

STONE FILL, TYPE II  
113+75.00, LT - 117+25.00, LT

STONE FILL, TYPE IV  
113+75.00, LT - 117+25.00, LT

STEEL BEAM GUARDRAIL, GALVANIZED  
117+50.38, LT - 118+20.01, LT

MANUFACTURED TERMINAL SECTION, FLARED  
118+20.01, LT - 118+57.30, LT

ANCHOR FOR STEEL BEAM RAIL  
118+56.35, LT

REMOVE AND RESET GUARDRAIL  
113+75.00, LT - 117+50.38, LT

REMOVAL AND DISPOSAL OF GUARDRAIL  
117+50.38, LT - 117+75.81, LT

4" YELLOW LINE  
113+75 - 117+25, CL (DBL)

4" WHITE LINE  
113+75, LT - 117+25, LT  
113+75, RT - 117+25, RT

SPECIAL PROVISION  
5 FT RIPRAP, HEAVY TYPE  
(SCATTERED NATURAL RIVER BOULDERS)  
113+75.00, LT - 117+25.00, LT

SPECIAL PROVISION  
5 FT RIPRAP, HEAVY TYPE  
(STONE TOE WALL)  
114+25.00, LT - 116+25.00, LT

GULF STREAM  
CURVE (GS1)  
DELTA = 13°53'53"  
D = 28°38'52"  
R = 200.00'  
T = 24.38'  
L = 48.51'  
E = 1.48'

GULF STREAM  
CURVE (GS2)  
DELTA = 22°08'16"  
D = 13°19'29"  
R = 430.00'  
T = 84.12'  
L = 166.14'  
E = 8.15'

GULF STREAM  
CURVE (GS3)  
DELTA = 13°35'17"  
D = 11°56'12"  
R = 480.00'  
T = 57.19'  
L = 113.84'  
E = 3.39'

BENCHMARK  
HVCTRL #1  
5/8" REBAR  
EL. 750.76

**END R.O.W. PROJECT  
WOODSTOCK ER 0241 (40)  
STA. 118+77, 36.78 LT**

**BEGIN R.O.W. PROJECT  
WOODSTOCK ER 0241 (40)  
STA. 116+70, 96.13 LT**

**KILLIAN, HENRIETTE M.**

**MARTSOLF, AMY  
& TAN, TERESA**

**MARTSOLF, AMY  
& TAN, TERESA**

N 417828.85  
E 1629102.67  
STA. 119+00, 52.37 RT

VT 12  
CURVE (1)  
DELTA = 4°54'42"  
D = 2°31'07"  
R = 2275.00'  
T = 96.91'  
L = 193.70'  
E = 2.06'

VT 12  
CURVE (2)  
DELTA = 11°36'42"  
D = 4°20'26"  
R = 1320.00'  
T = 134.22'  
L = 267.52'  
E = 6.81'


N 417882.56  
E 1629572.04  
STA. 114+50, 131.85 LT

BENCHMARK  
HVCTRL #2  
5/8" REBAR  
EL. 746.10

N 418052.72  
E 1629505.42  
STA. 114+50, 50.88 RT

LINES SHOWN ON THIS PLAN AS EXISTING  
PROPERTY LINES P/L ARE BELIEVED TO  
BE ACCURATE BUT SHOULD NOT BE RELIED  
UPON FOR PURPOSES UNRELATED TO THE  
STATE OF VERMONT'S ACQUISITION OF LAND  
AND RIGHTS FOR THIS PROJECT.

**FOR R.O.W.  
USE ONLY**

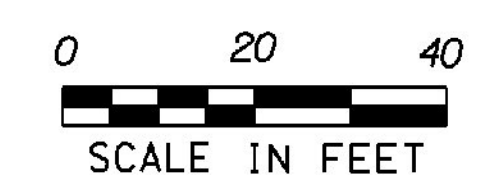

PROJECT NAME:	WOODSTOCK	PLOT DATE:	27-MAY-2014
PROJECT NUMBER:	ER 0241(40)	DRAWN BY:	A. EGIZI
FILE NAME:	r13c014lay.dgn	CHECKED BY:	R. CLOUTIER
PROJECT LEADER:	P. LIBBY	SHEET	12 OF 27
DESIGNED BY:	TYLIN	ROW LAYOUT SHEET	1 OF 1

