

STONE FILL, TYPE II  
113+75.00, LT - 117+13.10, LT

STONE FILL, TYPE IV  
113+75.00, LT - 117+20.39, LT

STEEL BEAM GUARDRAIL, GALVANIZED  
117+50.38, LT - 118+57.5, LT  
11025.00  
ANCHOR FOR STEEL BEAM RAIL

118+51.00, LT  
11025.00, LT  
~~REMOVE AND RESET GUARDRAIL~~  
113+75.00, LT - 117+50.38, LT

REMOVAL AND DISPOSAL OF GUARDRAIL  
117+50.38, LT - 117+75.81, LT  
11025.00

4" YELLOW LINE  
111+85 - 119+15, CL (DBL)

4" WHITE LINE  
111+85, RT - 119+15, RT  
113+75, LT - 117+25, LT

SPECIAL PROVISION  
(RIPRAP, CHANNEL ARMORING)  
(NATURAL RIVER BOULDERS)  
113+75.00, LT - 117+20.39, LT

SPECIAL PROVISION  
(RIPRAP, CHANNEL ARMORING)  
(STONE TOE WALL)  
114+25.00, LT - 116+25.00, LT


⊕ GULF STREAM  
CURVE (GS1)  
DELTA = 13°53'53" LT  
D = 28°38'52"  
R = 200.00'  
T = 24.38'  
L = 48.51'  
E = 1.48'

⊕ VT 12  
CURVE (1)  
DELTA = 4°52'42" LT  
D = 2°31'07"  
R = 2275.00'  
T = 96.91'  
L = 193.70'  
E = 2.06'  
BANK = VARIES

⊕ GULF STREAM  
CURVE (GS2)  
DELTA = 22°08'16" LT  
D = 13°19'29"  
R = 430.00'  
T = 84.12'  
L = 166.14'  
E = 8.15'

⊕ VT 12  
CURVE (2)  
DELTA = 11°36'42" LT  
D = 4°20'26"  
R = 1320.00'  
T = 134.22'  
L = 267.52'  
E = 6.81'  
BANK = VARIES

⊕ GULF STREAM  
CURVE (GS3)  
DELTA = 13°35'17" RT  
D = 11°56'12"  
R = 480.00'  
T = 57.19'  
L = 113.84'  
E = 3.39'

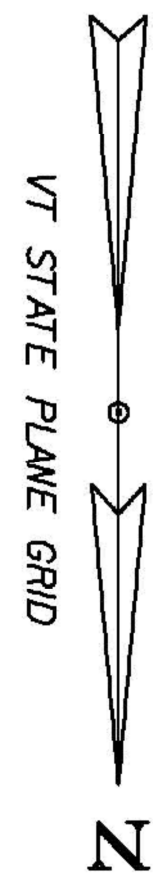

BENCHMARK  
HVCTRL #1  
5/8" REBAR  
EL. 755.76

BENCHMARK  
HVCTRL #2  
5/8" REBAR  
EL. 746.10

GRASS  
252'6" x 2'50"  
4"X6" GRAN. MON. 10' AG. LEANING  
VT 12  
STA. 118+79.35  
LIMIT OF WORK

LEGEND:

- STONE FILL, TYPE II
- STONE FILL, TYPE IV
- SPECIAL PROVISION (RIPRAP, CHANNEL ARMORING) (NATURAL RIVER BOULDERS)
- COLD PLANING
- STONE FILL, TYPE IV W/SPECIAL PROVISION (RIPRAP, CHANNEL ARMORING) - (NATURAL RIVER BOULDERS)
- DYCL DOUBLE YELLOW CENTER LINE
- SWEL SOLID WHITE EDGE LINE

PROJECT NAME: WOODSTOCK  
PROJECT NUMBER: ER 024(40)

FILE NAME: z13c014bdr.dgn  
PROJECT LEADER: D. BRYANT  
DESIGNED BY: T. KELLEY  
PLAN SHEET

PLOT DATE: 2/4/2015  
DRAWN BY: T. KELLEY  
CHECKED BY: D. BRYANT  
SHEET 13 OF 27



TYLINTERNATIONAL

