




STA. 118+79.35
LIMIT OF WORK

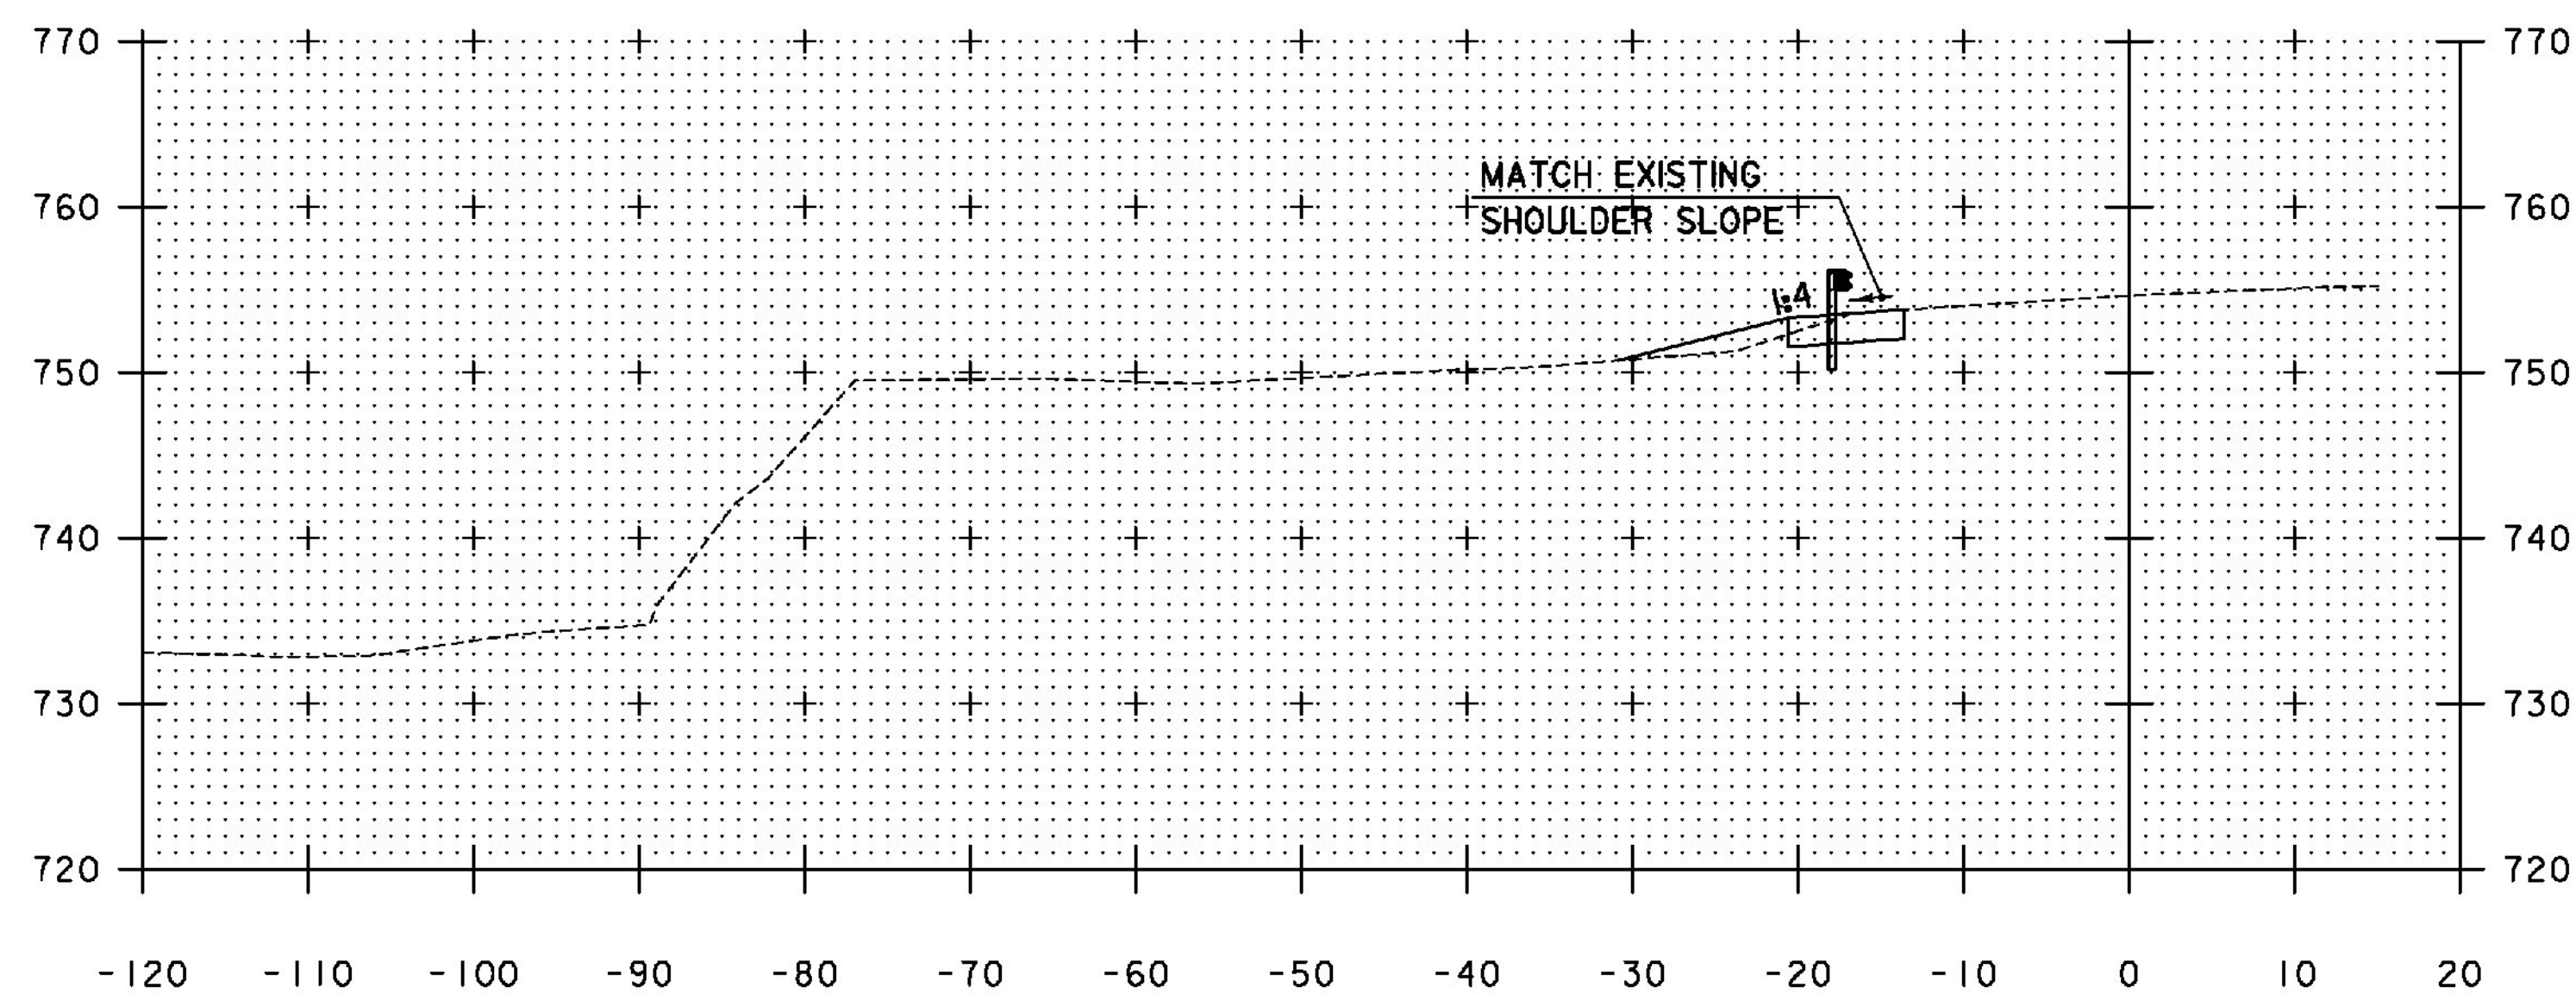

118+50

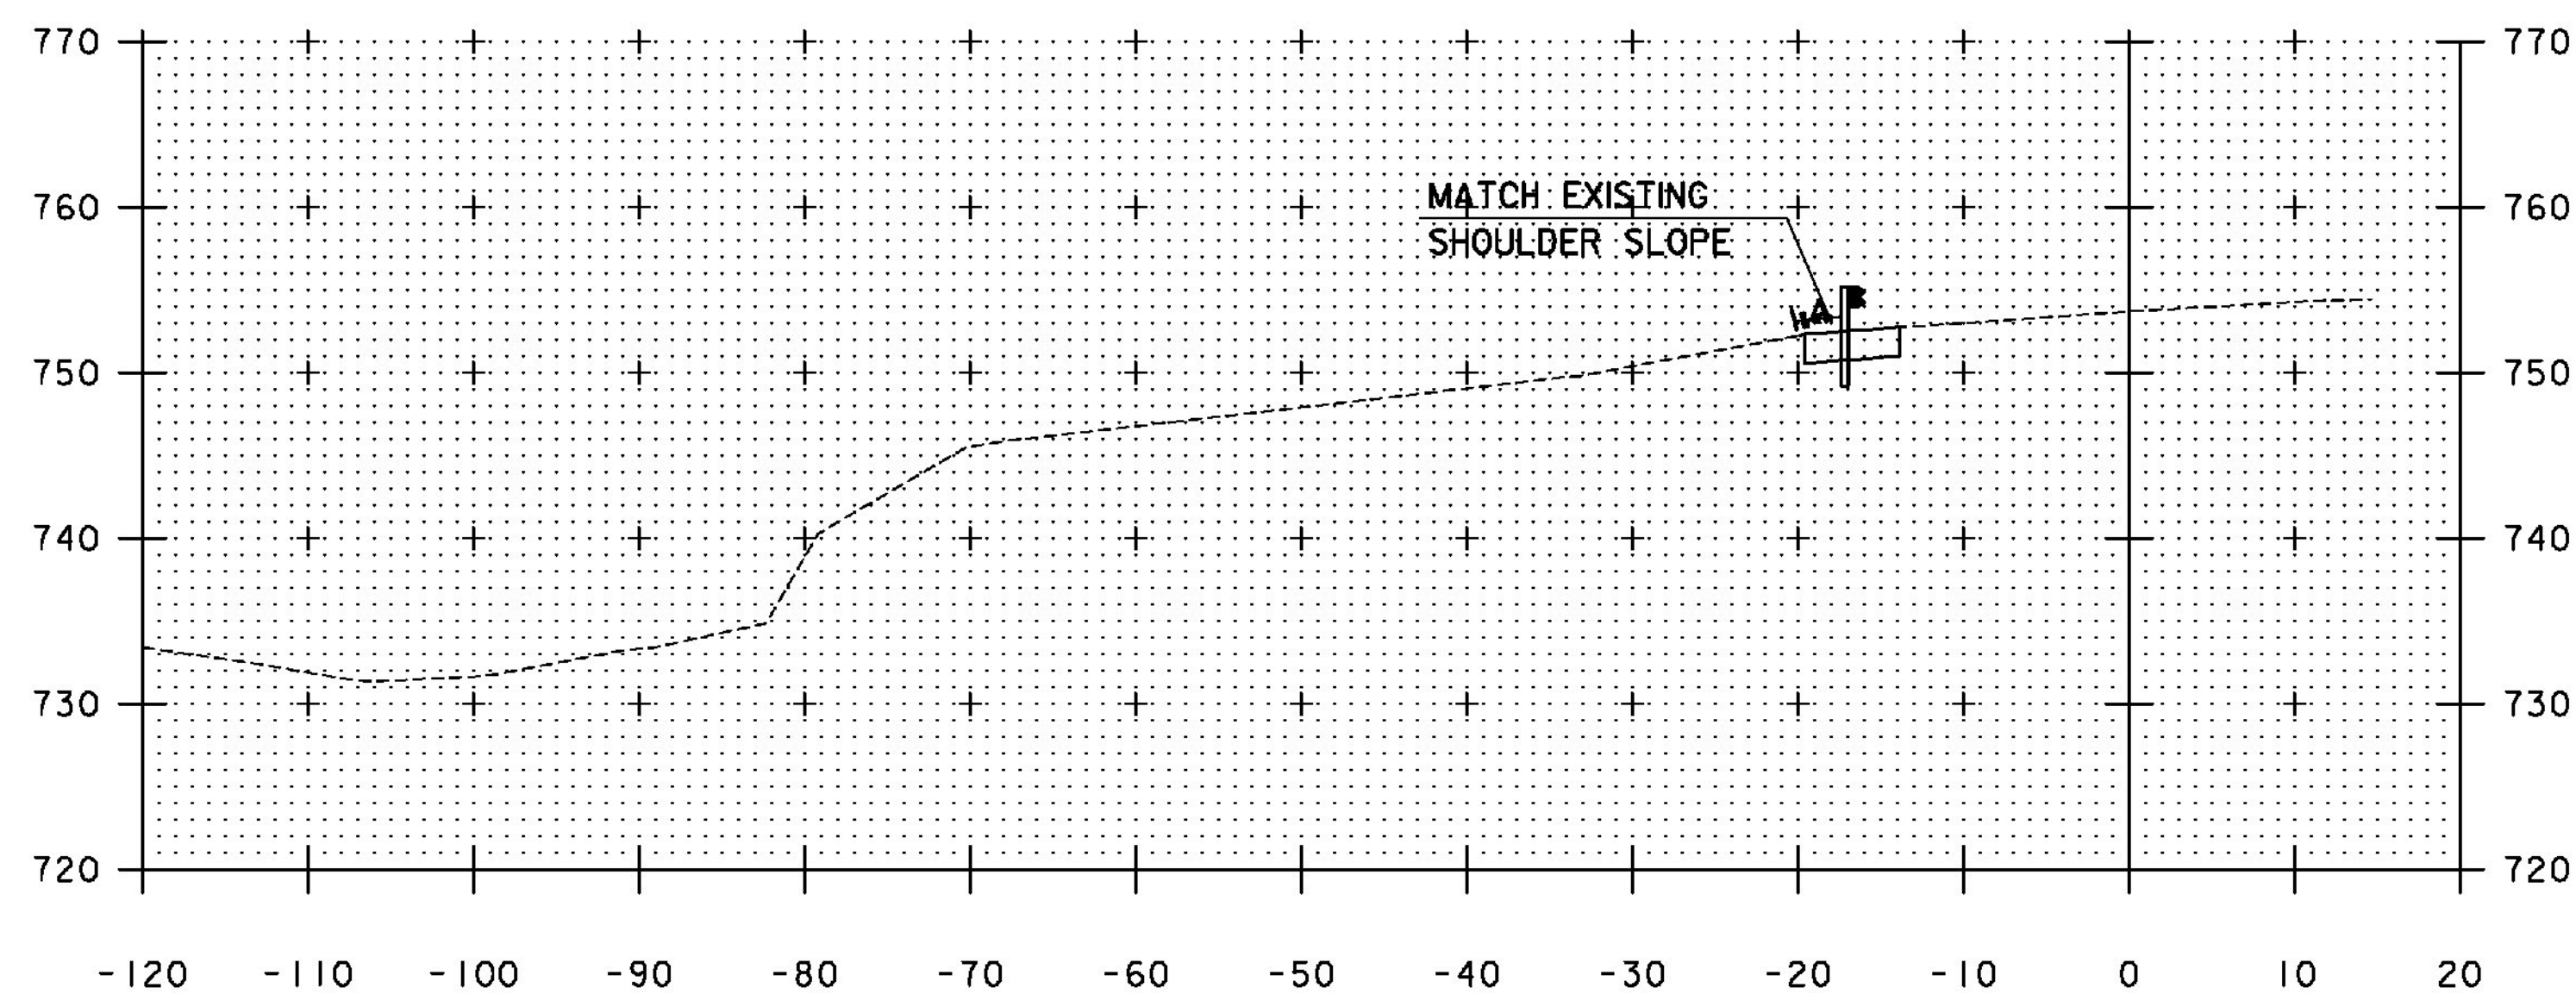

118+00

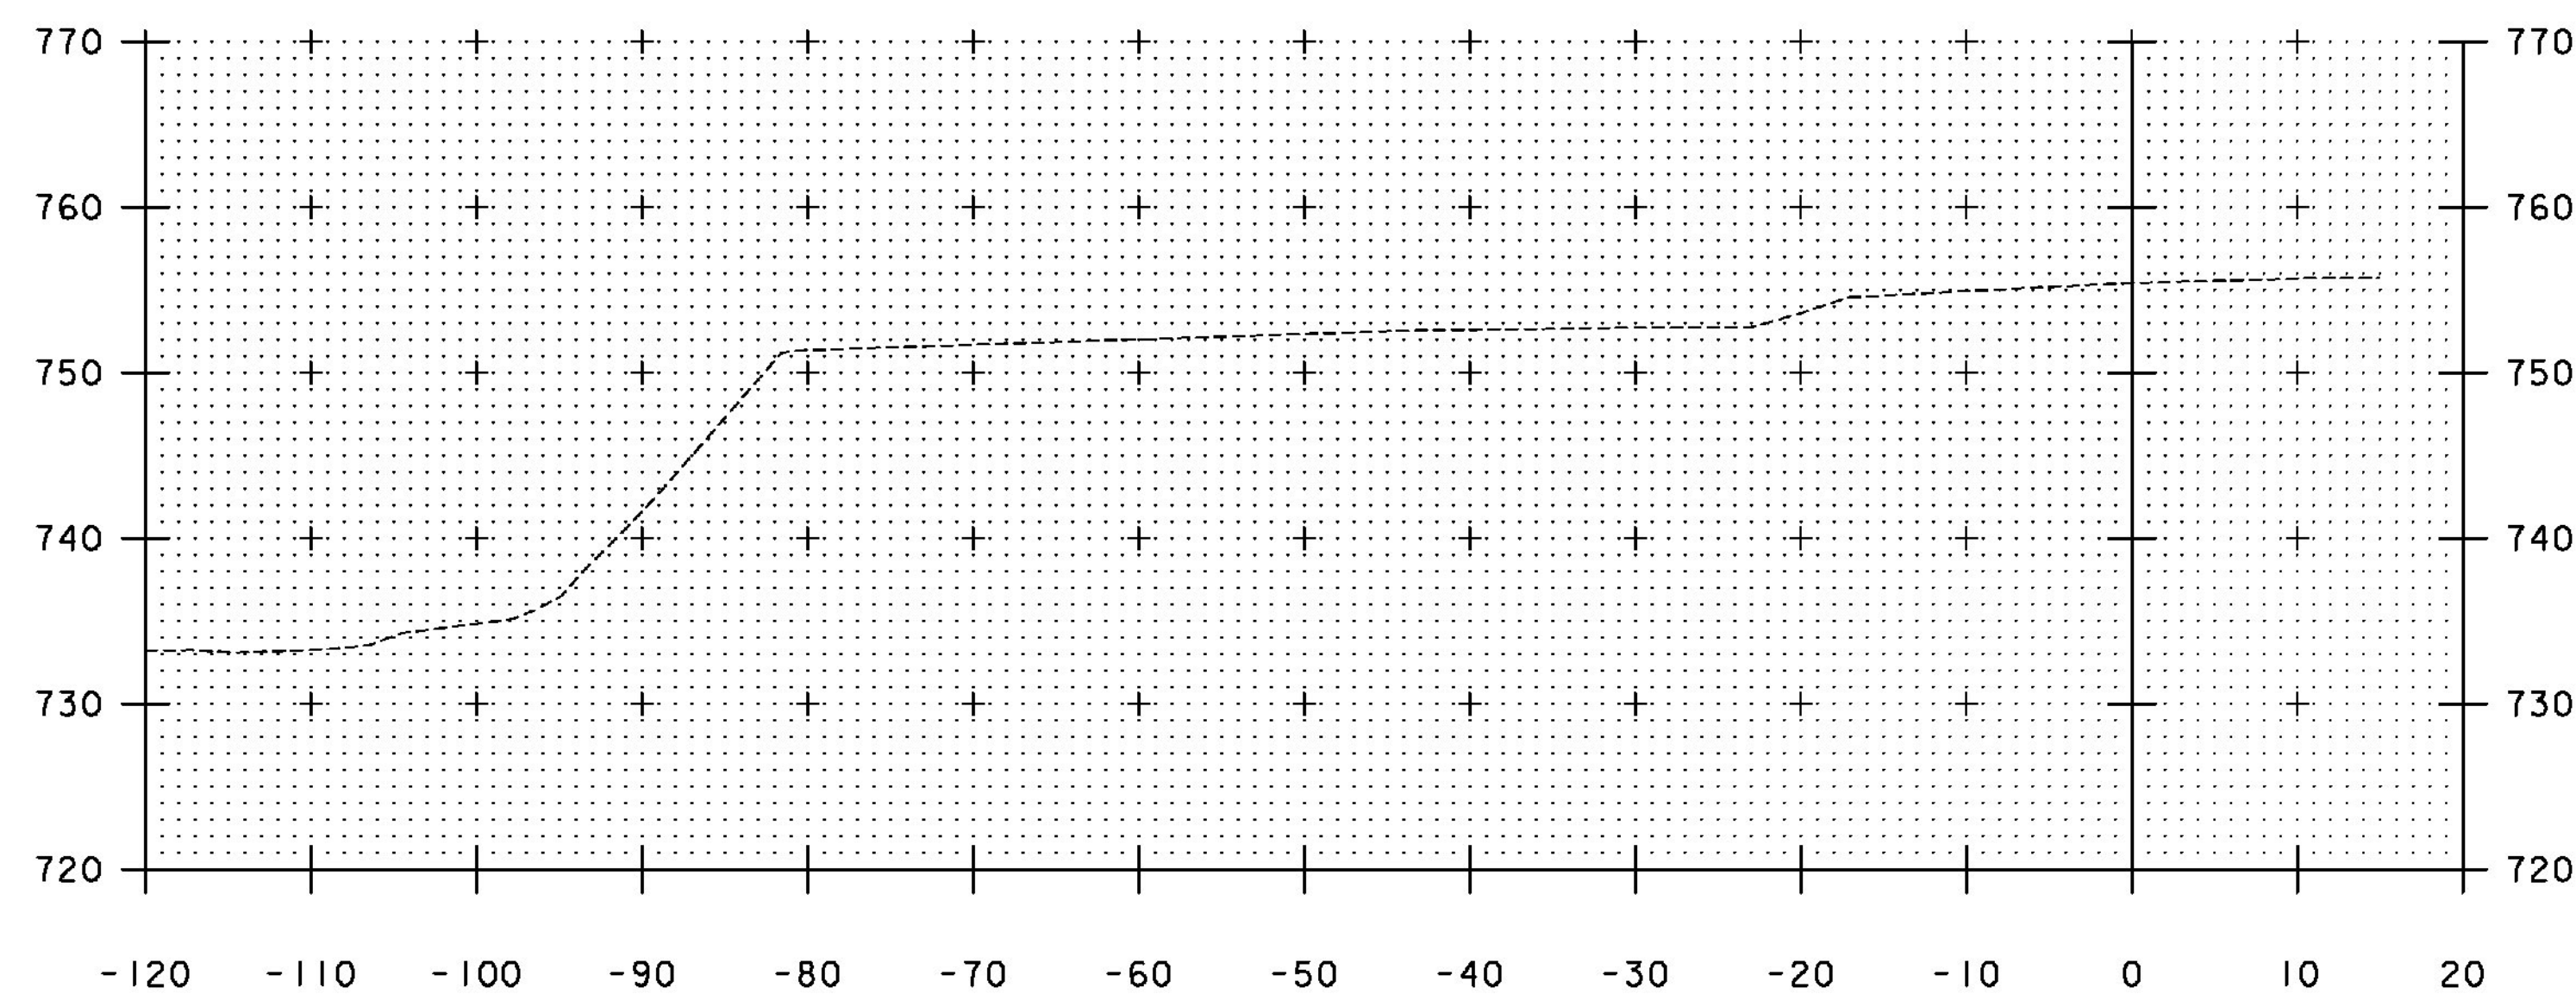

119+00

STA. 118+00 TO STA. 119+00

TYLINTERNATIONAL

PROJECT NAME: WOODSTOCK
PROJECT NUMBER: ER 024I(40)

FILE NAME: z13c014XS.dgn
PROJECT LEADER: D. BRYANT
DESIGNED BY: T. KELLEY
VT ROUTE 12 CROSS SECTION SHEET 3

PLOT DATE: 2/4/2015
DRAWN BY: T. KELLEY
CHECKED BY: D. BRYANT
SHEET 23 OF 27