


**NOTE:**  
SEE TRAFFIC CONTROL SHEET 2 FOR RECONSTRUCTION OF EASTBOUND SIDE SLOPE AND SIGNING NOTES.

SIGN #	DESCRIPTION	SIGN COLORS		SIZE	QTY	SUPPORT
		LEGEND	BACKGROUND			
G20-2	END ROAD WORK	BLACK	ORANGE *	36x18	2	4 - POSTS (2/SIGN)
R10-6	STOP HERE ON RED	BLACK	WHITE *	24x36	2	4 - POSTS
**	TO GET GREEN LIGHT	**	**	24x24	2	(2/SIGN ASSEMBLY)
W1-8	CHEVRON	BLACK	ORANGE *	24x30	6	ON BARRICADE
W3-3	TRAFFIC SIGNAL	CIRCLE: TOP - RED * MID. - YELLOW * BOT. - GREEN *	ORANGE *	48x48	2	4 - POSTS (2/SIGN)
W20-1	ROAD WORK 1000 FT	BLACK	ORANGE *	48x48	2	4 - POSTS (2/SIGN)
W20-1	ROAD WORK 1500 FT	BLACK	ORANGE *	48x48	2	4 - POSTS (2/SIGN)
W20-1	ROAD WORK AHEAD	BLACK	ORANGE *	48x48	4	8 - POSTS
W13-1P	25 M.P.H.	BLACK	ORANGE *	24x24	4	(2/SIGN ASSEMBLY)
W20-4	ONE LANE ROAD AHEAD	BLACK	ORANGE *	48x48	4	8 - POSTS (2/SIGN)
W24-1	DOUBLE REVERSE CURVE (1LANE)	BLACK	ORANGE *	48x48	1	2 - POSTS
W13-1P	25 M.P.H.	BLACK	ORANGE *	24x24	1	(2/SIGN ASSEMBLY)

\* RETROREFLECTIVE  
\*\* SEE "TRAFFIC CONTROL SHEET 3" FOR SIGN DETAILS


SQUARE SIGN POSTS	38
POST ANCHORS	38

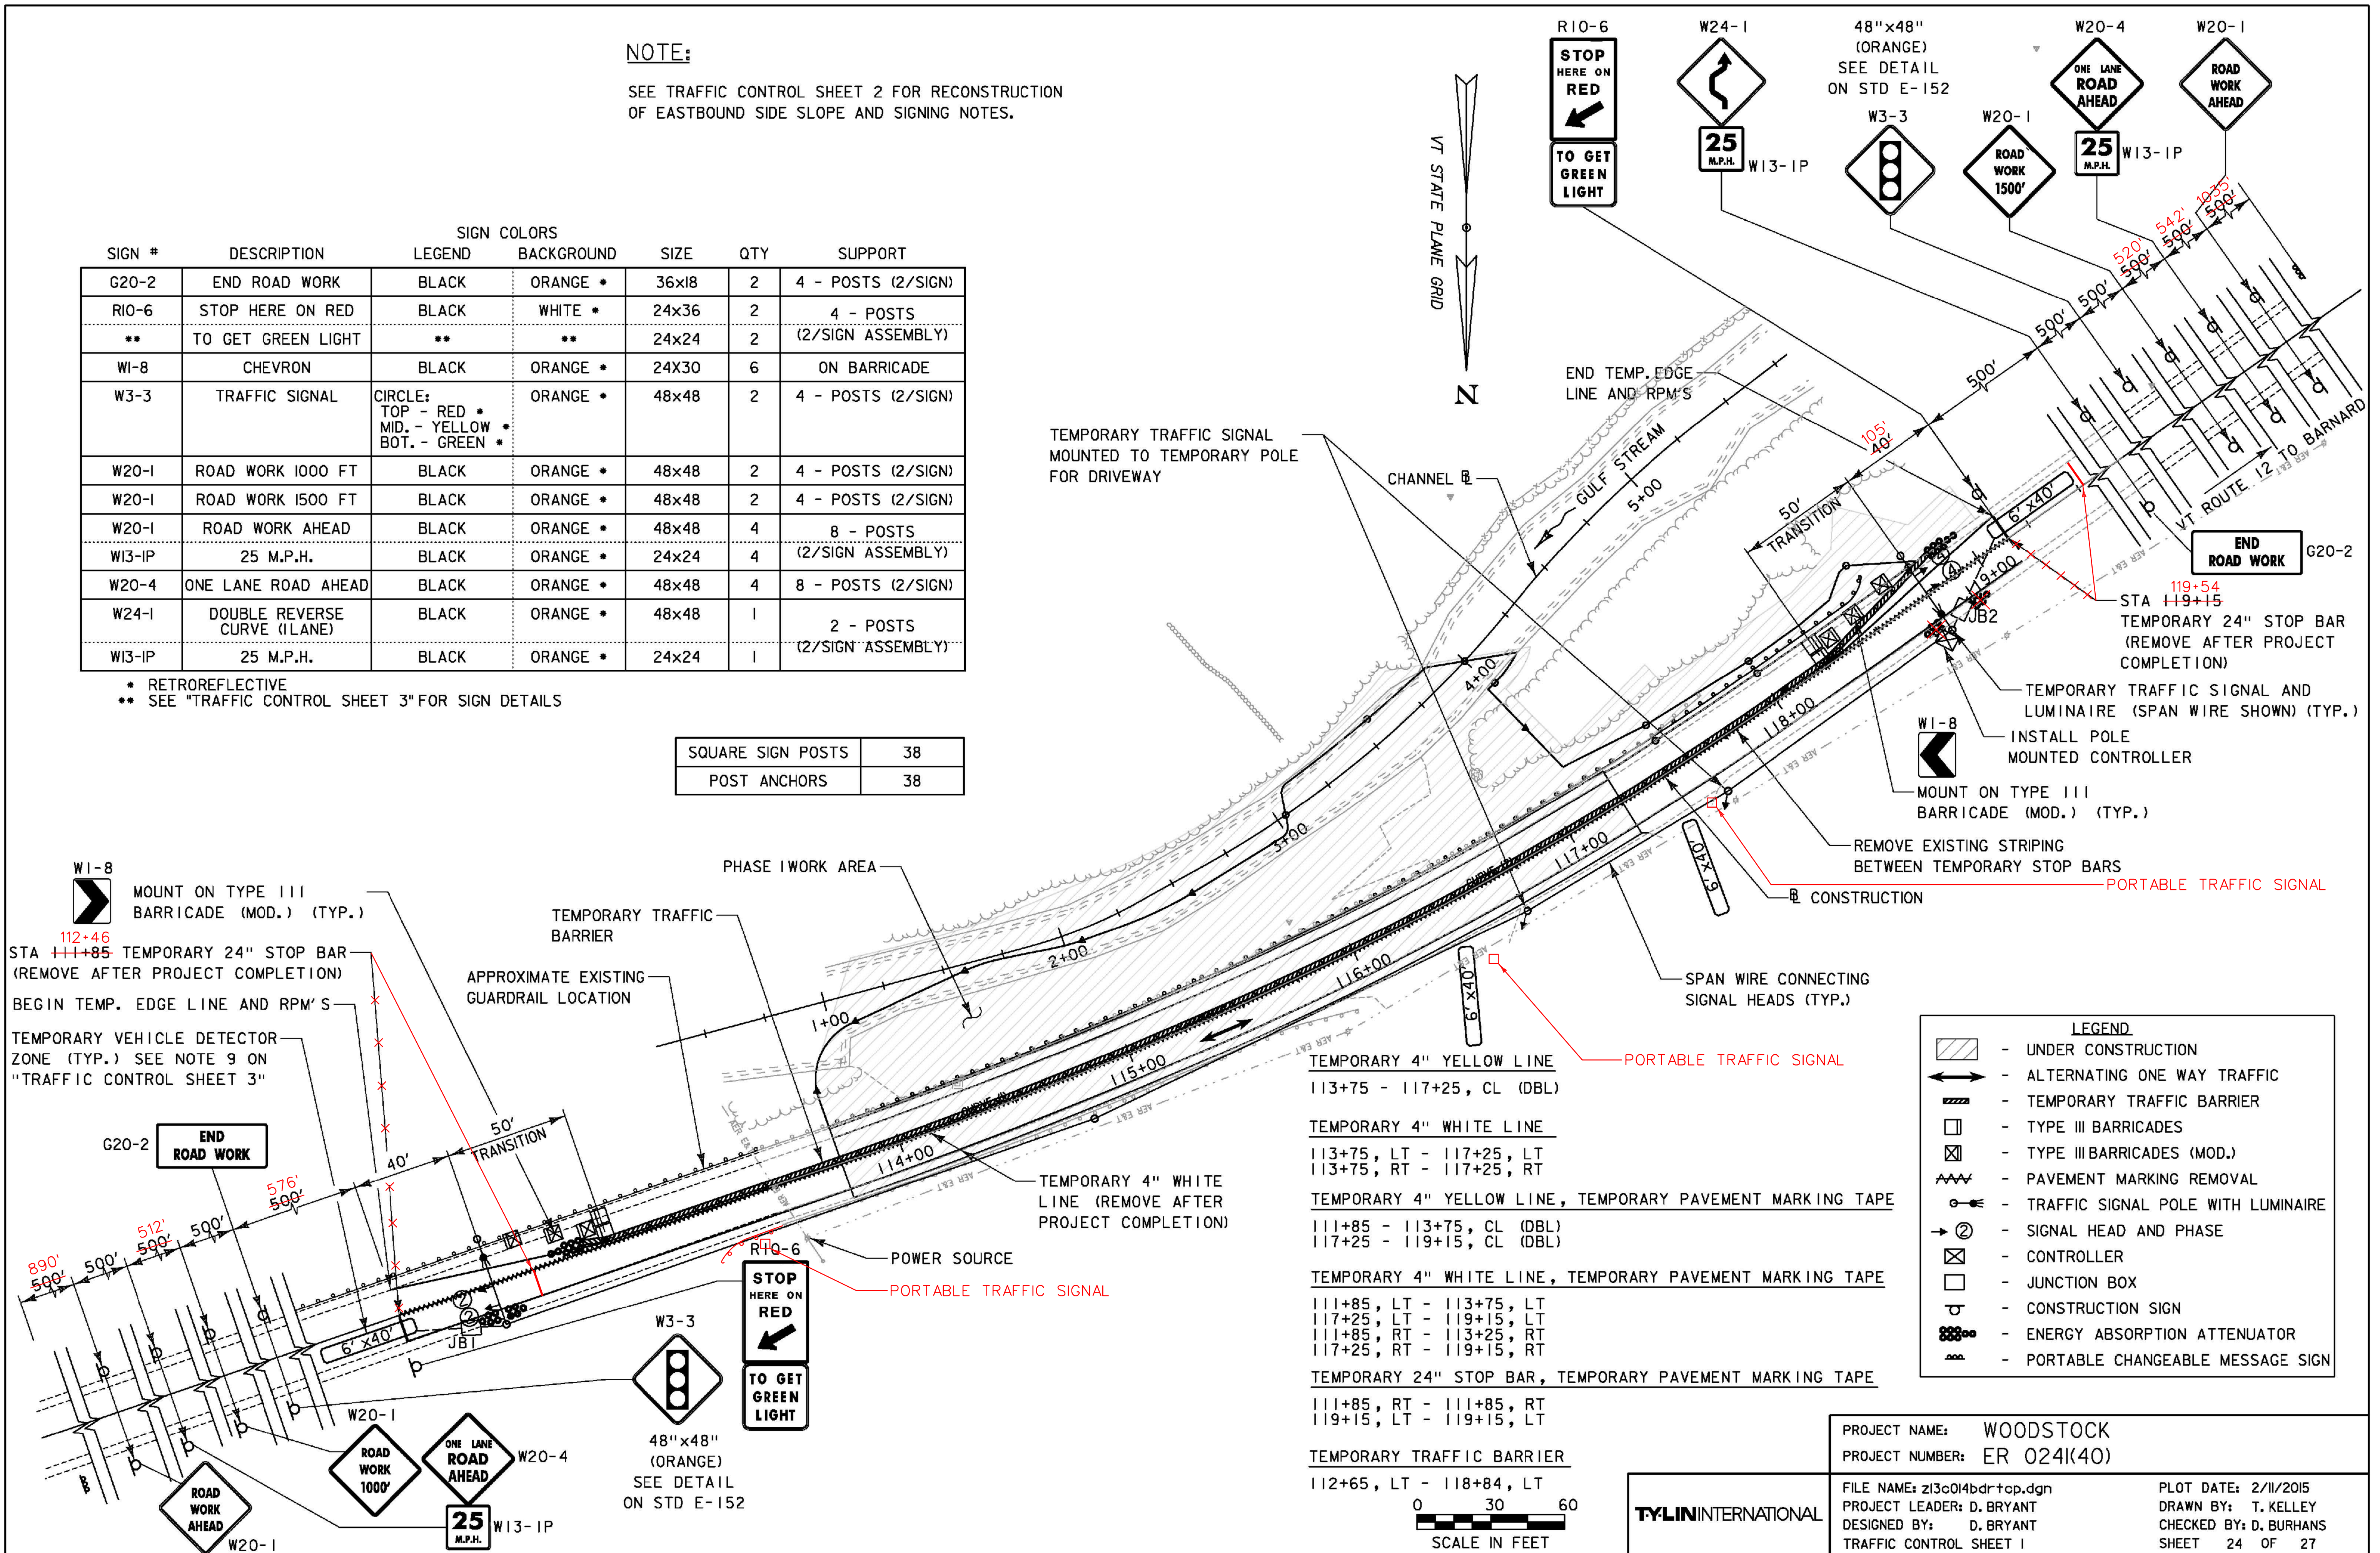

**LEGEND**

- UNDER CONSTRUCTION
- ALTERNATING ONE WAY TRAFFIC
- TEMPORARY TRAFFIC BARRIER
- TYPE III BARRICADES
- TYPE III BARRICADES (MOD.)
- PAVEMENT MARKING REMOVAL
- TRAFFIC SIGNAL POLE WITH LUMINAIRE
- SIGNAL HEAD AND PHASE
- CONTROLLER
- JUNCTION BOX
- CONSTRUCTION SIGN
- ENERGY ABSORPTION ATTENUATOR
- PORTABLE CHANGEABLE MESSAGE SIGN

- TEMPORARY 4" YELLOW LINE  
113+75 - 117+25, CL (DBL)
- TEMPORARY 4" WHITE LINE  
113+75, LT - 117+25, LT  
113+75, RT - 117+25, RT
- TEMPORARY 4" YELLOW LINE, TEMPORARY PAVEMENT MARKING TAPE  
111+85 - 113+75, CL (DBL)  
117+25 - 119+15, CL (DBL)
- TEMPORARY 4" WHITE LINE, TEMPORARY PAVEMENT MARKING TAPE  
111+85, LT - 113+75, LT  
117+25, LT - 119+15, LT  
111+85, RT - 113+25, RT  
117+25, RT - 119+15, RT
- TEMPORARY 24" STOP BAR, TEMPORARY PAVEMENT MARKING TAPE  
111+85, RT - 111+85, RT  
119+15, LT - 119+15, LT
- TEMPORARY TRAFFIC BARRIER  
112+65, LT - 118+84, LT

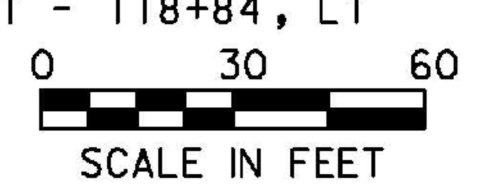

TYLIN INTERNATIONAL

PROJECT NAME: WOODSTOCK  
PROJECT NUMBER: ER 024(40)  
FILE NAME: z13c014bdr-top.dgn  
PROJECT LEADER: D. BRYANT  
DESIGNED BY: D. BRYANT  
TRAFFIC CONTROL SHEET 1  
PLOT DATE: 2/11/2015  
DRAWN BY: T. KELLEY  
CHECKED BY: D. BURHANS  
SHEET 24 OF 27