

# STATE OF VERMONT AGENCY OF TRANSPORTATION





## PROPOSED IMPROVEMENT BRIDGE PROJECT TOWN OF BRADFORD COUNTY OF ORANGE

ROUTE NO : VT 25B; RURAL MAJOR COLLECTOR BRIDGE NO : 1

PROJECT LOCATION : ON VT 25B BEGINNING APPROXIMATELY 0.166 MILE EAST FROM ITS INTERSECTION WITH VT 25 AND EXTENDING EASTERLY APPROXIMATELY 0.085 MILE.


PROJECT DESCRIPTION : REPLACEMENT OF EXISTING BRIDGE ALONG WITH RELATED APPROACH ROADWAY AND CHANNEL WORK.

LENGTH OF STRUCTURE : 143.08 FEET  
LENGTH OF ROADWAY : 306.92 FEET  
LENGTH OF PROJECT : 450.00 FEET

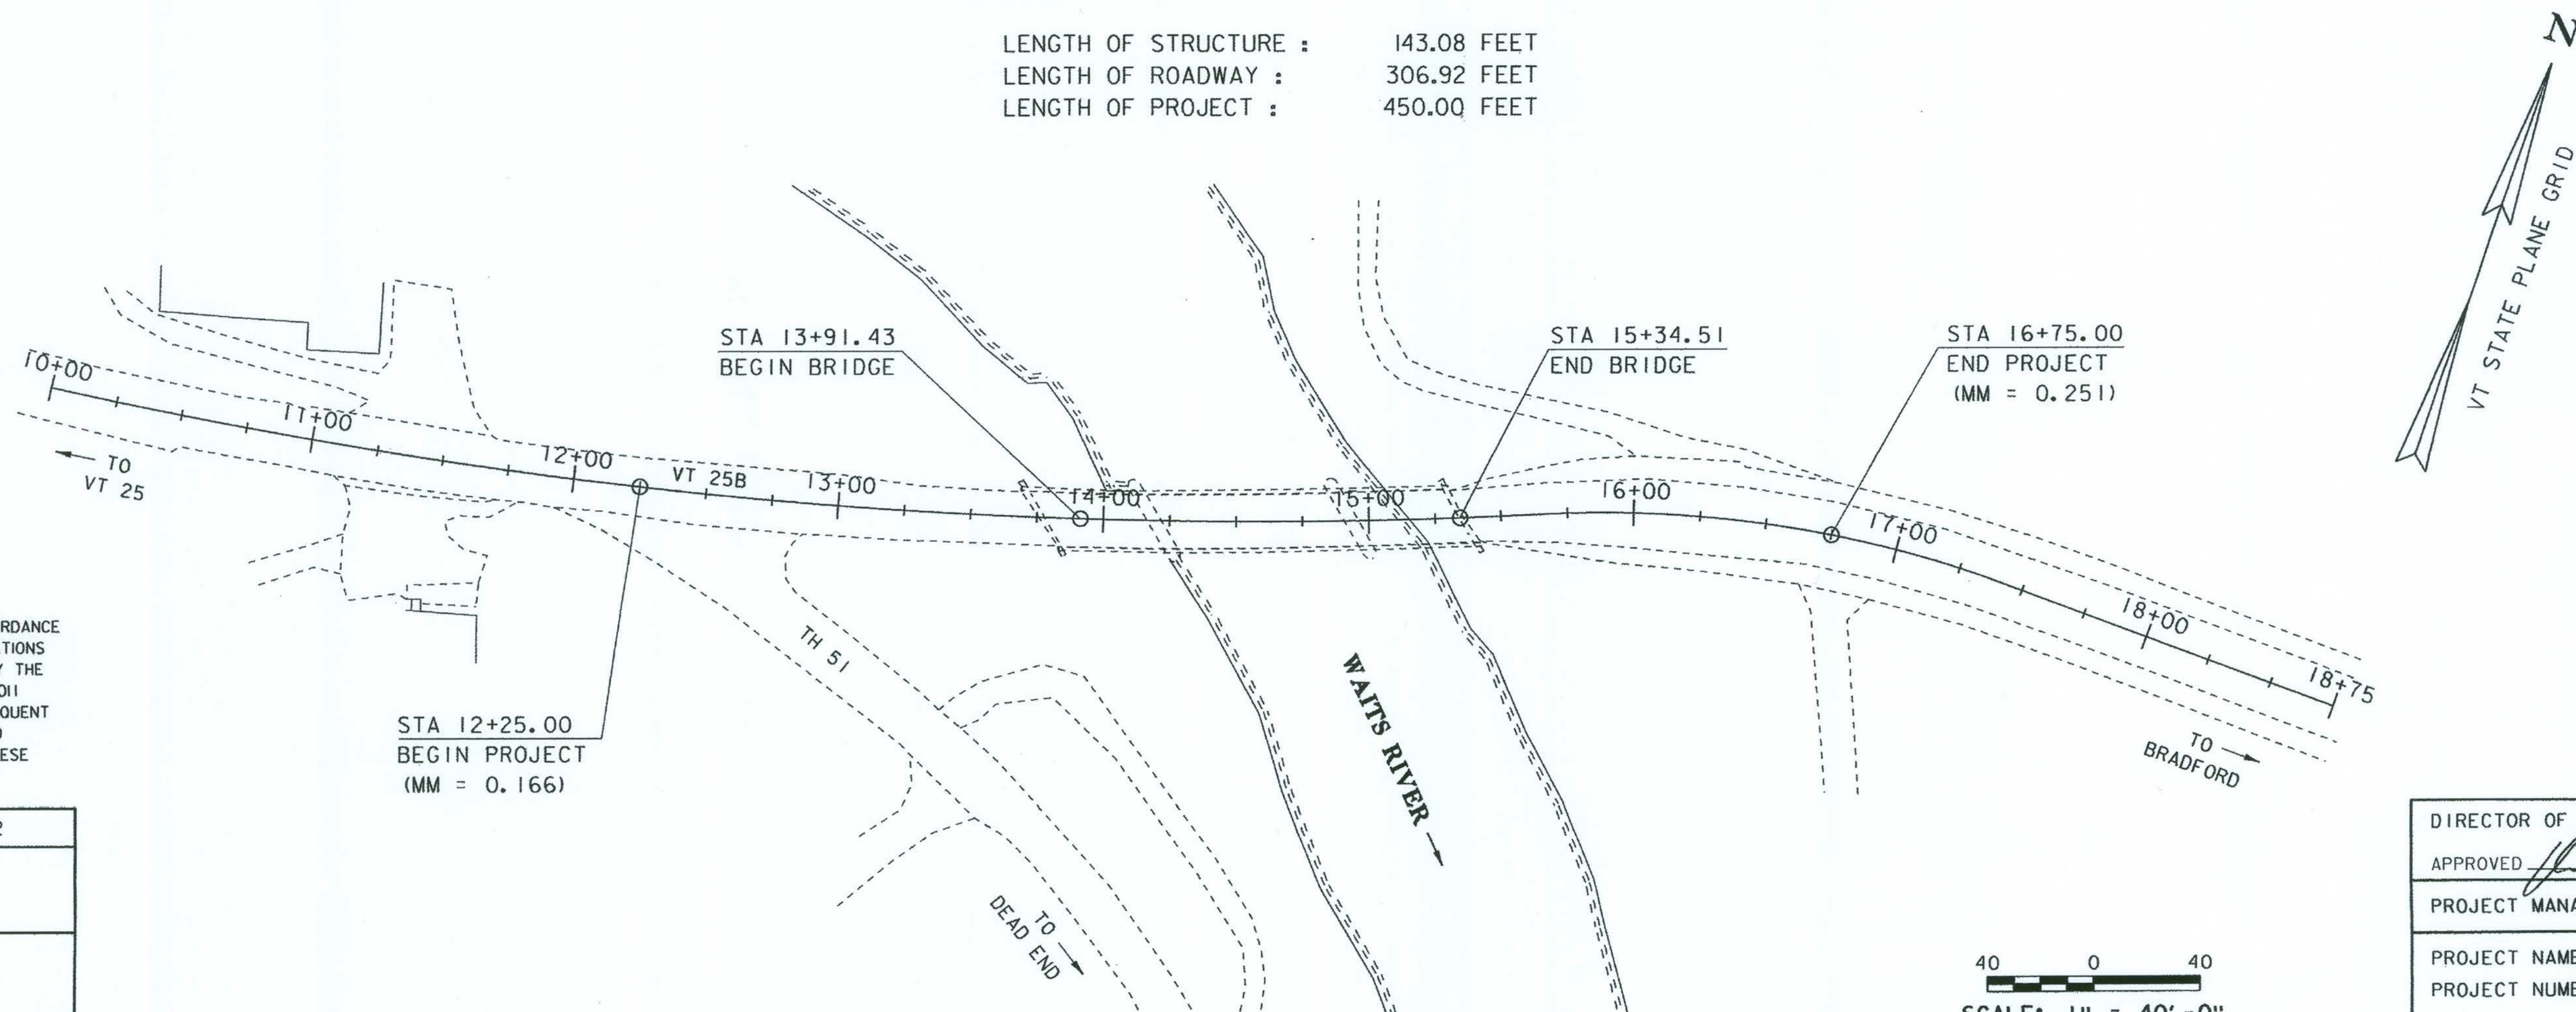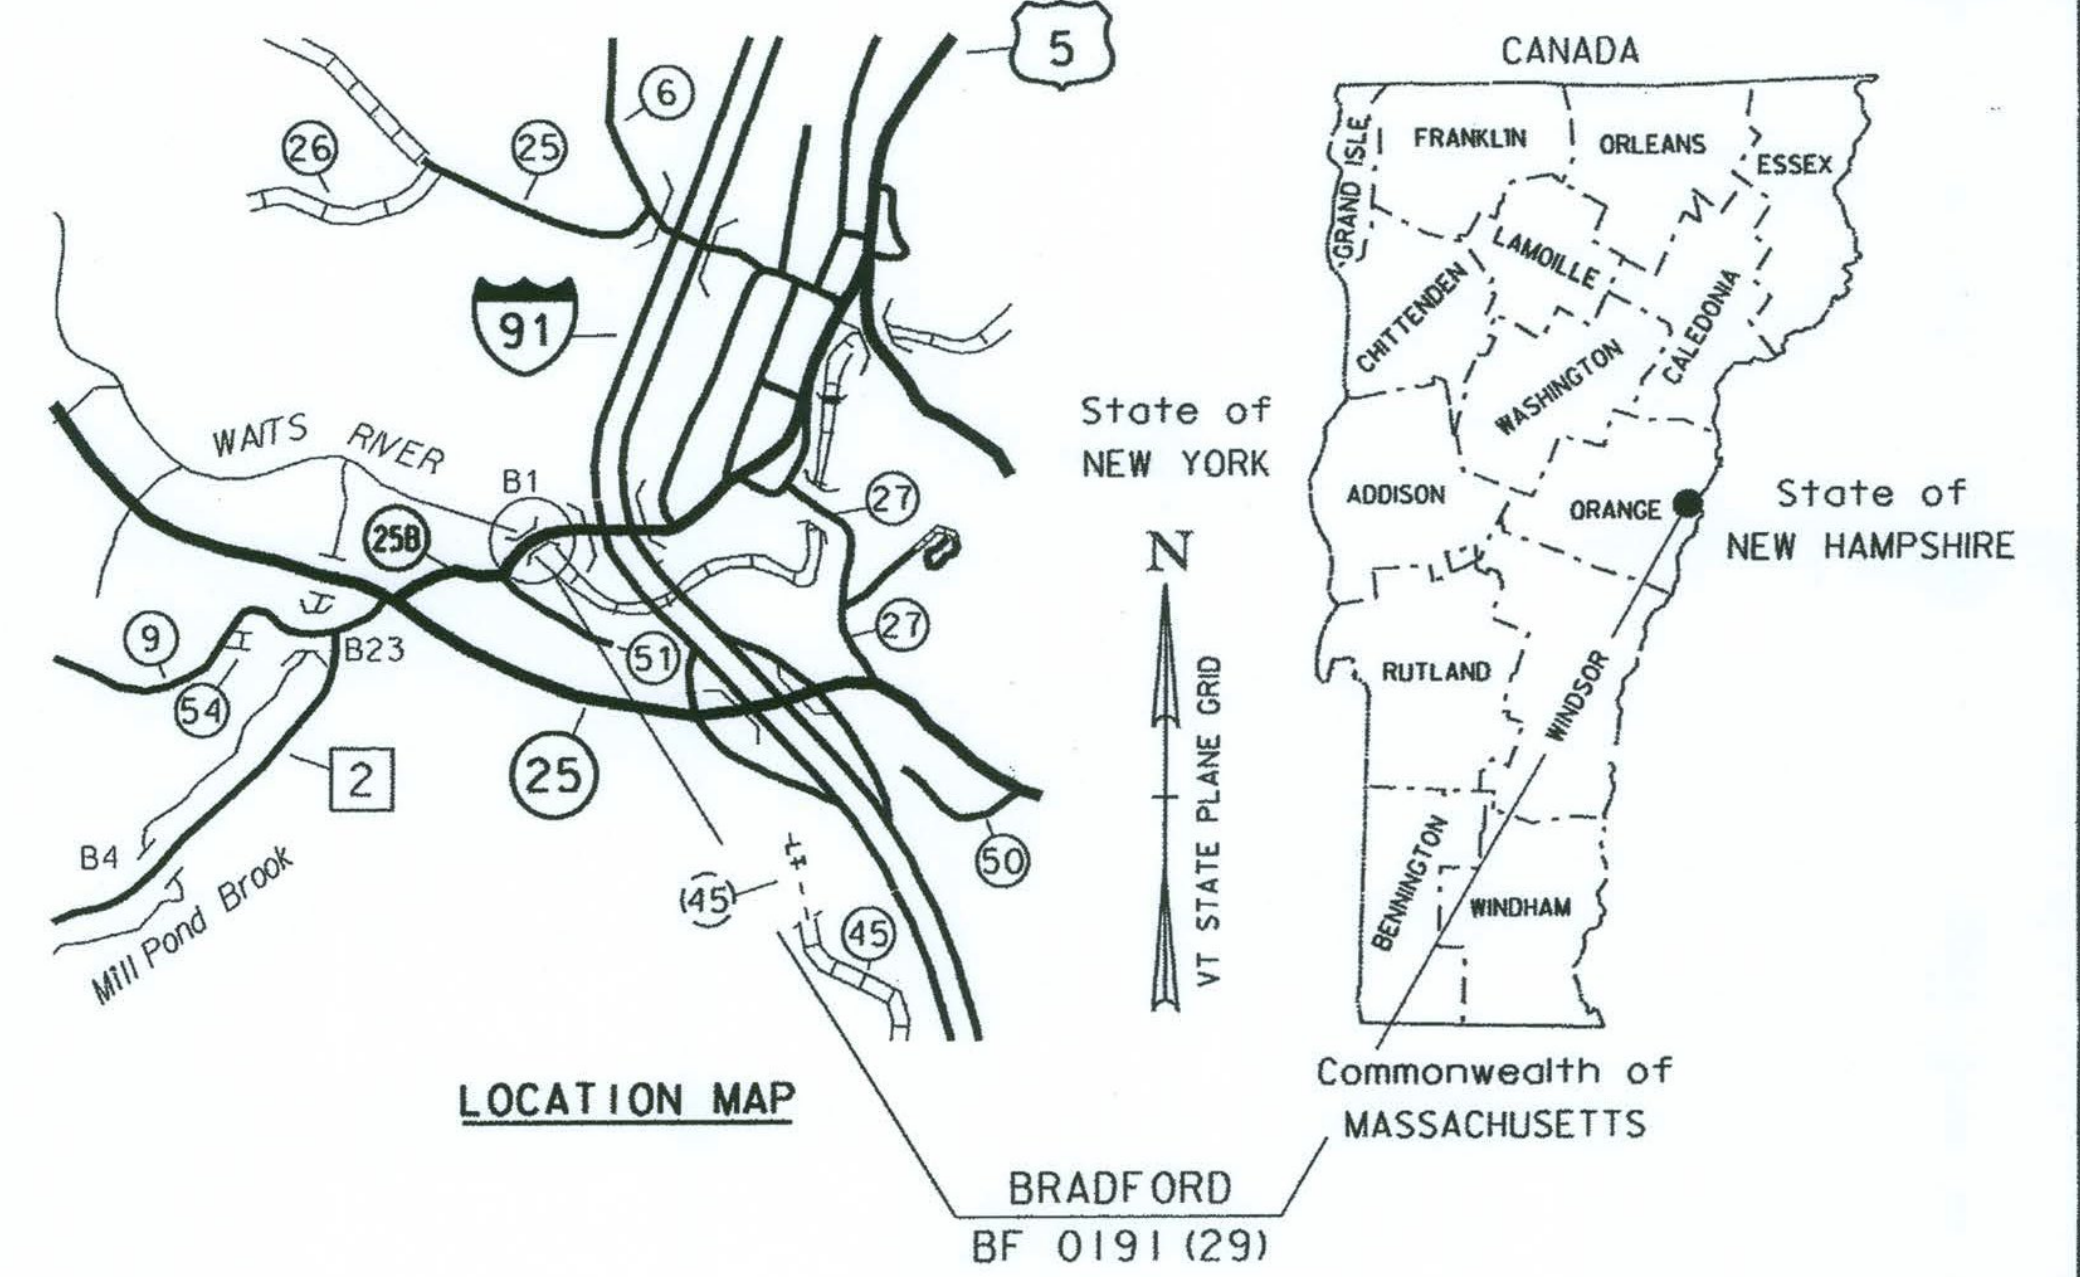

CONSTRUCTION IS TO BE CARRIED ON IN ACCORDANCE WITH THESE PLANS AND THE STANDARD SPECIFICATIONS FOR CONSTRUCTION DATED 2011, AS APPROVED BY THE FEDERAL HIGHWAY ADMINISTRATION ON JULY 20, 2011 FOR USE ON THIS PROJECT, INCLUDING ALL SUBSEQUENT REVISIONS AND SUCH REVISED SPECIFICATIONS AND SPECIAL PROVISIONS AS ARE INCORPORATED IN THESE PLANS.

QUALITY ASSURANCE PROGRAM : LEVEL 2	
SURVEYED BY : R. GILMAN	
SURVEYED DATE : 03/22/2013	
DATUM	
VERTICAL	NAVD88
HORIZONTAL	NAD 83 (96)

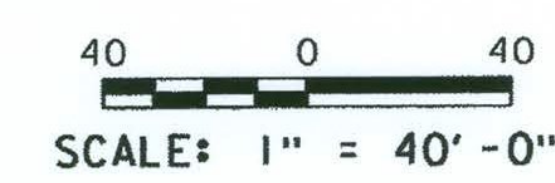

DIRECTOR OF PROJECT DELIVERY	
APPROVED <i>[Signature]</i>	DATE 9/19/2016
PROJECT MANAGER : C. CARLSON, PE	
PROJECT NAME : BRADFORD	
PROJECT NUMBER : BF 0191 (29)	
SHEET 1 OF 71 SHEETS	

**Record Plans**  
Contractor: A.L. ST. ONGE CONTRACTOR, INC.  
Resident Engineer: PETE HODGSON  
Construction Began: MAY 30, 2017  
Construction Complete: NOVEMBER 3, 2017  
Record Plans By: PETE HODGSON & JESSE IVES

I hereby certify that all construction required by this set of drawings has been accomplished as indicated herein.

BY: *[Signature]* Resident Engineer

Date: 12.27.2019

NOTE: Any further information concerning final quantities, amounts or other details relative to this project may be found at Central Files in the electronic archives.