

CONSTRUCT GRAVEL DRIVE

VT 25B STA 16+36.4 LT
VT 25B STA 16+82.1 RT

CONSTRUCT 4' PAVED APRON

VT 25B STA 16+04.8 LT - VT 25B STA 16+89.2 LT
VT 25B STA 16+57.5 RT - VT 25B STA 17+07.4 RT

BOX BEAM GUARDRAIL

VT 25B STA 16+00.0 RT - VT 25B STA 16+04.1 RT

MANUFACTURED TERMINAL SECTION, FLARED




VT 25B STA 16+04.1 RT - VT 25B STA 16+17.9 RT

REMOVAL AND DISPOSAL OF GUARDRAIL

VT 25B STA 16+00.0 RT - VT 25B STA 16+24.2 RT

DELINEATOR WITH STEEL POST

VT 25B STA 16+17.9 RT (GREEN)

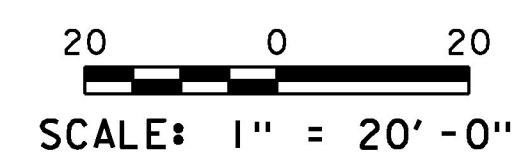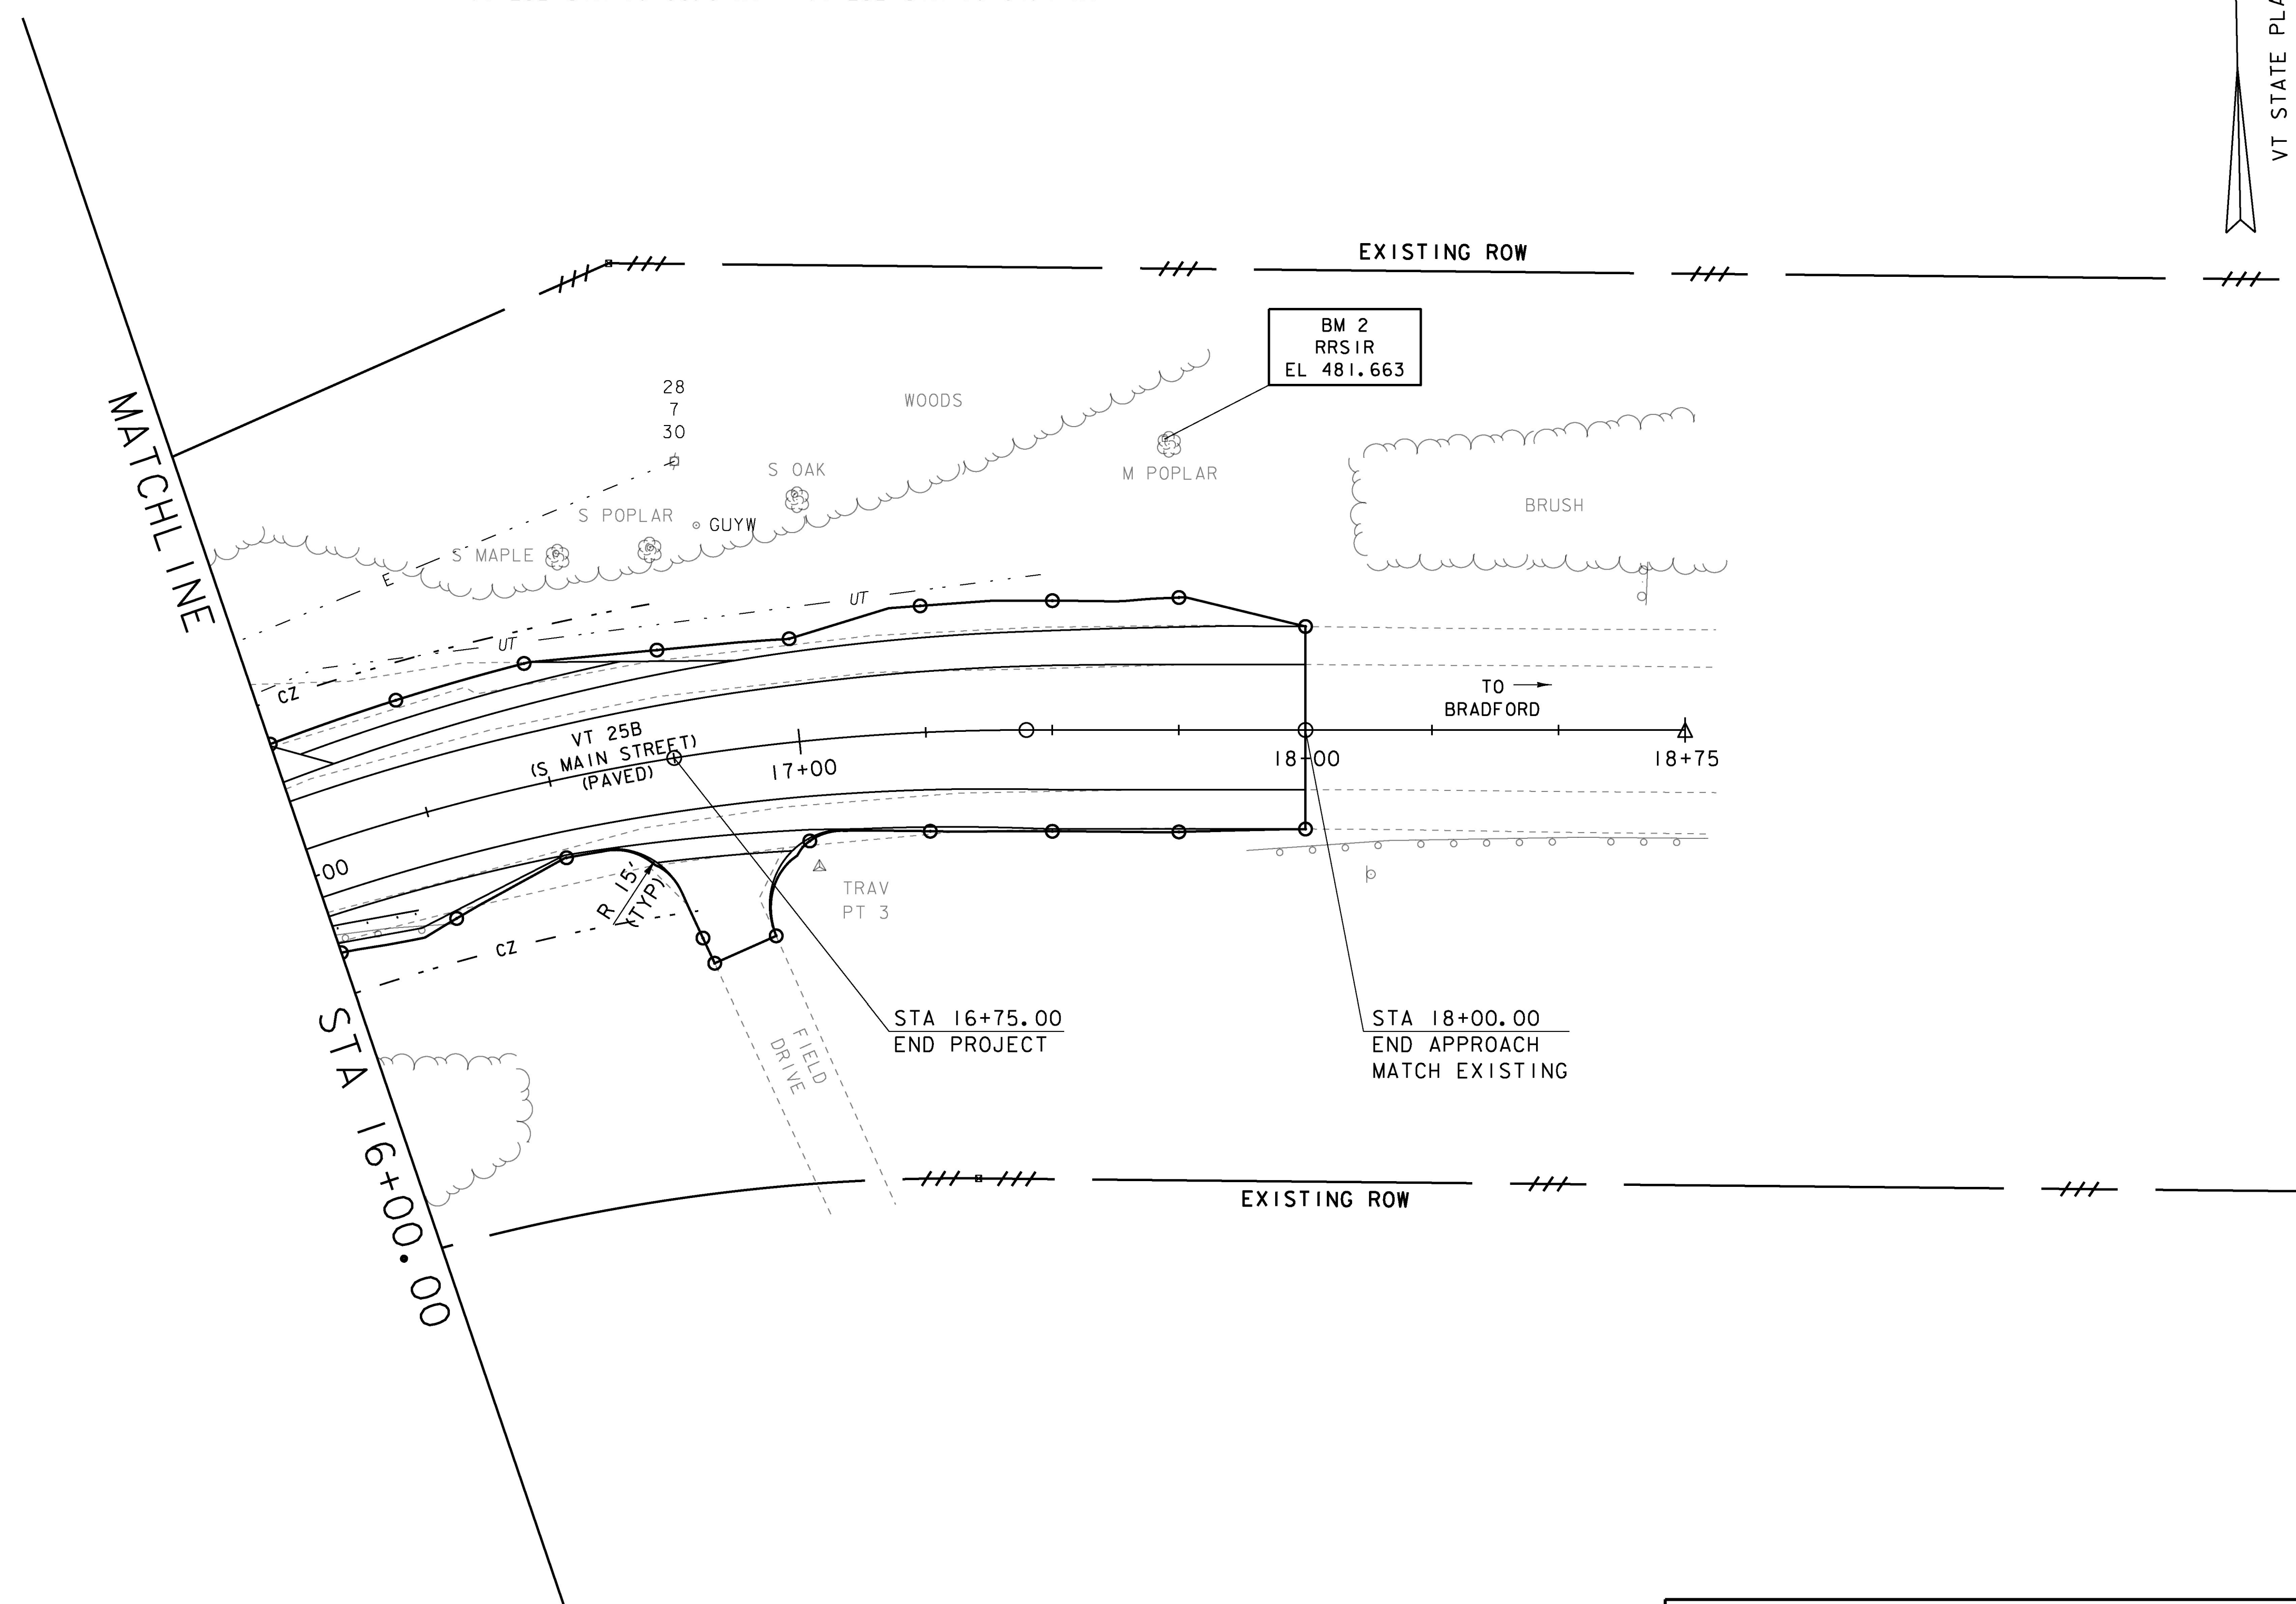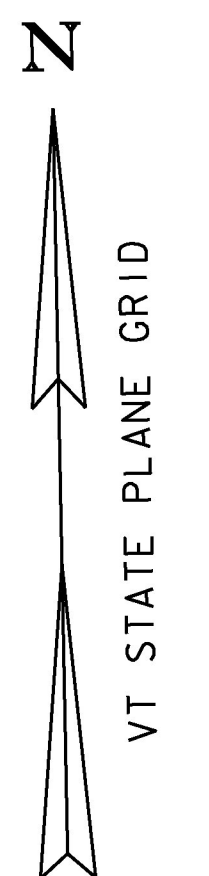

PROJECT NAME: BRADFORD	PLOT DATE: 02-NOV-2016
PROJECT NUMBER: BF 0191 (29)	DRAWN BY: G. ROY
FILE NAME: sl3c054bdr.dgn	CHECKED BY: M. EVANS-MONGEON
PROJECT LEADER: C. CARLSON	SHEET 15 OF 71
DESIGNED BY: G. ROY	
LAYOUT (2)	