


VT 25B BANKING DIAGRAM

HORIZONTAL SCALE: 1" = 20'-0"
 VERTICAL SCALE: 1" = 0.020' /'

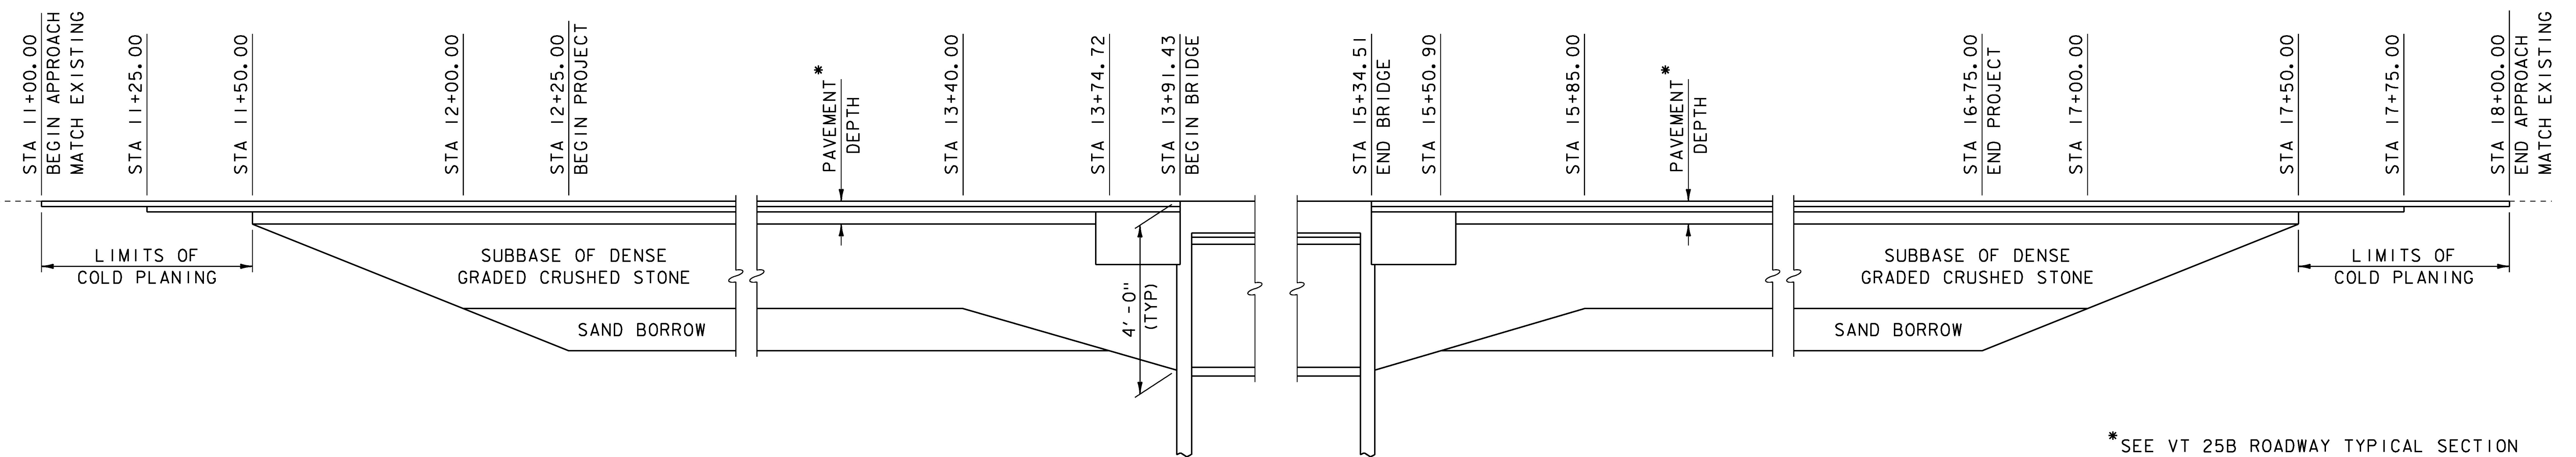

*SEE VT 25B ROADWAY TYPICAL SECTION FOR PAVEMENT AND SUBBASE MATERIAL DESIGN INFORMATION.

VT 25B MATERIAL TRANSITION

HORIZONTAL SCALE: 1" = 20'-0"
 VERTICAL SCALE: 1" = 2'-0"

PROJECT NAME: BRADFORD	PLOT DATE: 15-SEP-2016
PROJECT NUMBER: BF 0191 (29)	DRAWN BY: G. ROY
FILE NAME: sl3c054pro.dgn	CHECKED BY: M. EVANS-MONGEON
DESIGNED BY: G. ROY	SHEET 17 OF 71
VT 25B BANKING & MATERIAL TRANSITION	