


PRECAST ABUTMENT NO. 2 REINFORCING PLAN

SCALE:  $\frac{3}{8}$ " = 1'-0"

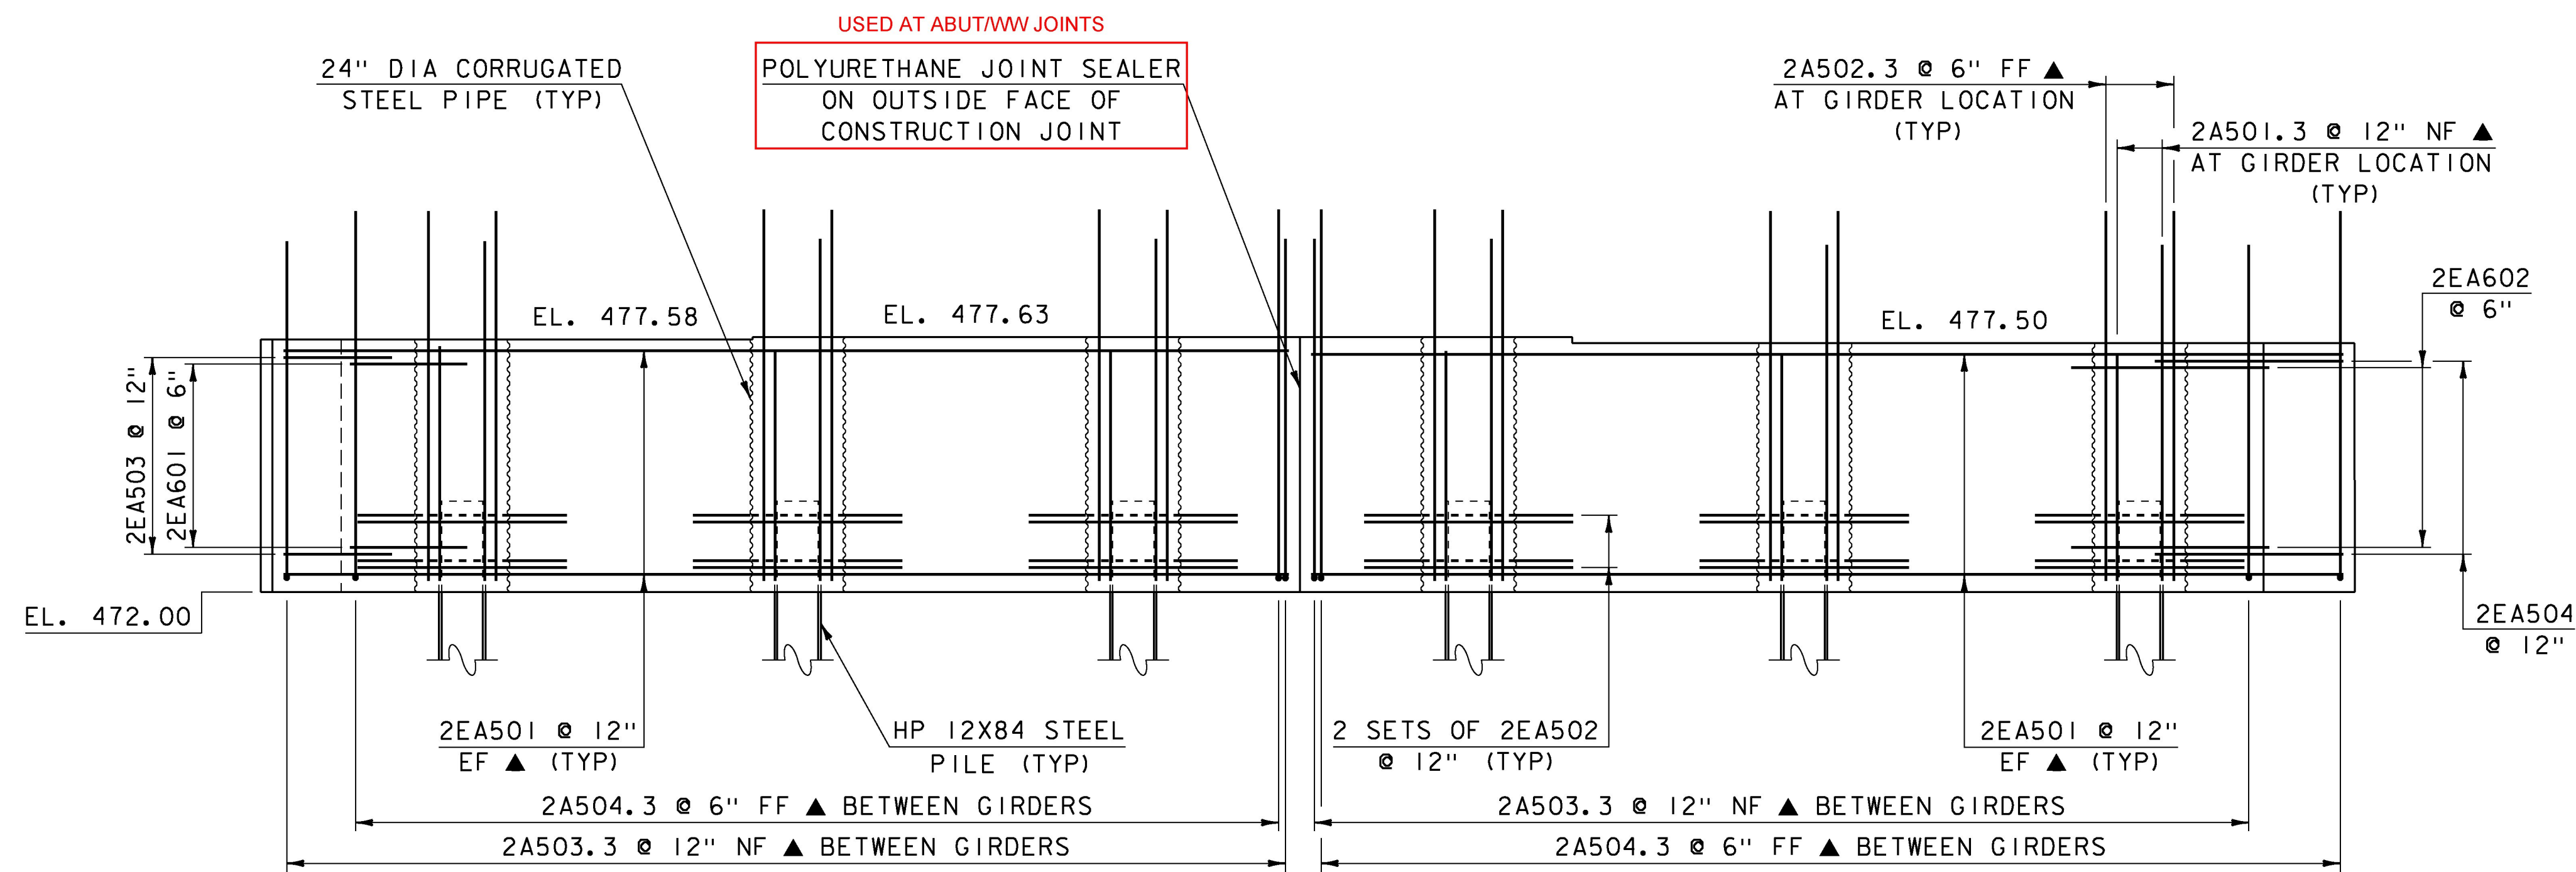

PRECAST ABUTMENT NO. 2 ELEVATION

SCALE:  $\frac{3}{8}$ " = 1'-0"

**NOTE:**

- NF = NEAR FACE
- FF = FAR FACE
- EF = EACH FACE
- ▲ = CUT TO FIT IN FIELD
- 3" CLR. UNLESS OTHERWISE NOTED
- 2'-2" BAR LAP UNLESS OTHERWISE NOTED

PROJECT NAME: BRADFORD	PLOT DATE: 02-NOV-2016
PROJECT NUMBER: BF 0191 (29)	DRAWN BY: G. ROY
FILE NAME: sl3c054sub.dgn	CHECKED BY: M. EVANS-MONGEON
PROJECT LEADER: C. CARLSON	PRECAST ABUTMENT NO. 2 DETAILS
DESIGNED BY: M. EVANS-MONGEON	SHEET 37 OF 71