



11+00


STA 11+00.00
BEGIN APPROACH
MATCH EXISTING

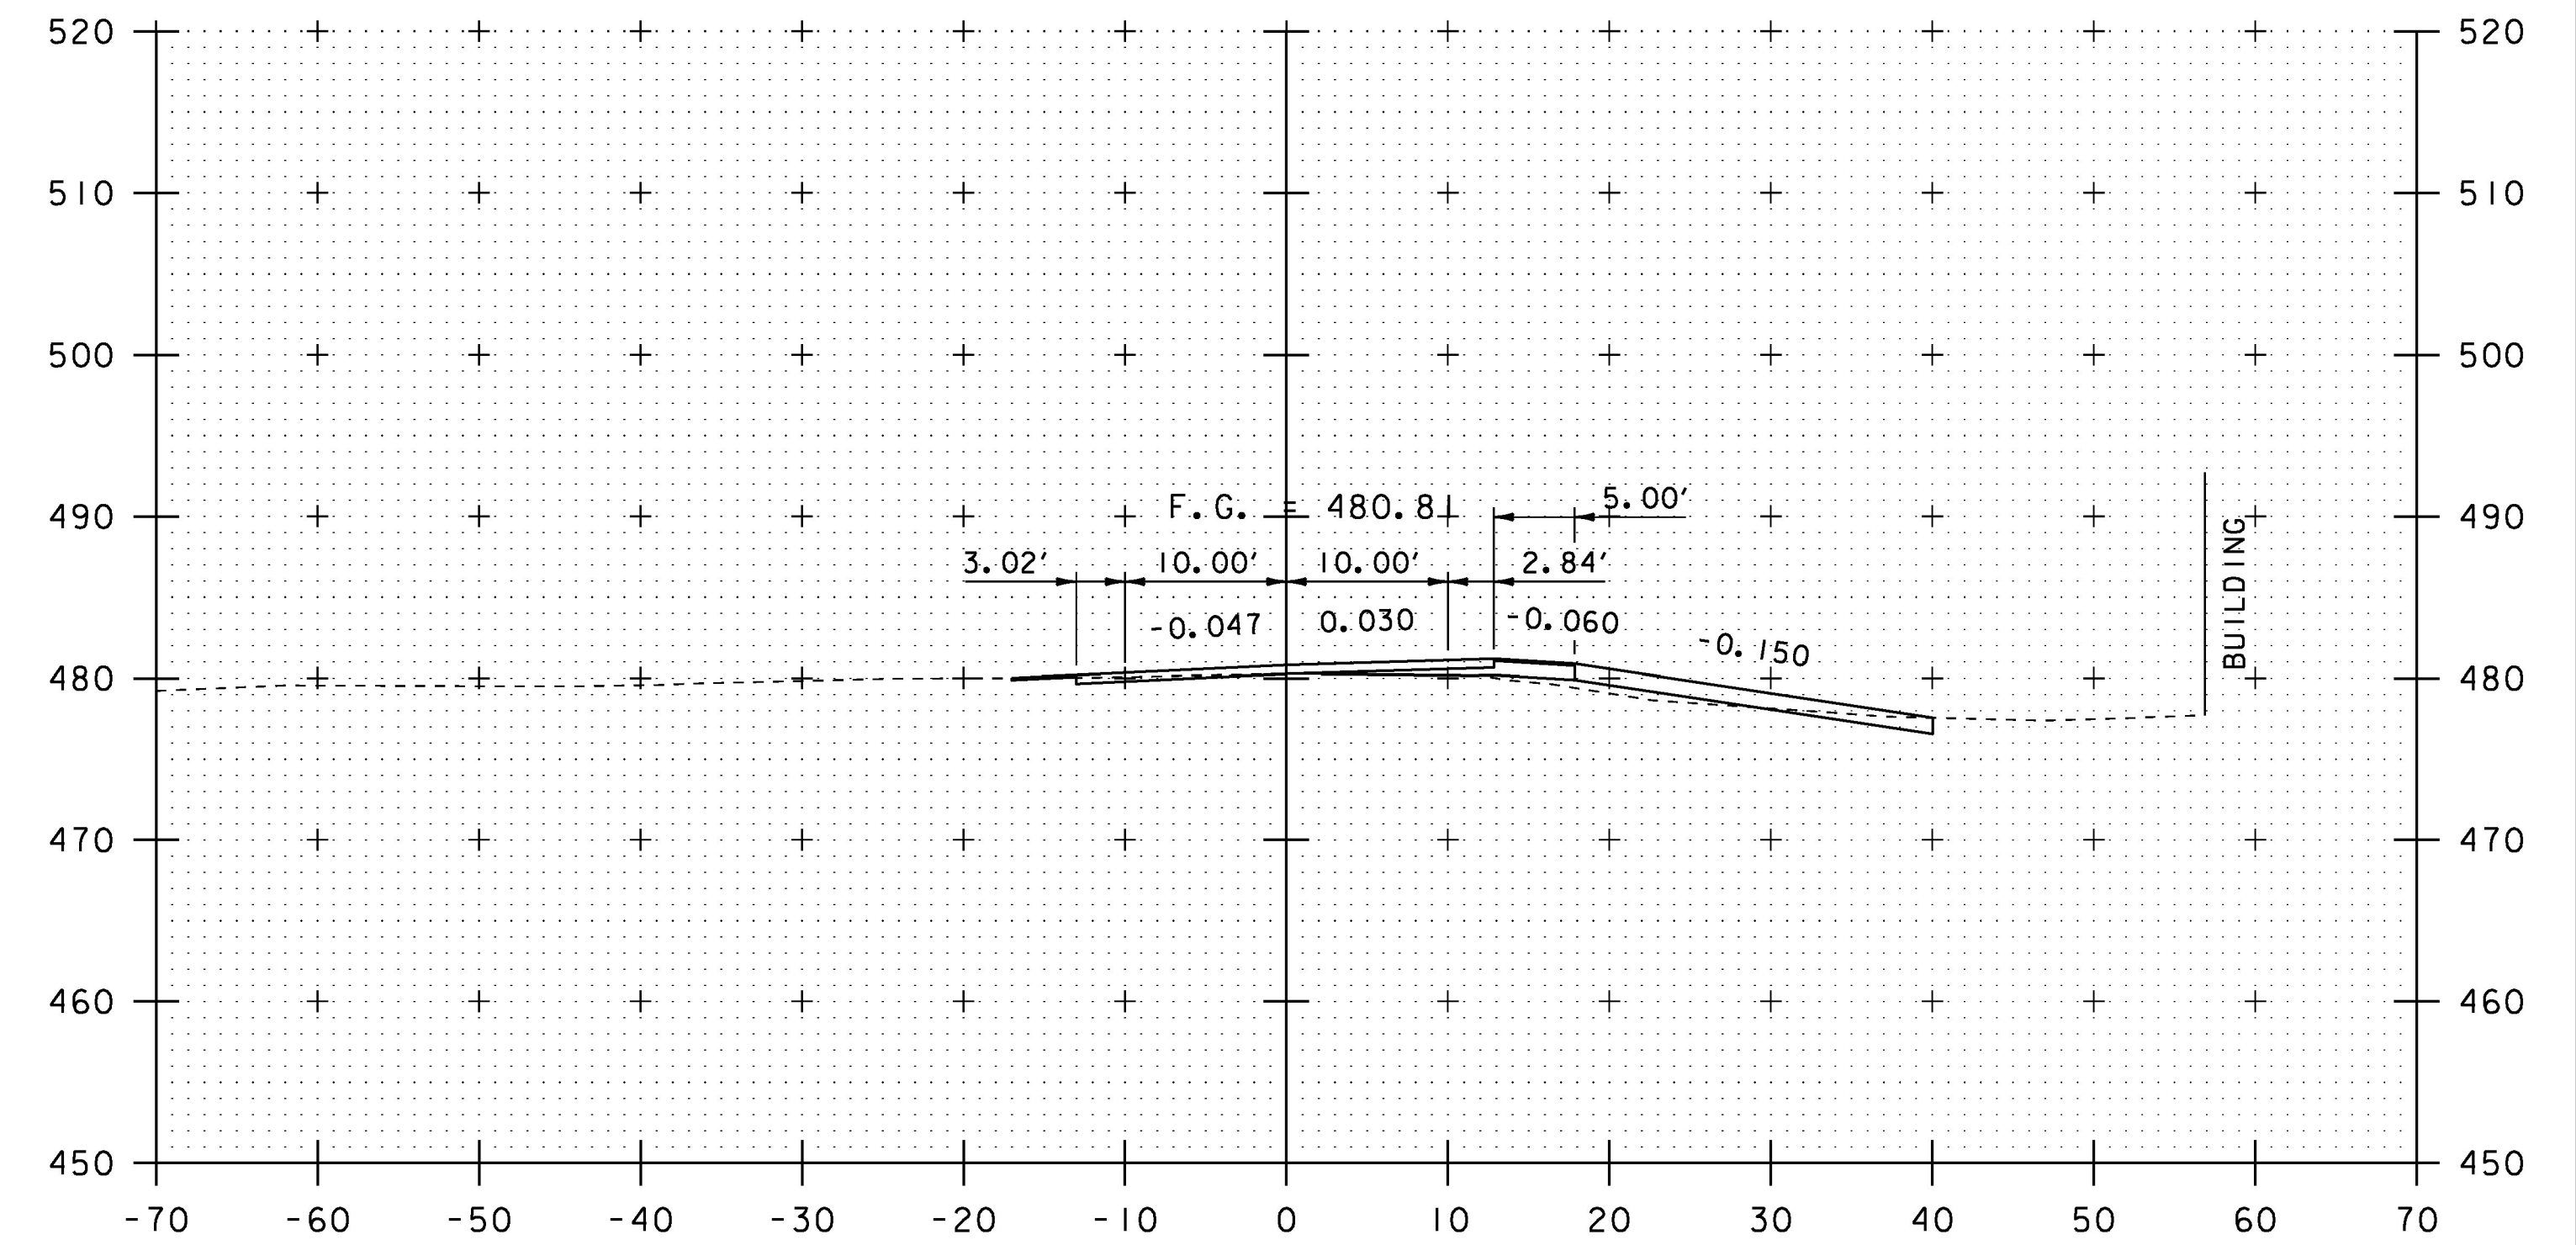

11+50

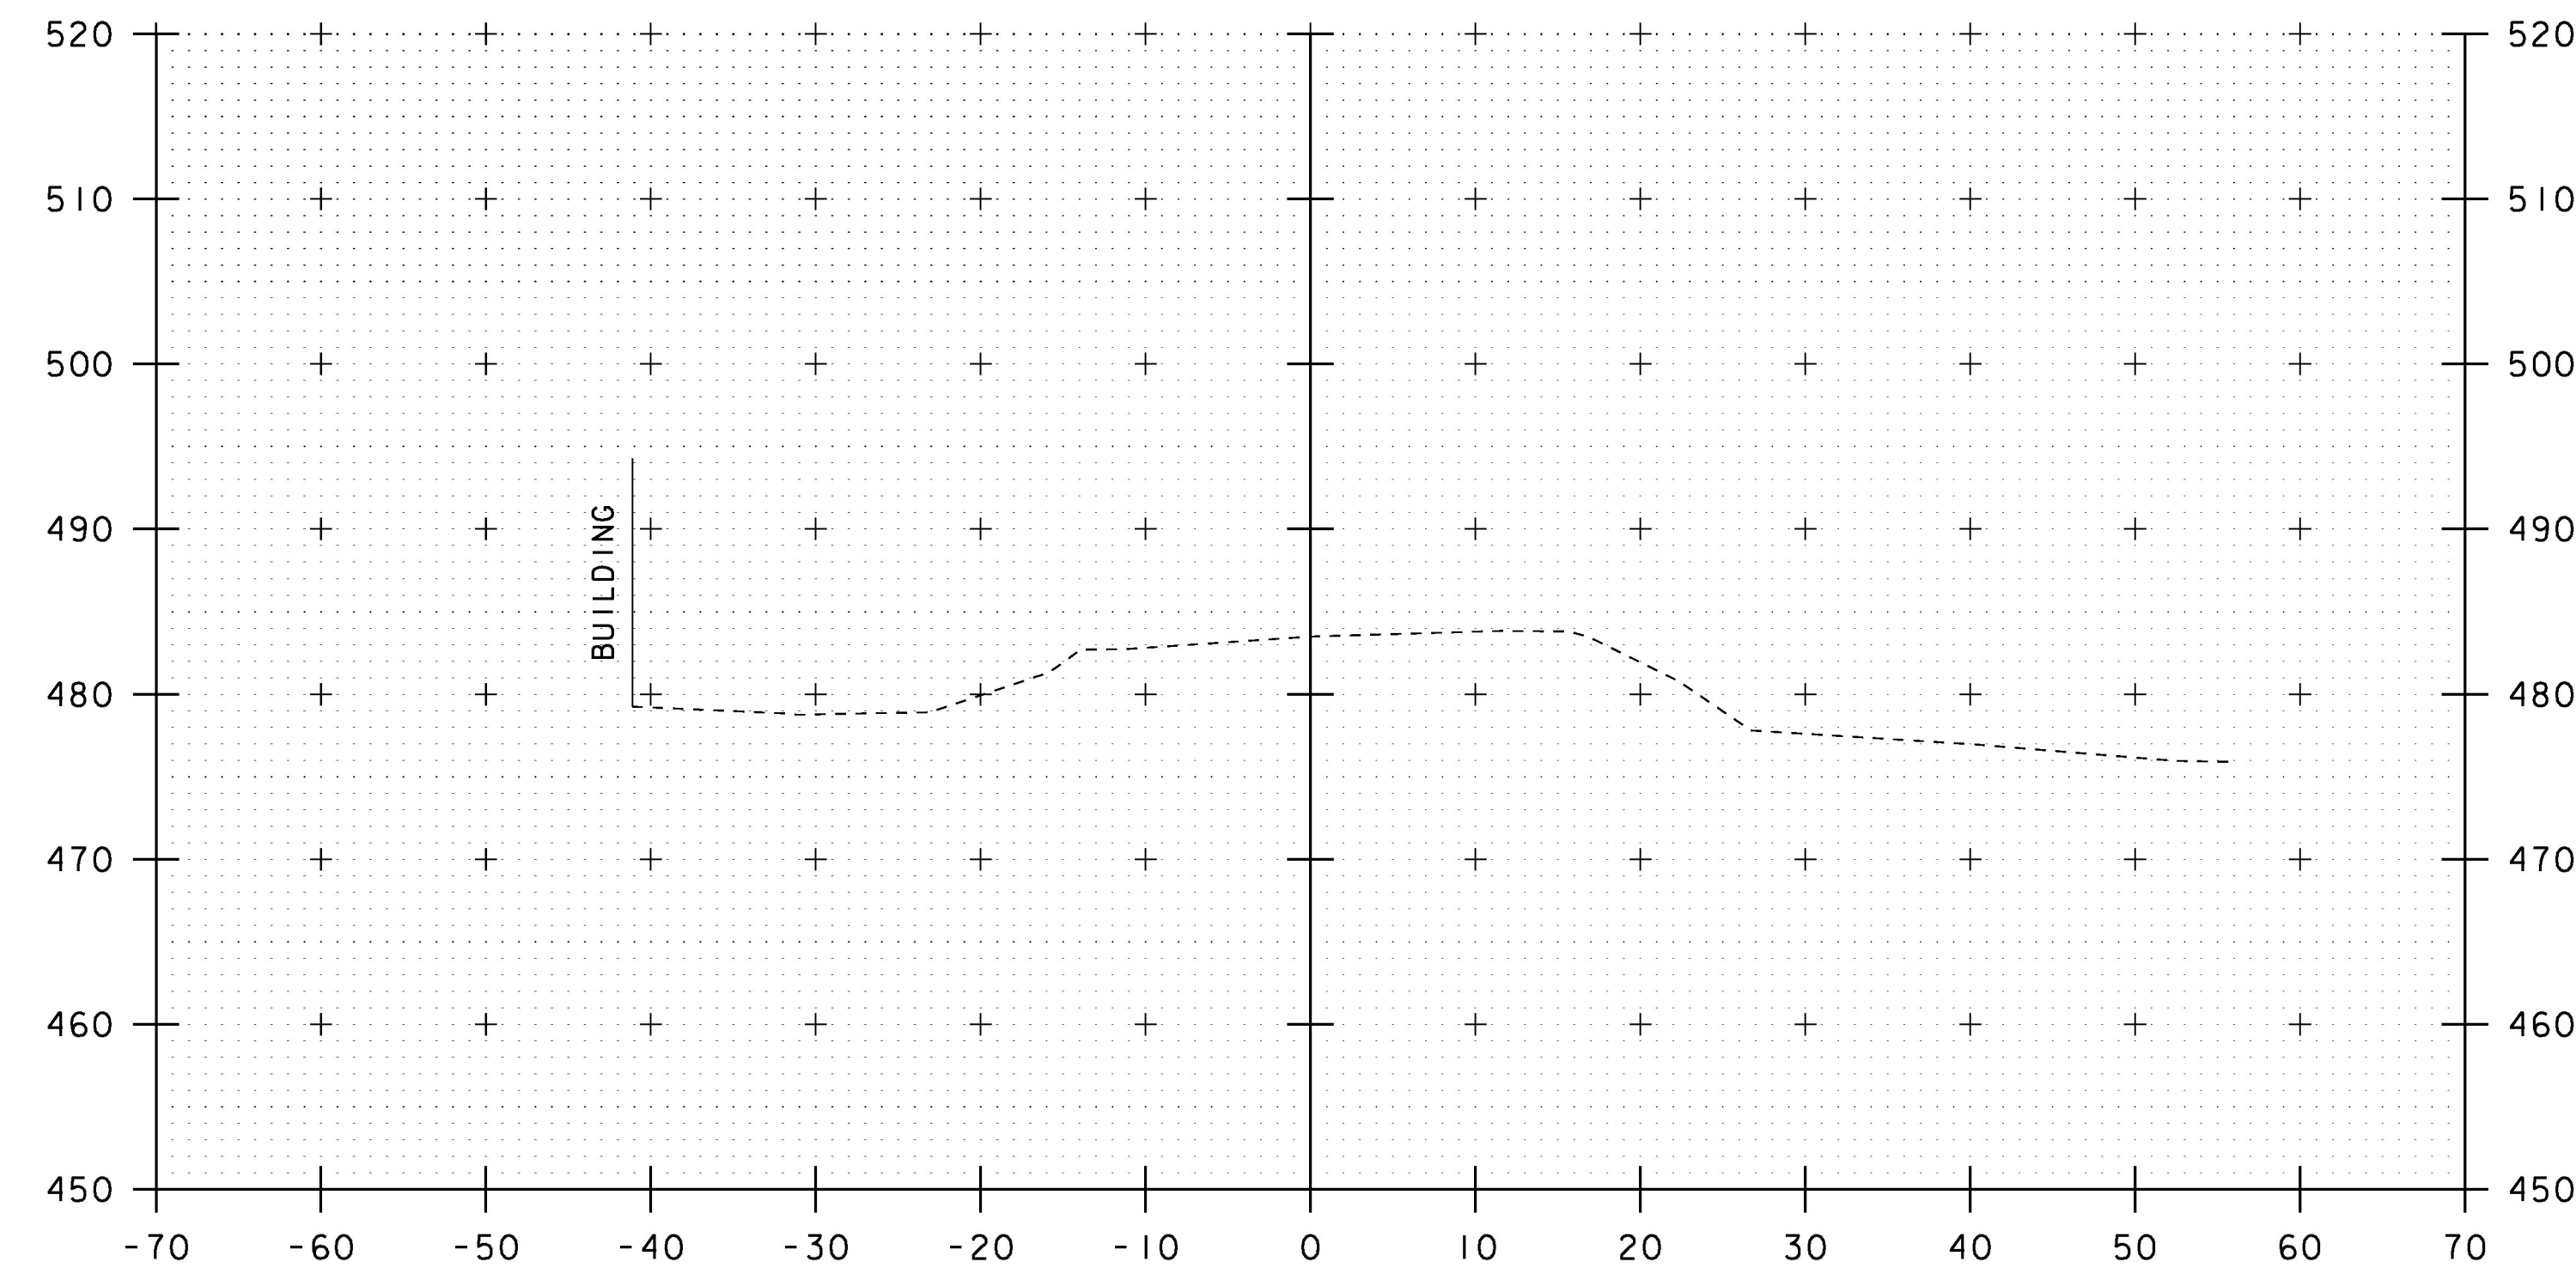


10+75

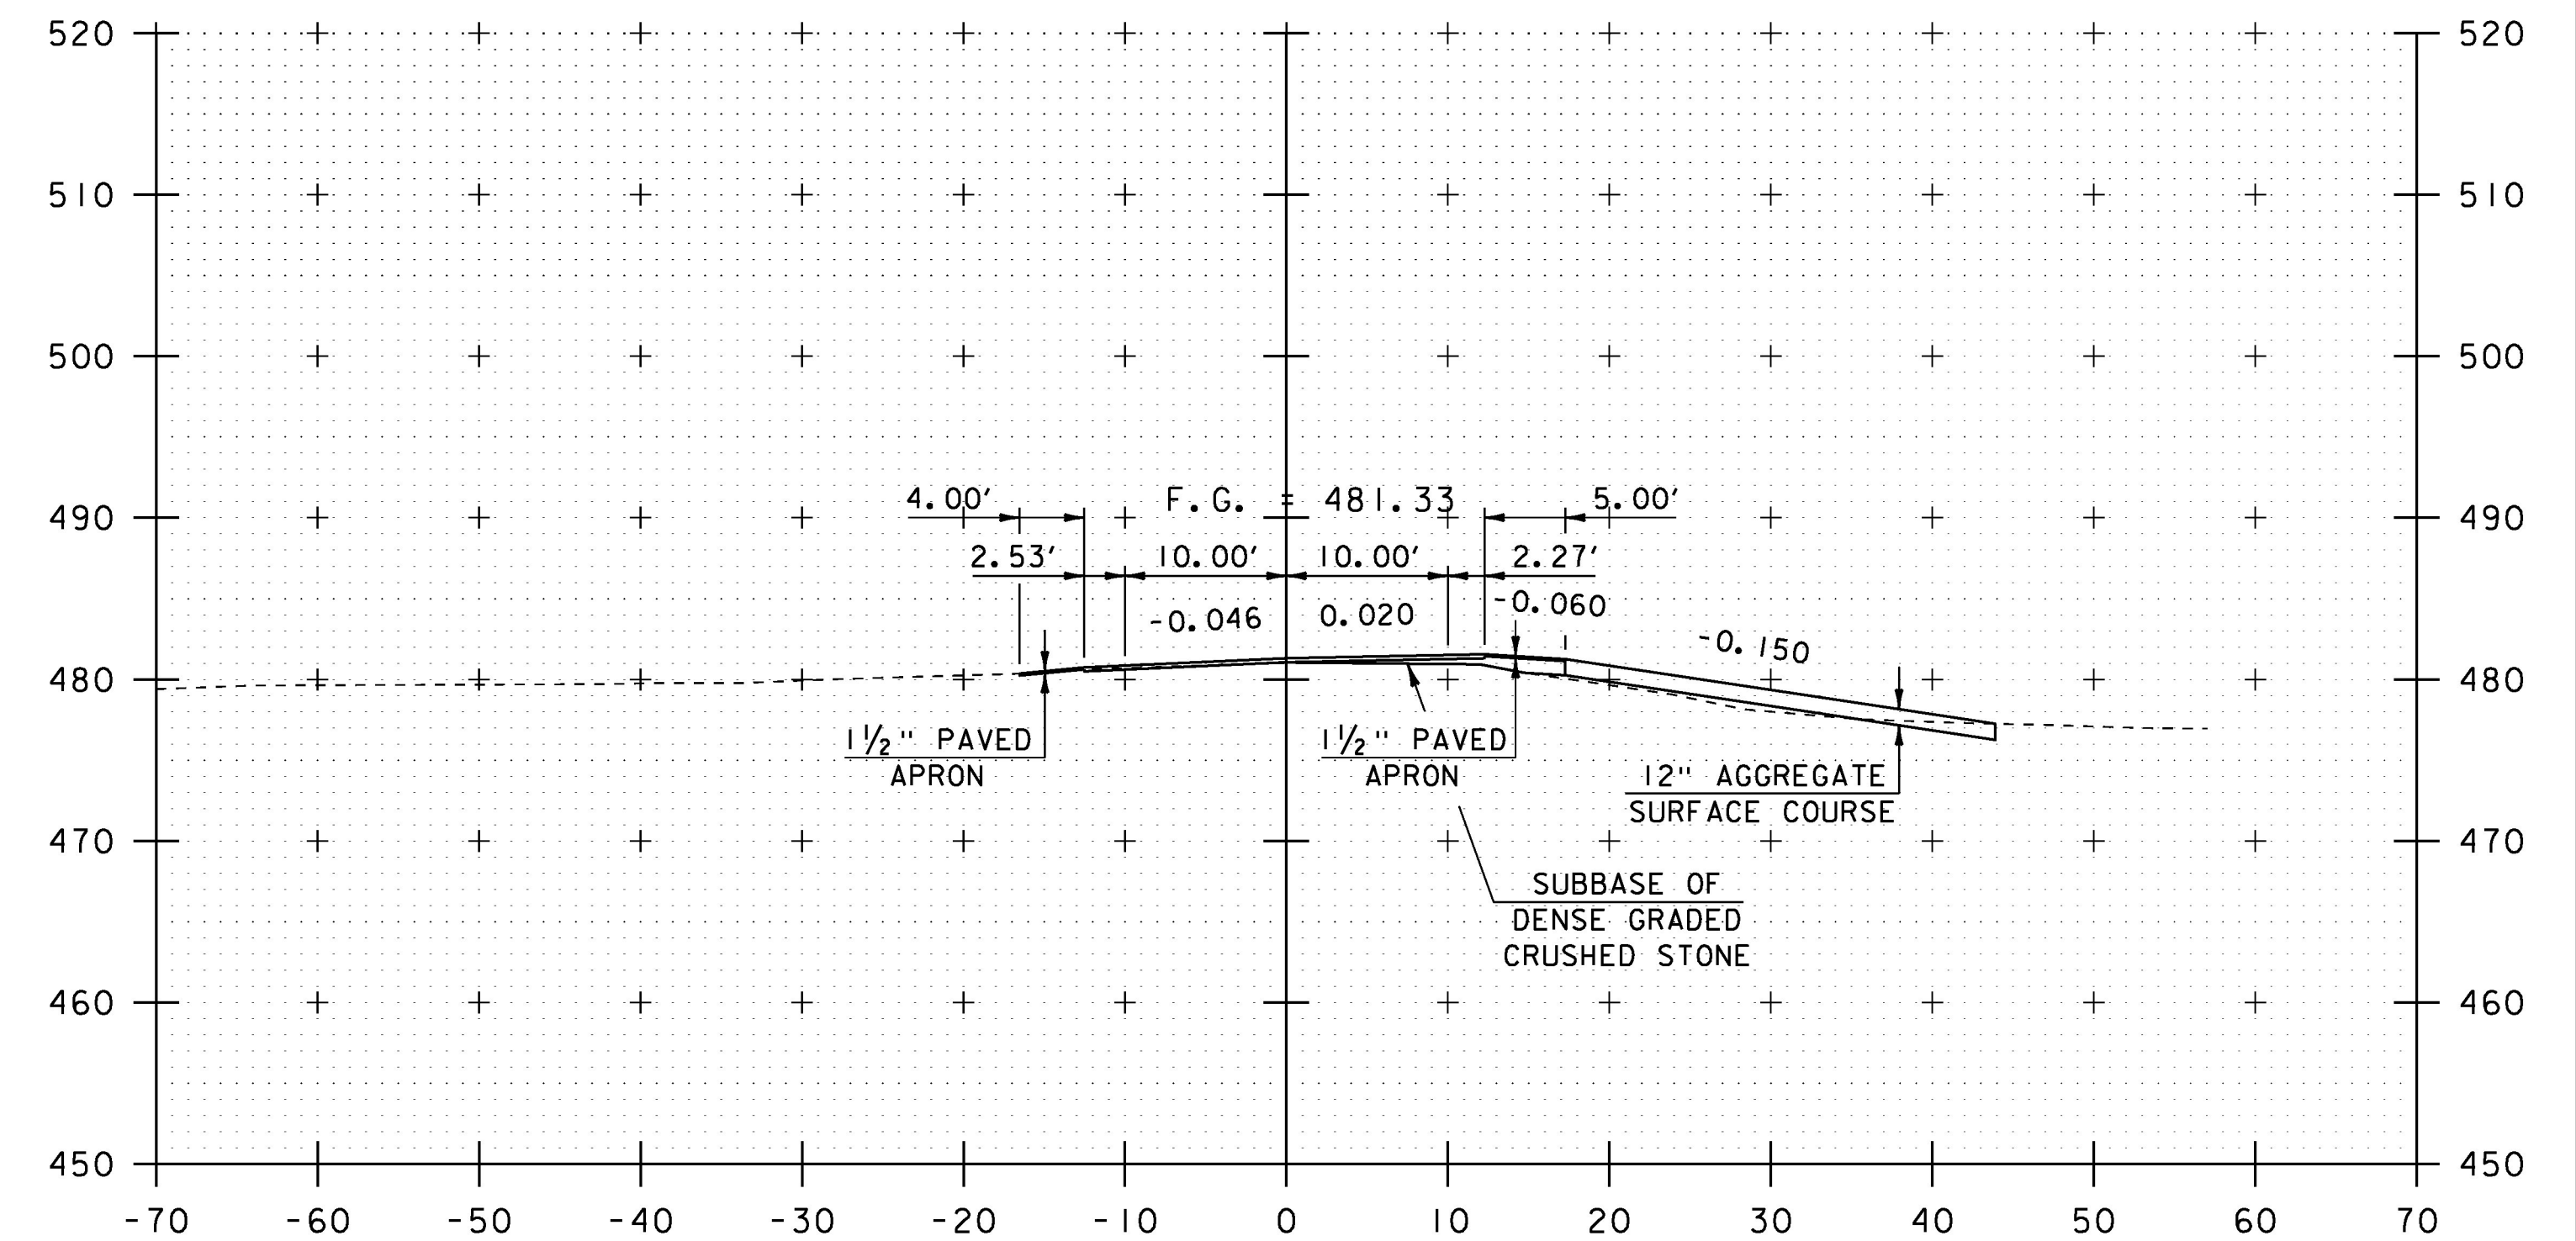

11+25

STA 11+06.8 LT - STA 11+72.7 LT
CONSTRUCT 4' PAVED APRON

STA 11+04.2 RT - STA 11+87.5 RT
CONSTRUCT 5' PAVED APRON WITH
AGGREGATE SURFACE COURSE DRIVE

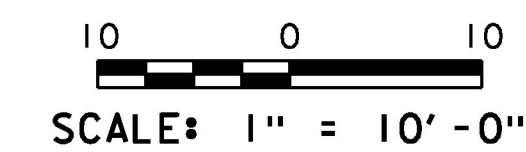

STA. 10+75 TO STA. 11+50

PROJECT NAME: BRADFORD	PLOT DATE: 15-SEP-2016
PROJECT NUMBER: BF 0191 (29)	DRAWN BY: G. ROY
FILE NAME: s13c054xsl.dgn	CHECKED BY: M. EVANS-MONGEON
PROJECT LEADER: C. CARLSON	SHEET 42 OF 71
DESIGNED BY: G. ROY	
VT 25B CROSS SECTION (1)	