




13+00

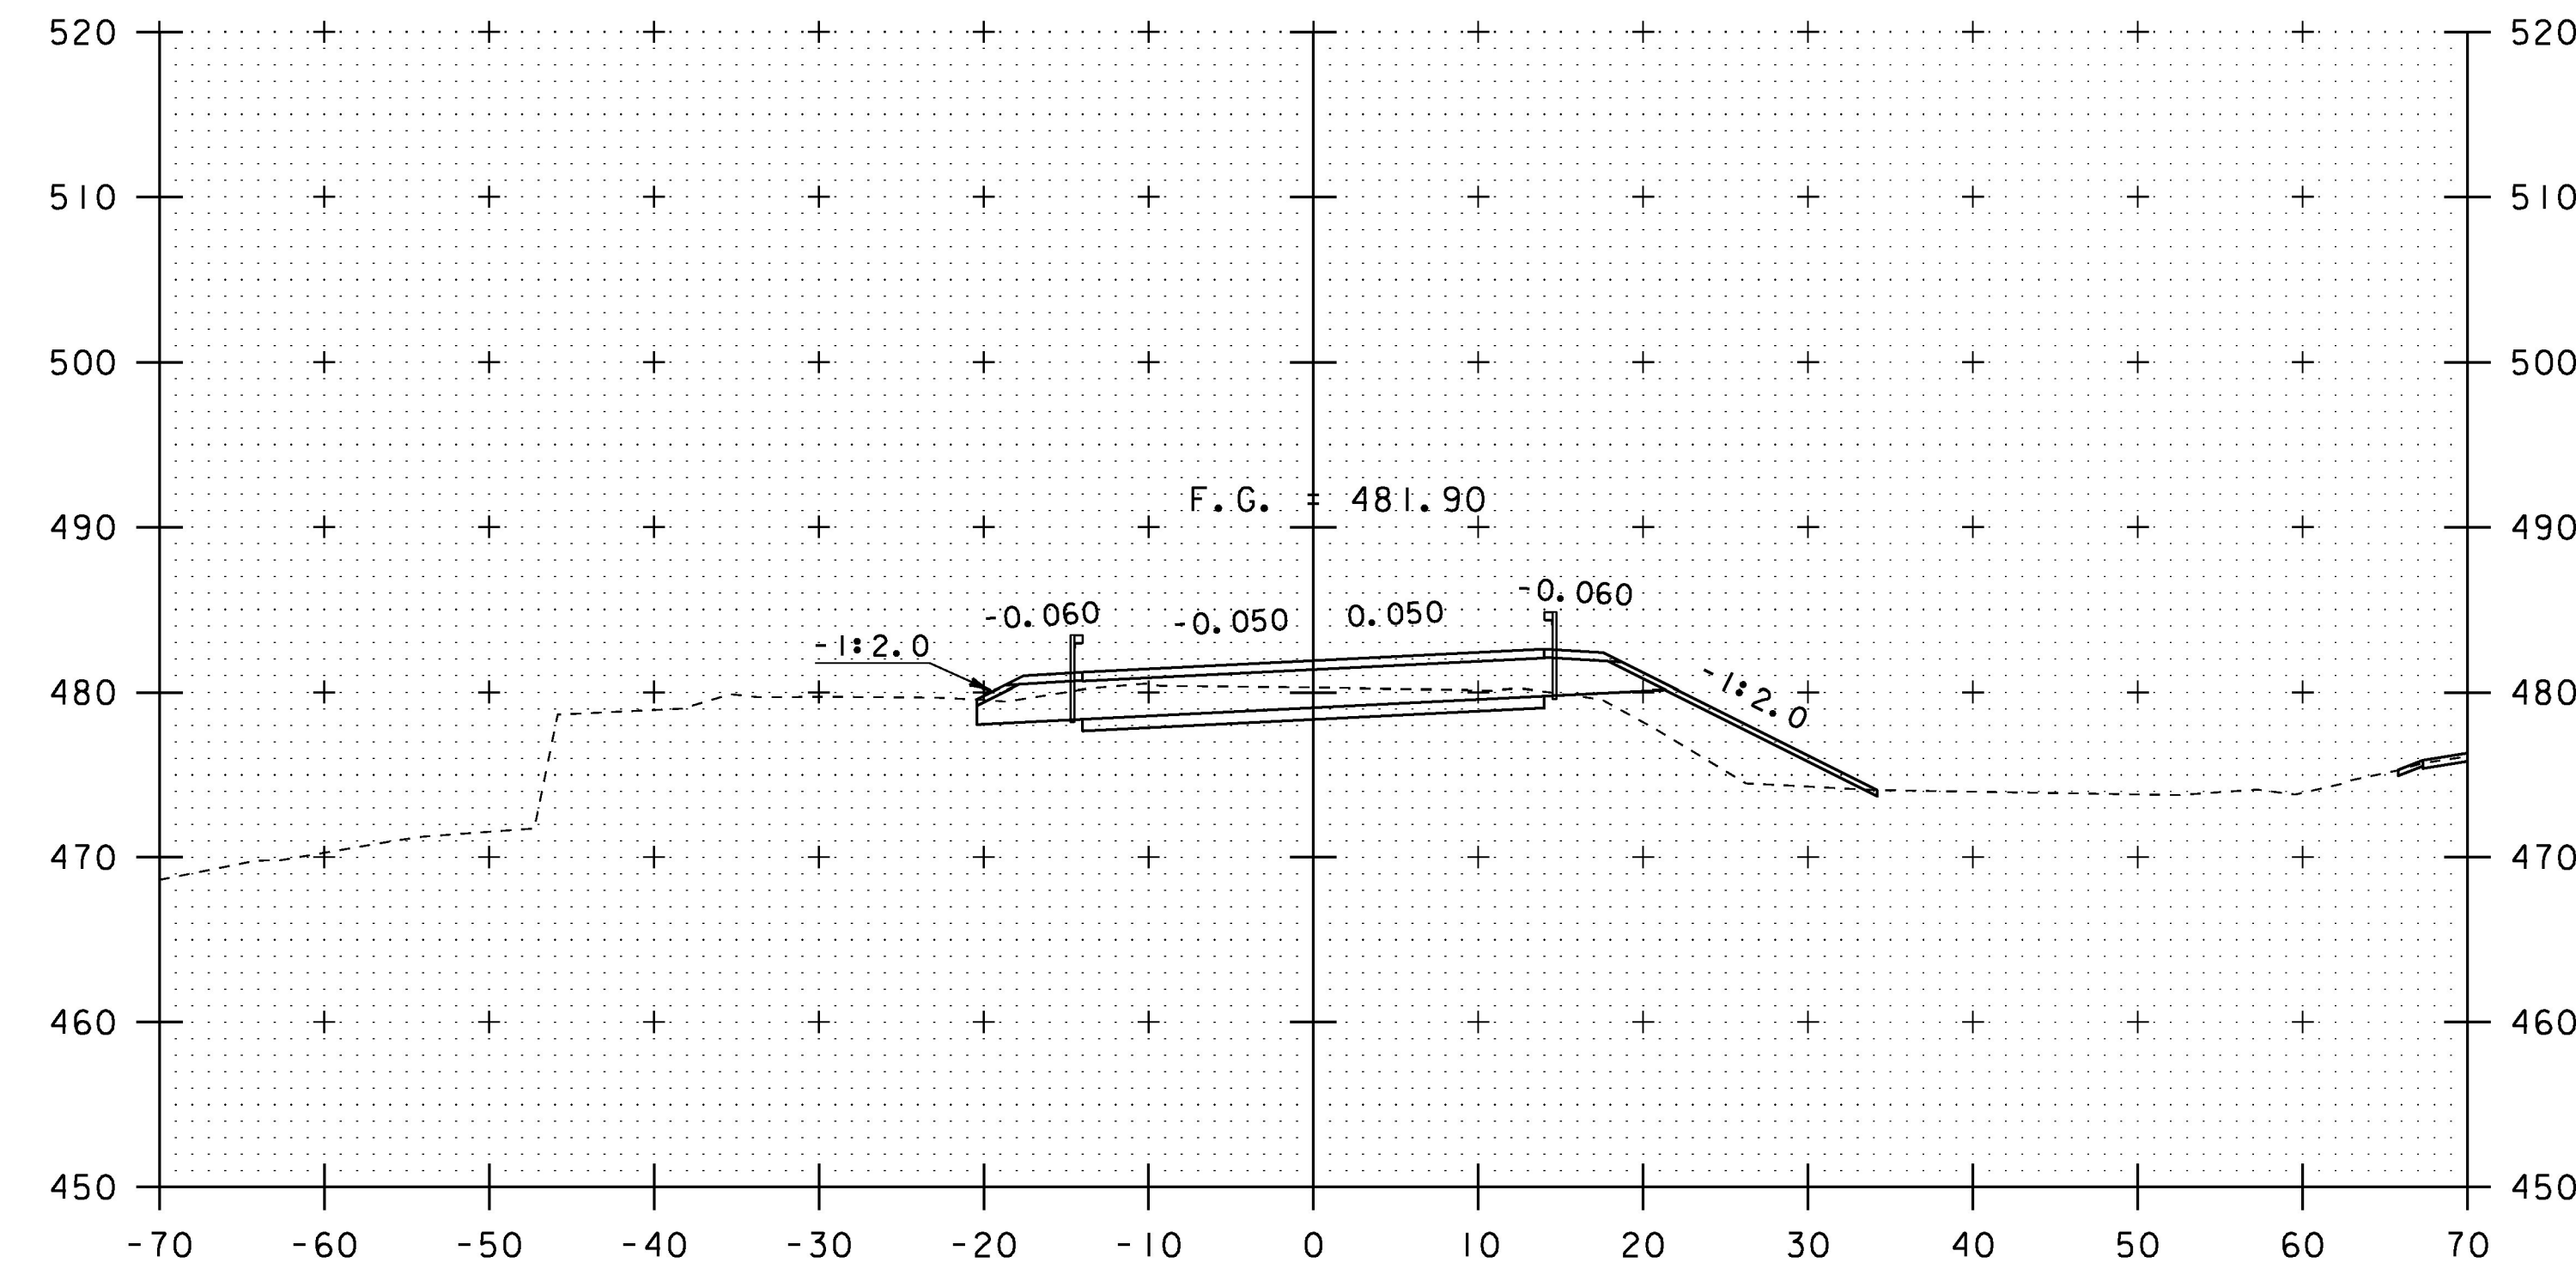


13+50

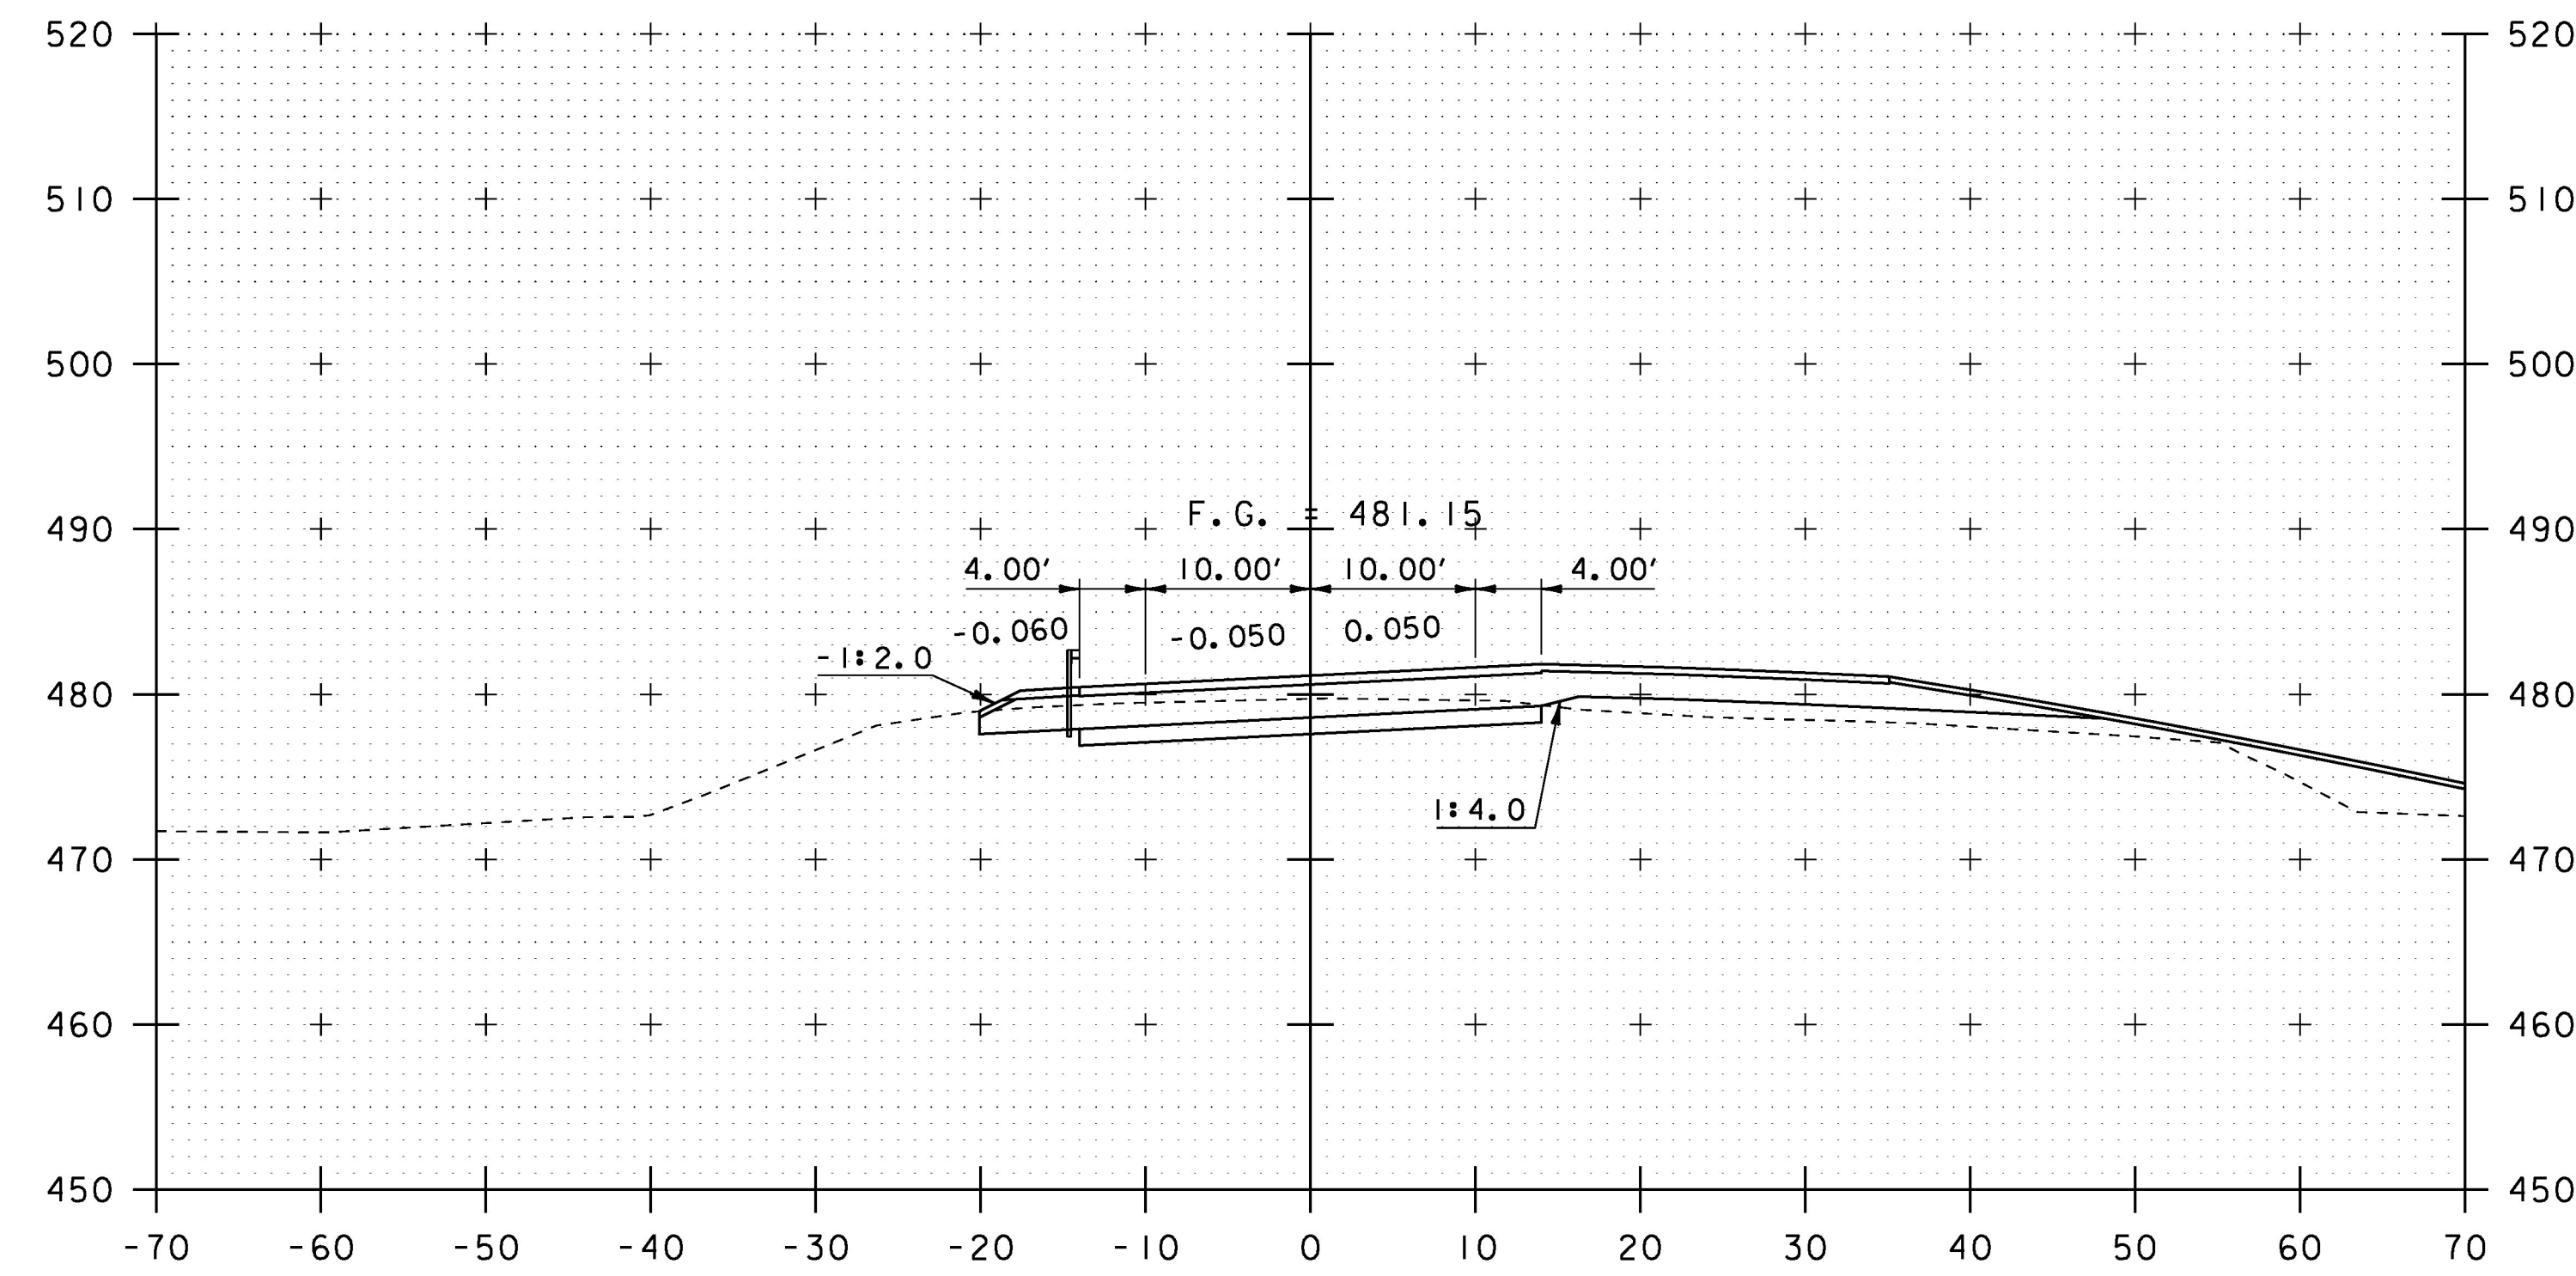

12+75

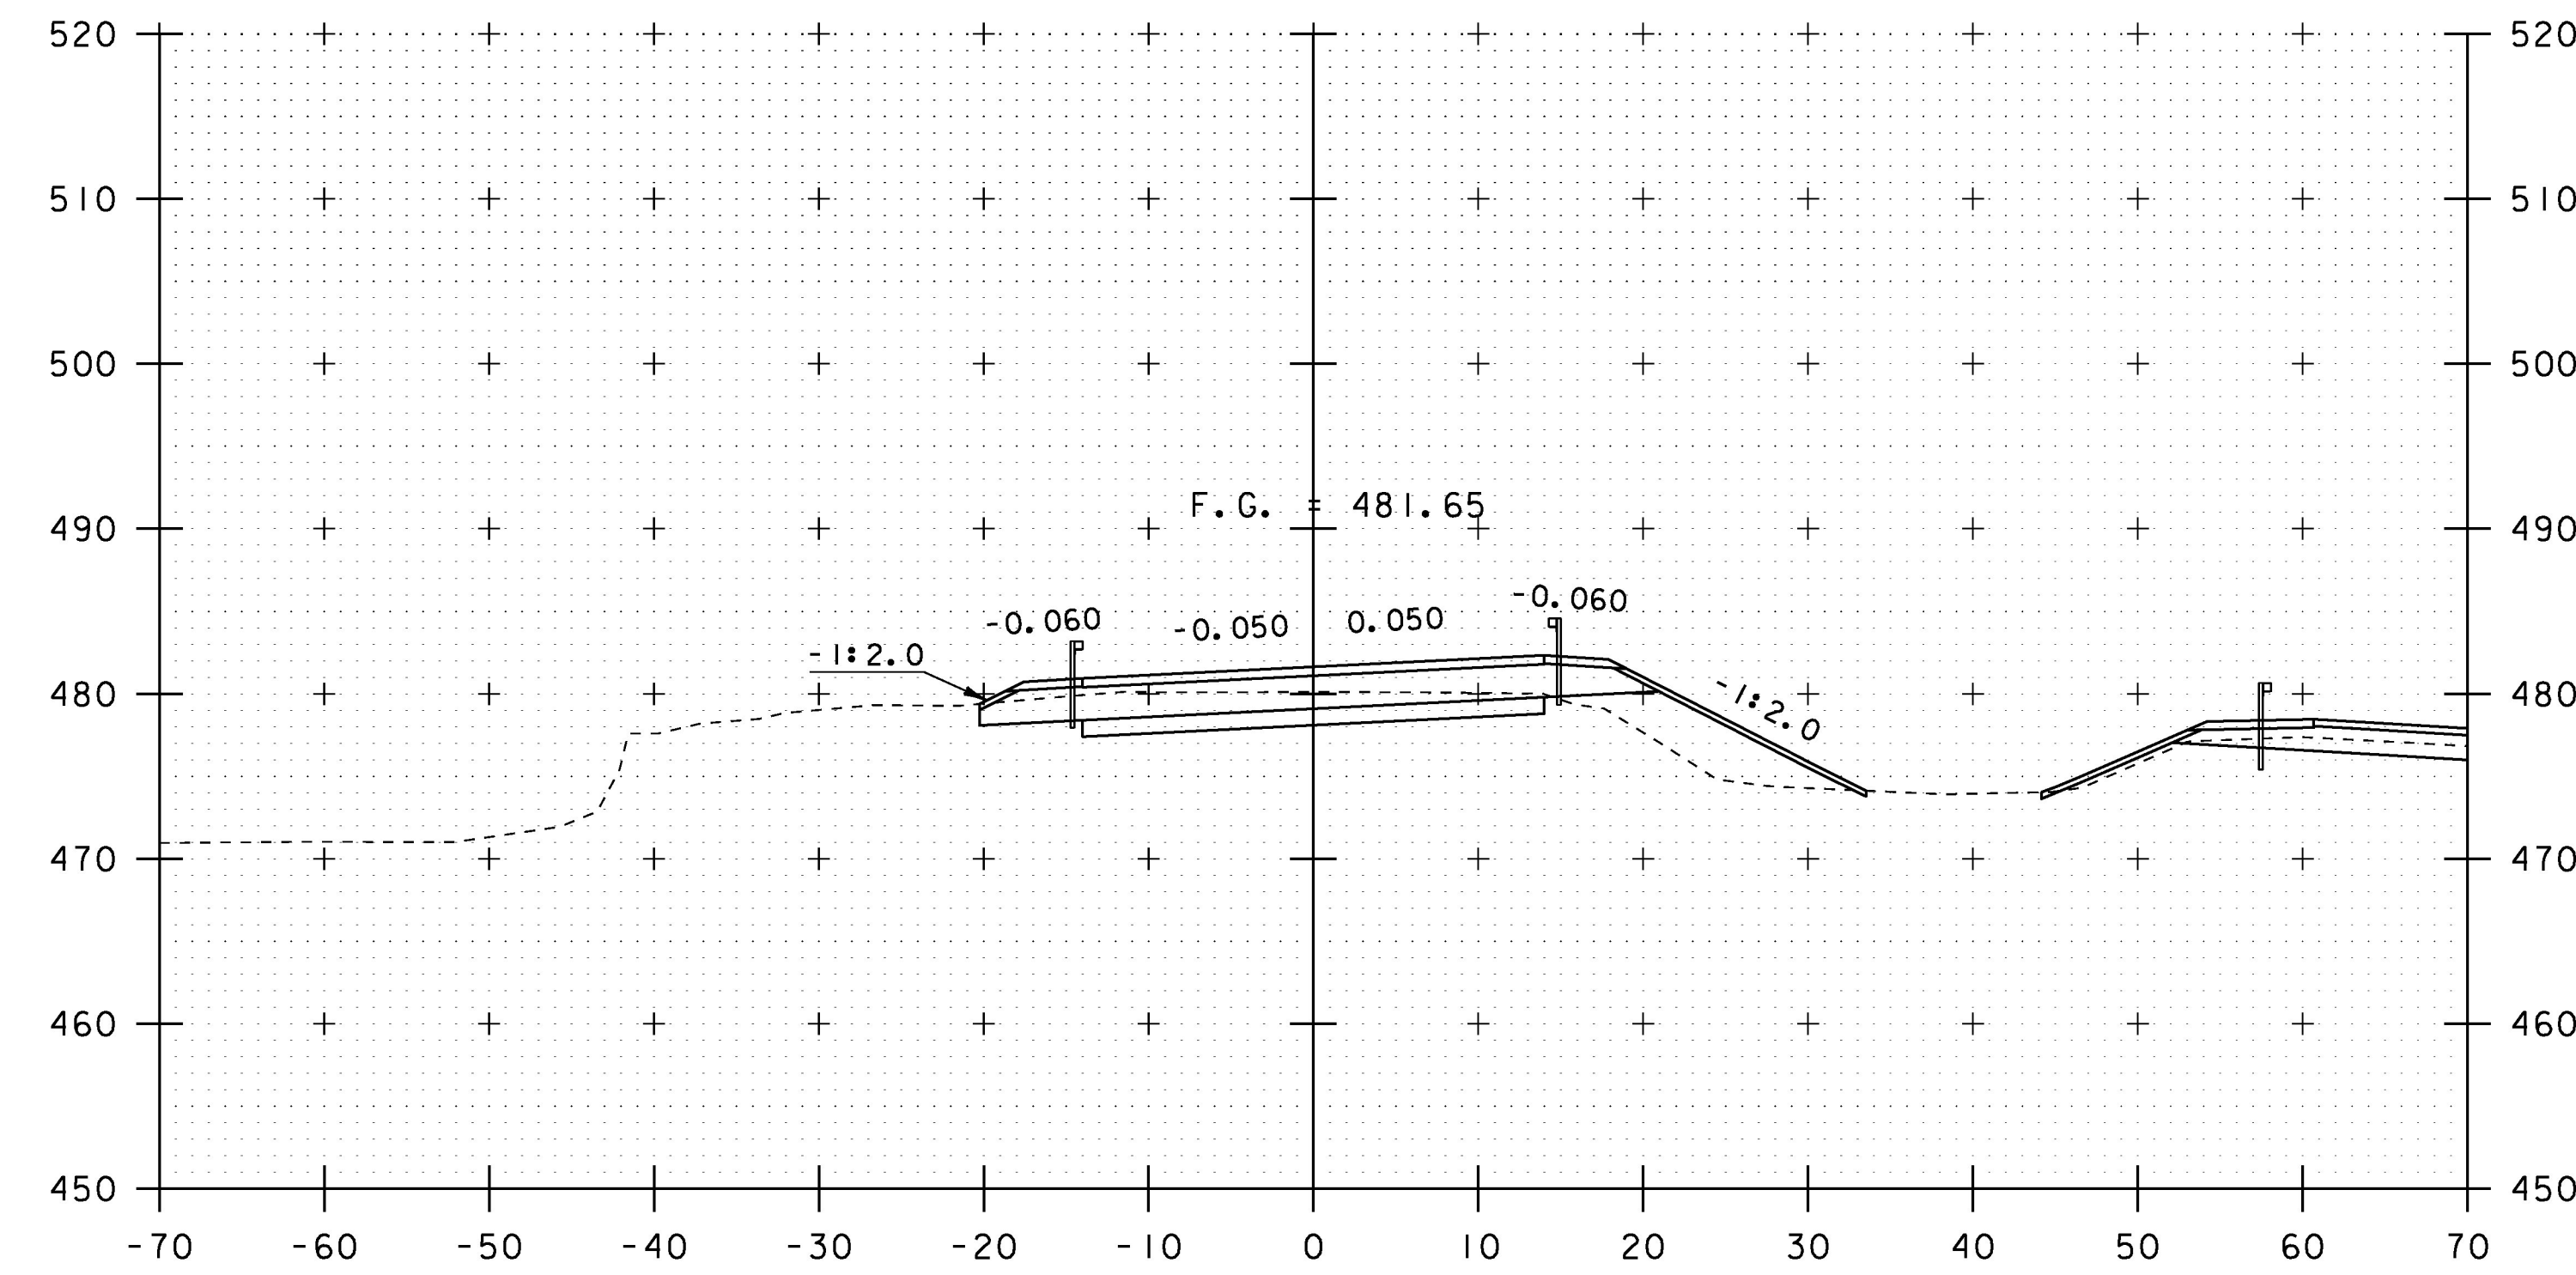

13+25

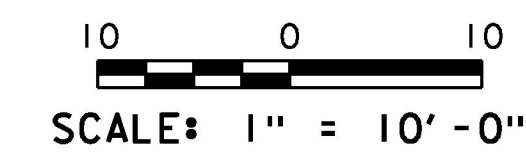

STA. 12+75 TO STA. 13+50

PROJECT NAME: BRADFORD	PLOT DATE: 15-SEP-2016
PROJECT NUMBER: BF 0191 (29)	DRAWN BY: G. ROY
FILE NAME: s13c054xsl.dgn	CHECKED BY: M. EVANS-MONGEON
PROJECT LEADER: C. CARLSON	SHEET 44 OF 71
DESIGNED BY: G. ROY	
VT 25B CROSS SECTION (3)	