




16+00

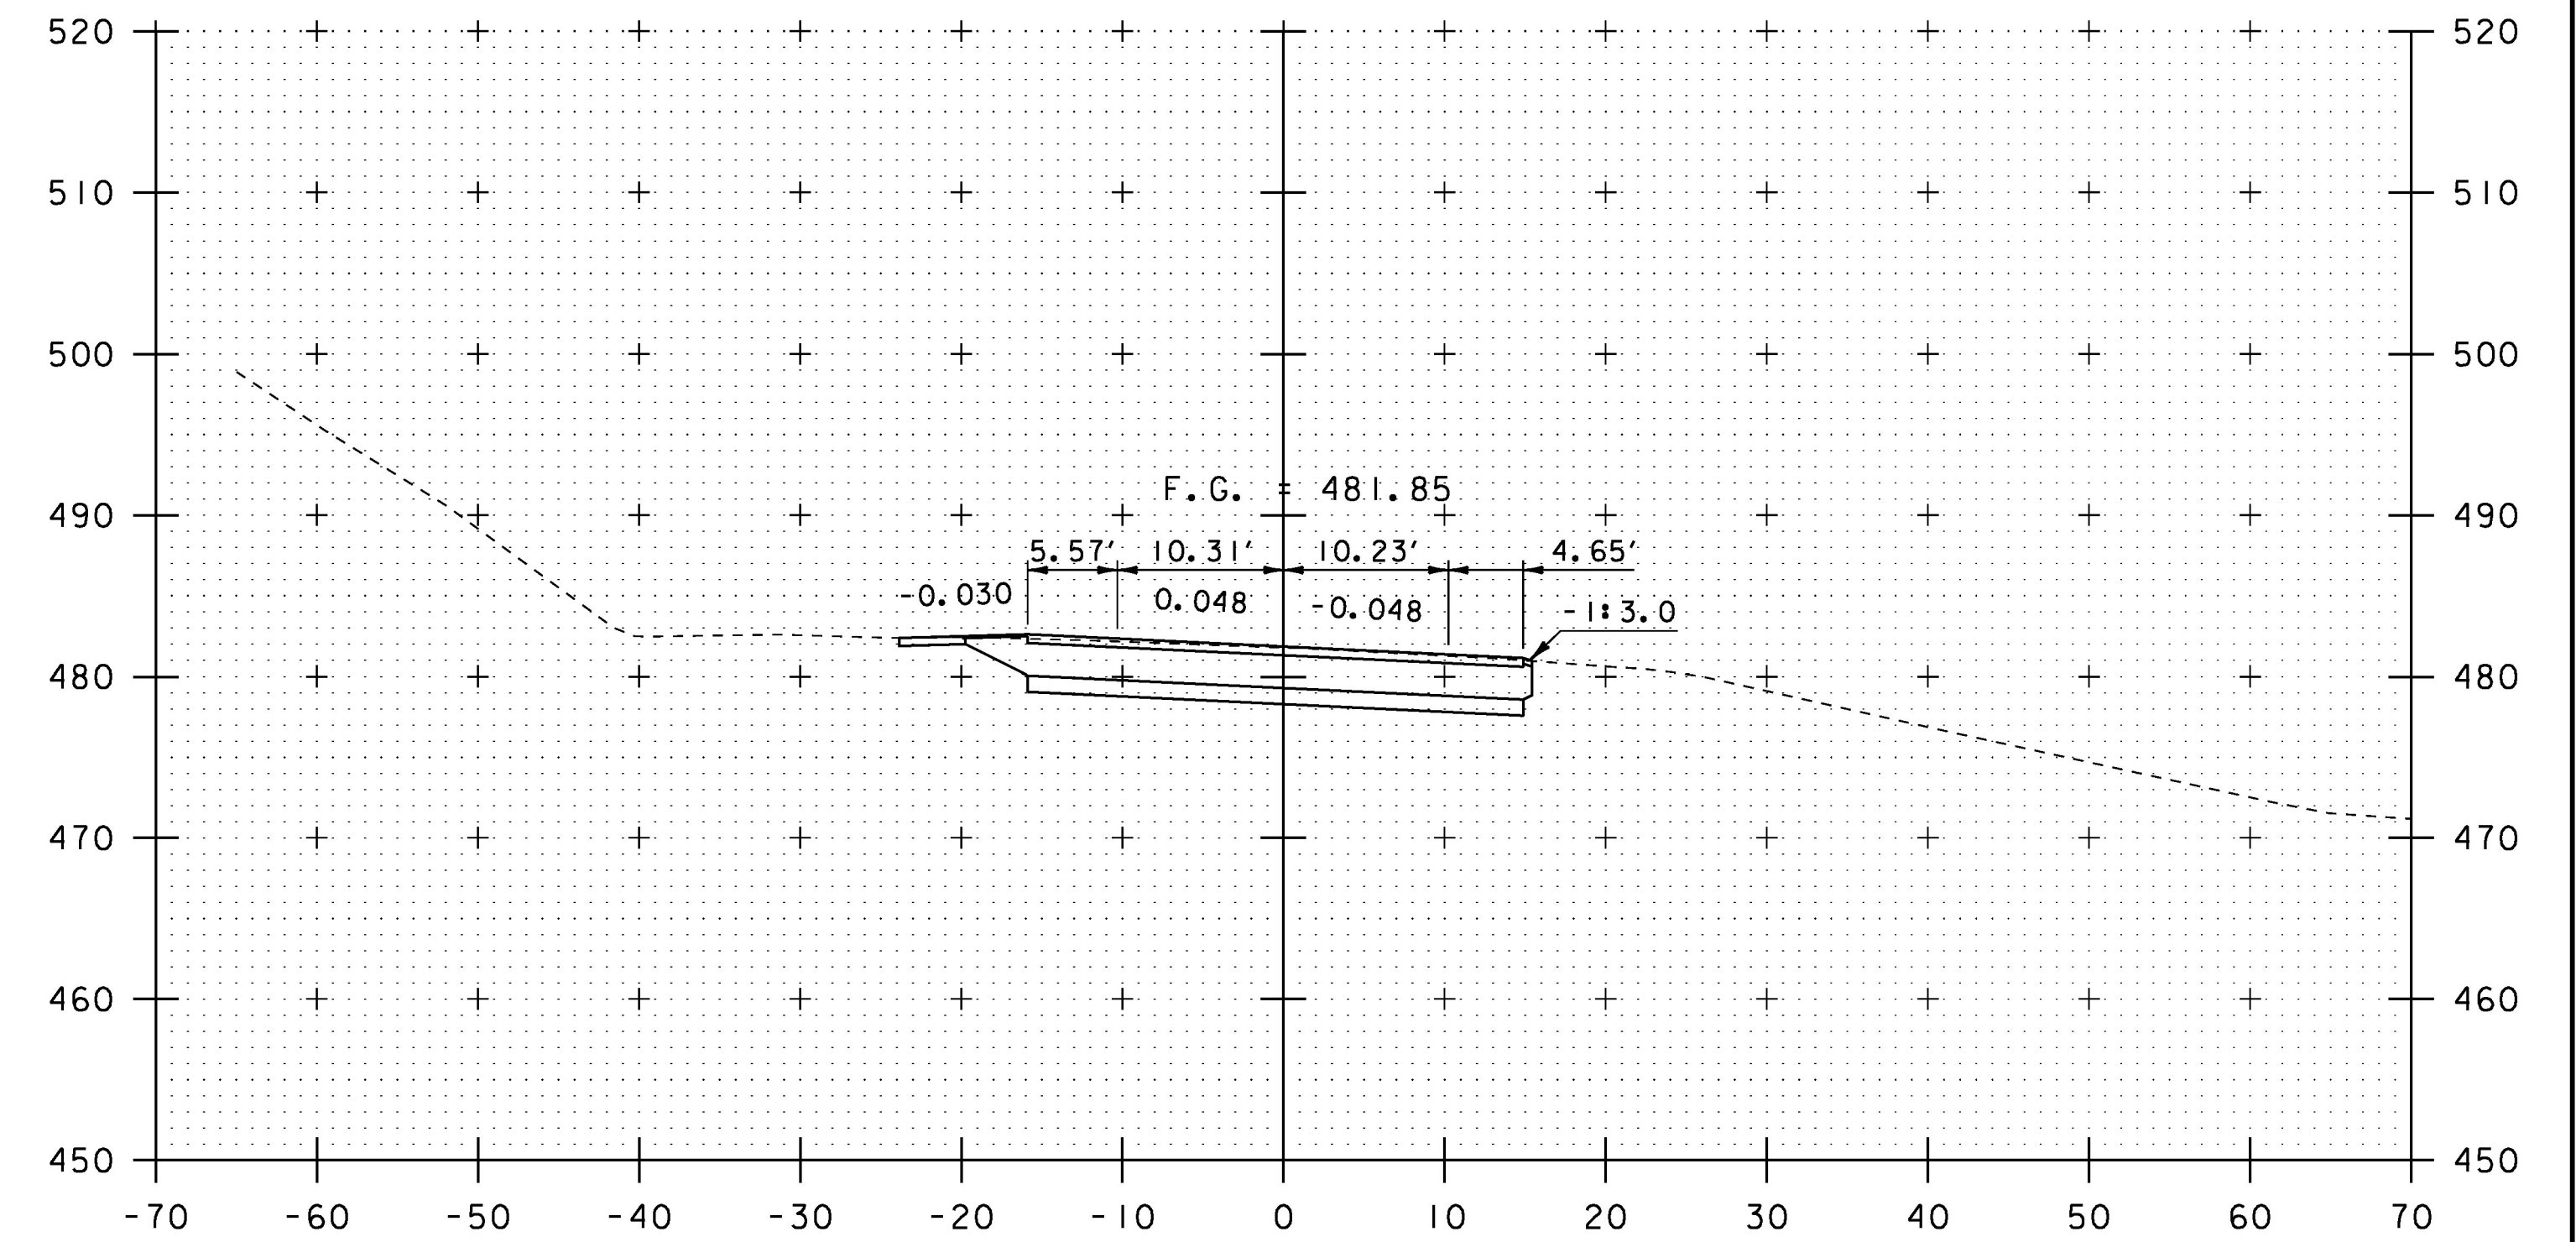

16+50

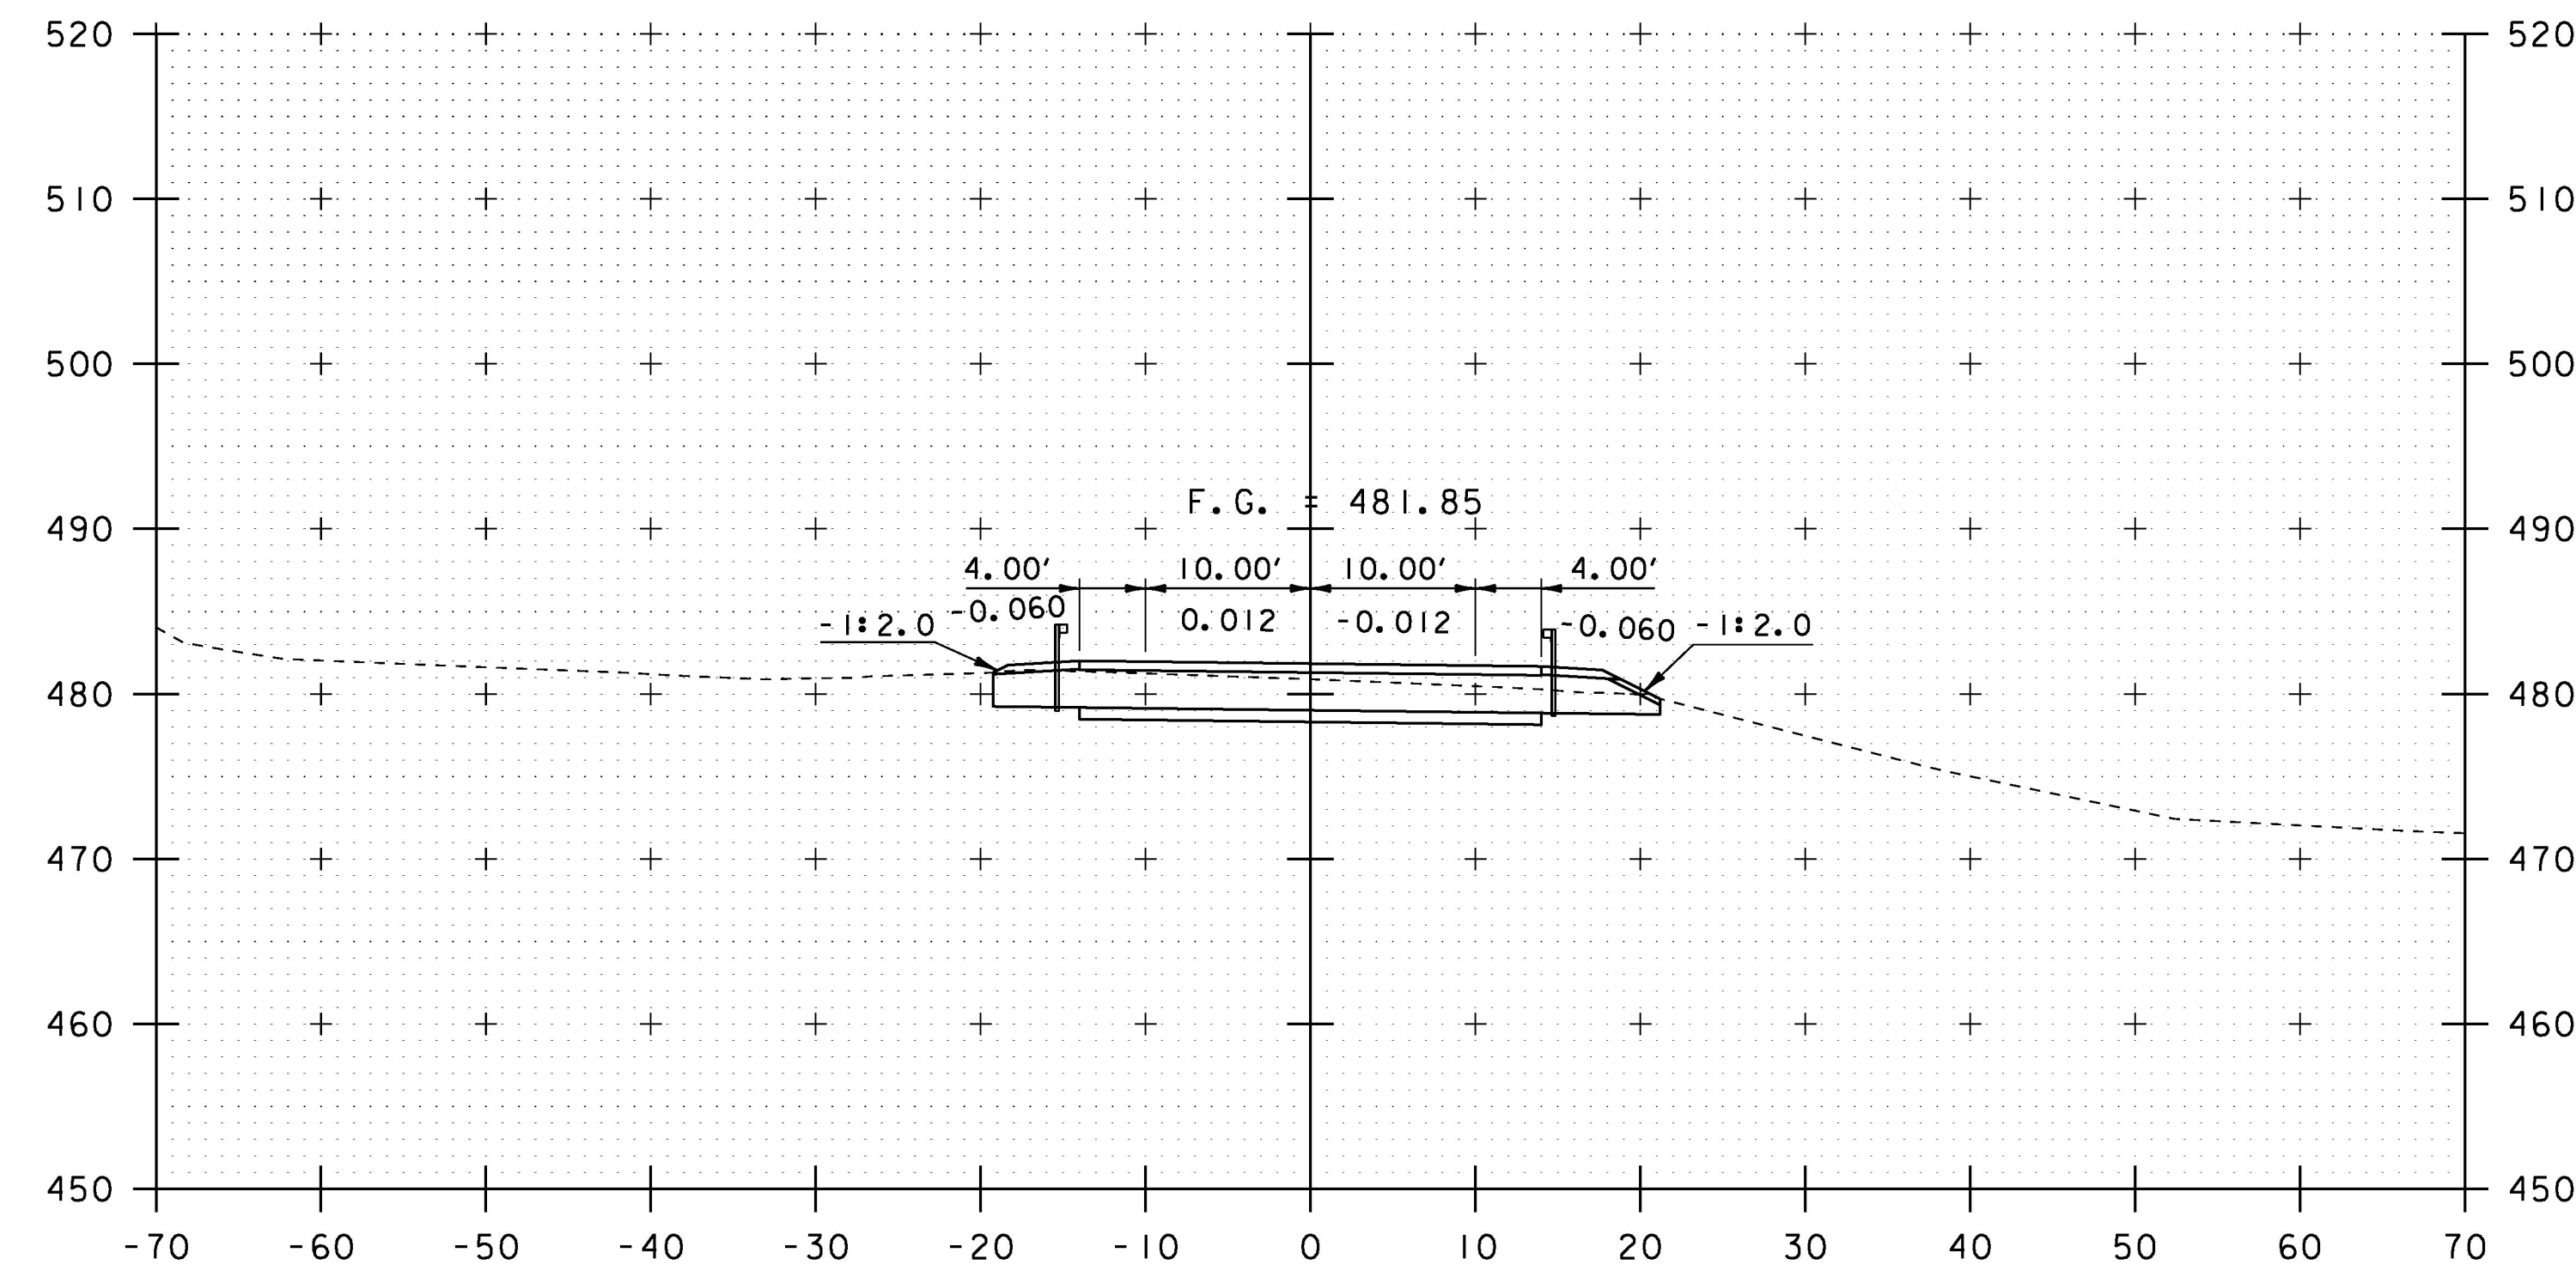


15+75

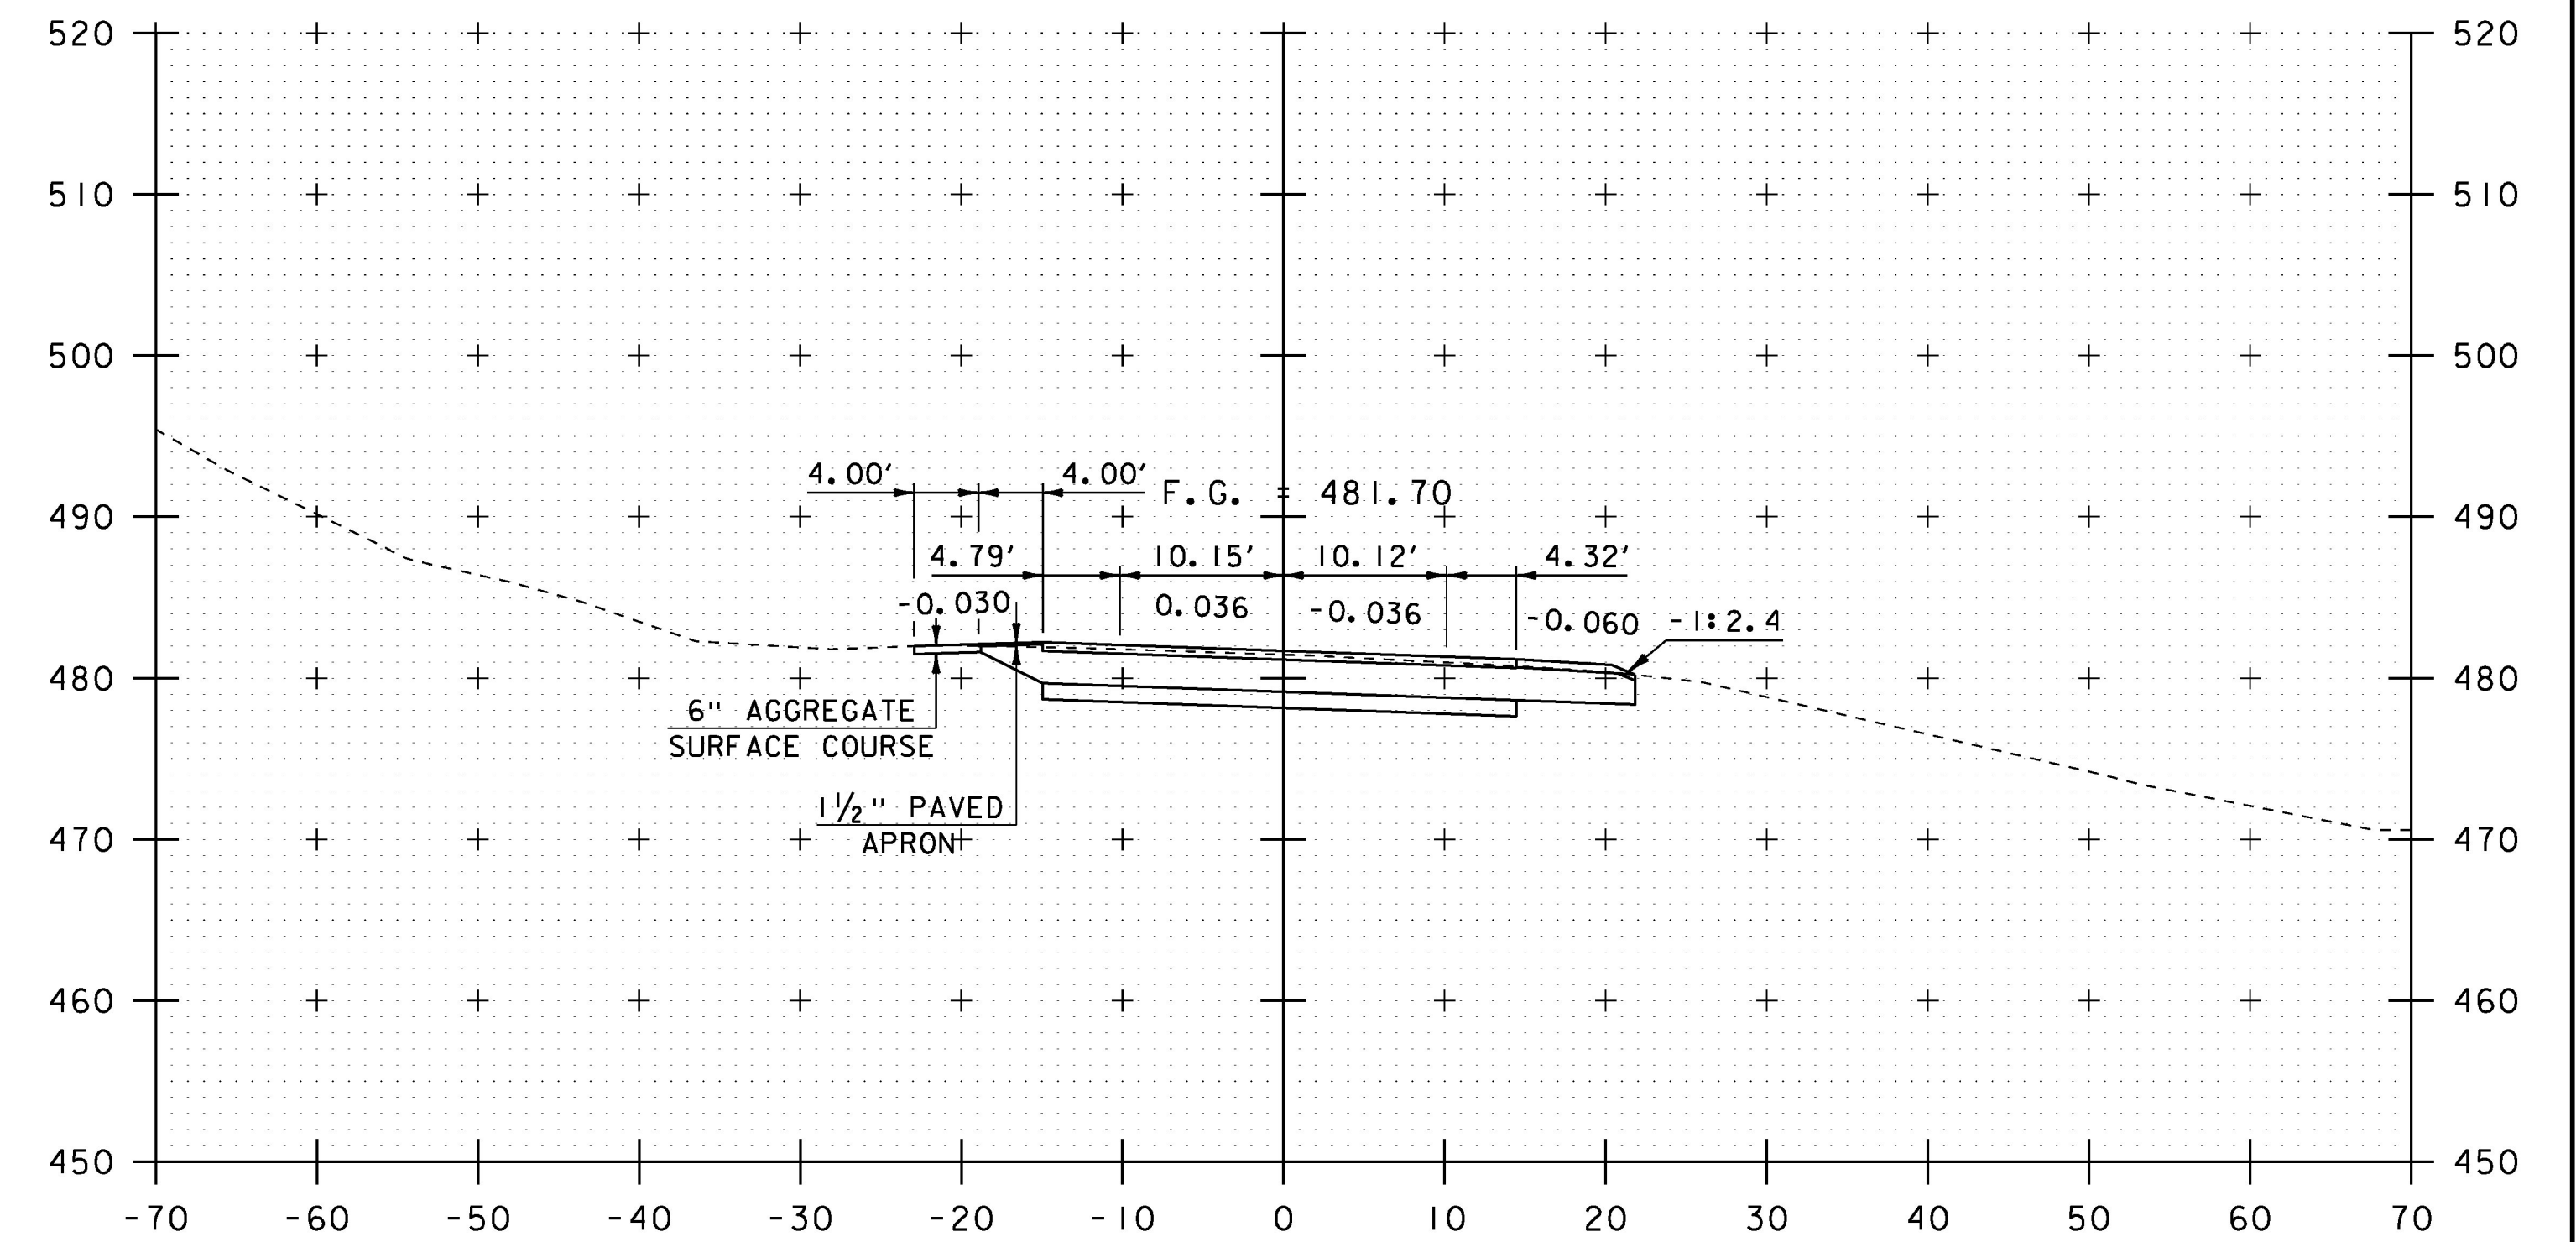

16+25

STA 16+04.8 LT - STA 16+89.2 LT
CONSTRUCT 4' PAVED APRON WITH
AGGREGATE SURFACE COURSE DRIVE

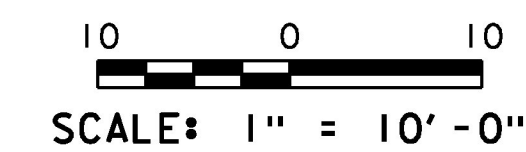

STA. 15+75 TO STA. 16+50

PROJECT NAME: BRADFORD	PLOT DATE: 15-SEP-2016
PROJECT NUMBER: BF 0191 (29)	DRAWN BY: G. ROY
FILE NAME: sl3c054xsl.dgn	CHECKED BY: M. EVANS-MONGEON
PROJECT LEADER: C. CARLSON	SHEET 47 OF 71
DESIGNED BY: G. ROY	
VT 25B CROSS SECTION (6)	