




17+00

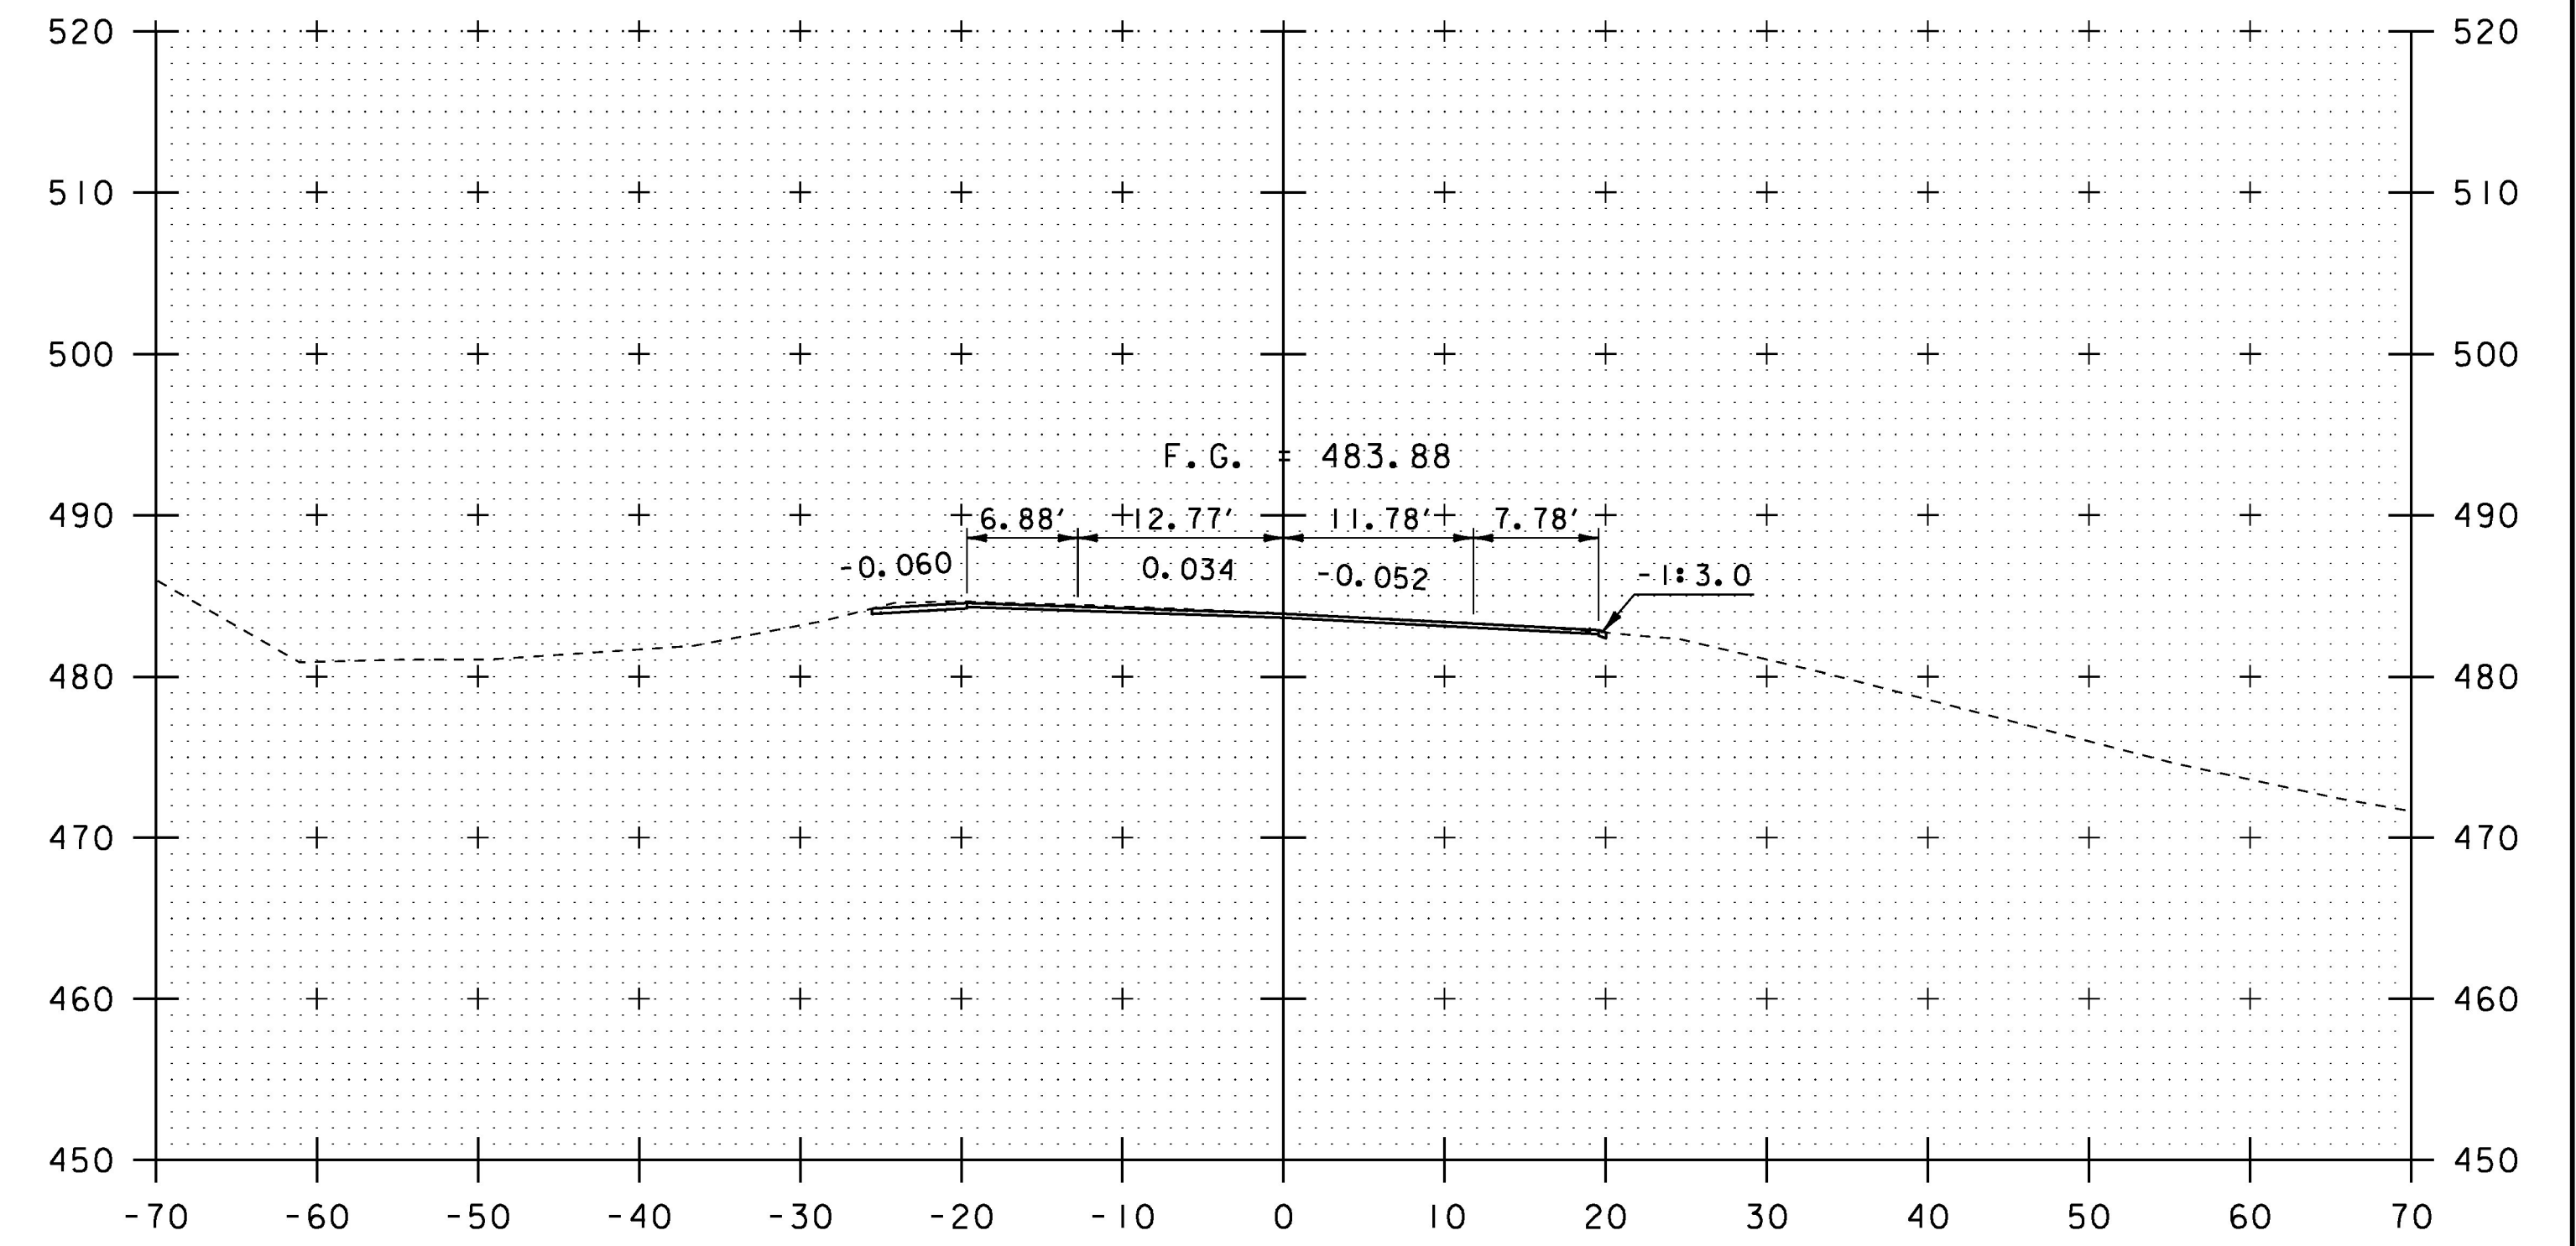

17+50

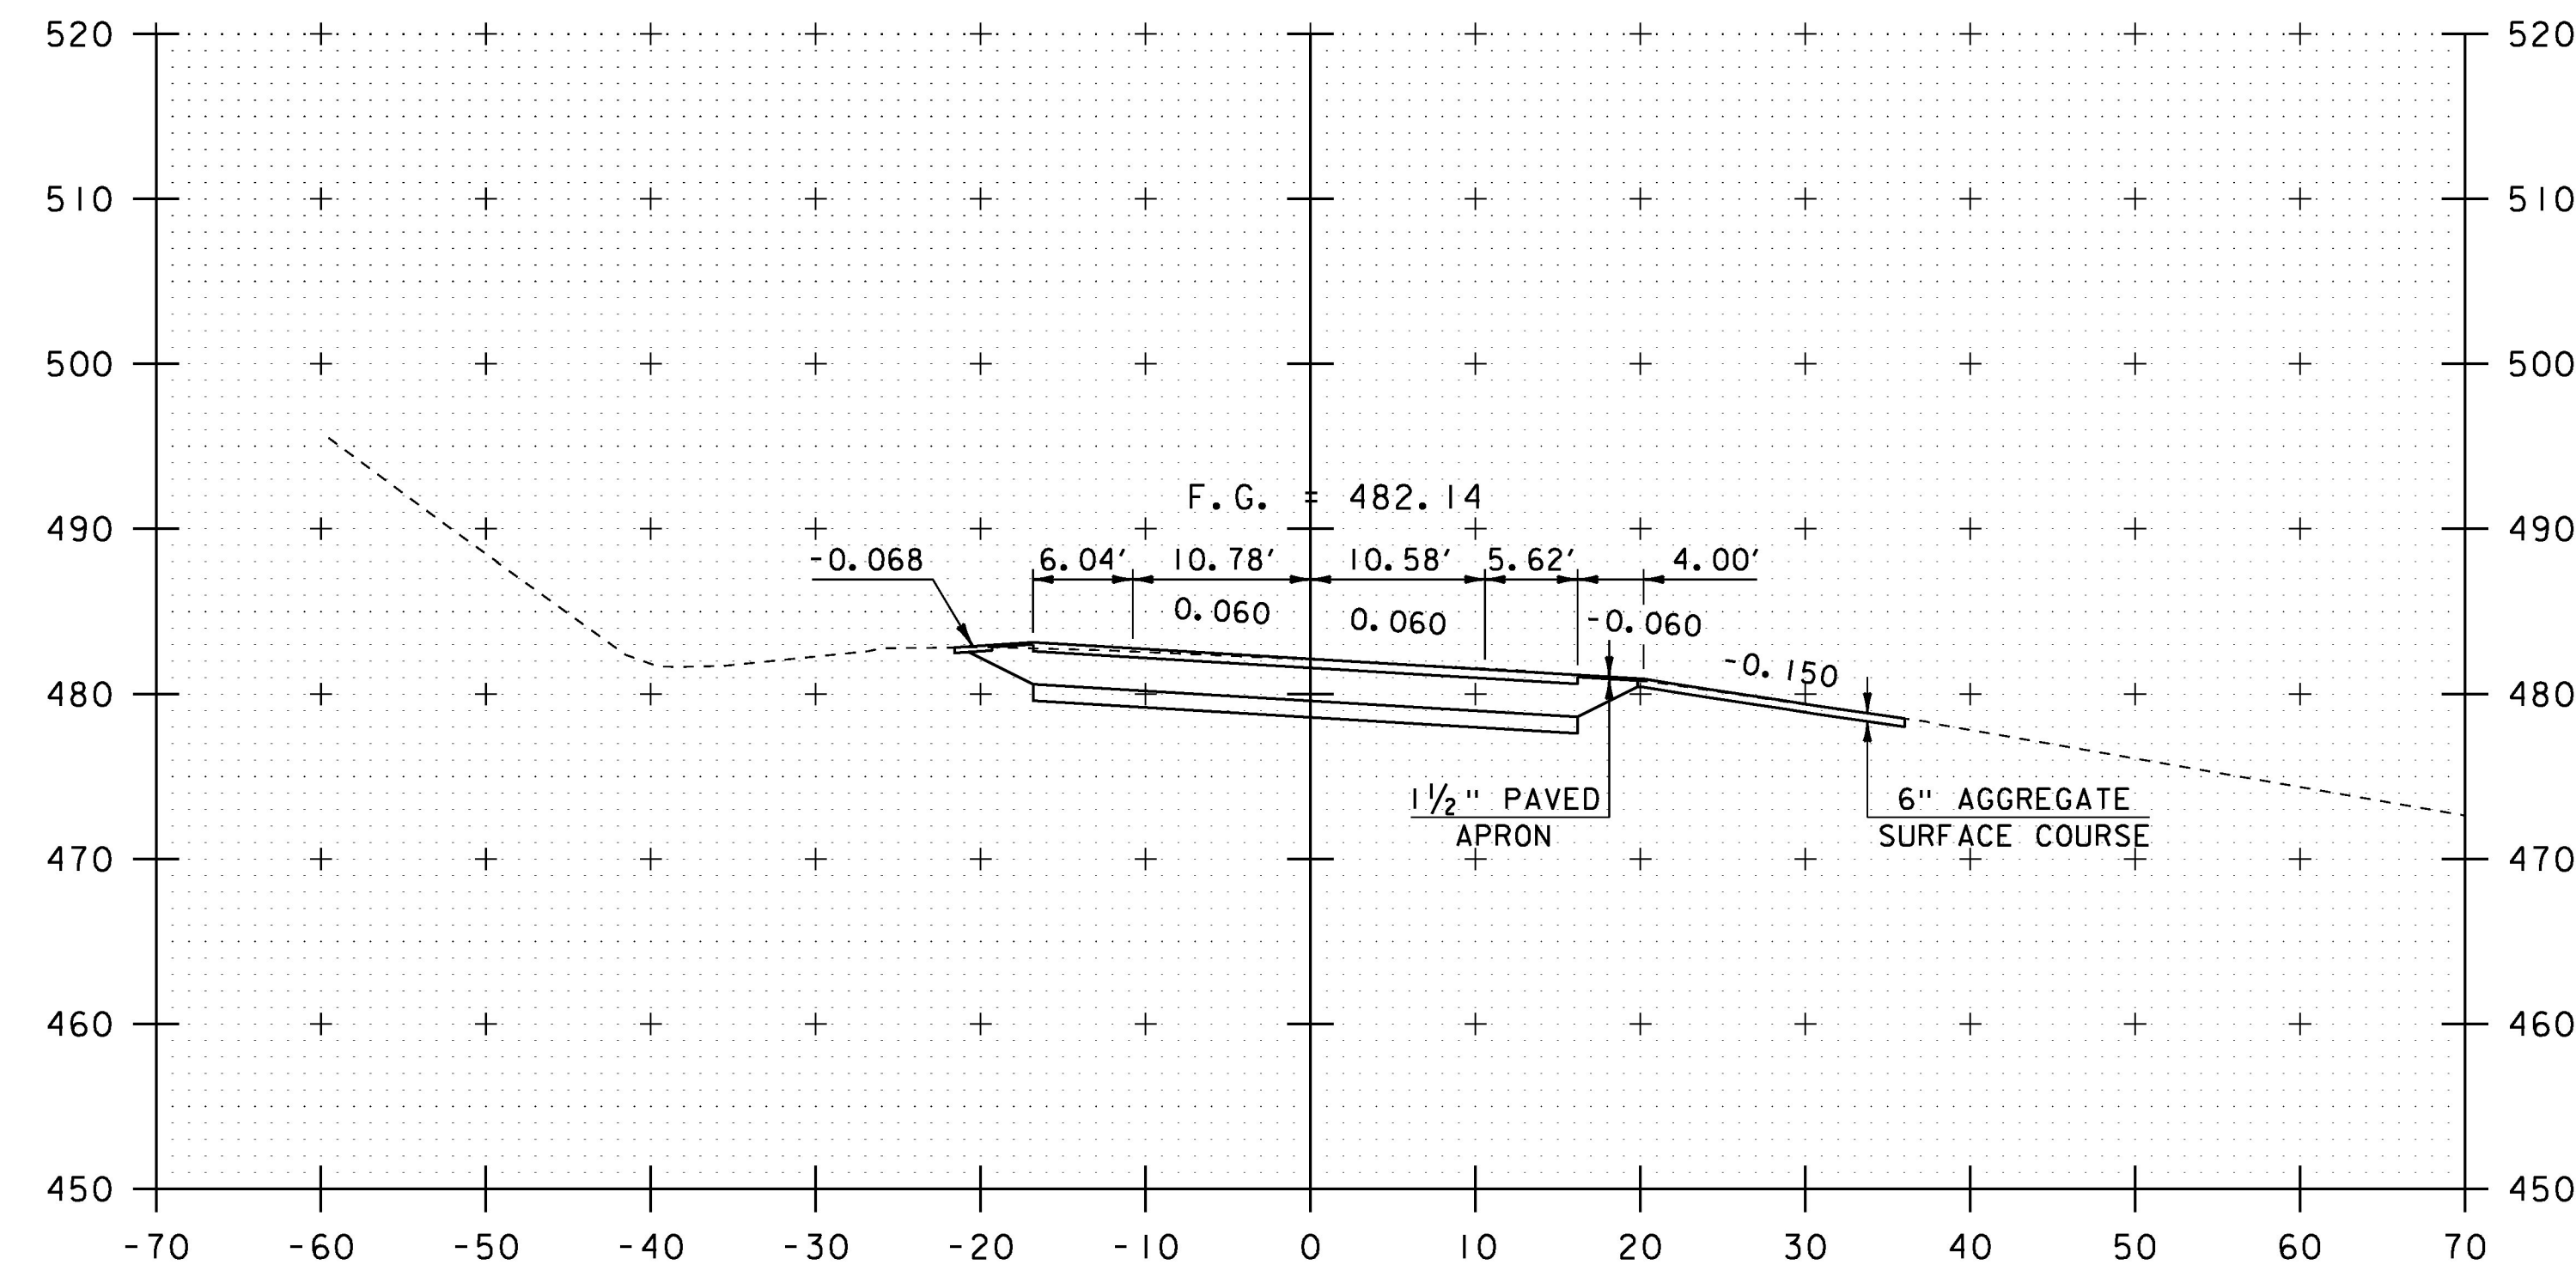


16+75

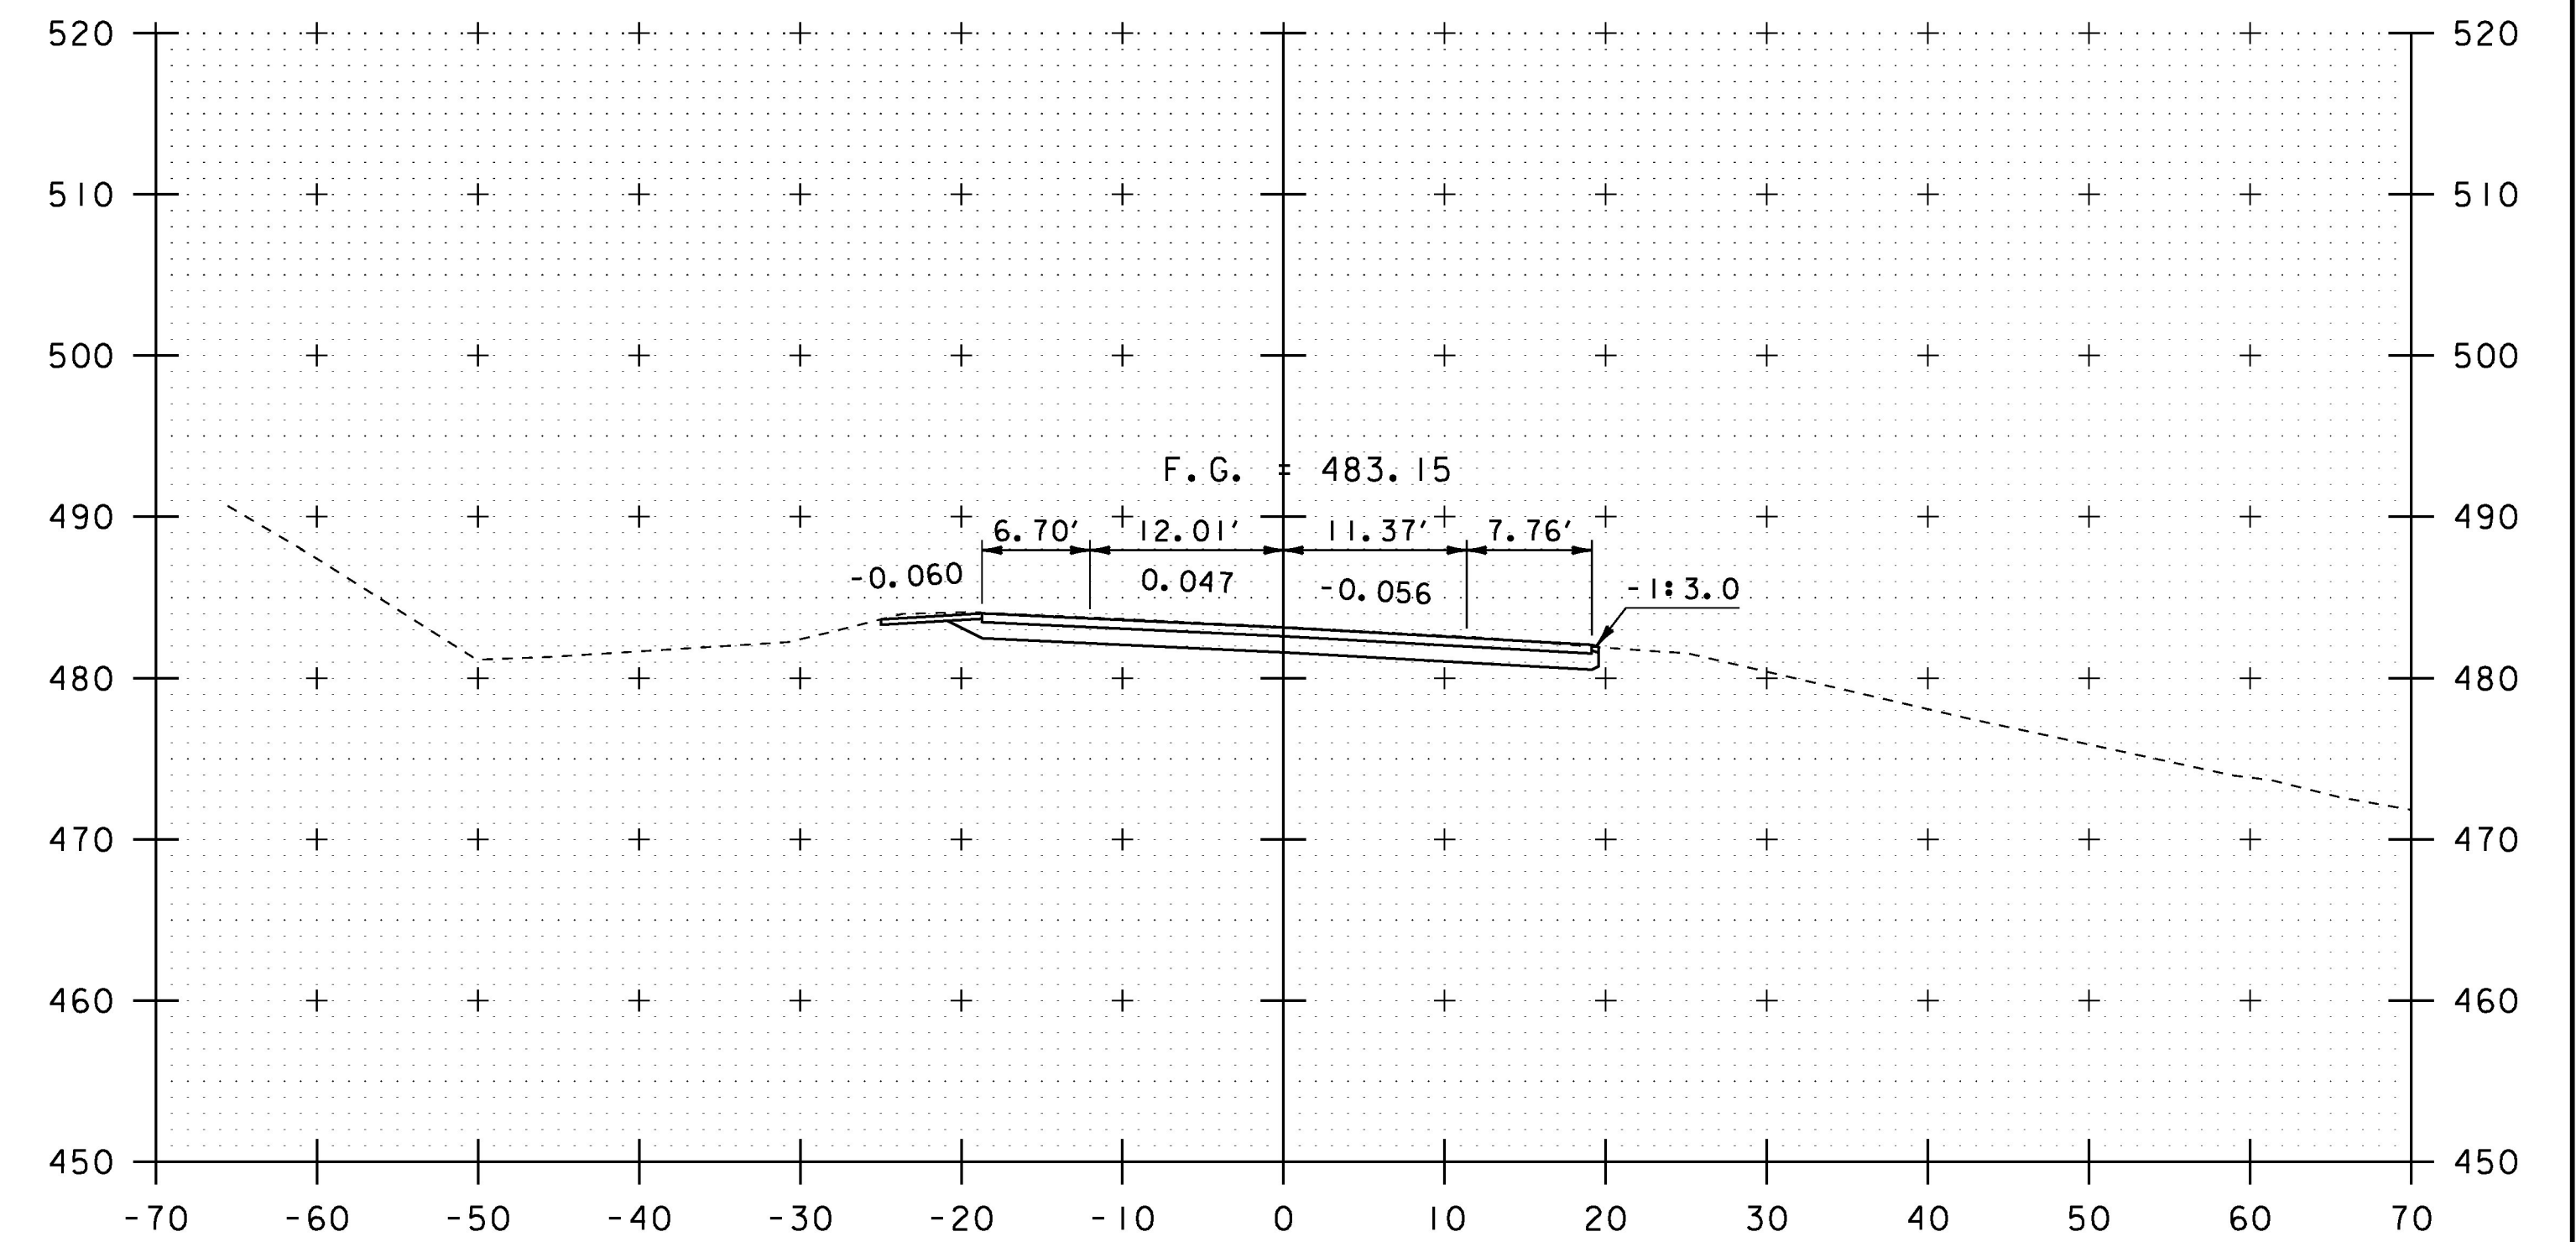

17+25

STA 16+75.00
END PROJECT
STA 16+57.5 RT - STA 17+07.4 RT
CONSTRUCT 4' PAVED APRON WITH
AGGREGATE SURFACE COURSE DRIVE

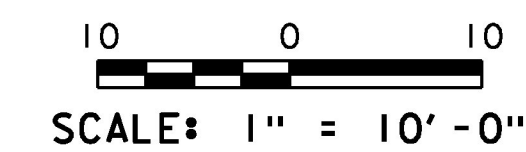

STA. 16+75 TO STA. 17+50

PROJECT NAME: BRADFORD	PLOT DATE: 15-SEP-2016
PROJECT NUMBER: BF 0191 (29)	DRAWN BY: G. ROY
FILE NAME: sl3c054xsl.dgn	CHECKED BY: M. EVANS-MONGEON
PROJECT LEADER: C. CARLSON	SHEET 48 OF 71
DESIGNED BY: G. ROY	
VT 25B CROSS SECTION (7)	