



18+00


STA 18+00.00  
END APPROACH  
MATCH EXISTING

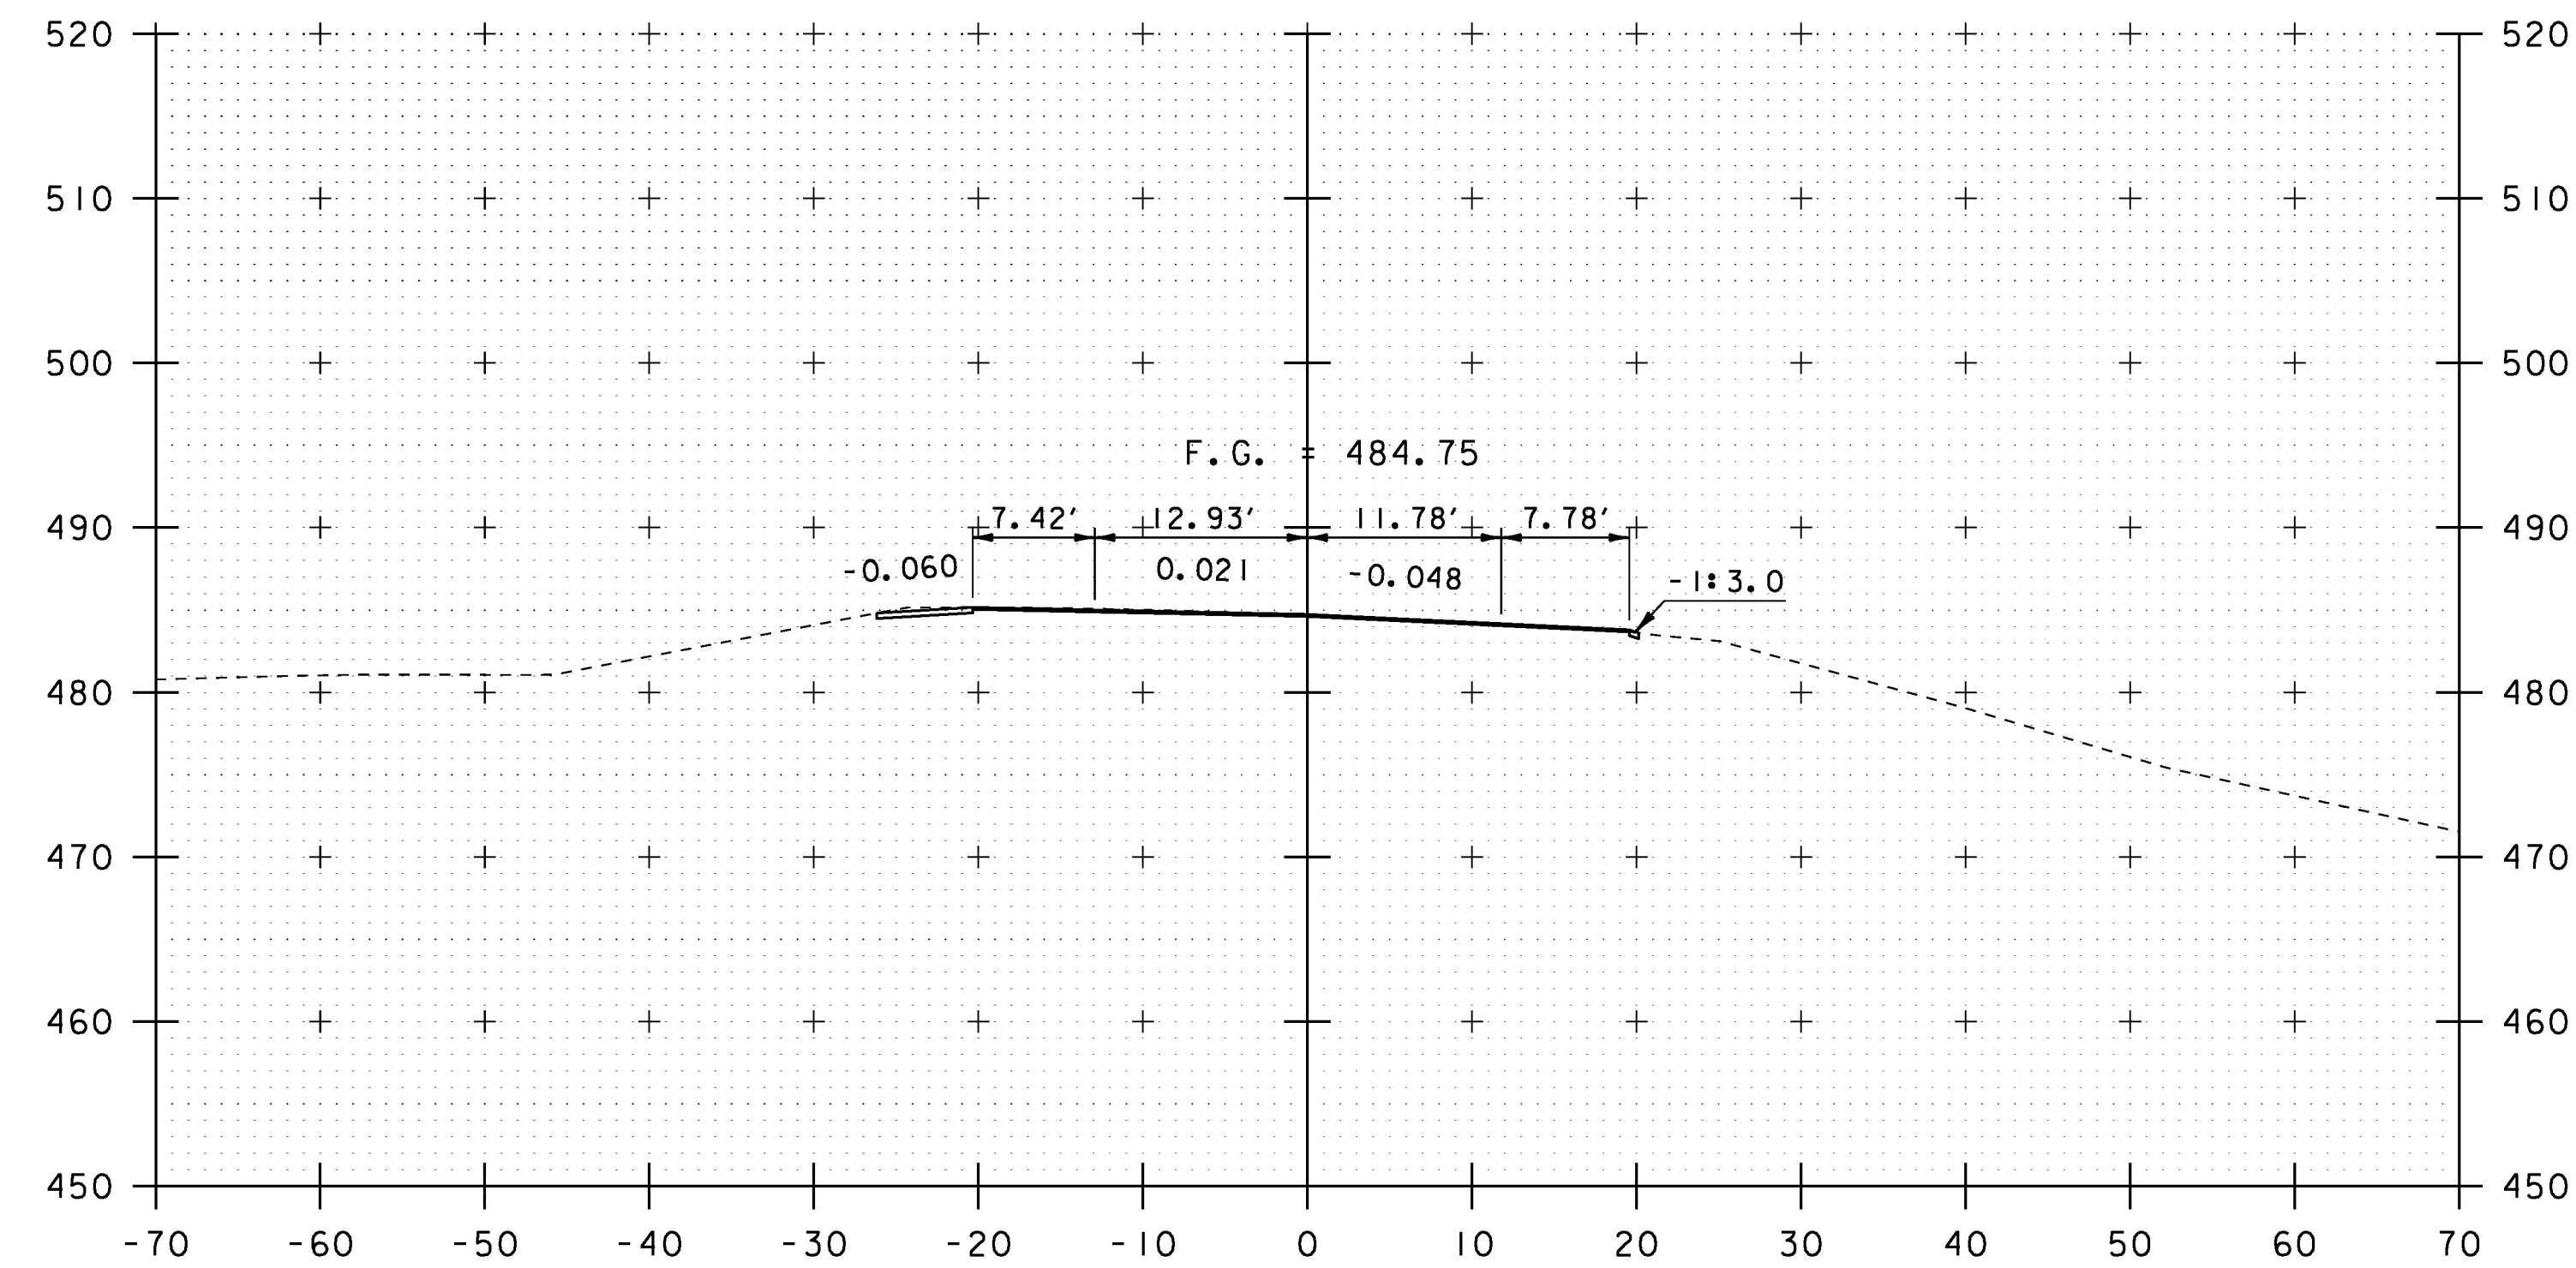

17+75

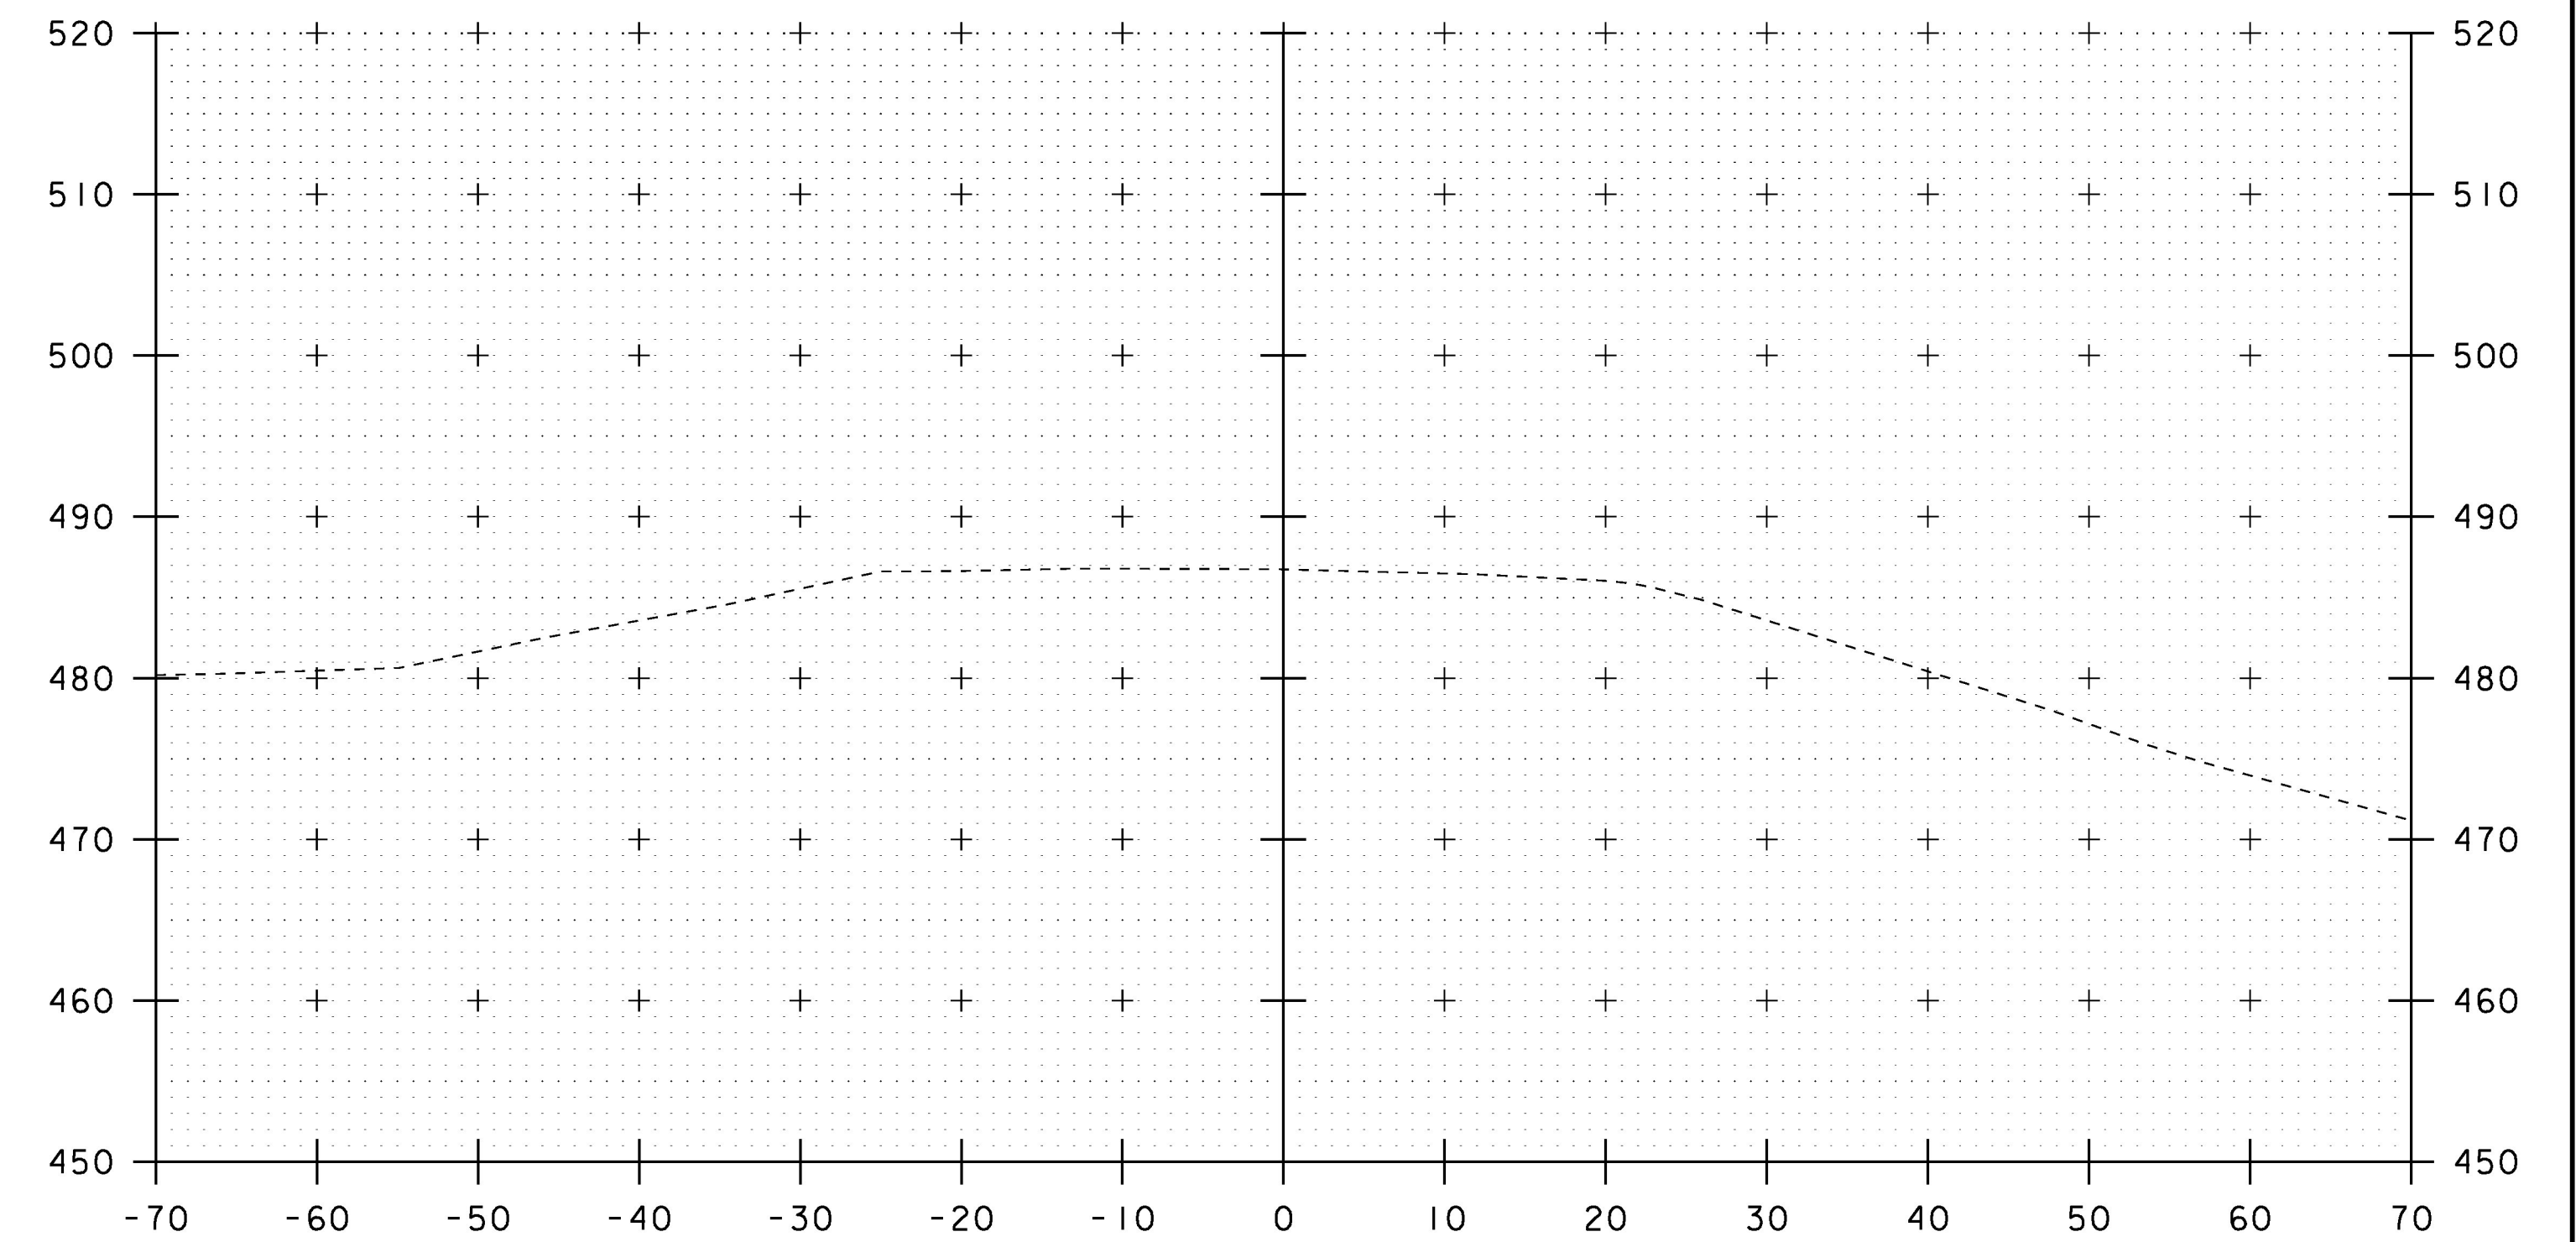

18+25

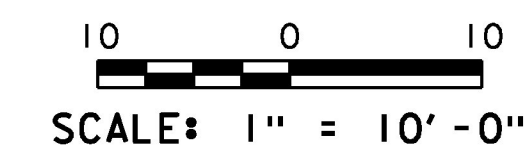

STA. 17+75 TO STA. 18+25

PROJECT NAME: BRADFORD	PLOT DATE: 15-SEP-2016
PROJECT NUMBER: BF 0191 (29)	DRAWN BY: G. ROY
FILE NAME: s13c054xsl.dgn	CHECKED BY: M. EVANS-MONGEON
PROJECT LEADER: C. CARLSON	SHEET 49 OF 71
DESIGNED BY: G. ROY	
VT 25B CROSS SECTION (8)	