



20+25


STA 20+14.11  
BEGIN SIDELINE ROADWAY

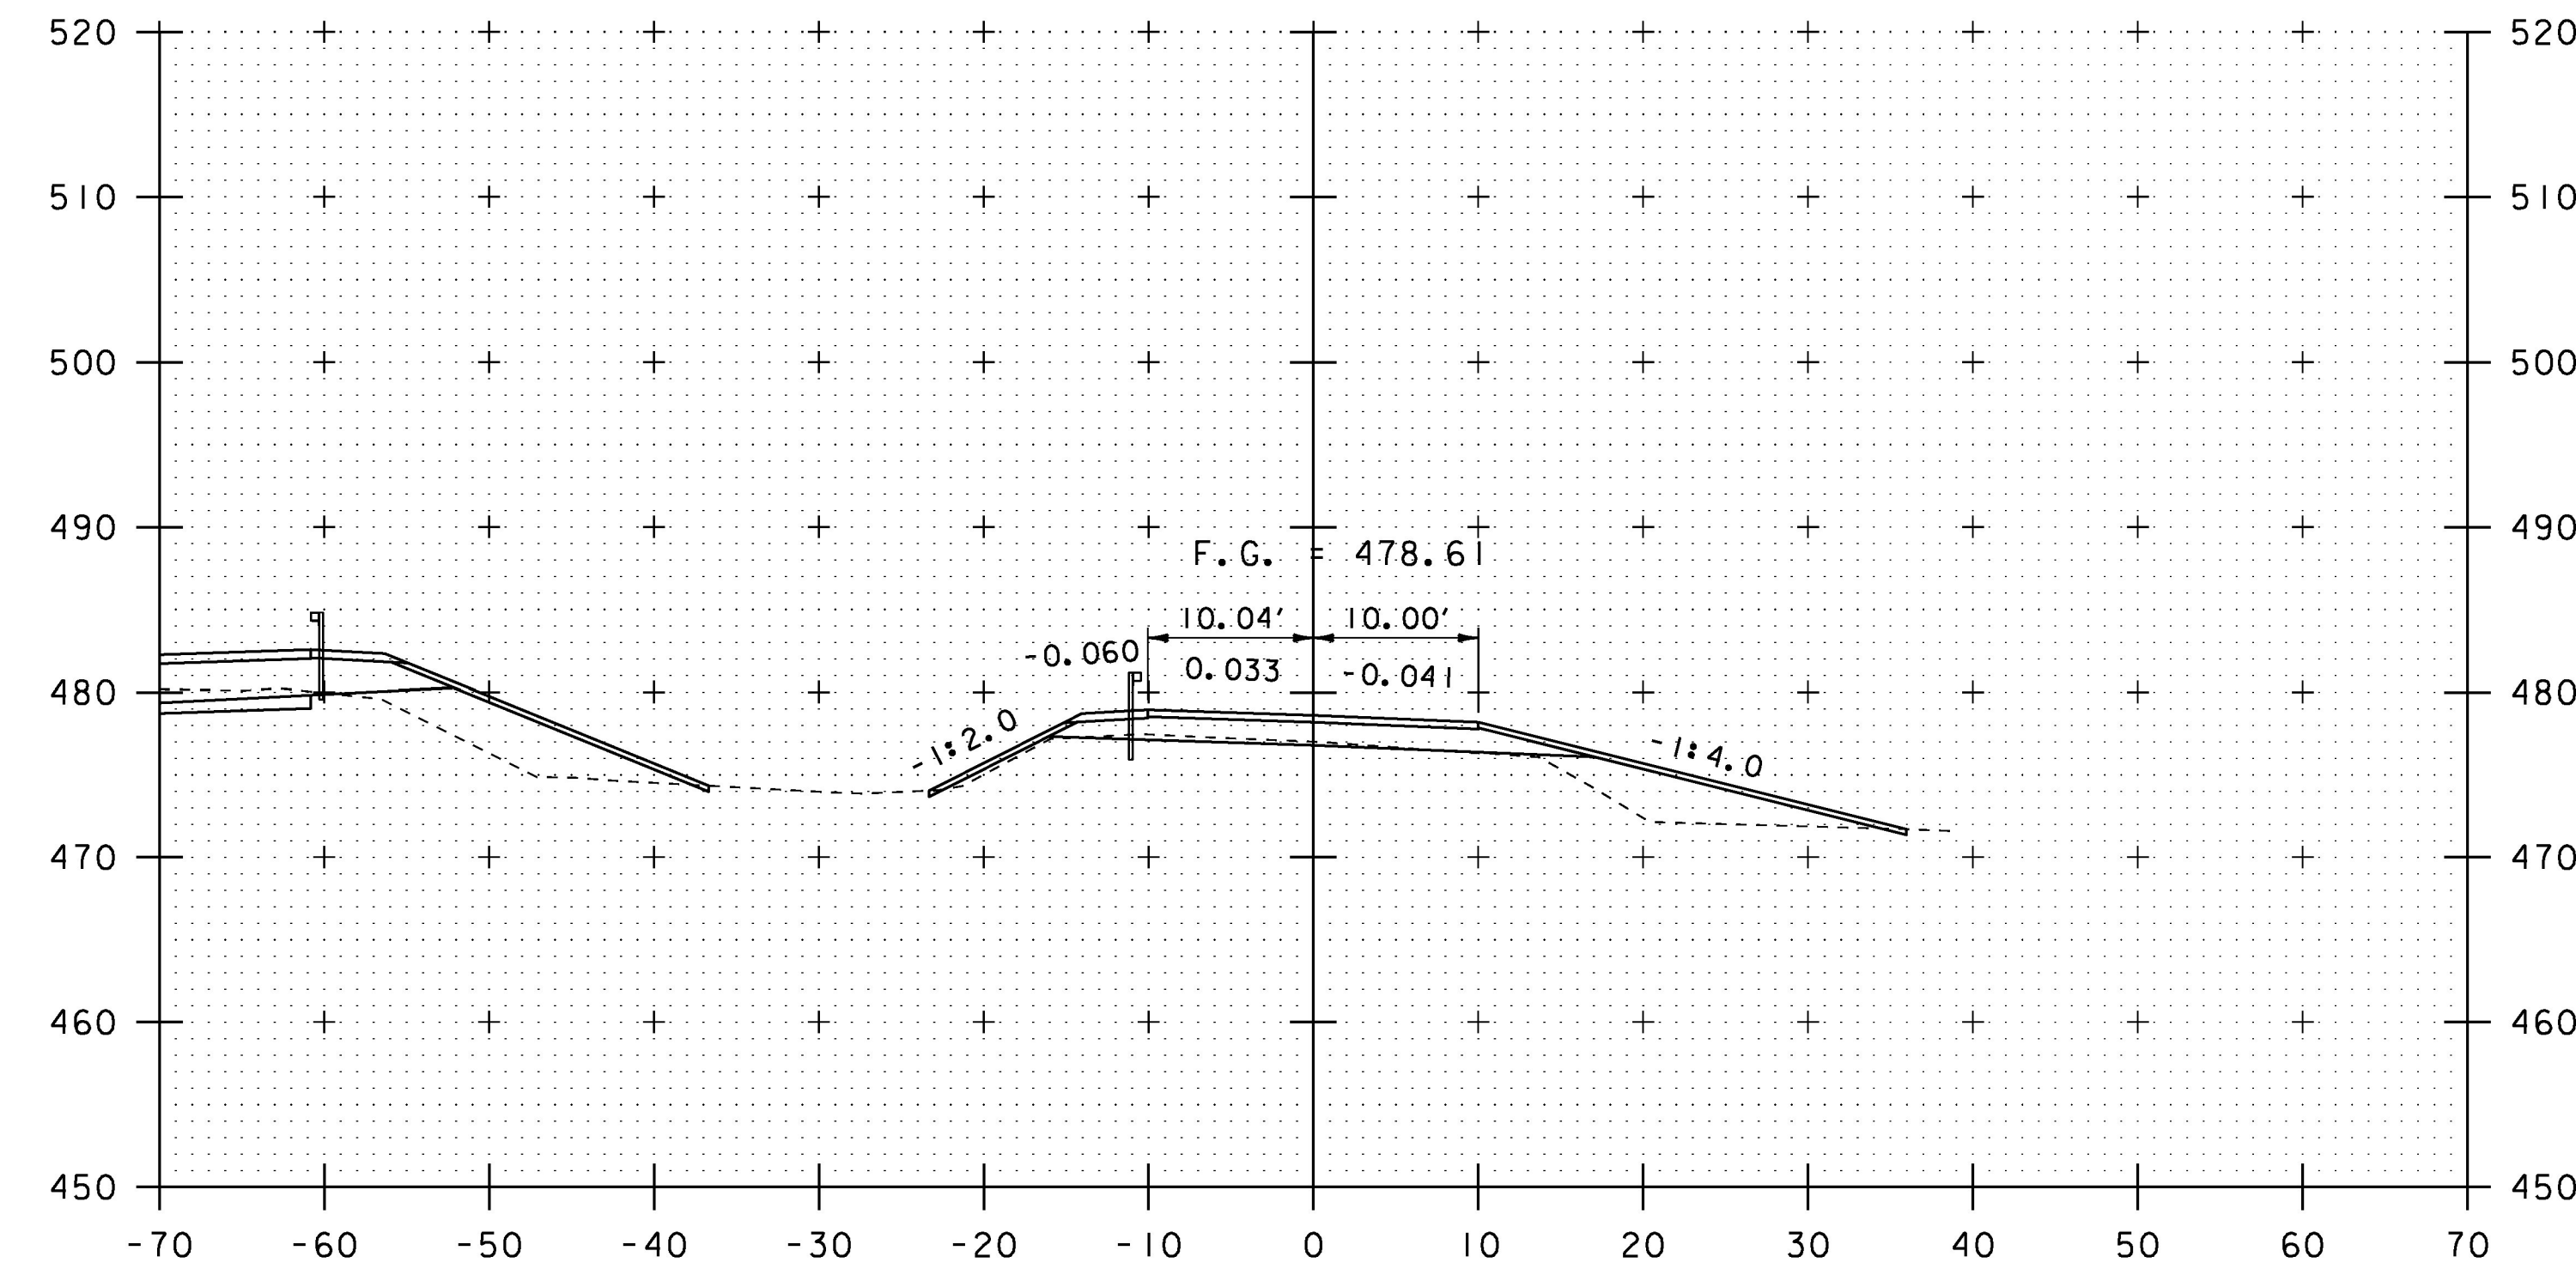


20+75

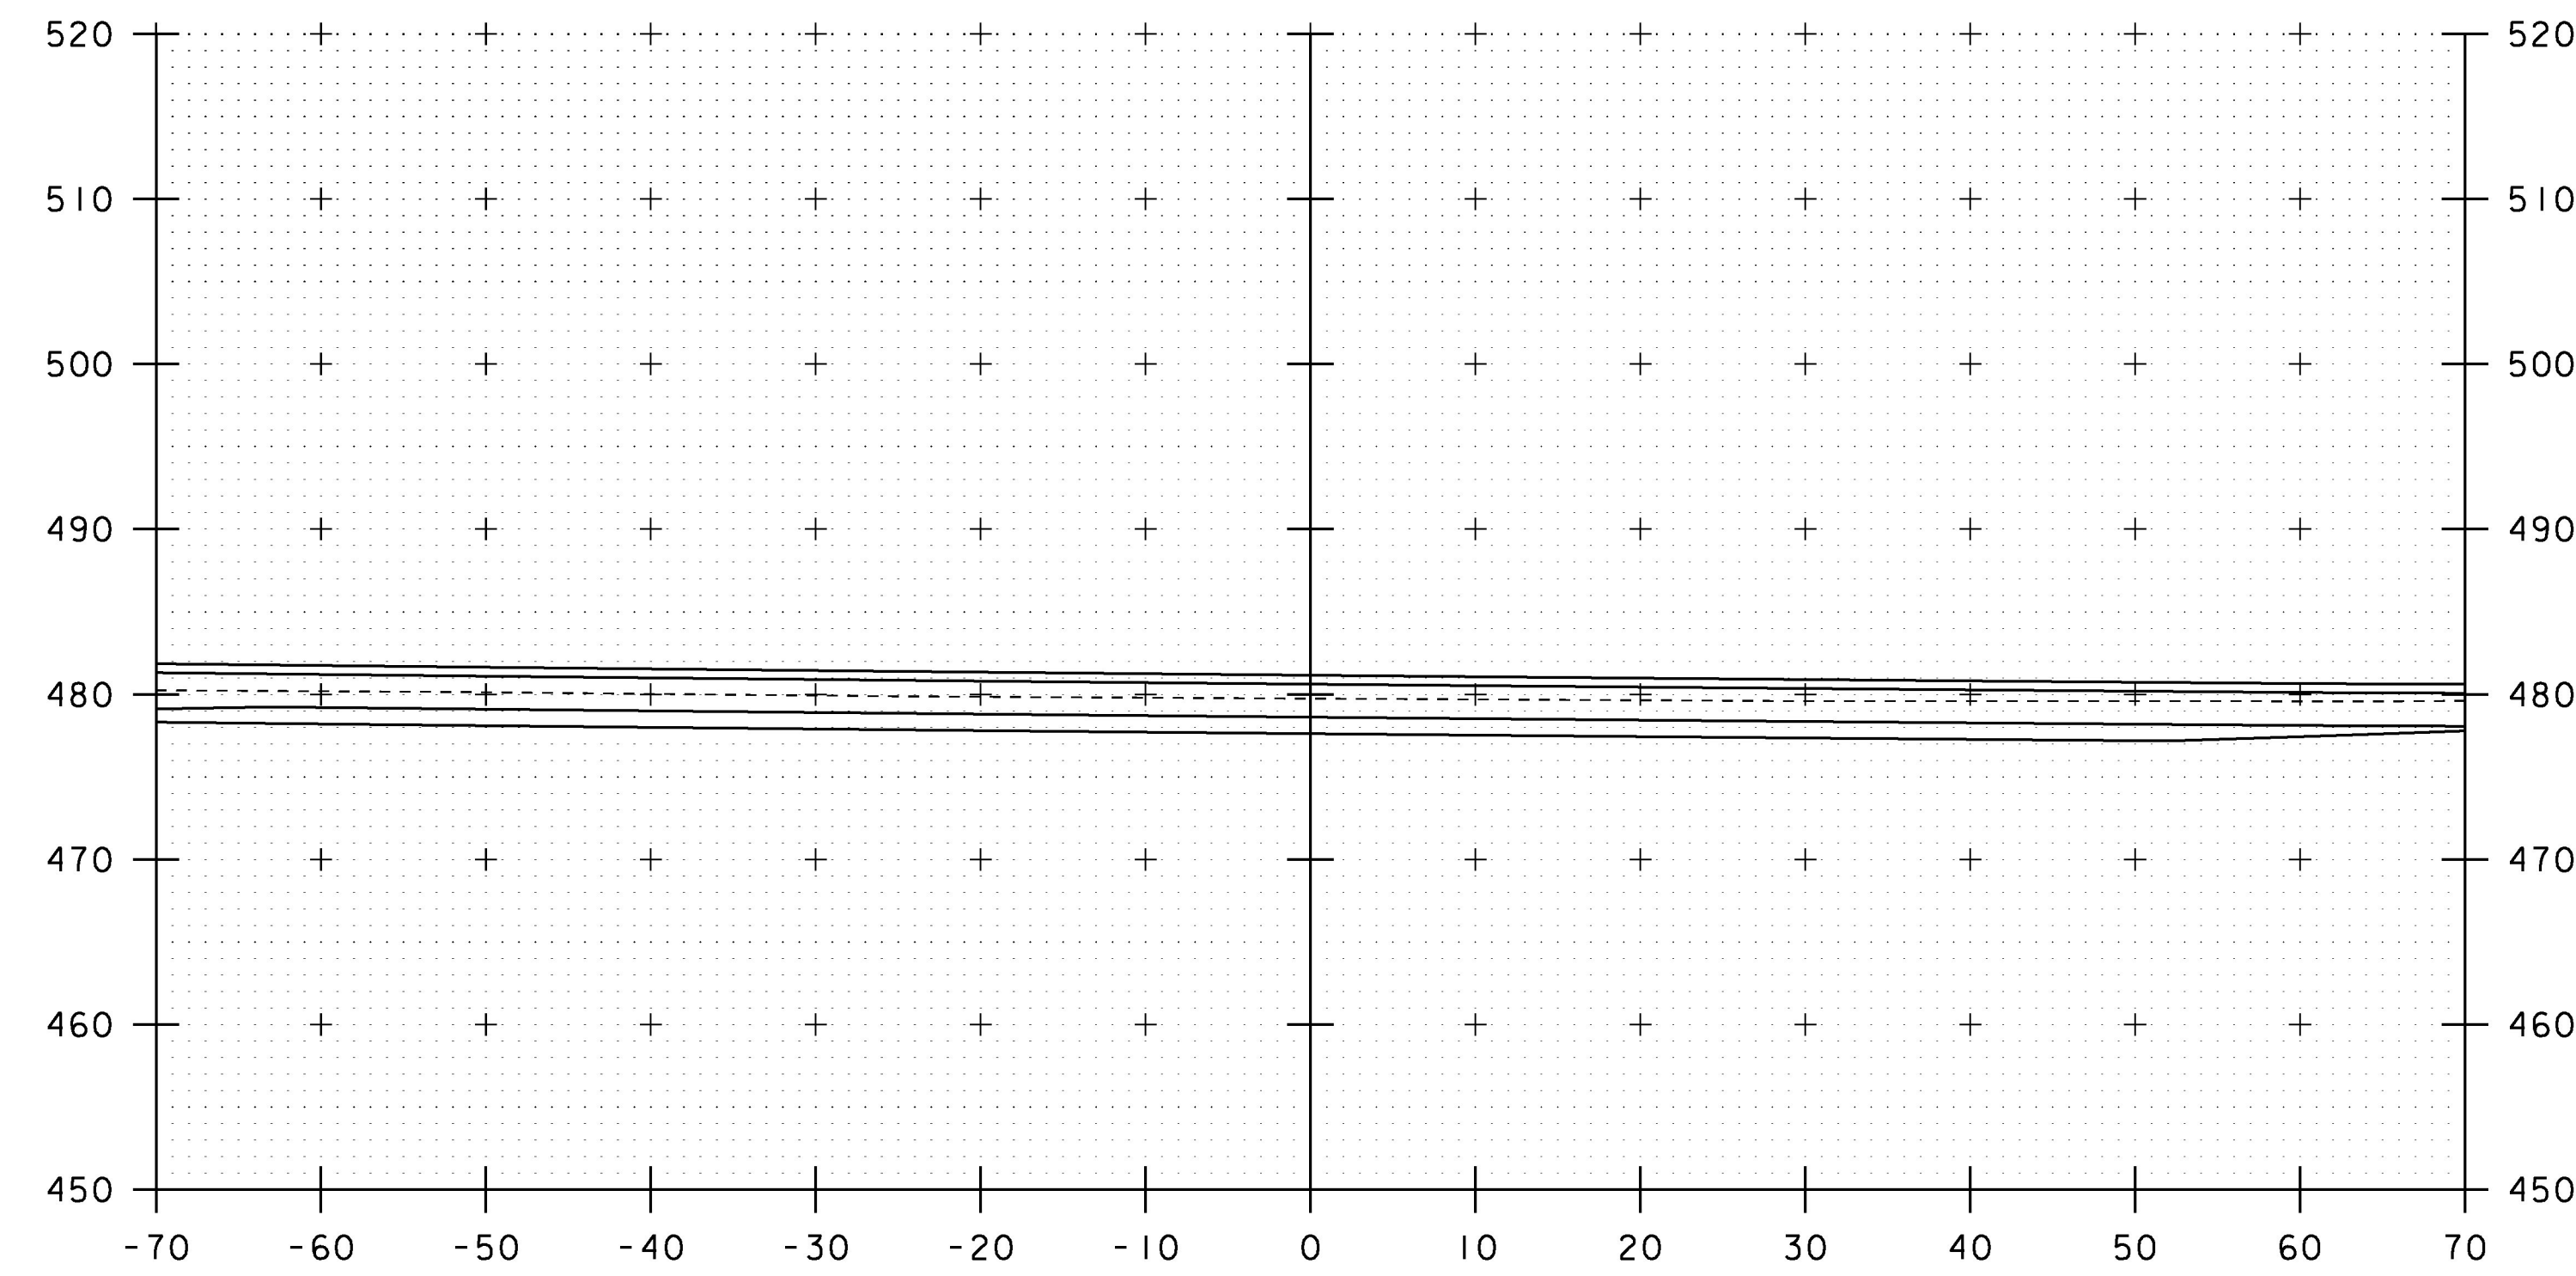

20+00

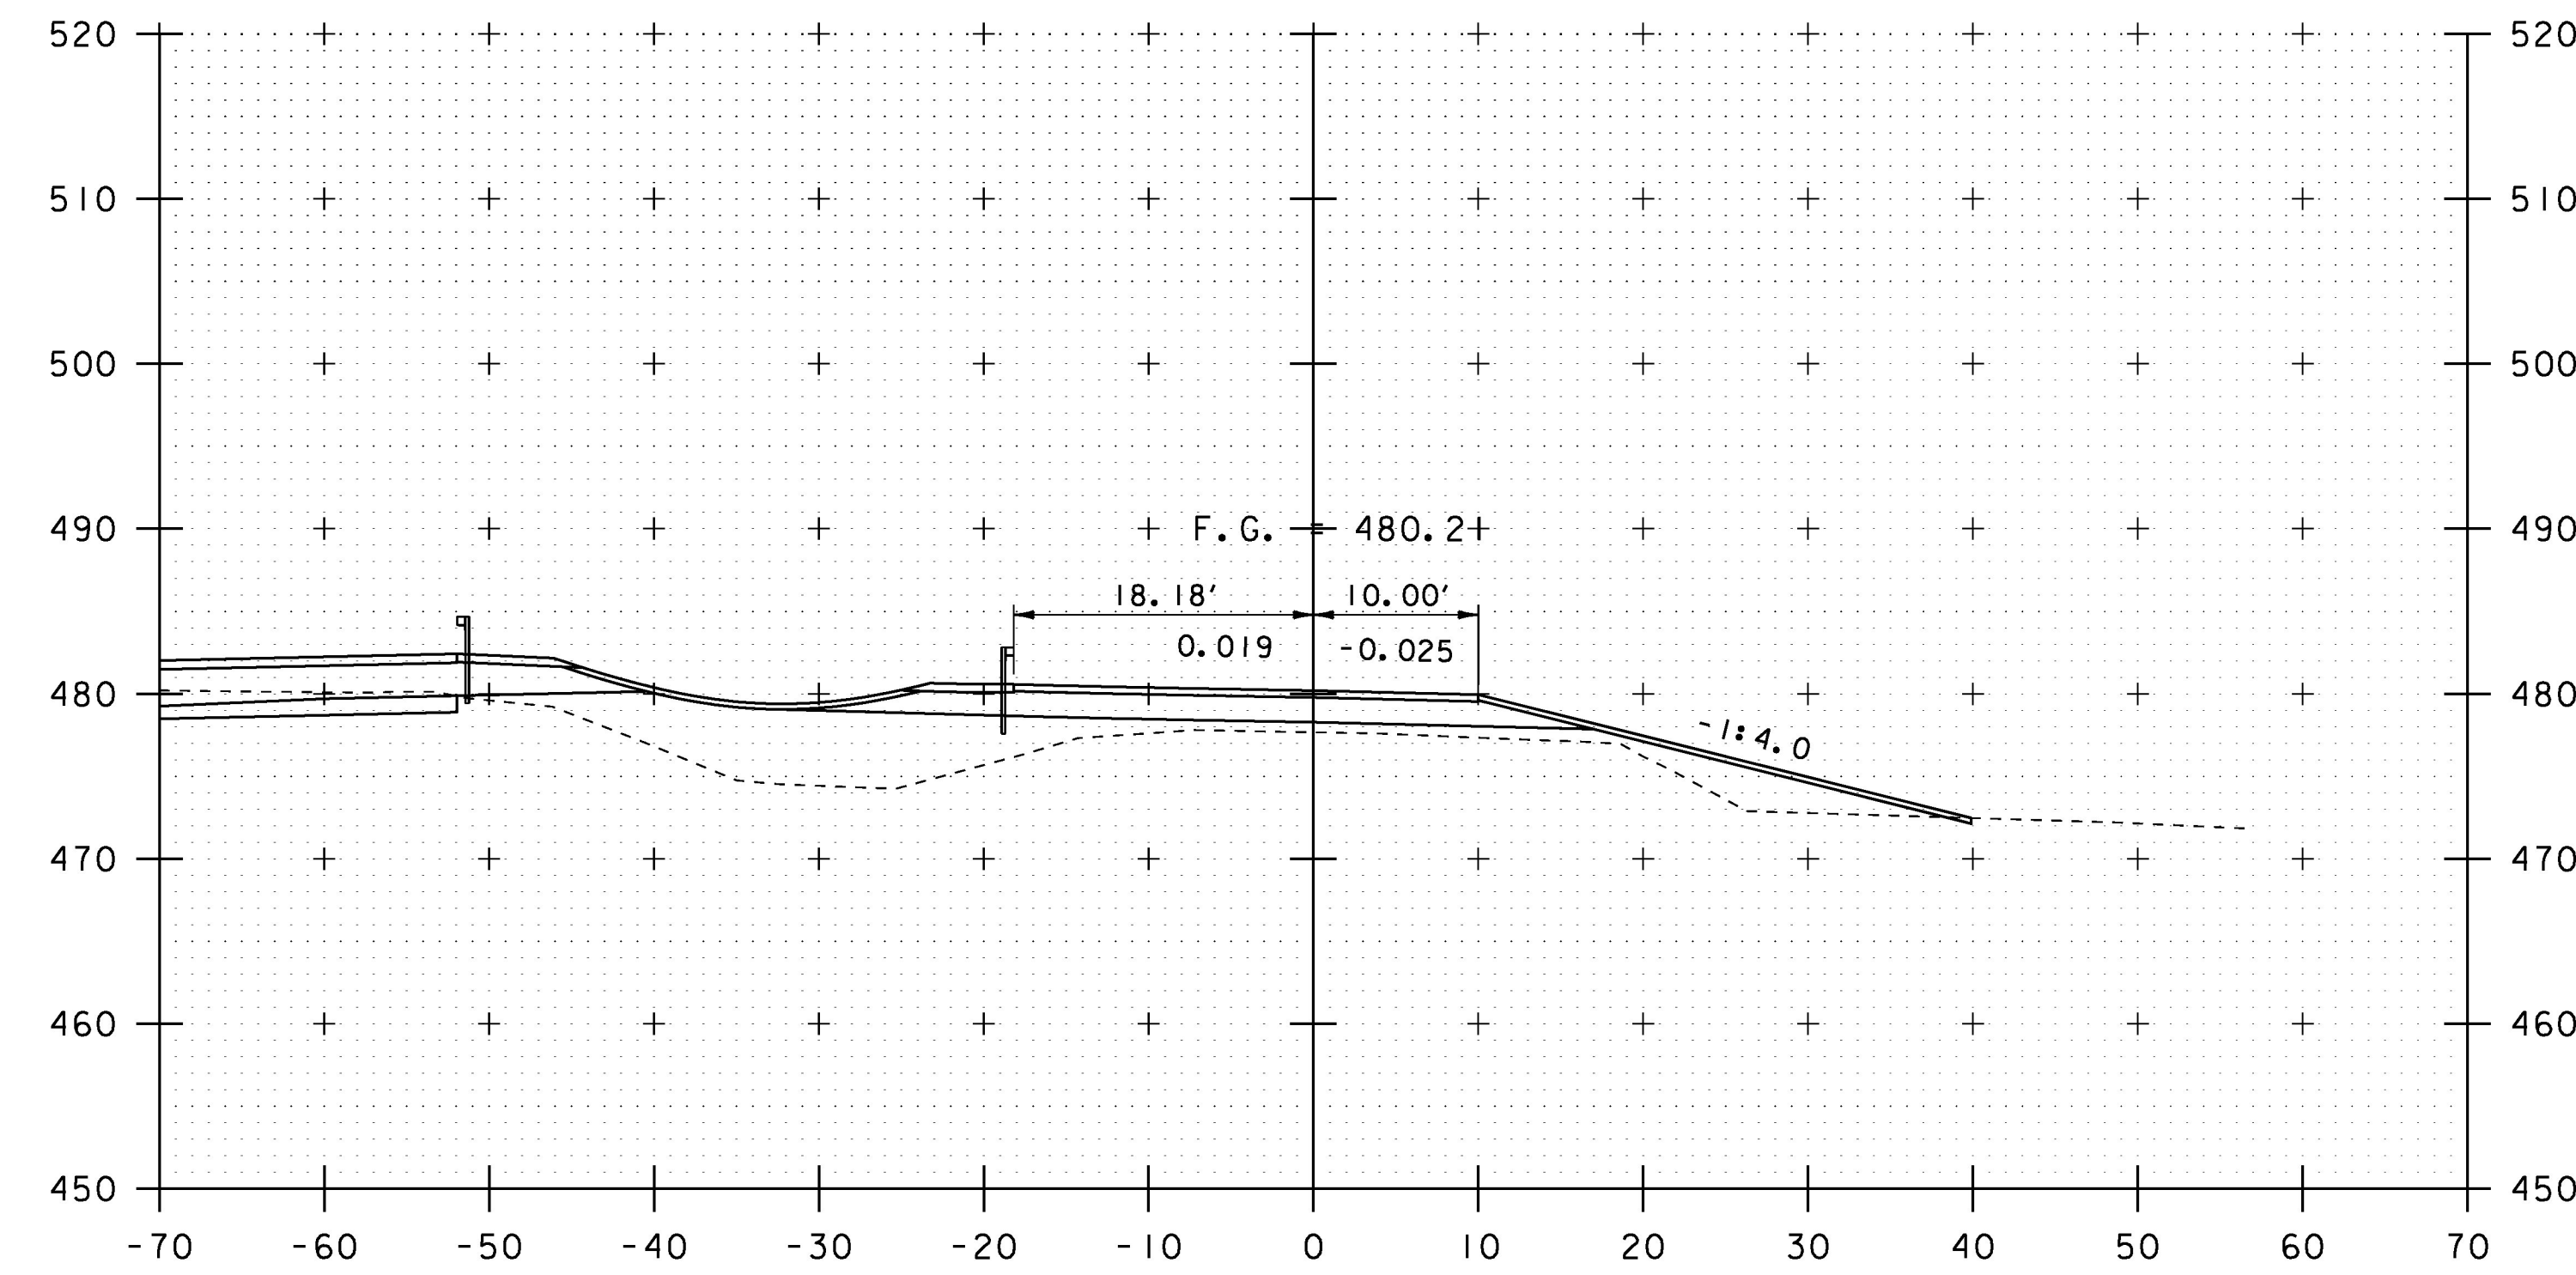

20+50

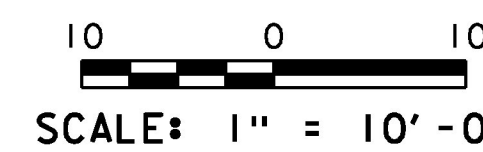

STA. 20+00 TO STA. 20+75

PROJECT NAME: BRADFORD	PLOT DATE: 15-SEP-2016
PROJECT NUMBER: BF 0191 (29)	DRAWN BY: G. ROY
FILE NAME: s13c054xsl.dgn	CHECKED BY: M. EVANS-MONGEON
PROJECT LEADER: C. CARLSON	SHEET 50 OF 71
DESIGNED BY: G. ROY	
TH 5I CROSS SECTION (1)	