


48+80

STA 48+75.0 FAR RT
 BEGIN UNCLASSIFIED CHANNEL EXCAVATION
 GEOTEXTILE UNDER STONE FILL
 STONE FILL, TYPE III
 GRUBBING MATERIAL

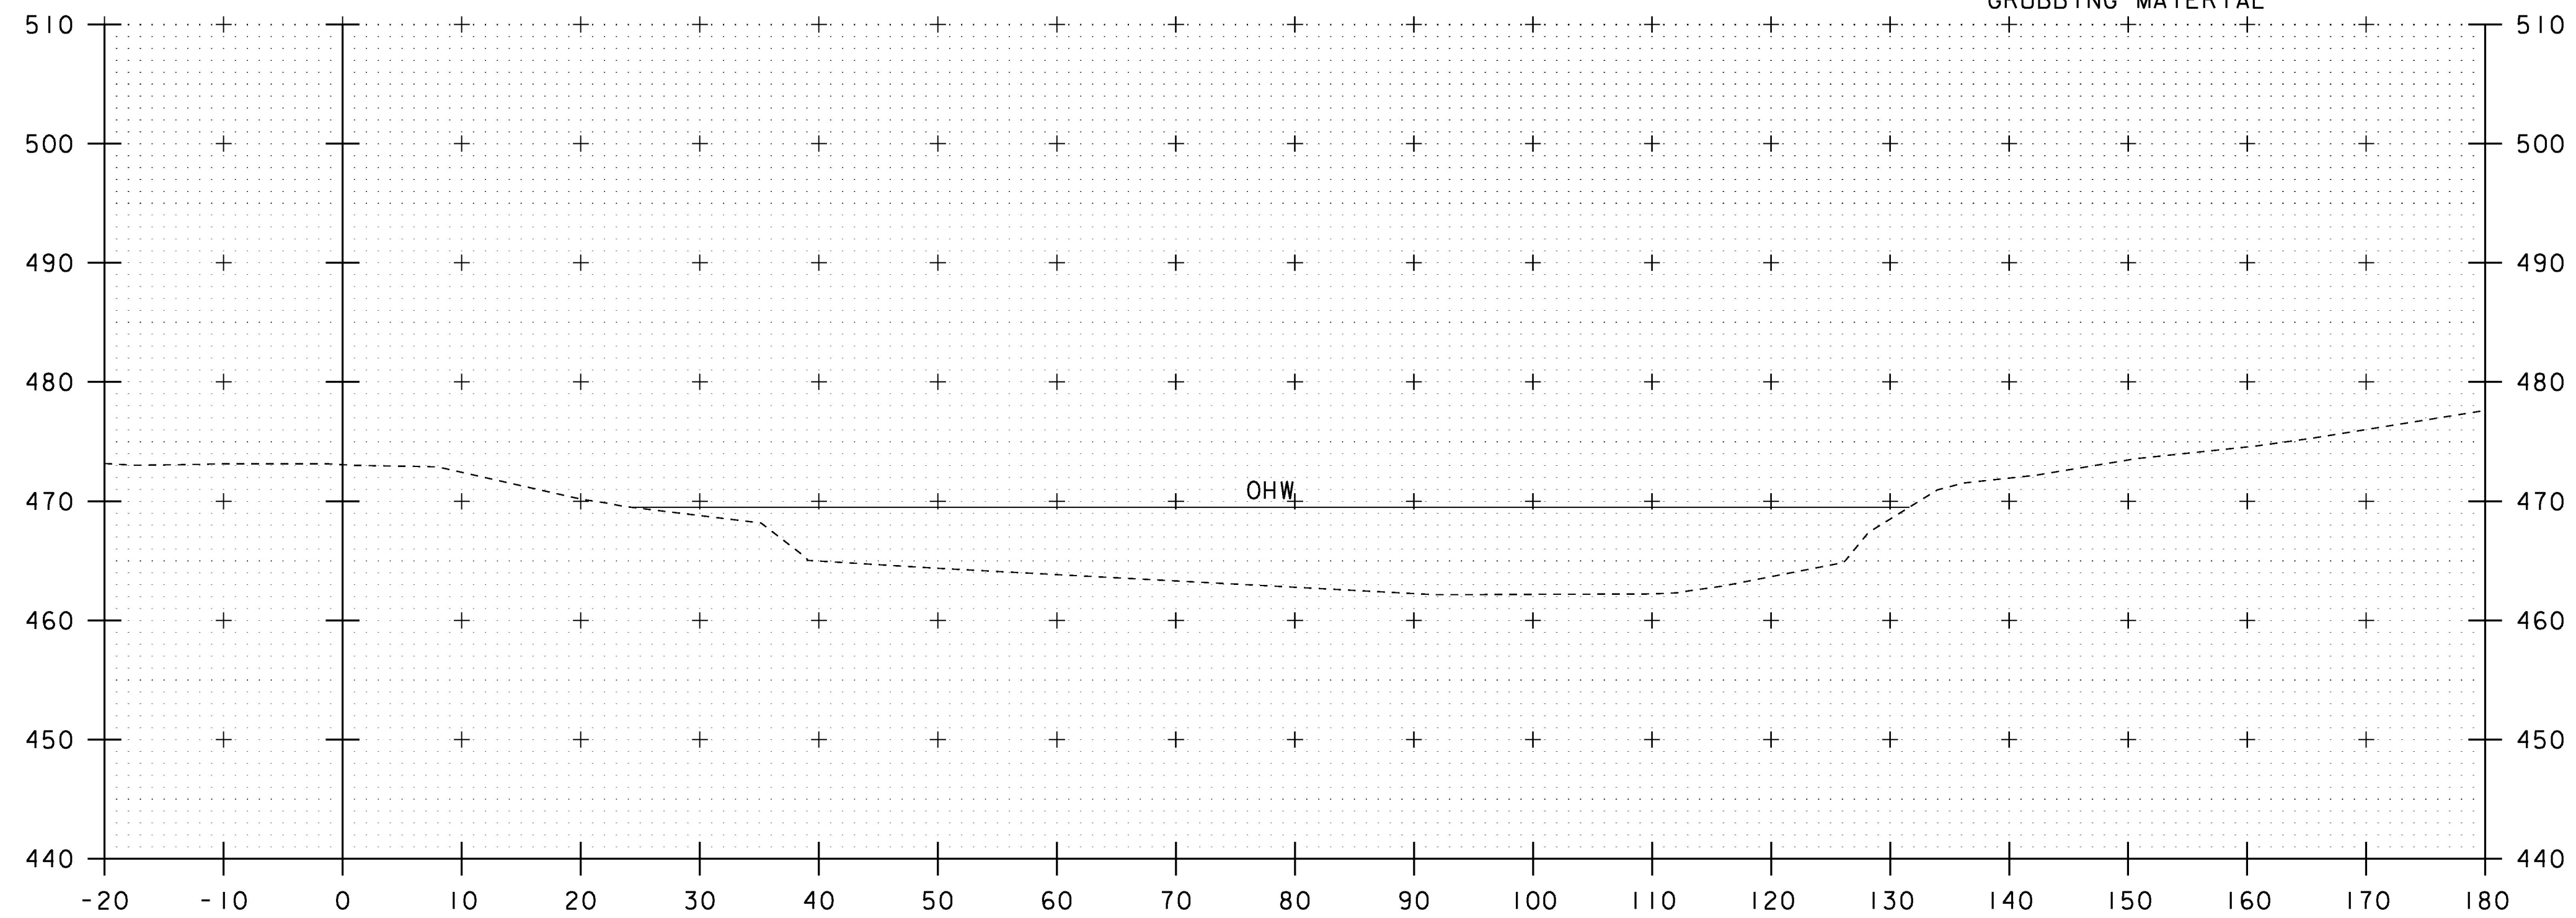

48+70

10 0 10
 SCALE: 1" = 10'-0"

STA. 48+70 TO STA. 48+80

PROJECT NAME: BRADFORD	PLOT DATE: 15-SEP-2016
PROJECT NUMBER: BF 0191 (29)	DRAWN BY: G. ROY
FILE NAME: sl3c054xsl.dgn	CHECKED BY: M. EVANS-MONGEON
PROJECT LEADER: C. CARLSON	SHEET 52 OF 71
DESIGNED BY: G. ROY	
CHANNEL CROSS SECTION (1)	