



49+40

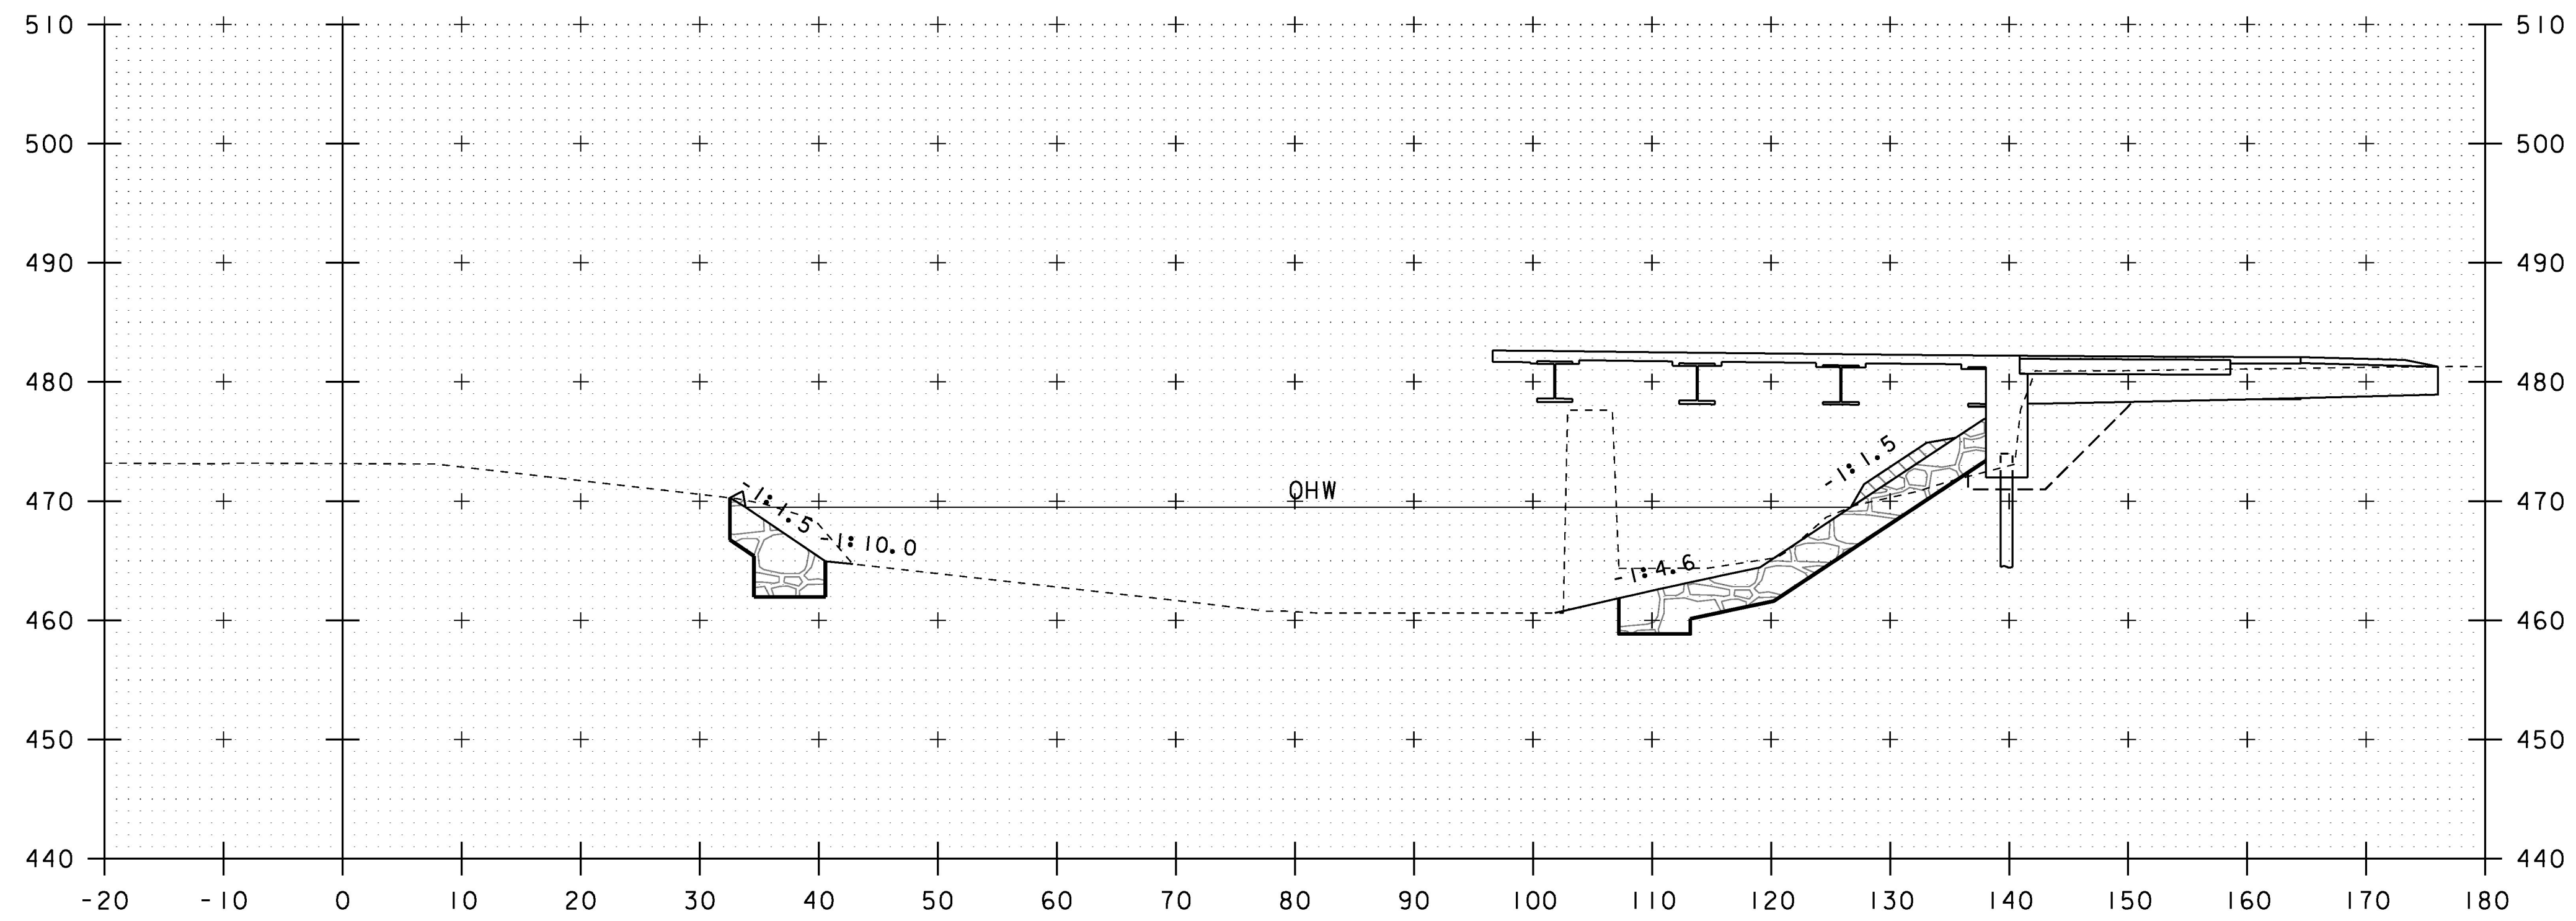

STA 49+30.0 RT  
BEGIN GRUBBING MATERIAL

49+30

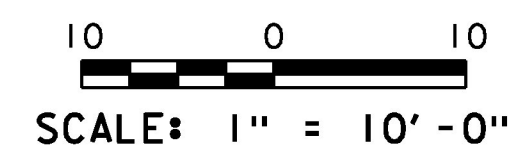

STA. 49+30 TO STA. 49+40

PROJECT NAME: BRADFORD	PLOT DATE: 15-SEP-2016
PROJECT NUMBER: BF 0191 (29)	DRAWN BY: G. ROY
FILE NAME: sl3c054xsl.dgn	CHECKED BY: M. EVANS-MONGEON
PROJECT LEADER: C. CARLSON	SHEET 55 OF 71
DESIGNED BY: G. ROY	
CHANNEL CROSS SECTION (4)	