



49+60

STA 49+52.5 FAR RT  
 END STRUCTURE EXCAVATION  
 GRANULAR BACKFILL FOR STRUCTURES

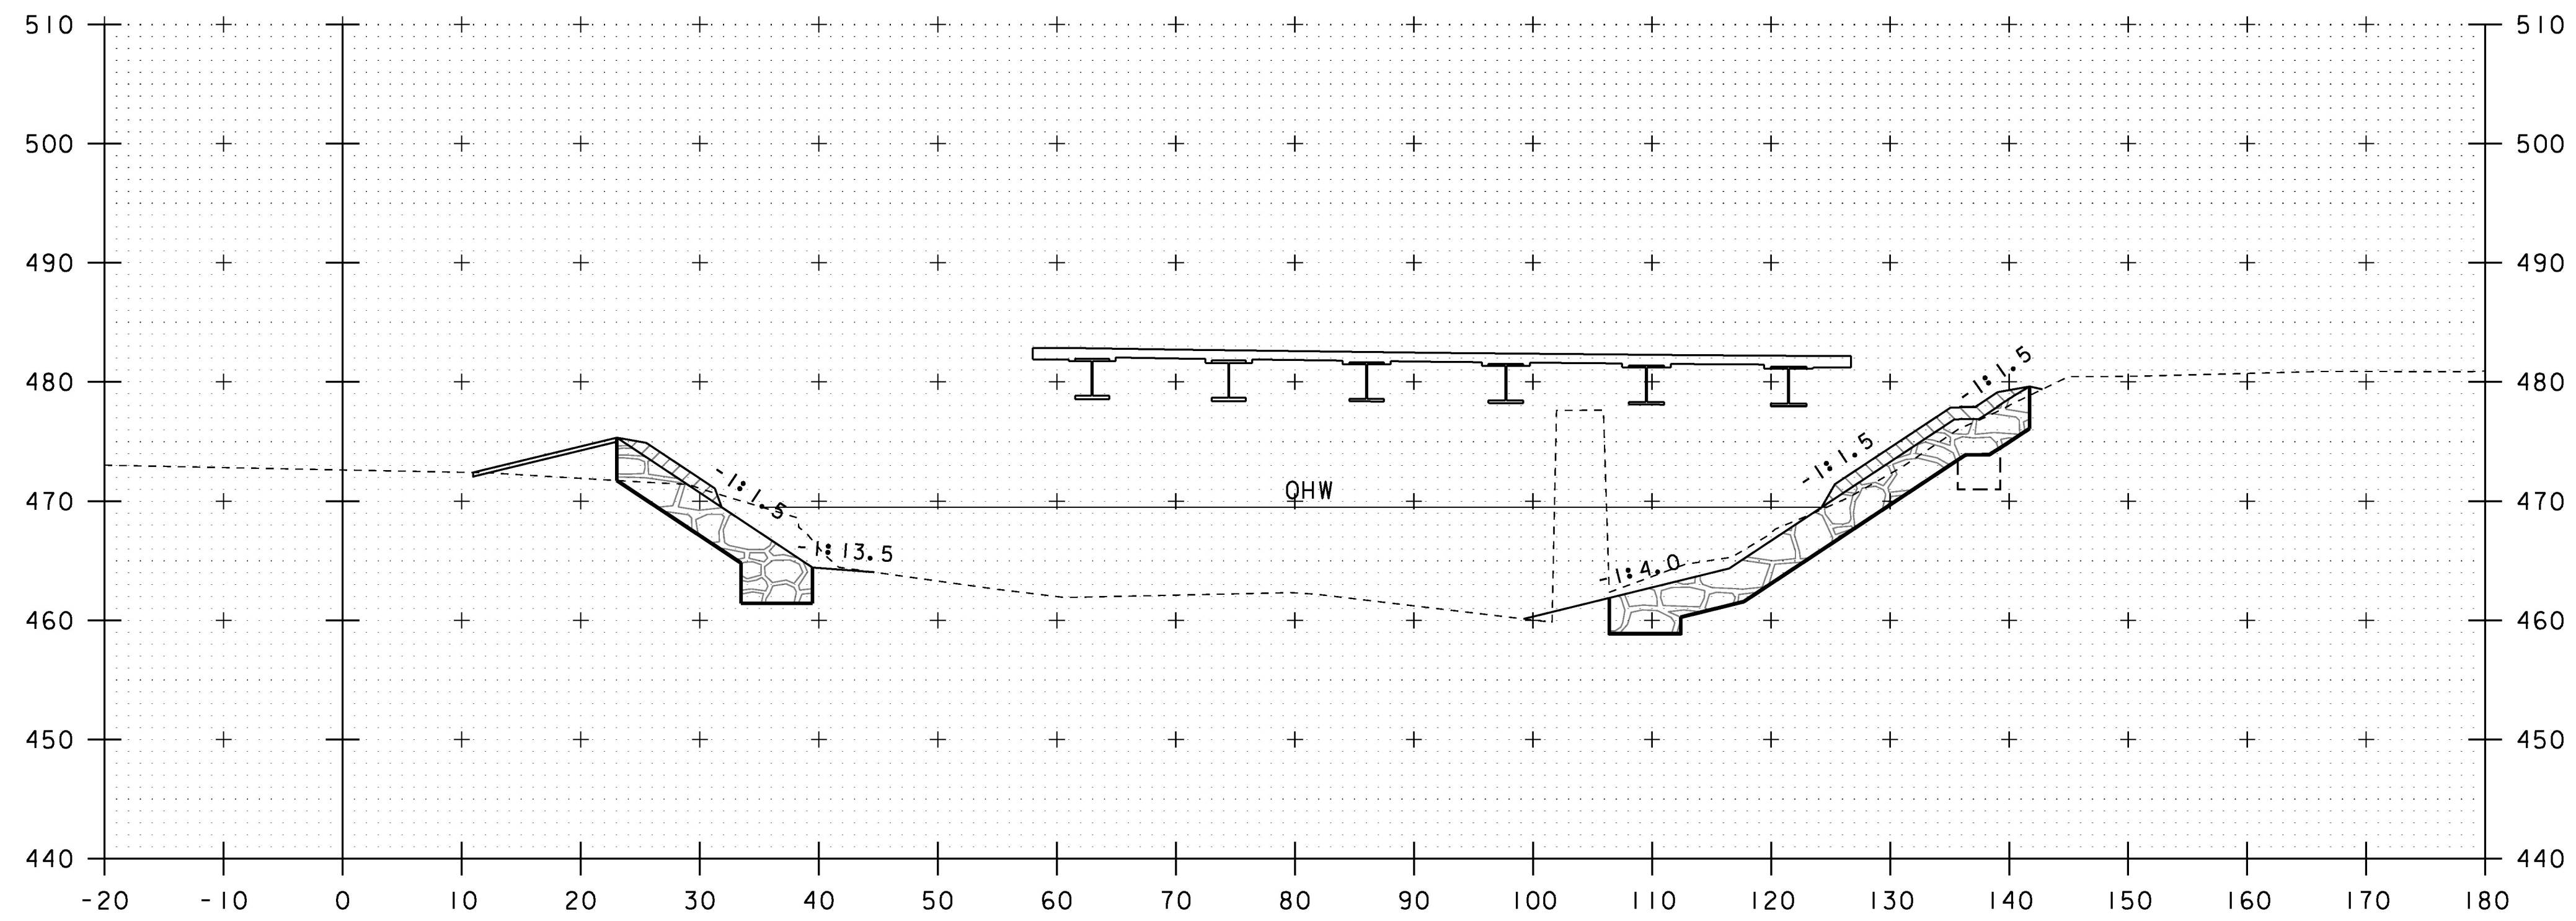

49+50

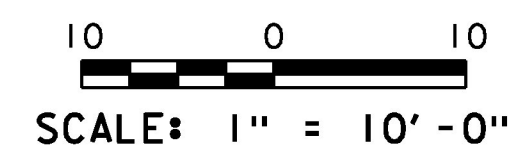

STA. 49+50 TO STA. 49+60

PROJECT NAME: BRADFORD	PLOT DATE: 15-SEP-2016
PROJECT NUMBER: BF 0191 (29)	DRAWN BY: G. ROY
FILE NAME: sl3c054xsl.dgn	CHECKED BY: M. EVANS-MONGEON
PROJECT LEADER: C. CARLSON	SHEET 56 OF 71
DESIGNED BY: G. ROY	
CHANNEL CROSS SECTION (5)	