



49+80

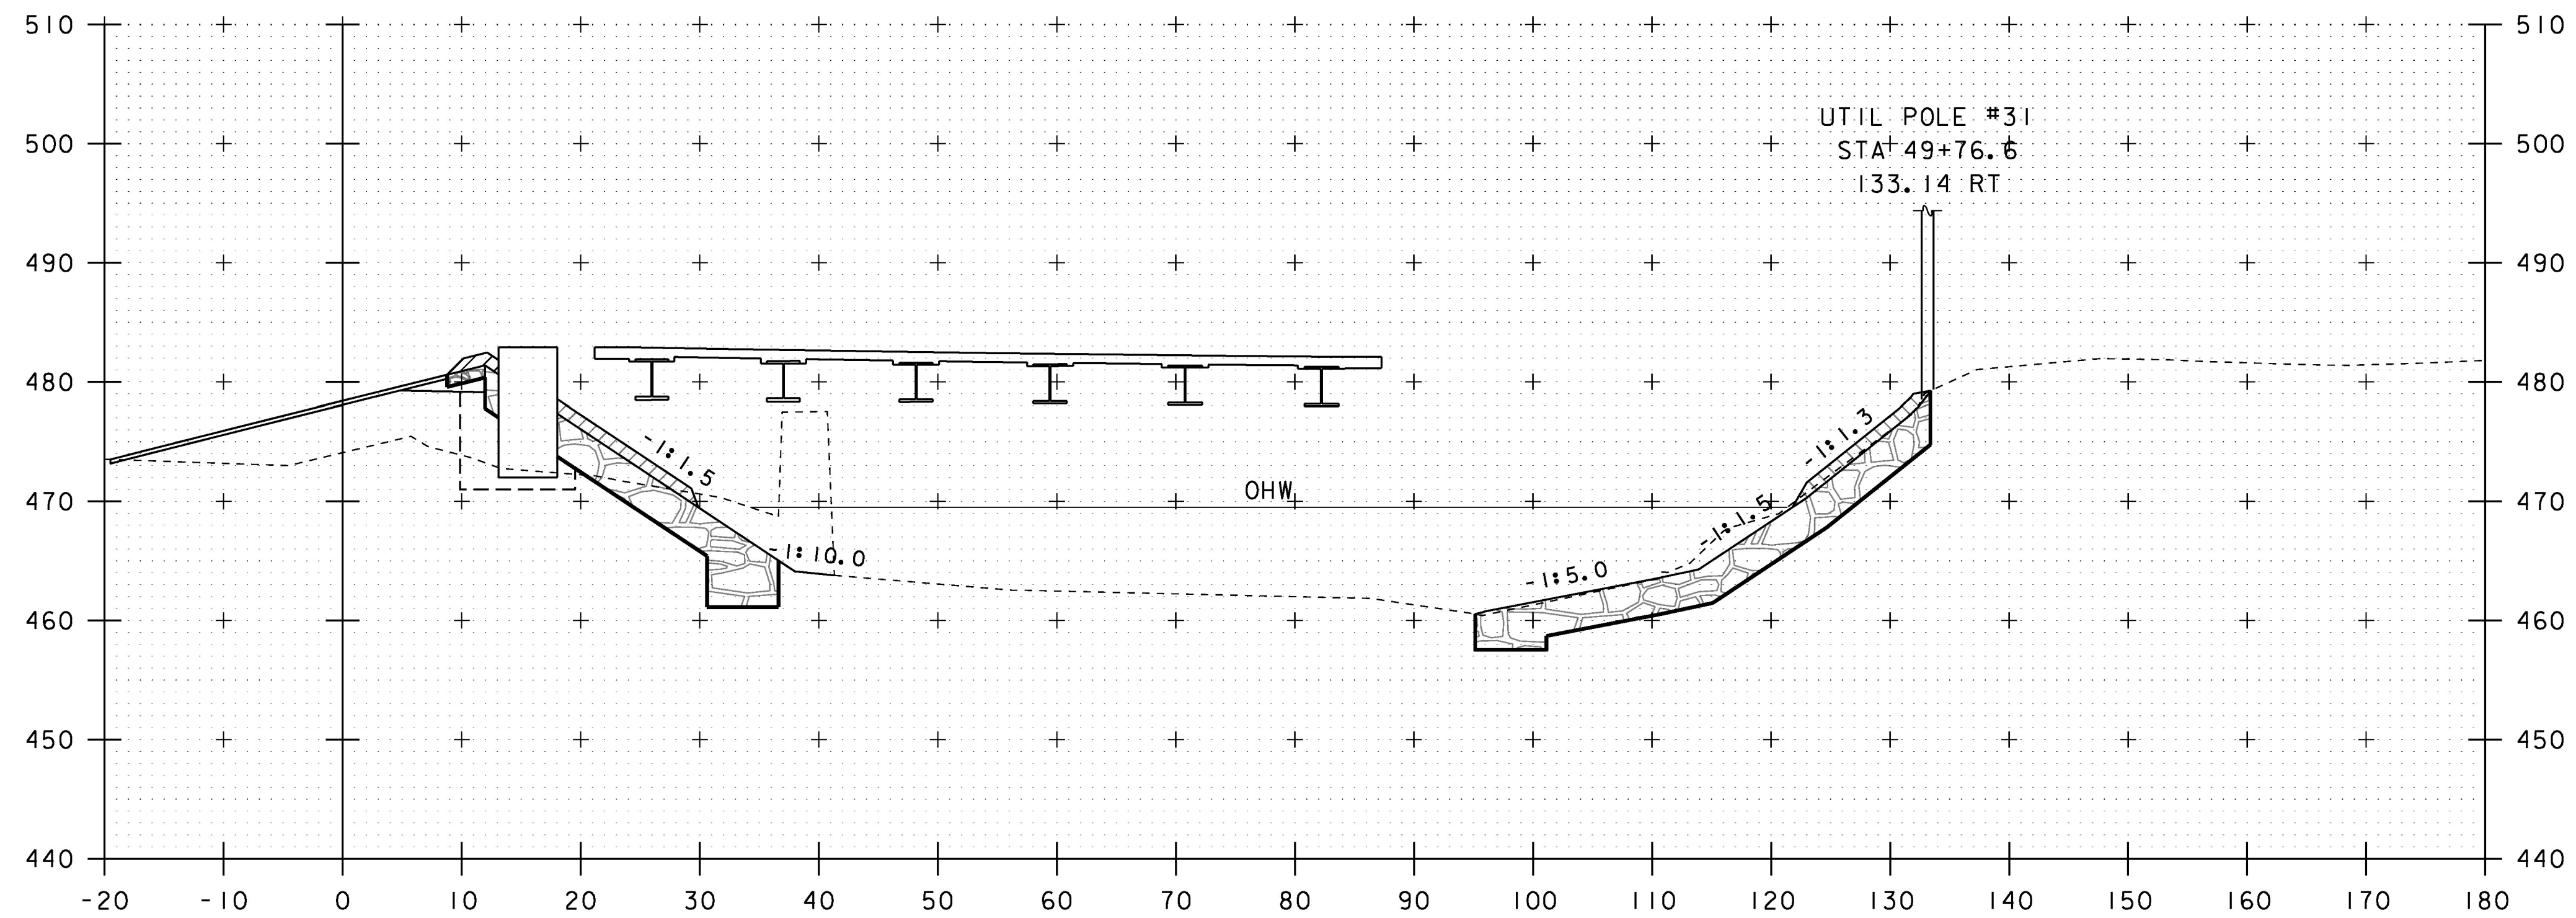

STA 49+64.3 RT
 BEGIN STRUCTURE EXCAVATION
 GRANULAR BACKFILL FOR STRUCTURES

49+70

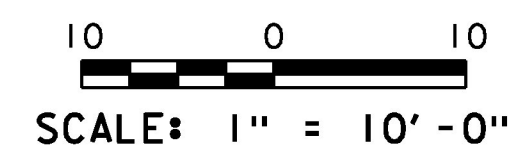

STA. 49+70 TO STA. 49+80

PROJECT NAME: BRADFORD	PLOT DATE: 15-SEP-2016
PROJECT NUMBER: BF 0191 (29)	DRAWN BY: G. ROY
FILE NAME: sl3c054xsl.dgn	CHECKED BY: M. EVANS-MONGEON
PROJECT LEADER: C. CARLSON	SHEET 57 OF 71
DESIGNED BY: G. ROY	
CHANNEL CROSS SECTION (6)	