



50+20

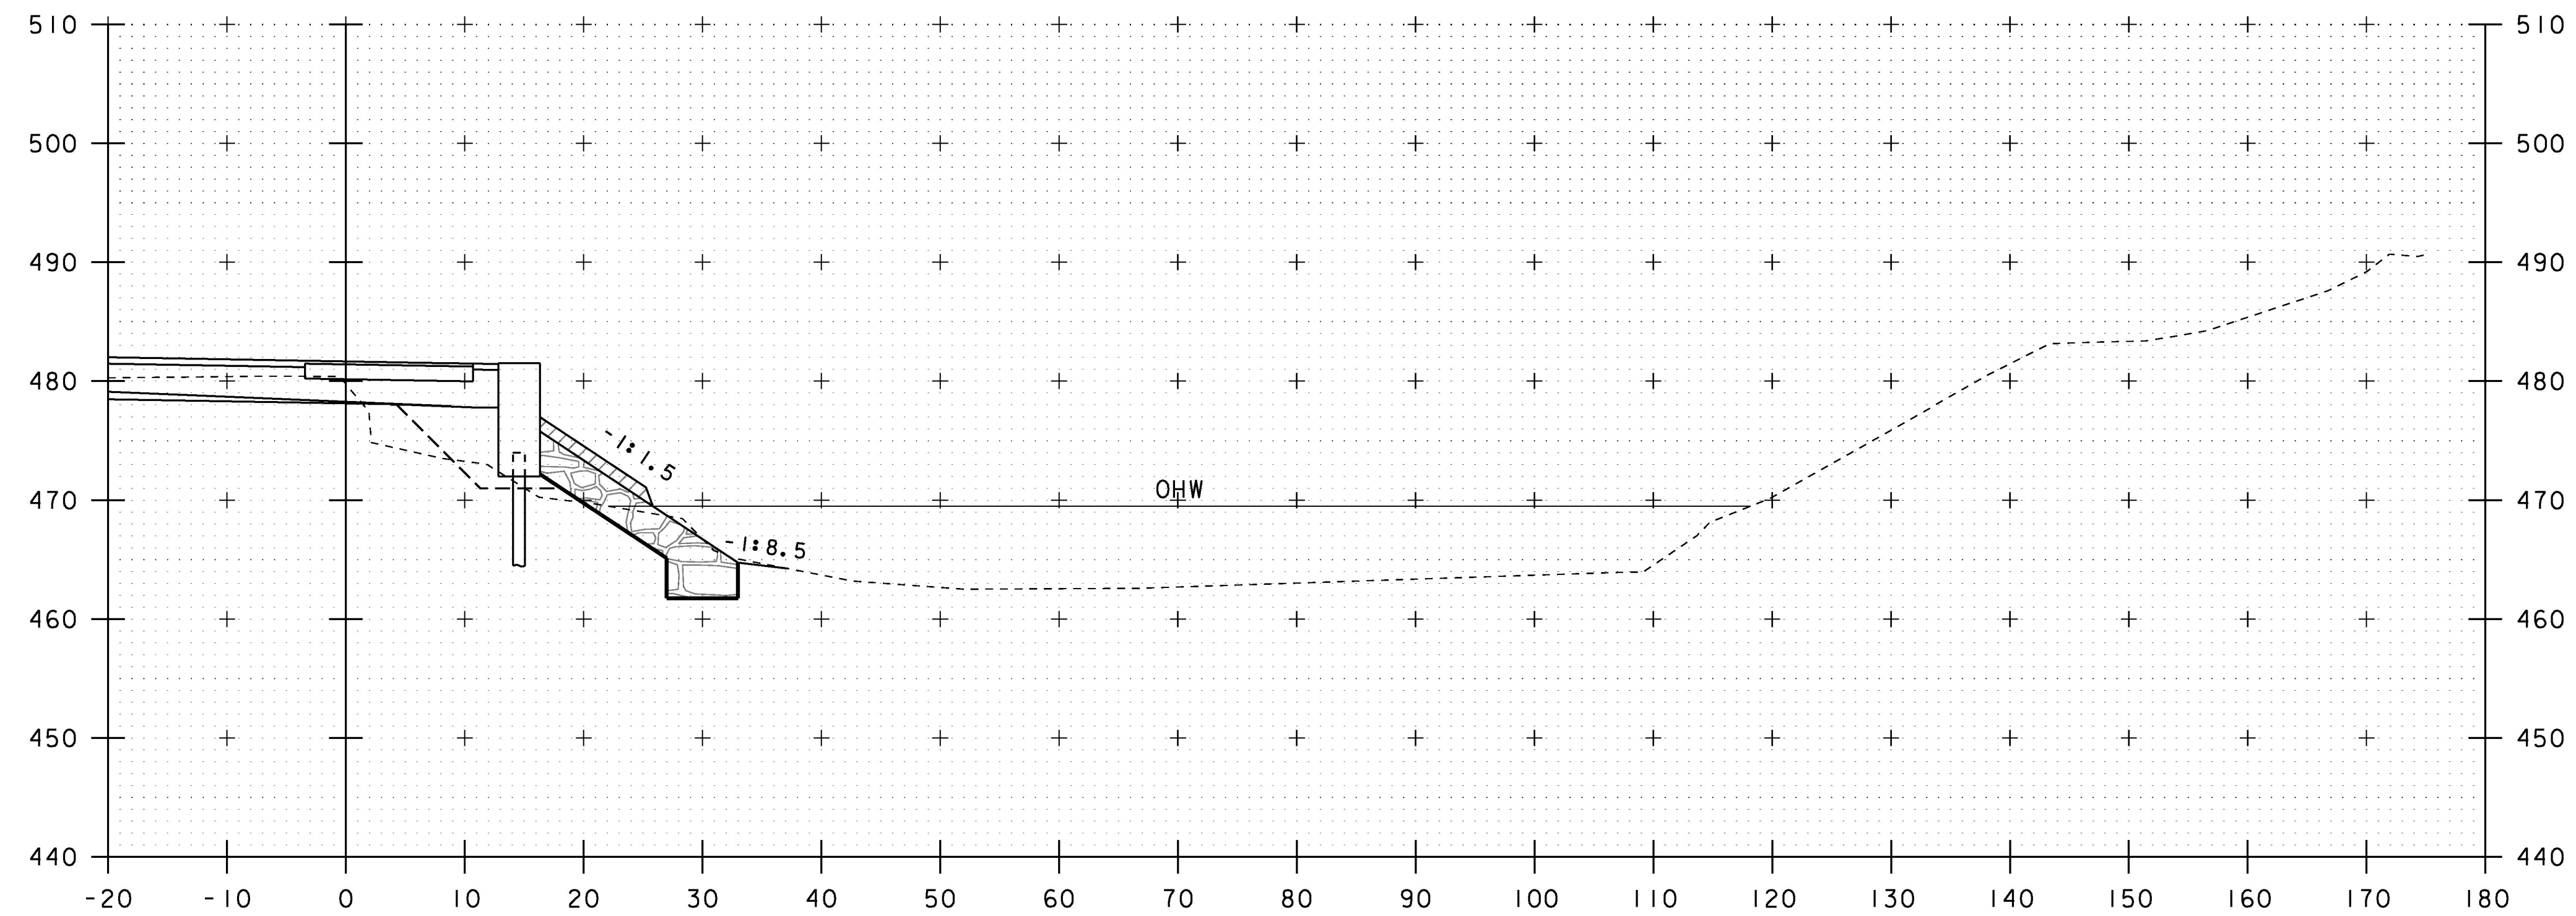

50+10

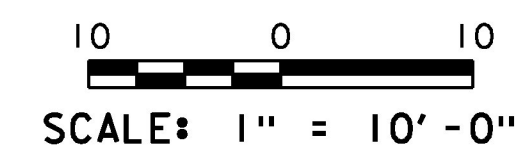

STA. 50+10 TO STA. 50+20

PROJECT NAME: BRADFORD	PLOT DATE: 15-SEP-2016
PROJECT NUMBER: BF 0191 (29)	DRAWN BY: G. ROY
FILE NAME: s13c054xsl.dgn	CHECKED BY: M. EVANS-MONGEON
PROJECT LEADER: C. CARLSON	SHEET 59 OF 71
DESIGNED BY: G. ROY	
CHANNEL CROSS SECTION (8)	