



STA 50+40.0 RT
 END UNCLASSIFIED CHANNEL EXCAVATION
 GEOTEXTILE UNDER STONE FILL
 STONE FILL, TYPE III
 GRUBBING MATERIAL

50+40

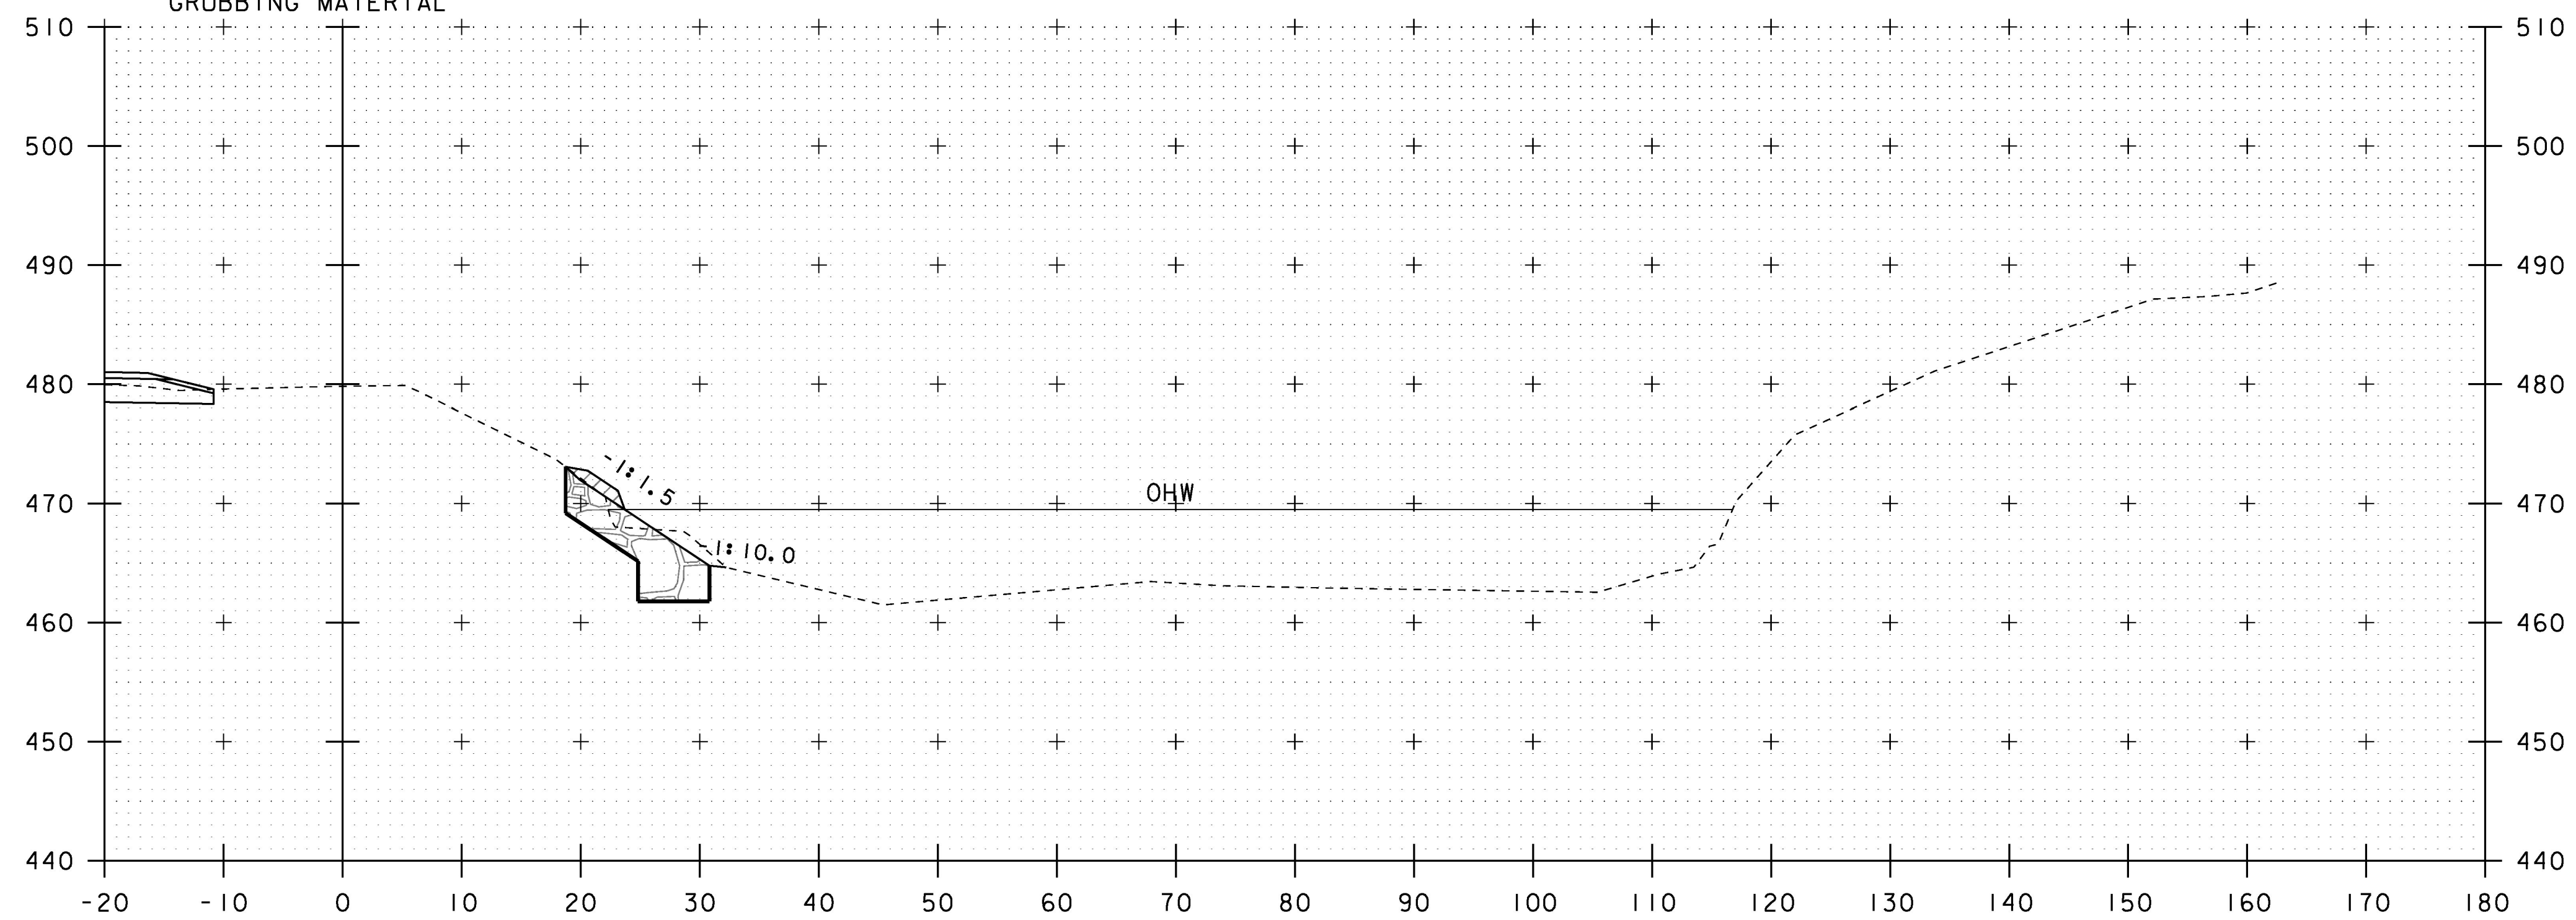

STA 50+20.2 RT
 END STRUCTURE EXCAVATION
 GRANULAR BACKFILL FOR STRUCTURES

50+30

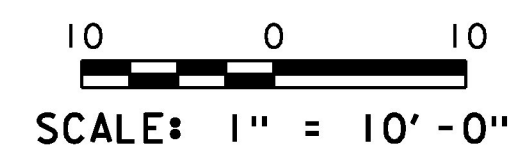

STA. 50+30 TO STA. 50+40

PROJECT NAME: BRADFORD	PLOT DATE: 15-SEP-2016
PROJECT NUMBER: BF 0191 (29)	DRAWN BY: G. ROY
FILE NAME: sl3c054xsl.dgn	CHECKED BY: M. EVANS-MONGEON
PROJECT LEADER: C. CARLSON	SHEET 60 OF 71
DESIGNED BY: G. ROY	
CHANNEL CROSS SECTION (9)	