



PLAN VIEW

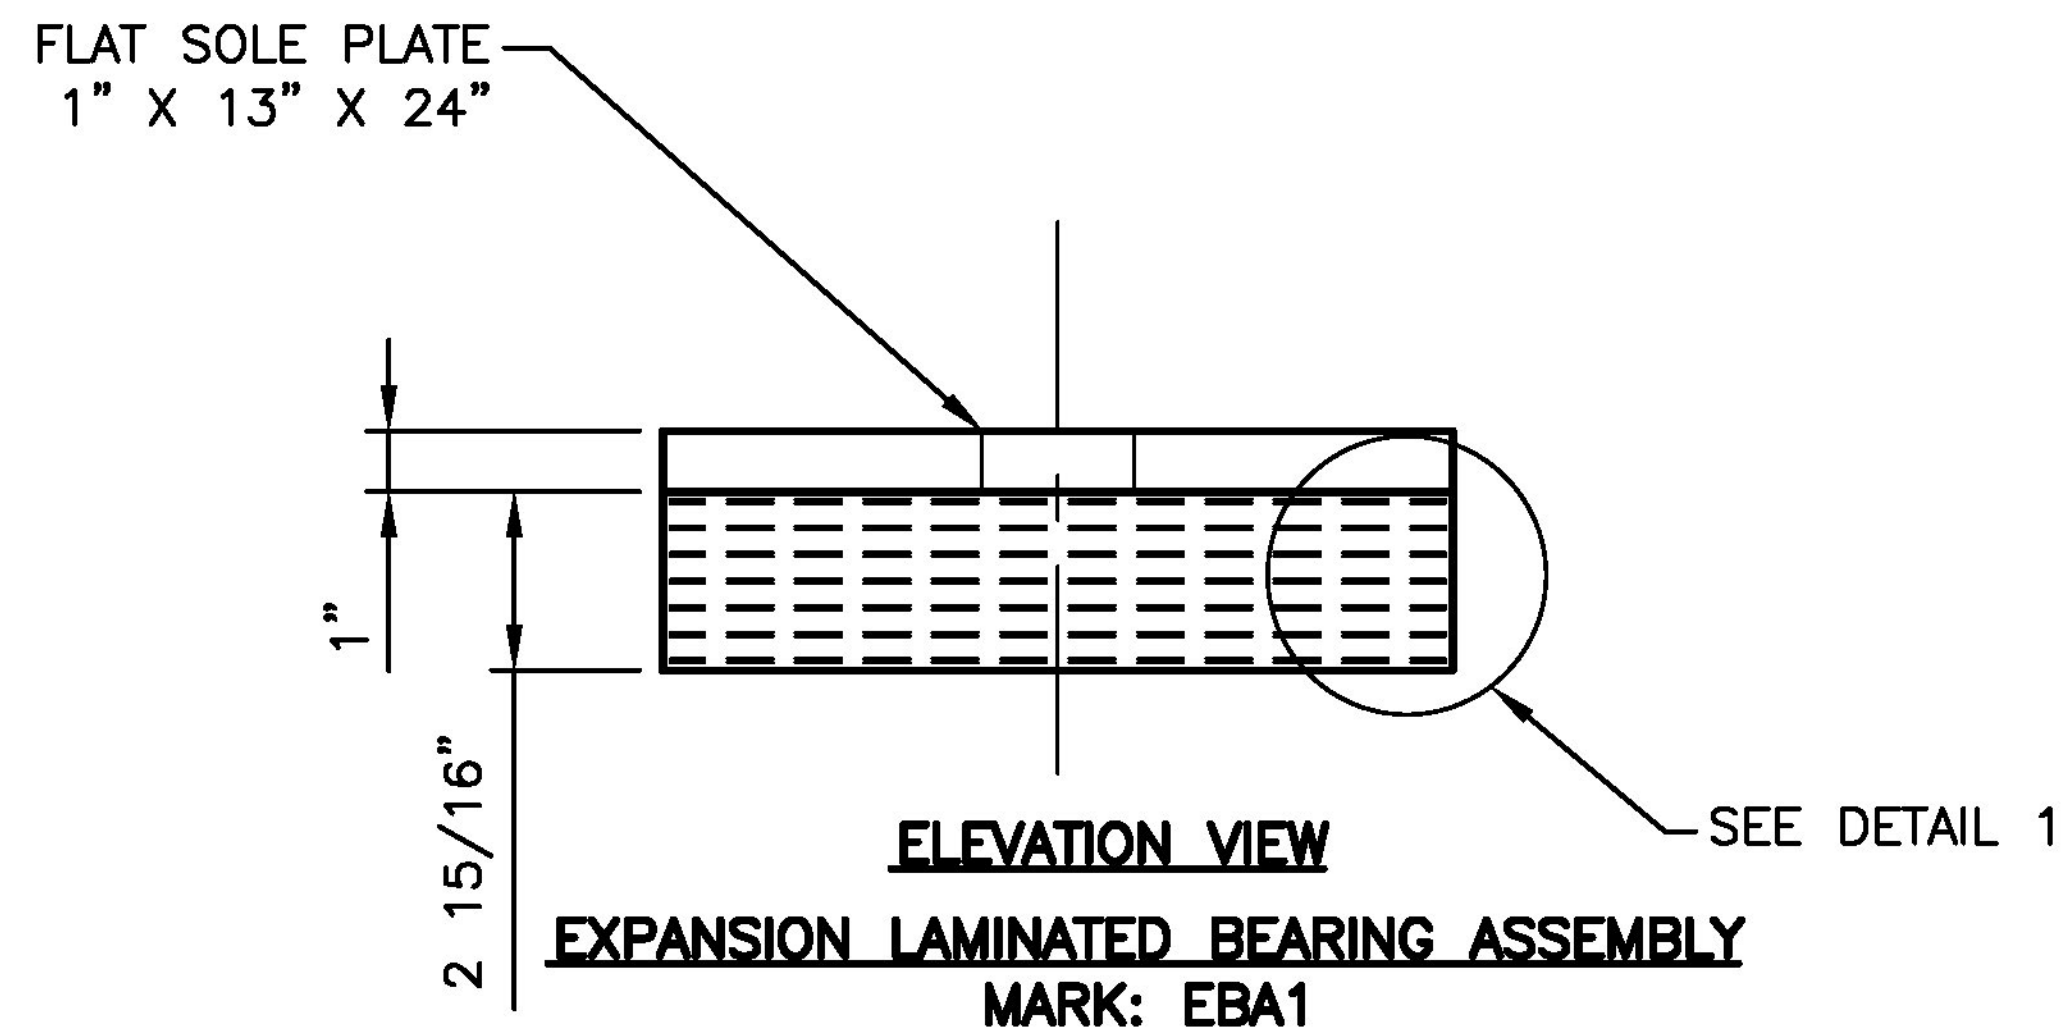

ELEVATION VIEW

EXPANSION LAMINATED BEARING ASSEMBLY
MARK: EBA1

- (6) LOCATED @ ABUT 1 GIRDER 1 - 6
- (6) LOCATED @ ABUT 2 GIRDER 1 - 6
- (12) REQUIRED

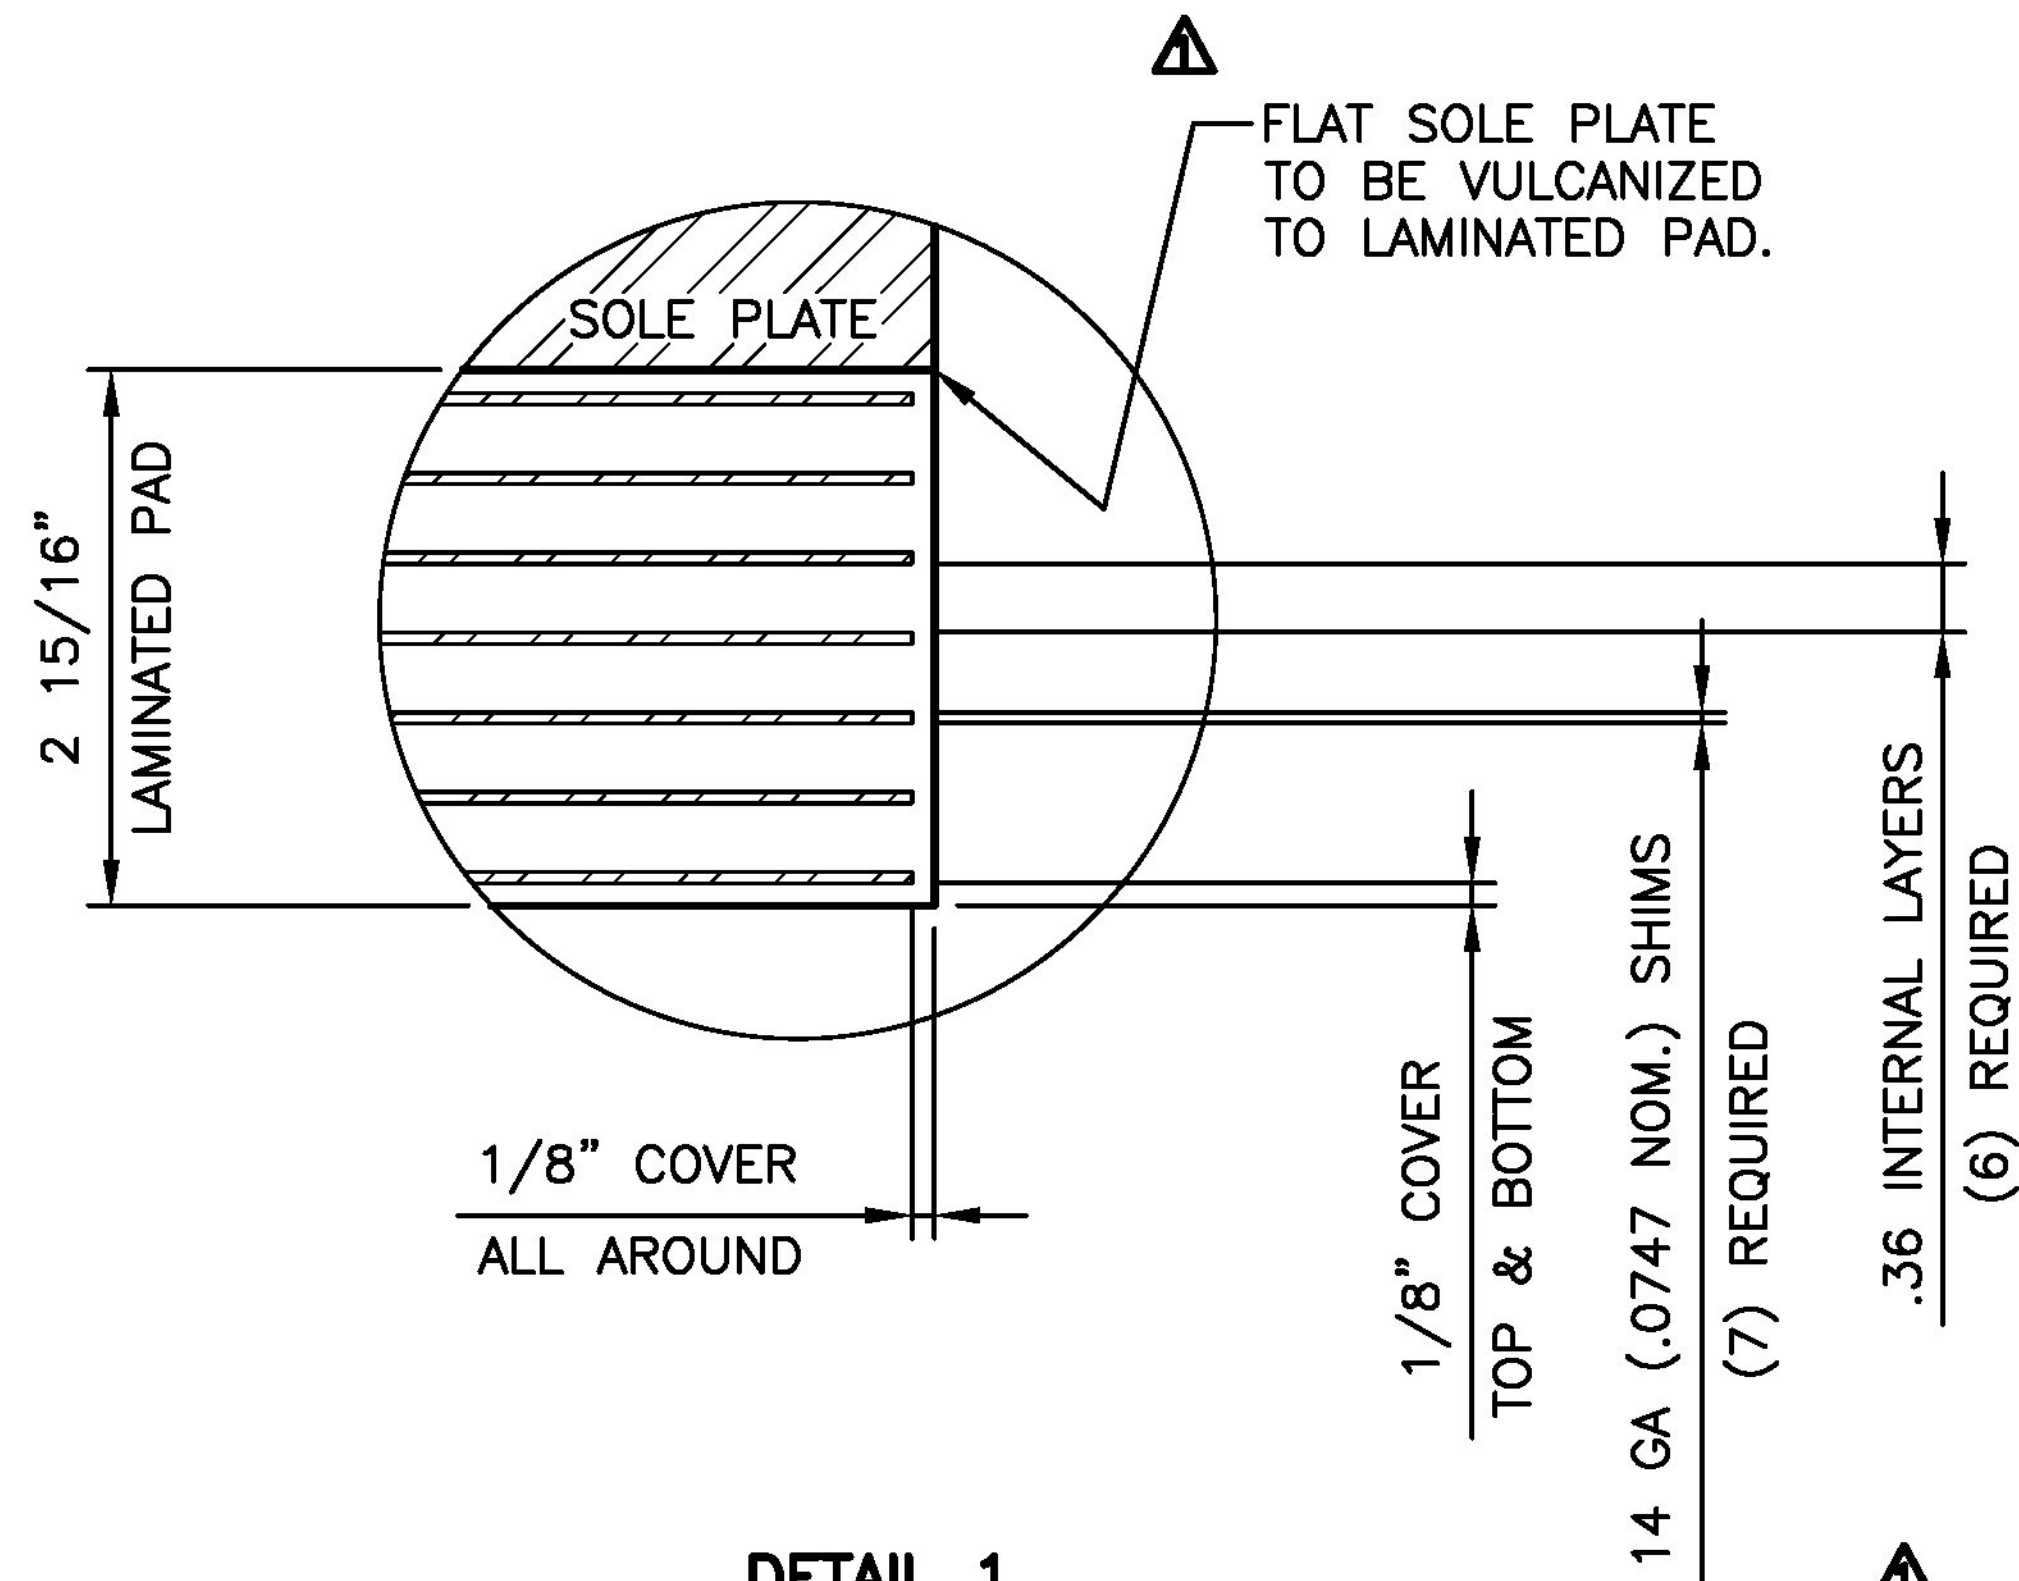

DETAIL 1

2 15/16" x 13 x 14 LAMINATED PAD
50 DUROMETER NATURAL RUBBER
W/ SHEAR MODULUS OF 110 PSI
(12) REQUIRED

TEST 1

2 15/16" x 13 x 14 LAMINATED PAD
50 DUROMETER NATURAL RUBBER
W/ SHEAR MODULUS OF 110 PSI
PAD ONLY
(2) REQUIRED

MAX. DESIGN LOADS
(UNFACTORED)
DEAD LOAD = 84 kips

Vermont Agency of Transportation

RECEIVED

13966 SHOP_DRAWING_RE SUBMITTAL.pdf

CK'D BY S. Fagan OK'D BY C. Carlson

March 9, 2017

RESUBMIT No Approved
BY Carolyn Carlson DATE 03/10/2017

STATE OF VERMONT
AGENCY OF TRANSPORTATION
ROUTE NO: VT 25B
TOWN OF BRADFORD
BRIDGE # 1

STATE	COUNTY	CONTROL NO.
VT	ORANGE	NA

PROJ. NO.: BR 0191 (29)

DYNAMIC RUBBER:
LAMINATED BEARING ASSEMBLIES

Cosmea 1501 ROCKY RIDGE ROAD
P.O. BOX 2159
ATHENS, TEXAS 75751

SCALE: NONE	DRAWN BY: FW	CHECKED BY: RB
	DATE: 2/2/17	DATE: 2/22/17

SHEET 1 OF 2 **JOB NO.: 13966**

CUSTOMER:	DRAWING NUMBER	REV.
A.L. ST. ONGE CONTRACTOR INC.	13966-D1	1

REV.	DESCRIPTION	BY	DATE	CK'D	DATE
	ADDED VULCANIZING NOTE, REMOVED APPROVERS NOTES, AND CORRECTED NAME IN TITLE BLOCK	JRB	3/3/17	ELS	3/6/17