


- * 1 1/2" SUPERPAVE BITUMINOUS CONCRETE PAVEMENT TYPE IVB OVER
- 1 1/2" SUPERPAVE BITUMINOUS CONCRETE PAVEMENT TYPE IVB OVER
- 2 1/2" SUPERPAVE BITUMINOUS CONCRETE PAVEMENT TYPE IIS OVER
- 2 1/2" SUPERPAVE BITUMINOUS CONCRETE PAVEMENT TYPE IIS

ROADWAY TYPICAL SECTION

SCALE 1/2" = 1'-0"

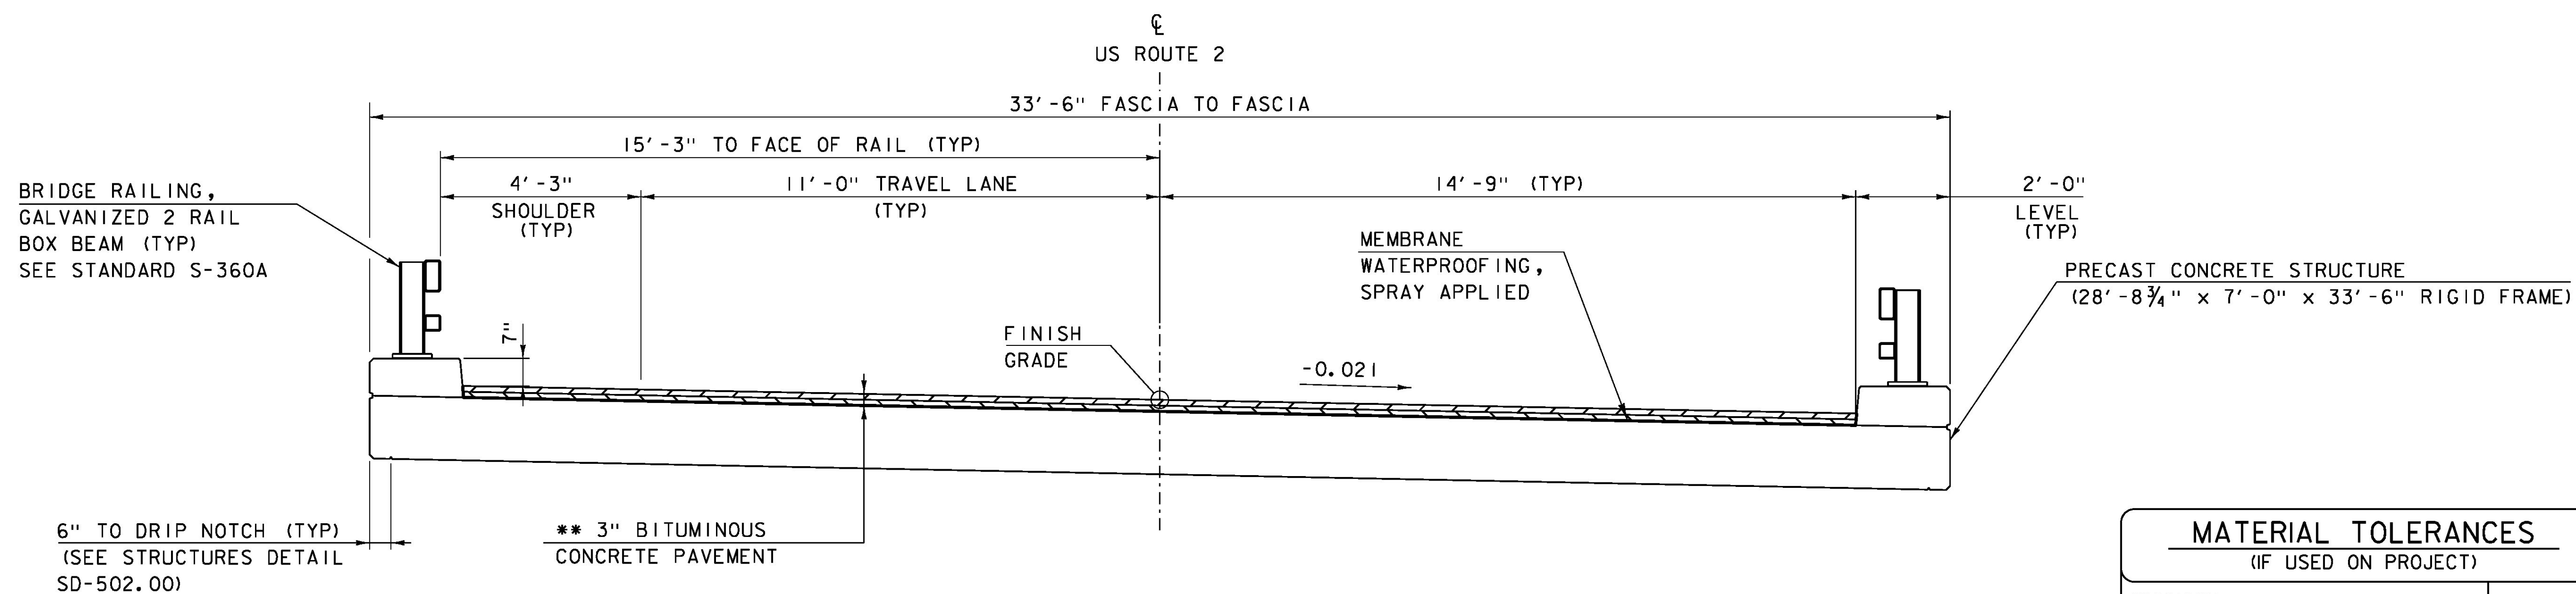

- ** 1 1/2" SUPERPAVE BITUMINOUS CONCRETE PAVEMENT TYPE IVB OVER
- 1 1/2" SUPERPAVE BITUMINOUS CONCRETE PAVEMENT TYPE IVB OVER

FRAME TYPICAL SECTION

SCALE 1/2" = 1'-0"

MATERIAL TOLERANCES (IF USED ON PROJECT)	
SURFACE	
- PAVEMENT (TOTAL THICKNESS)	+/- 1/4"
- AGGREGATE SURFACE COURSE	+/- 1/2"
SUBBASE	+/- 1"
SAND BORROW	+/- 1"

PROJECT NAME:	RICHMOND
PROJECT NUMBER:	BF 0284(28)
FILE NAME:	sl3c070+yp.dgn
PROJECT LEADER:	R. YOUNG
DESIGNED BY:	W. LAMMER
TYPICAL SECTIONS 1	
PLOT DATE:	13-SEP-2016
DRAWN BY:	S. COLEY
CHECKED BY:	W. LAMMER
SHEET	8 OF 54