


US 2 PROFILE

HOR. SCALE 1" = 20' - 0"
 VER. SCALE 1" = 10' - 0"

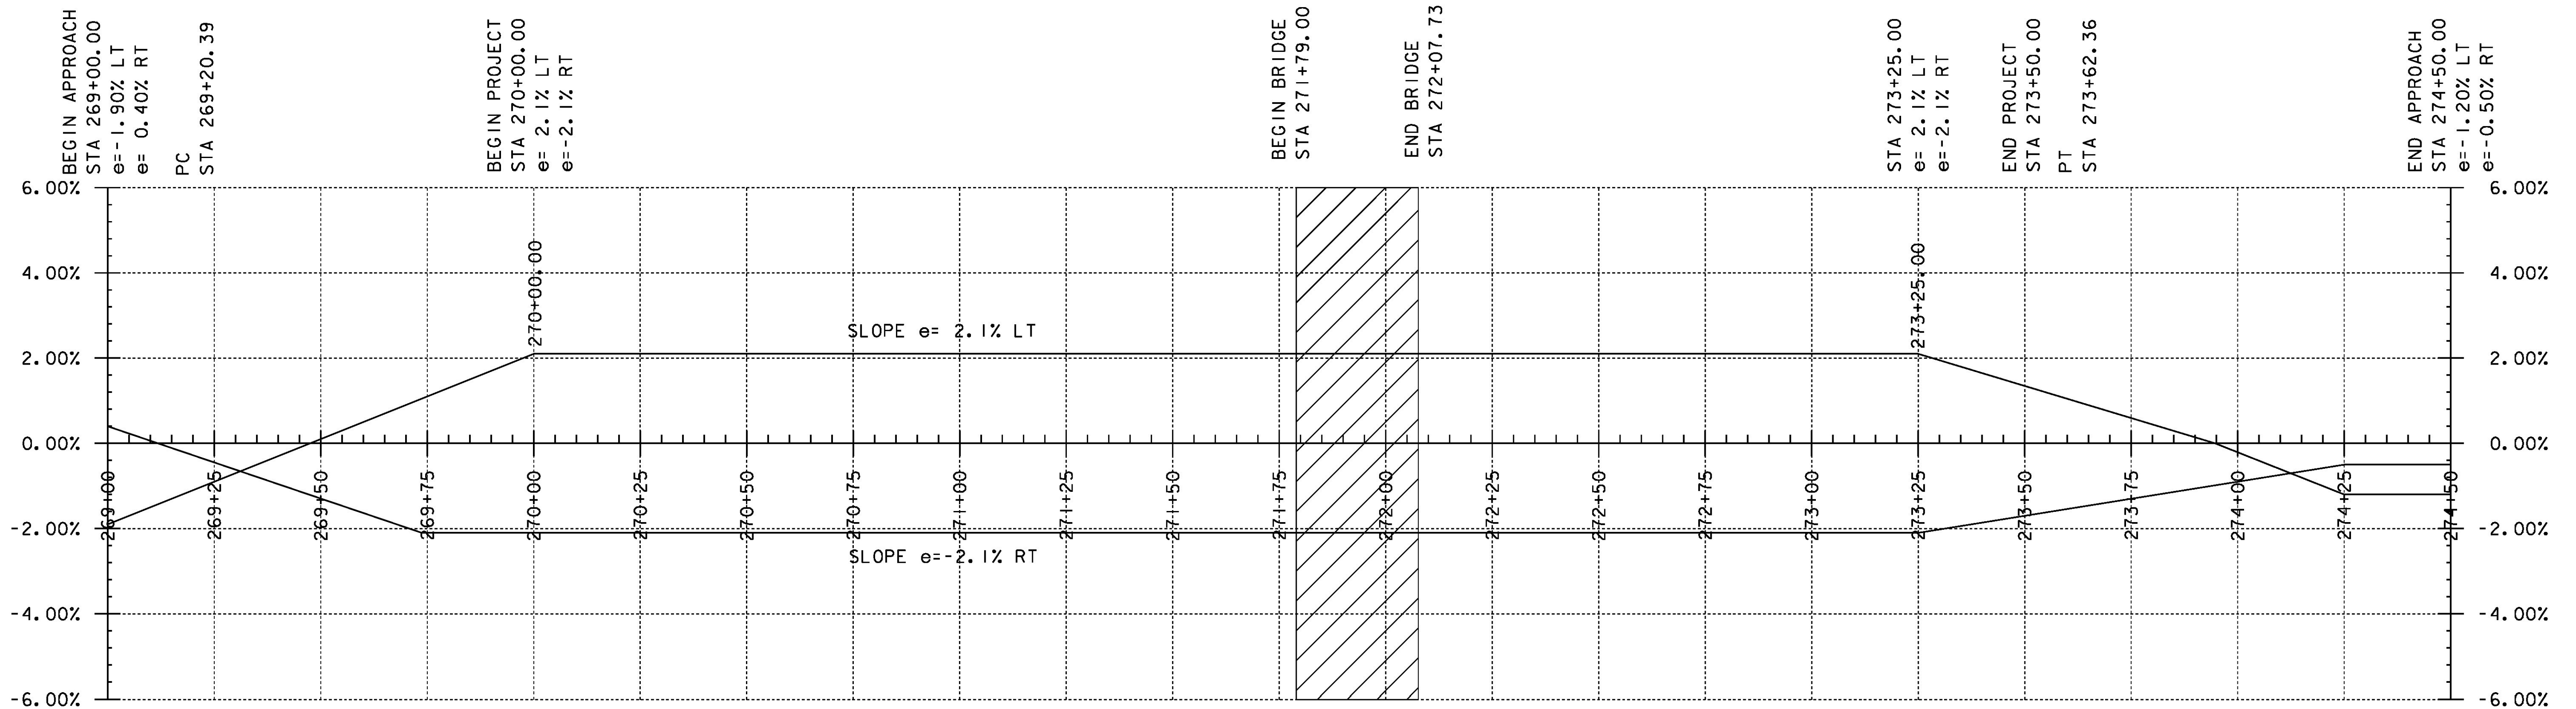

US 2 BANKING DIAGRAM

HOR. 1" = 20' - 0"
 VER. 1" = 10' - 0"

NOTE:
 THE GRADES SHOWN TO THE NEAREST TENTH ARE THE EXISTING GROUND ELEVATIONS ALONG THE PROPOSED ALIGNMENT.
 THE GRADES SHOWN TO THE NEAREST HUNDREDTH ARE THE FINISHED GROUND ELEVATIONS ALONG THE PROPOSED ALIGNMENT.

PROJECT NAME: RICHMOND	
PROJECT NUMBER: BF 0284(28)	
FILE NAME: I3c070profile.dgn	PLOT DATE: 13-SEP-2016
PROJECT LEADER: R. YOUNG	DRAWN BY: S. COLEY
DESIGNED BY: S. COLEY	CHECKED BY: W. LAMMER
MAINLINE PROFILE AND BANKING DIAGRAM	SHEET 14 OF 54