


TH-12 PROFILE

HOR. SCALE 1" = 20'-0"
VER. SCALE 1" = 10'-0"

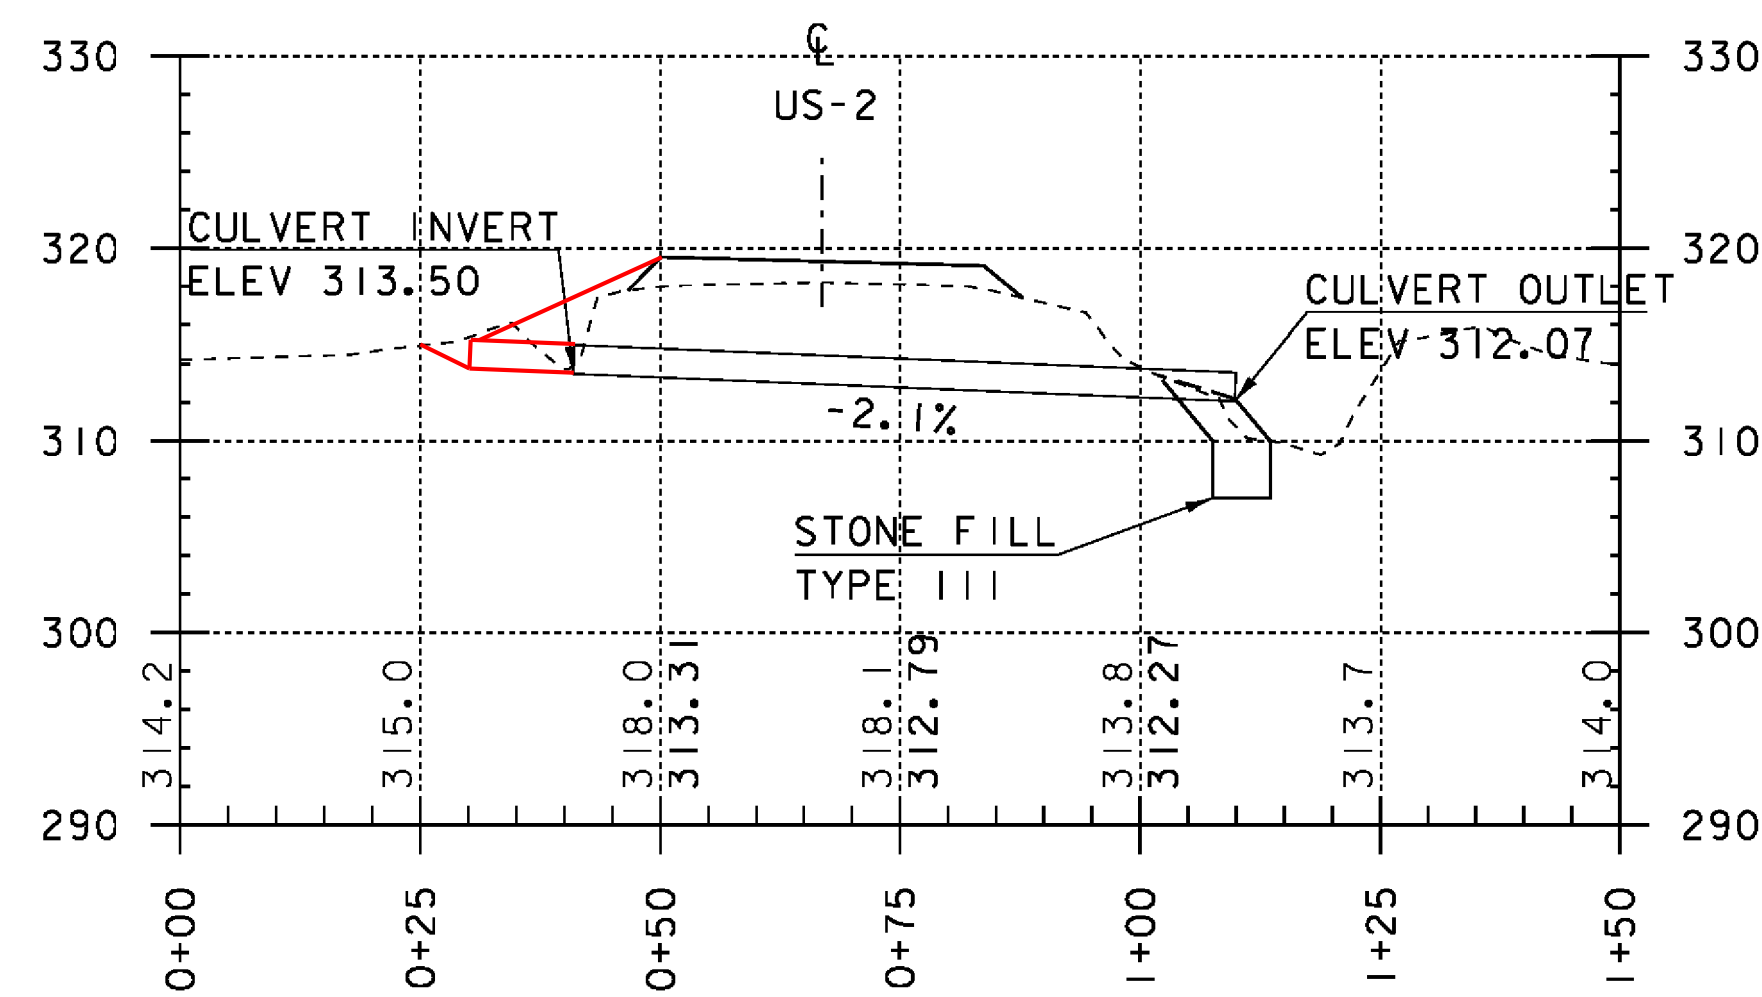


OPTION PIPE

HOR. SCALE 1" = 20'-0"
VER. SCALE 1" = 10'-0"

NOTE:

THE GRADES SHOWN TO THE NEAREST TENTH ARE THE EXISTING GROUND ELEVATIONS ALONG THE PROPOSED ALIGNMENT.

THE GRADES SHOWN TO THE NEAREST HUNDREDTH ARE THE FINISHED GROUND ELEVATIONS ALONG THE PROPOSED ALIGNMENT.

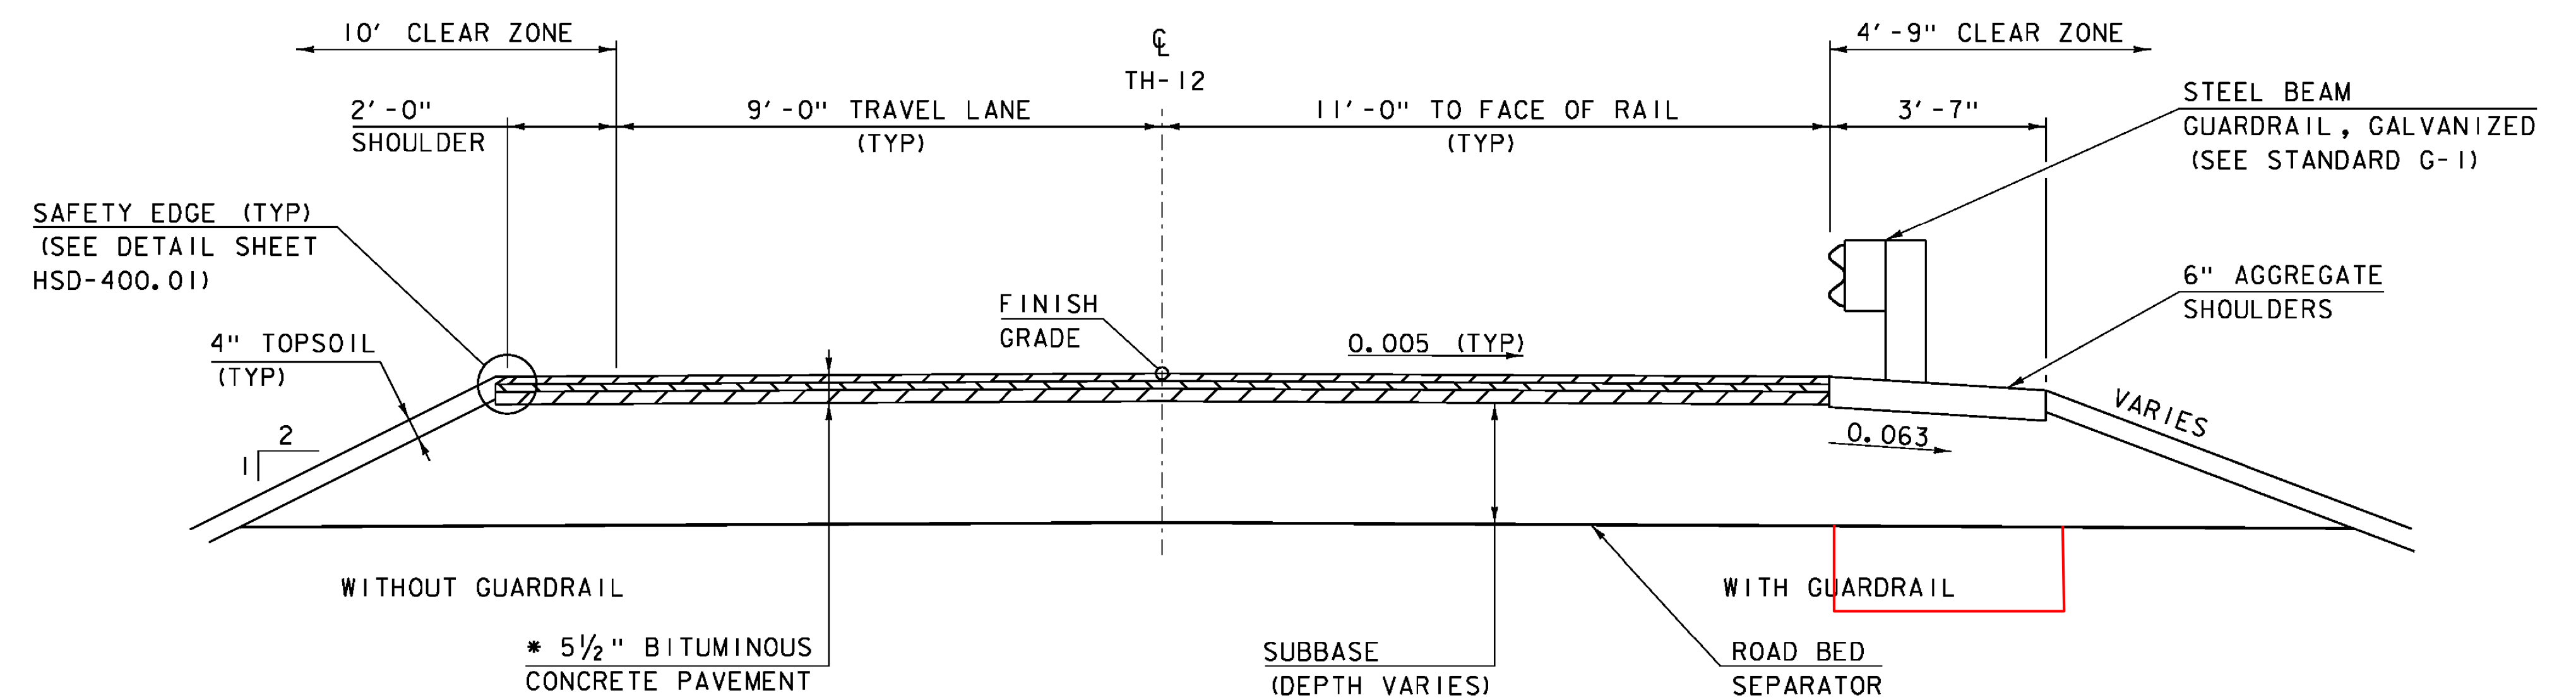

TH-12 TYPICAL SECTION

SCALE 1/2" = 1'-0"

- * 1 1/2" SUPERPAVE BITUMINOUS CONCRETE PAVEMENT TYPE IVB OVER
- 1 1/2" SUPERPAVE BITUMINOUS CONCRETE PAVEMENT TYPE IVB OVER
- 2 1/2" SUPERPAVE BITUMINOUS CONCRETE PAVEMENT TYPE IIS

PROJECT NAME: RICHMOND
PROJECT NUMBER: BF 0284(28)

FILE NAME: I3c070profile.dgn
PROJECT LEADER: R. YOUNG
DESIGNED BY: S. COLEY
TH 12 PROFILE AND TYPICAL SECTION

PLOT DATE: 13-SEP-2016
DRAWN BY: S. COLEY
CHECKED BY: W. LAMMER
SHEET 15 OF 54