


DURABLE 4 INCH WHITE LINE
 STA 269+00 RT - 274+50 RT
 STA 269+00 LT - 30+50 LT
 STA 30+50 RT - 274+50 LT

DURABLE 4 INCH YELLOW LINE (DOUBLE)

STA 269+00 - 271+25 CL
 STA 271+75 - 274+50 CL
 STA 30+19 - 30+50 CL

DURABLE 24" STOP BAR
 STA. 30+19.11 LT

DURABLE LETTER OR SYMBOL (STOP)
 STA. 271+49 LT - 271+59 LT

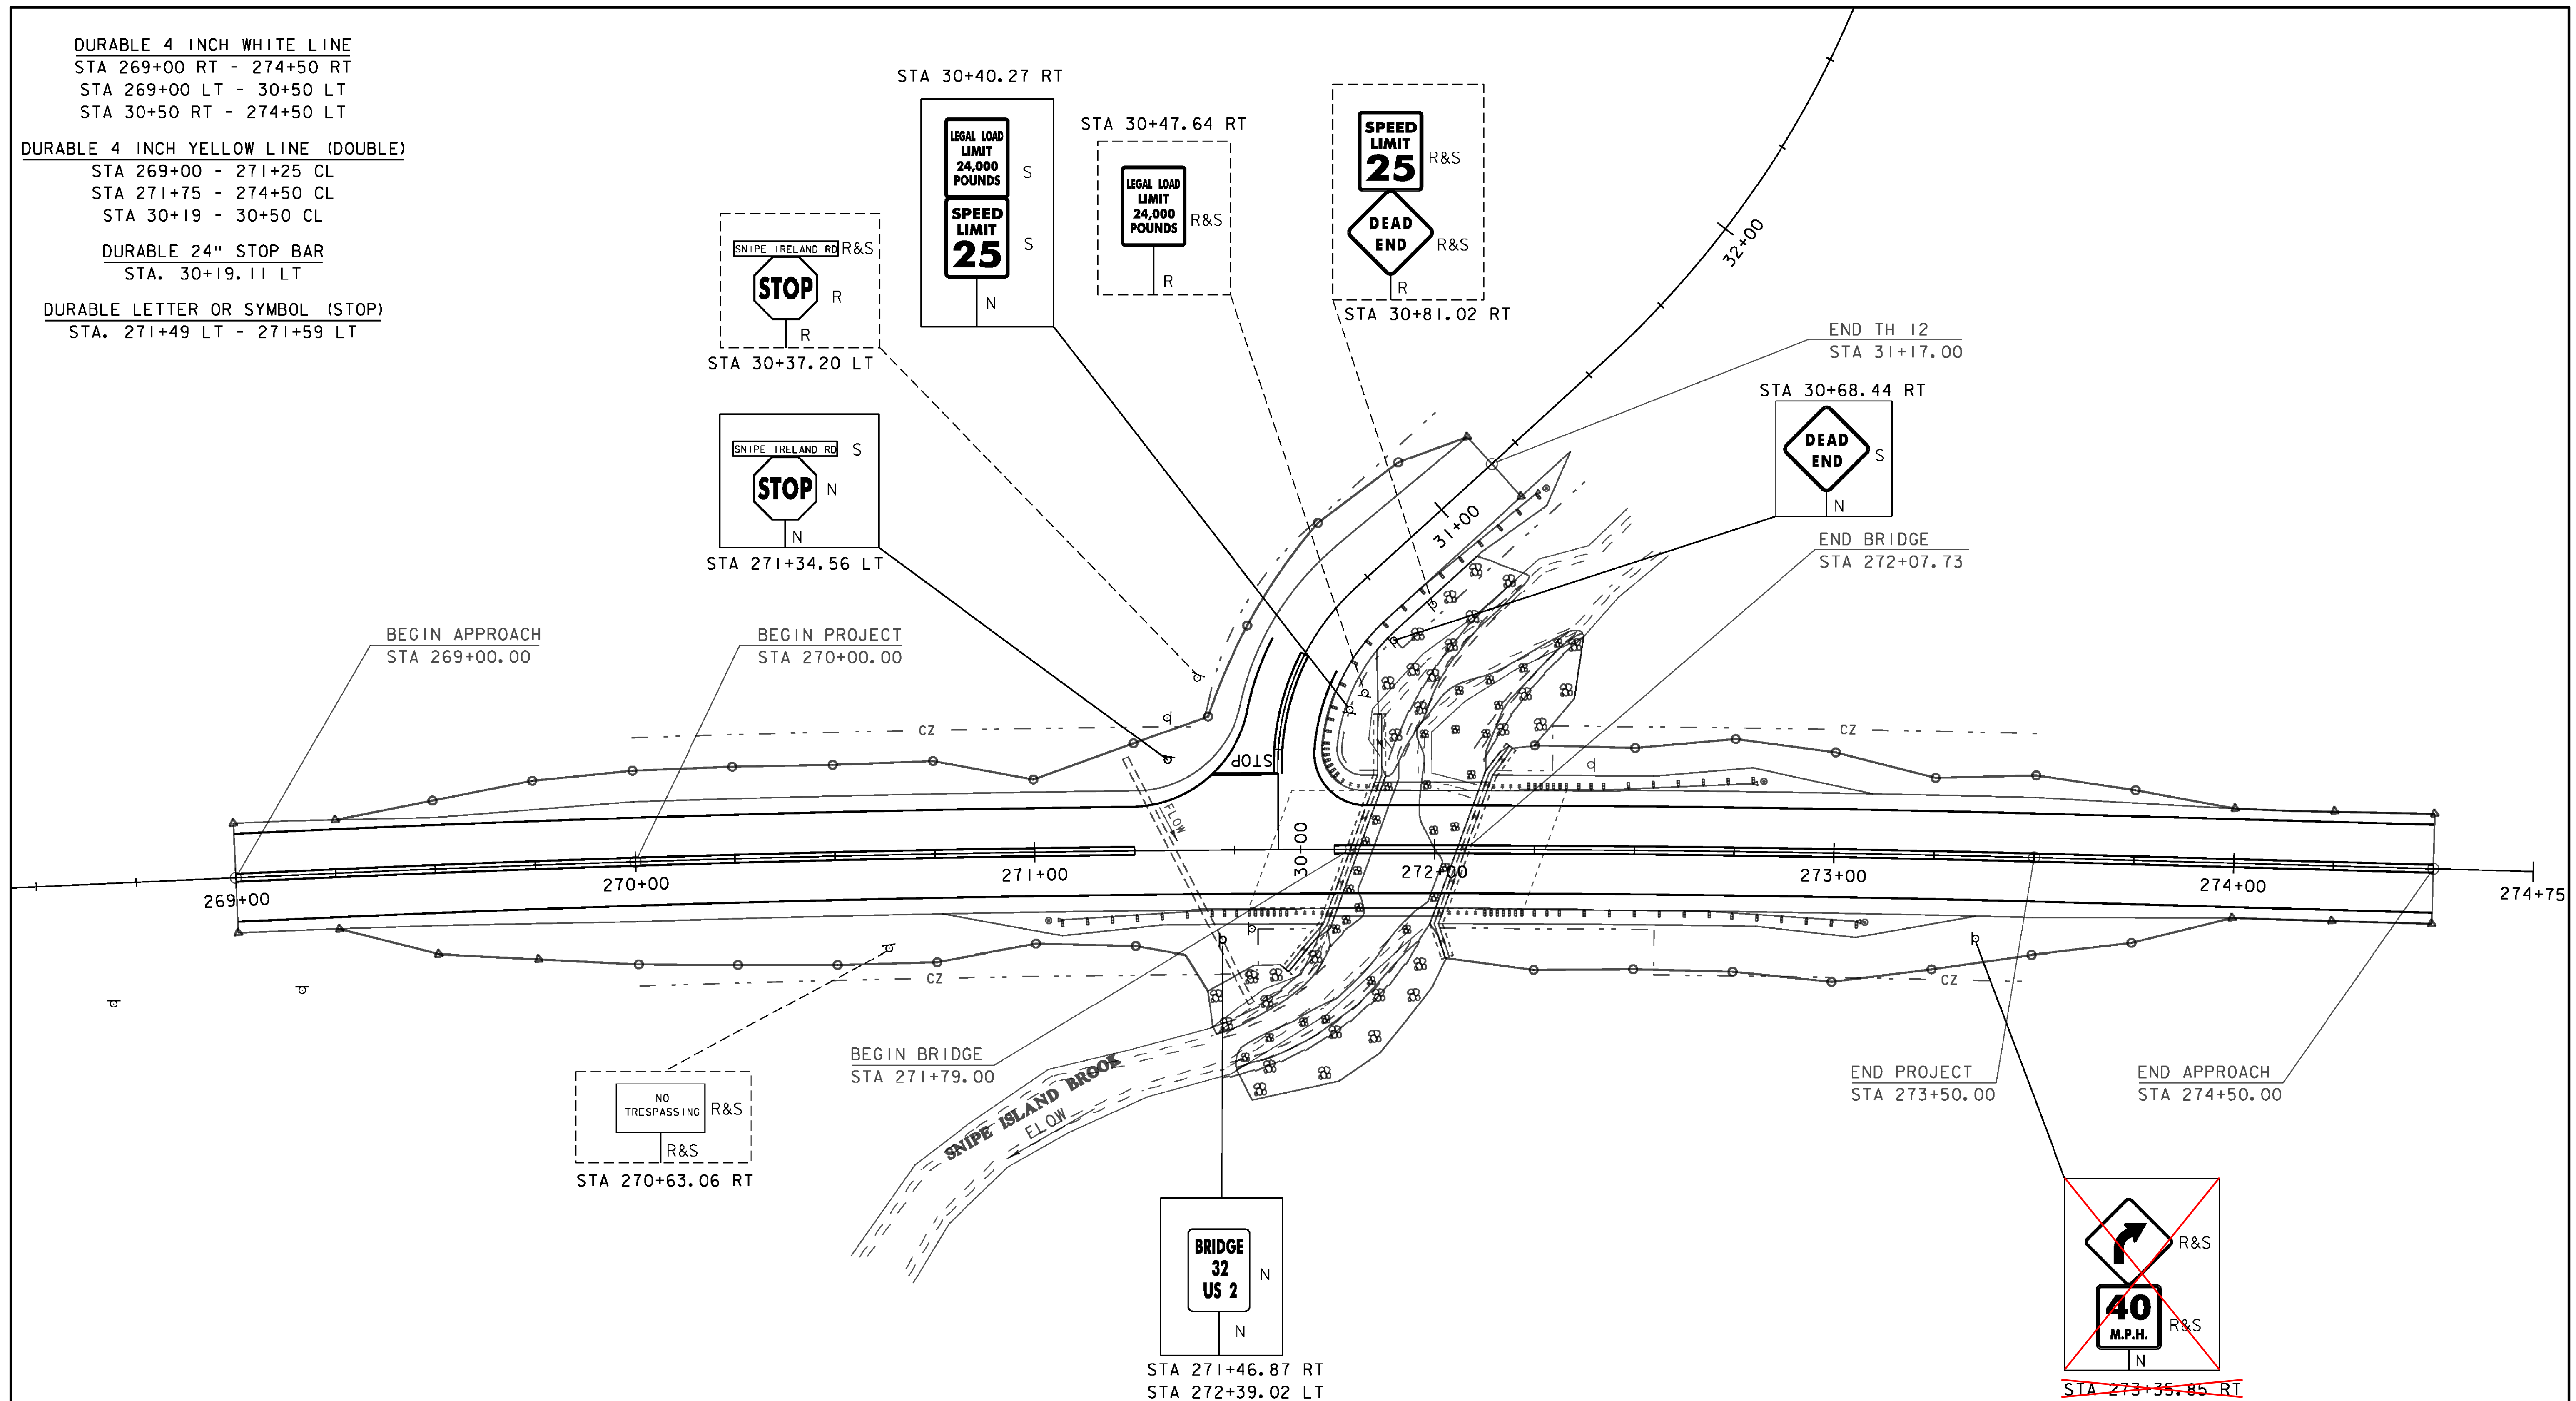

SIGN LEGEND	
N	= NEW
R	= REMOVE
S	= SALVAGE
R&S	= REMOVE & SALVAGE
RET	= RETAIN

SCALE 1" = 20' - 0"
 20 0 20

PROJECT NAME:	RICHMOND	PLOT DATE:	13-SEP-2016
PROJECT NUMBER:	BF 0284 (28)	DRAWN BY:	S. COLEY
FILE NAME:	s13c070sign.dgn	DESIGNED BY:	S. COLEY
PROJECT LEADER:	R. YOUNG	CHECKED BY:	W. LAMMER
SIGN AND PAVEMENT MARKINGS SHEET		SHEET 18 OF 54	