


PILE CAP I PLAN

SCALE 3/8" = 1'-0"

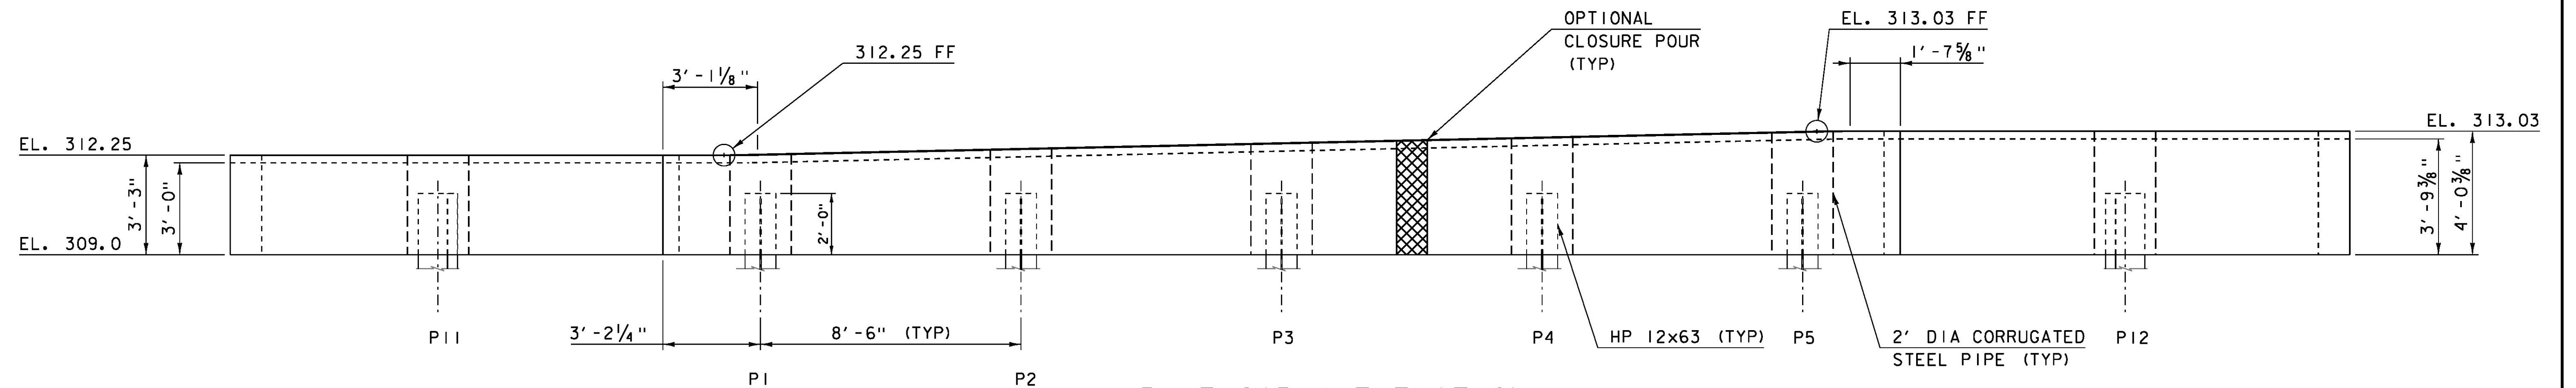

PILE CAP I ELEVATION

SCALE 3/8" = 1'-0"

NOTE:

- 1. EACH SECTION OF THE OPTIONAL CLOSURE POUR MUST INCLUDE AT LEAST TWO PILES.
- NF = NEAR FACE
- FF = FAR FACE

SPECIAL PROVISION (HIGH PERFORMANCE CONCRETE, RAPID SET)

PROJECT NAME: RICHMOND
PROJECT NUMBER: BF 0284(28)

FILE NAME: si3c070sub.dgn
PROJECT LEADER: R. YOUNG
DESIGNED BY: S. COLEY
PLOT DATE: 13-SEP-2016
DRAWN BY: S. COLEY
CHECKED BY: W. LAMMER
PILE CAP I PLAN
SHEET 26 OF 54