




DOWNSTREAM ELEVATION
LOOKING UPSTREAM
SCALE 1/4" = 1'-0"

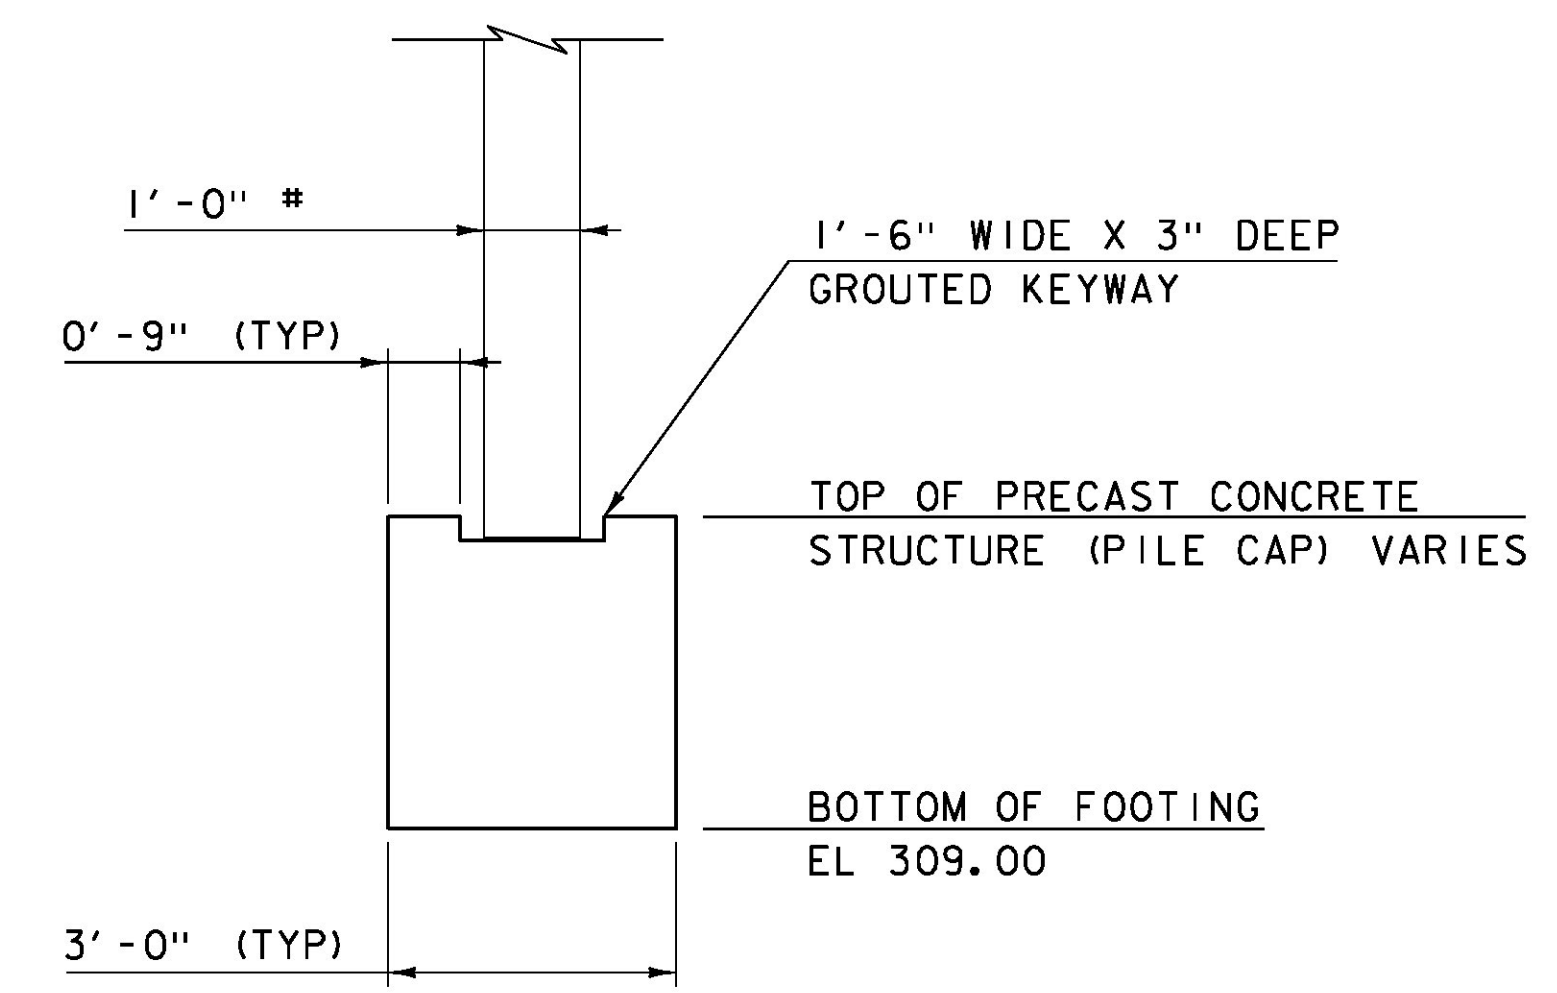

WINGWALL SECTION
SCALE 1/2" = 1'-0"

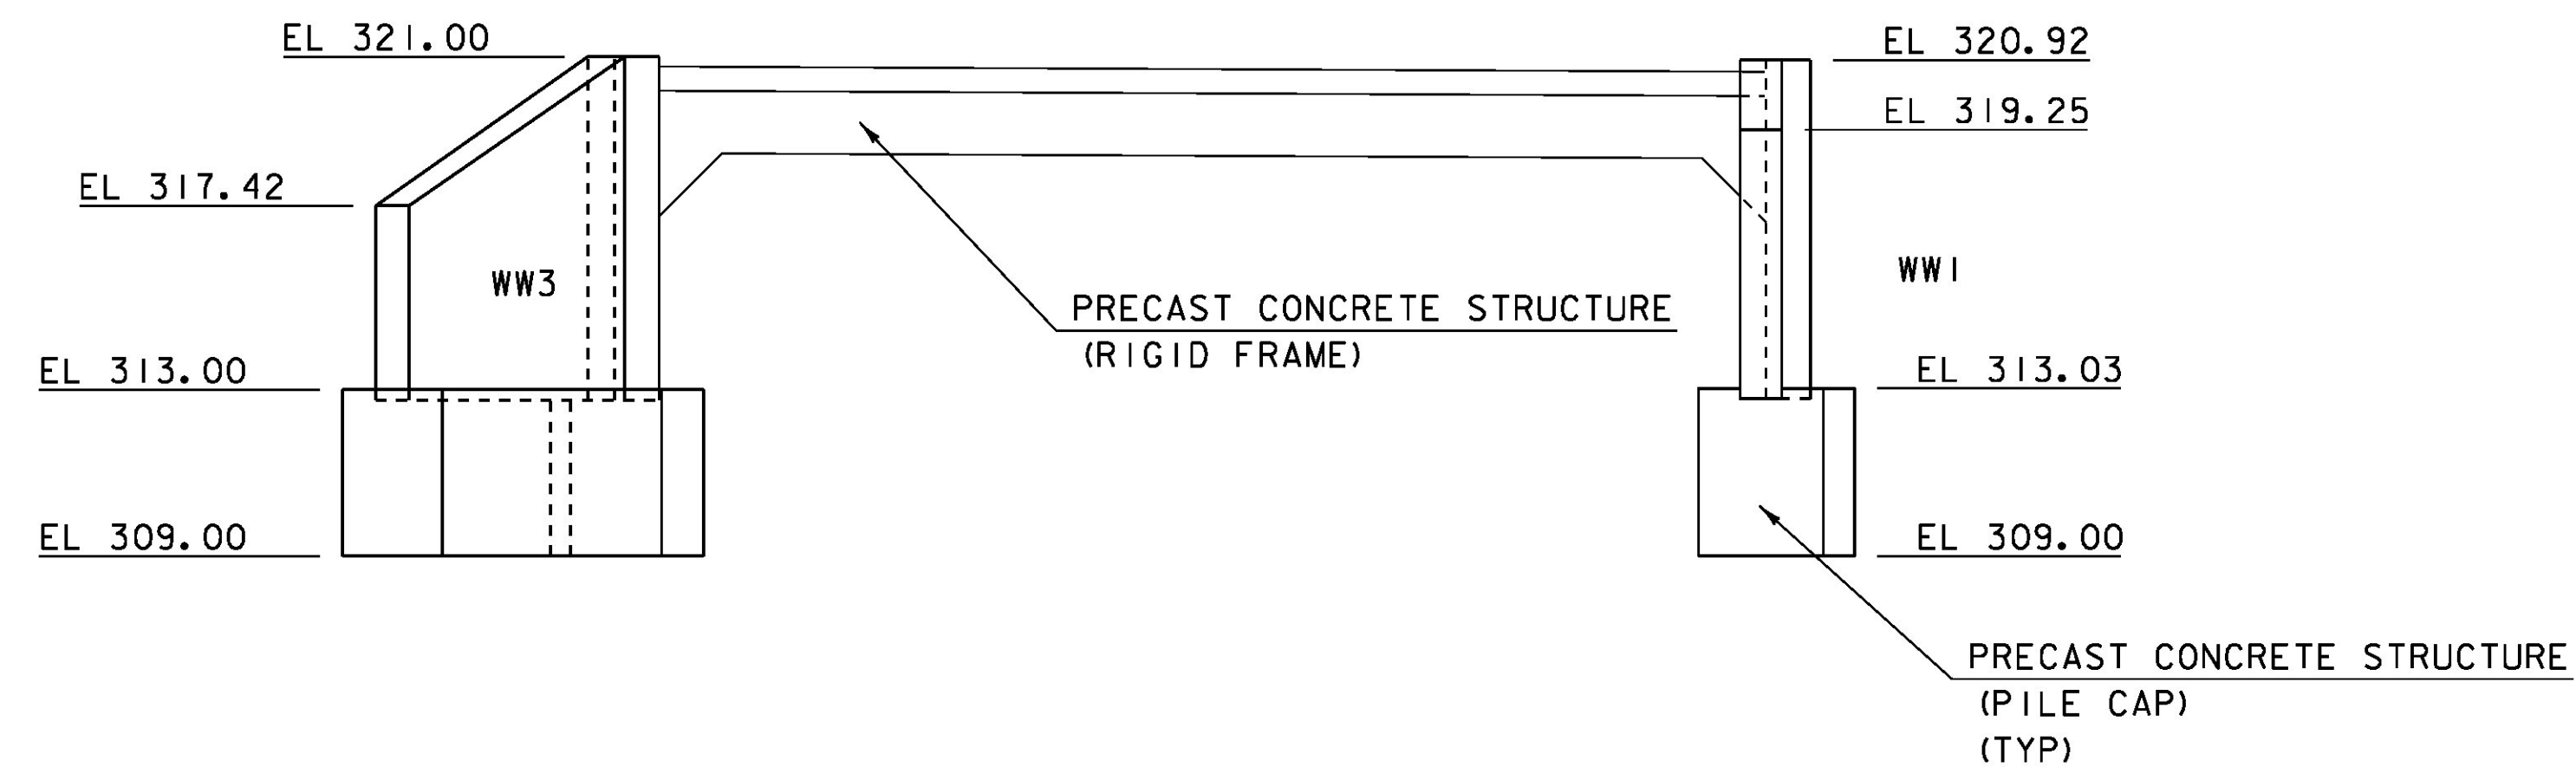

UPSTREAM ELEVATION
LOOKING DOWNSTREAM
SCALE 1/4" = 1'-0"

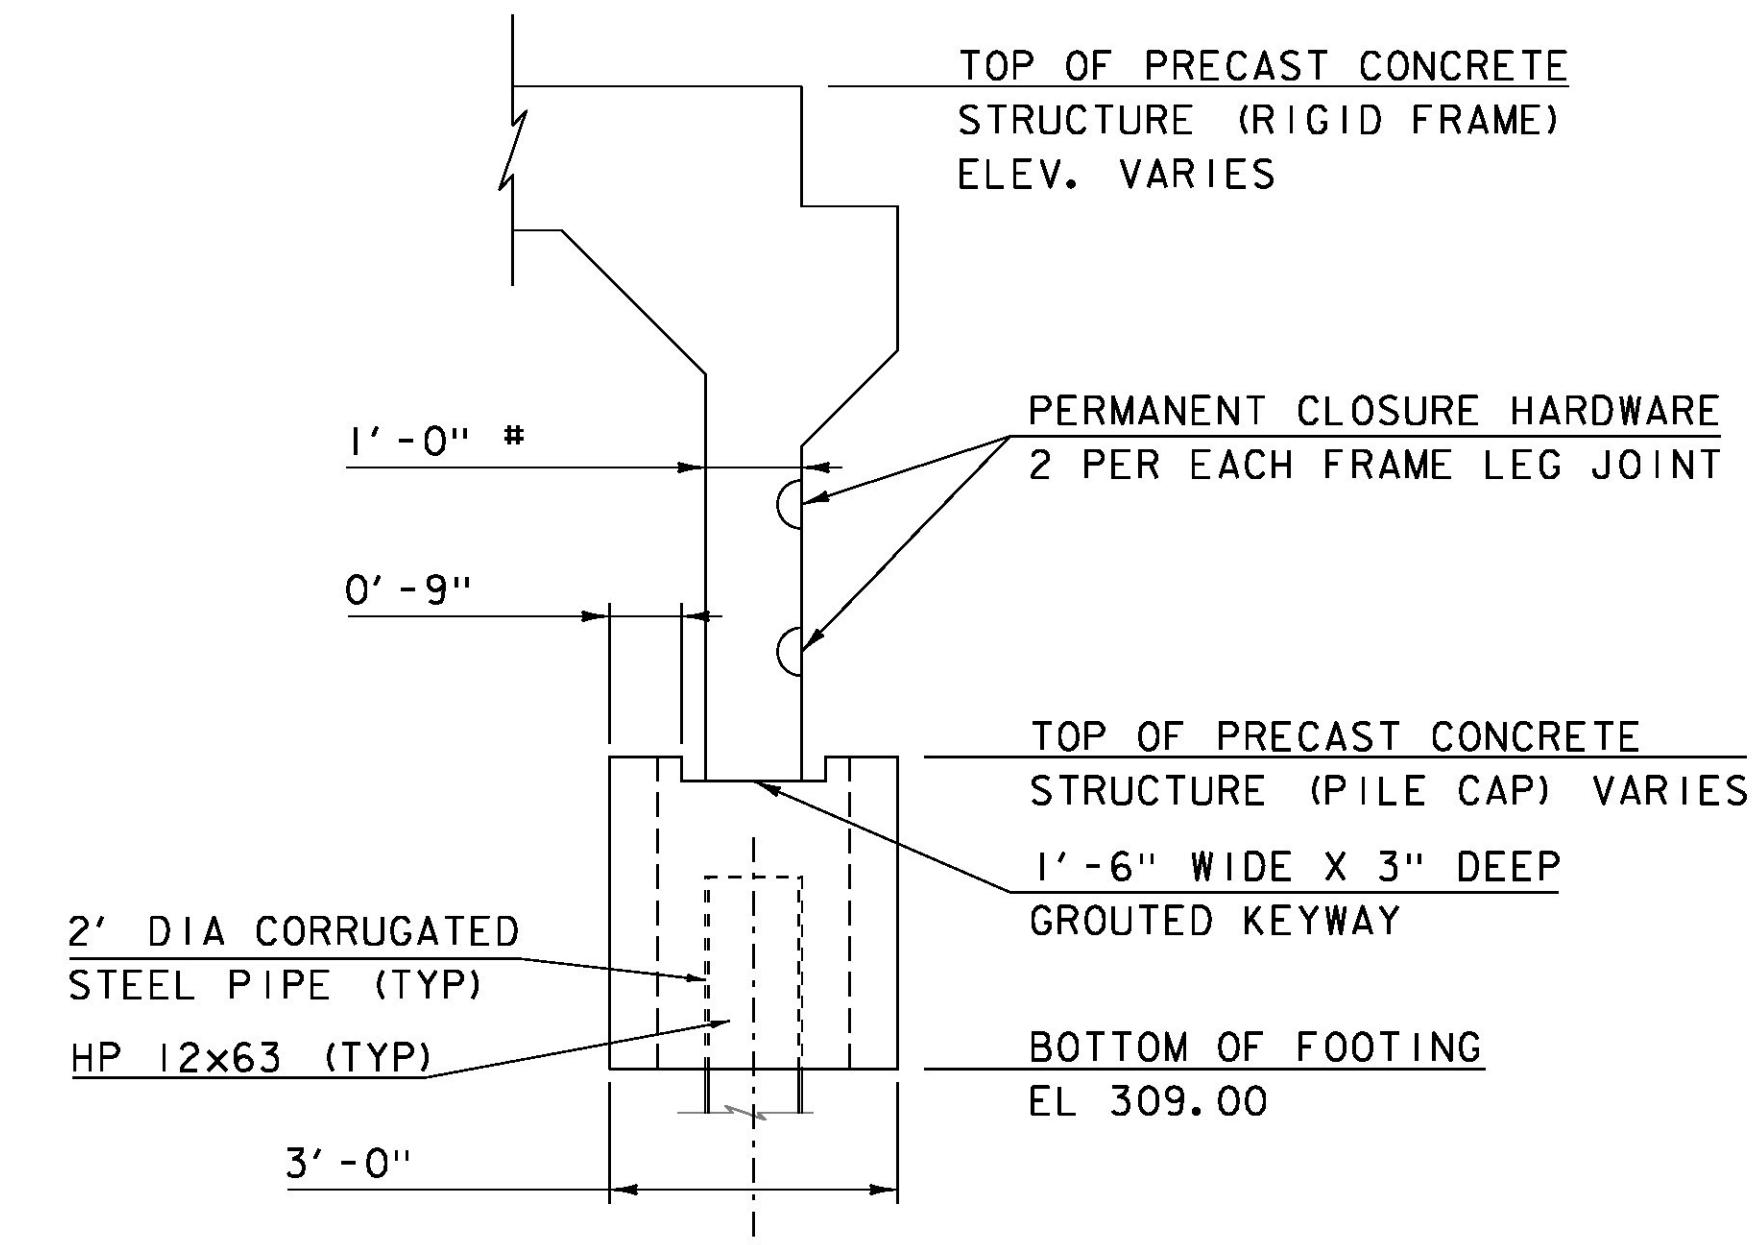

RIGID FRAME SECTION
SCALE 1/2" = 1'-0"

* DIMENSION SHOWN FOR ESTIMATING PURPOSES ONLY.
ACTUAL DIMENSIONS SHALL BE DESIGNED BY
FABRICATOR

PROJECT NAME: RICHMOND	PLOT DATE: 13-SEP-2016
PROJECT NUMBER: BF 0284(28)	DRAWN BY: S. COLEY
FILE NAME: s13c070sub.dgn	CHECKED BY: W. LAMMER
PROJECT LEADER: R. YOUNG	SHEET 29 OF 54
DESIGNED BY: S. COLEY	
RIGID FRAME ELEVATION	