


TH 12 MATERIAL TRANSITION DETAIL

HORIZONTAL SCALE: 1" = 20'-0"
 VERTICAL SCALE: 1" = 2'-0"

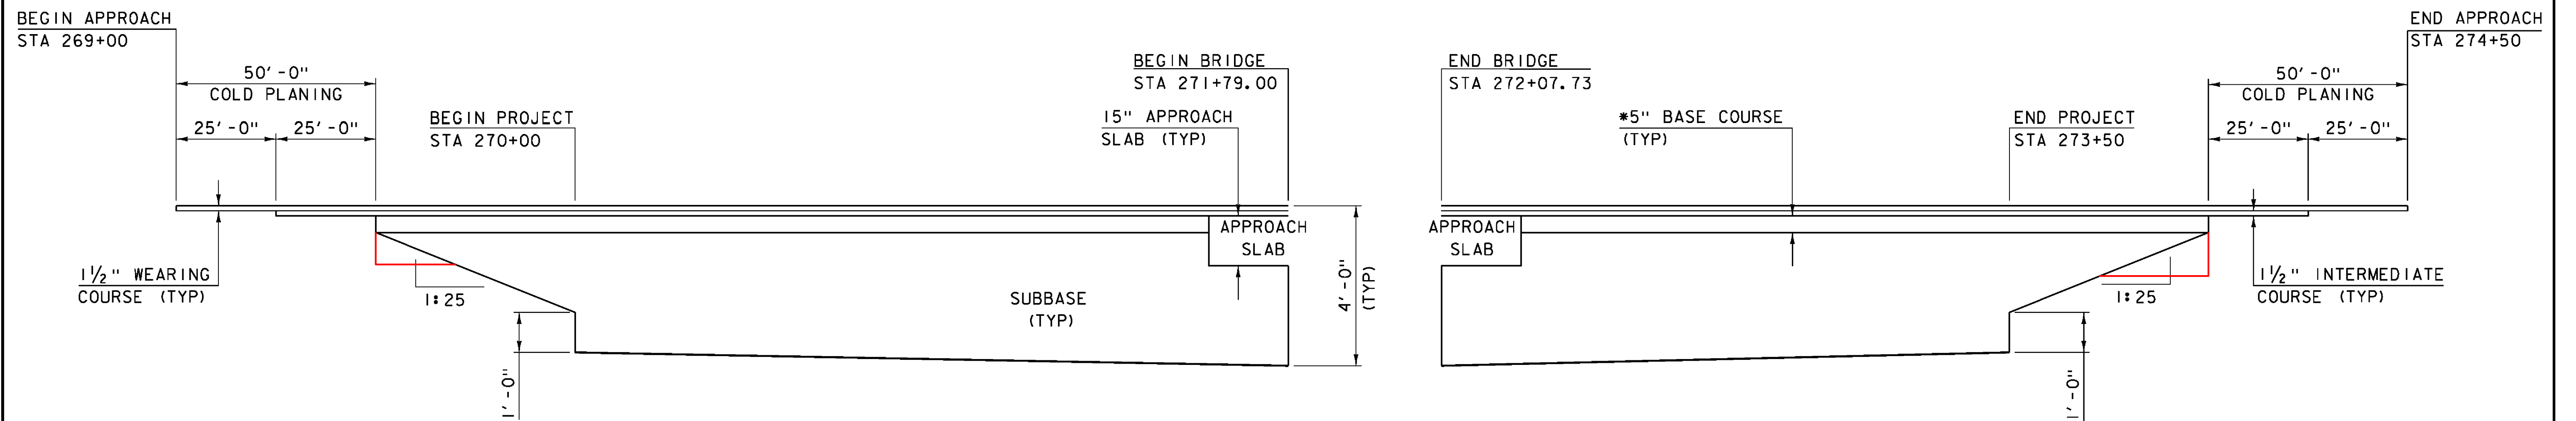

US 2 MATERIAL TRANSITION DETAIL

HORIZONTAL SCALE: 1" = 20'-0"
 VERTICAL SCALE: 1" = 2'-0"

NOTE:
 * TWO 2.5 INCH LIFTS OF TYPE IIS BASE

PROJECT NAME: RICHMOND	
PROJECT NUMBER: BF 0284 (28)	
FILE NAME: s13c070transition	PLOT DATE: 13-SEP-2016
PROJECT LEADER: R. YOUNG	DRAWN BY: S. COLEY
DESIGNED BY: S. COLEY	CHECKED BY: W. LAMMER
MATERIAL TRANSITION DETAIL	SHEET 35 OF 54