




270+25

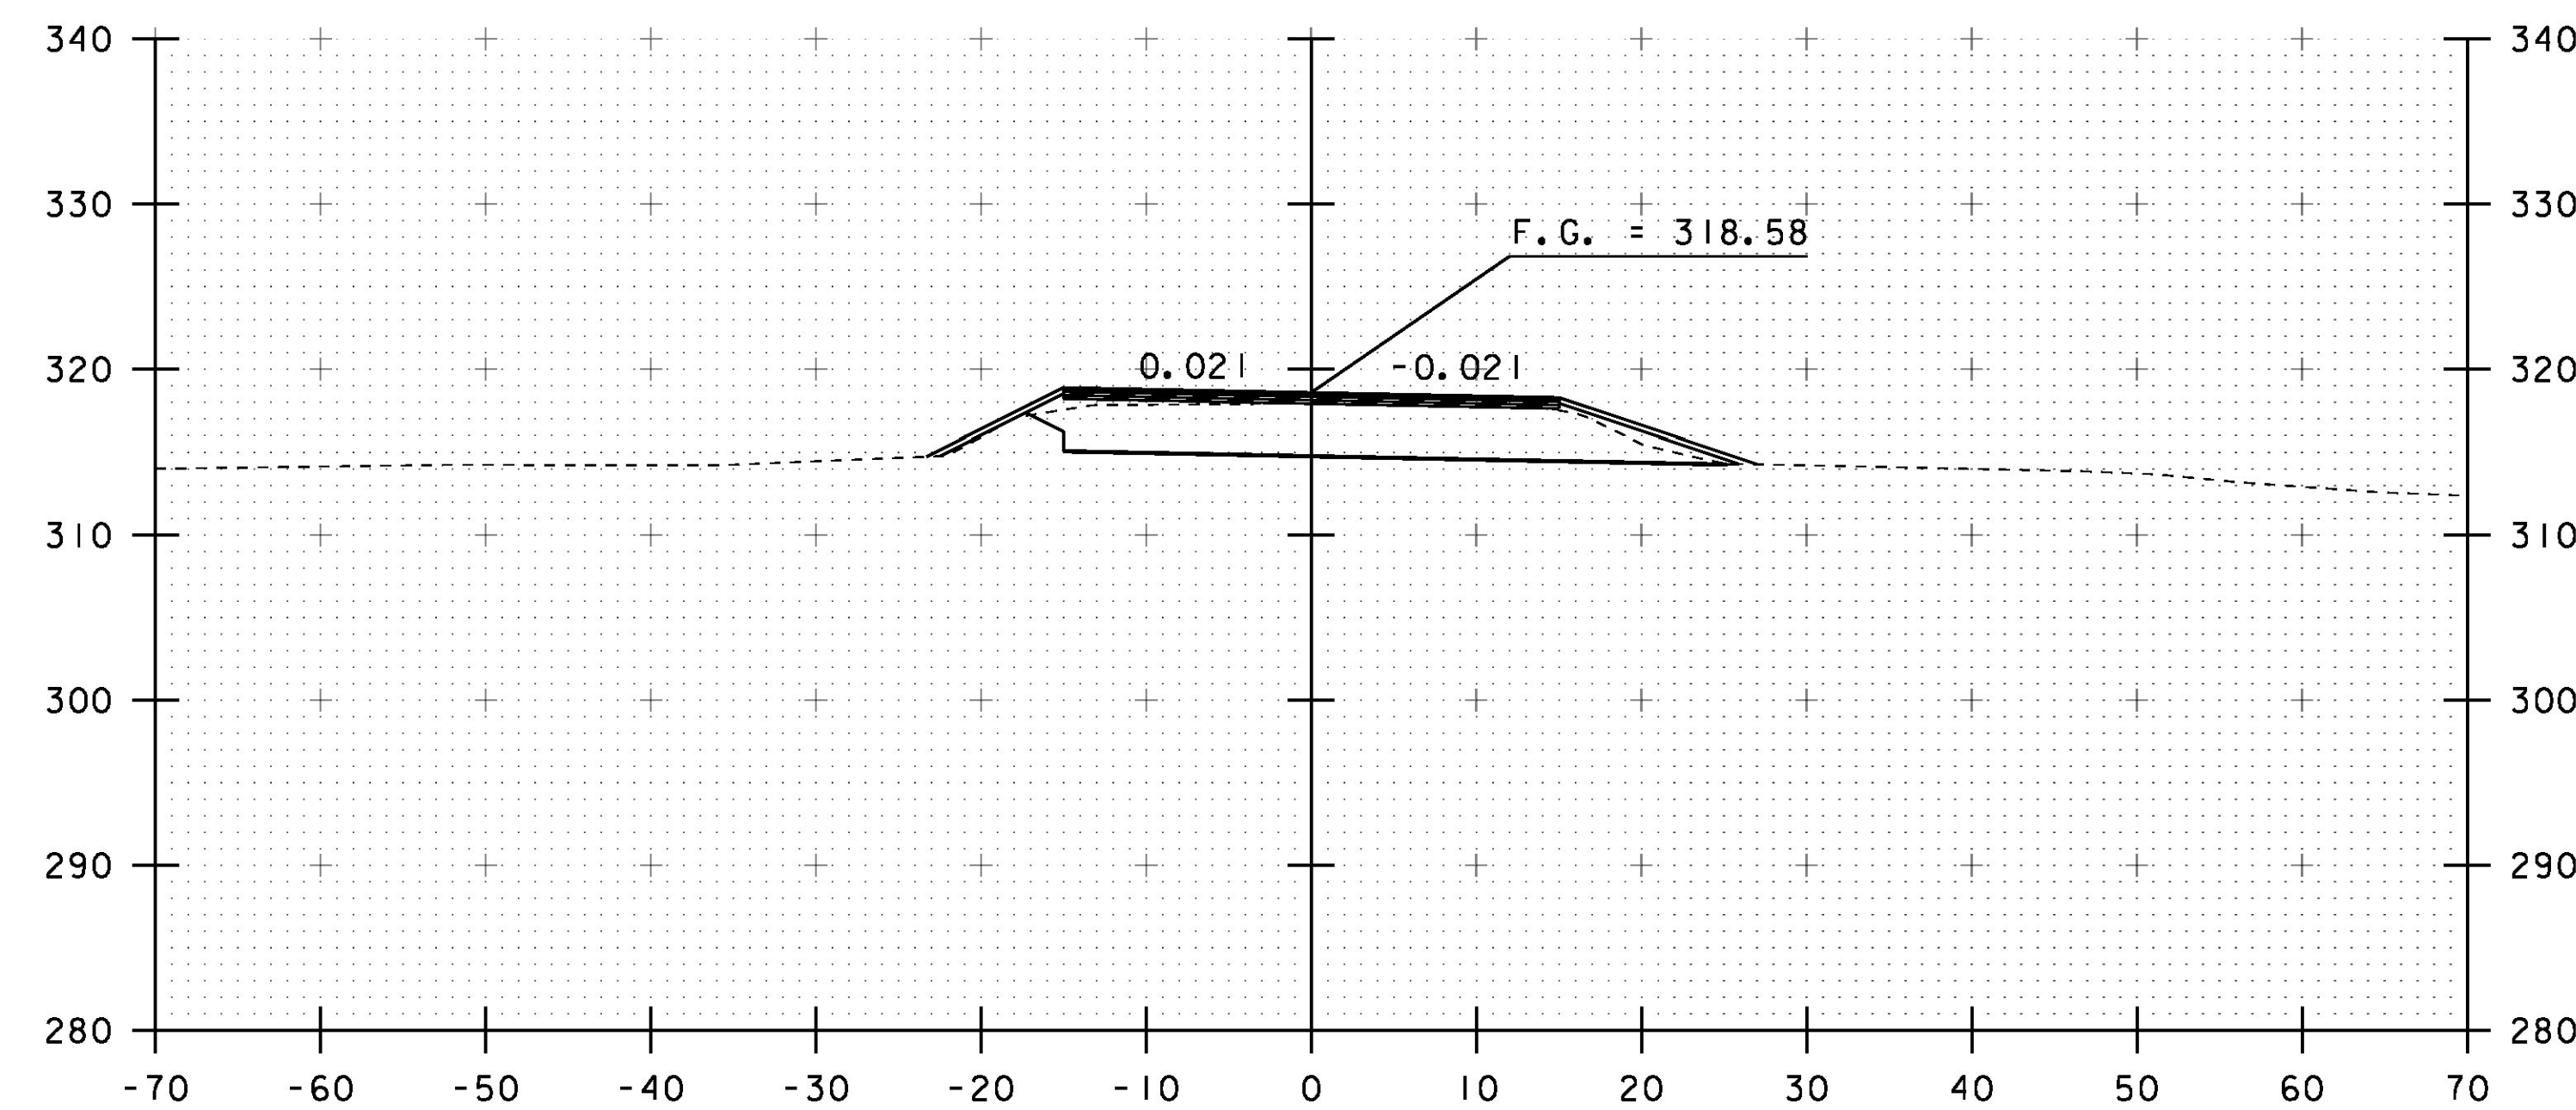

270+75

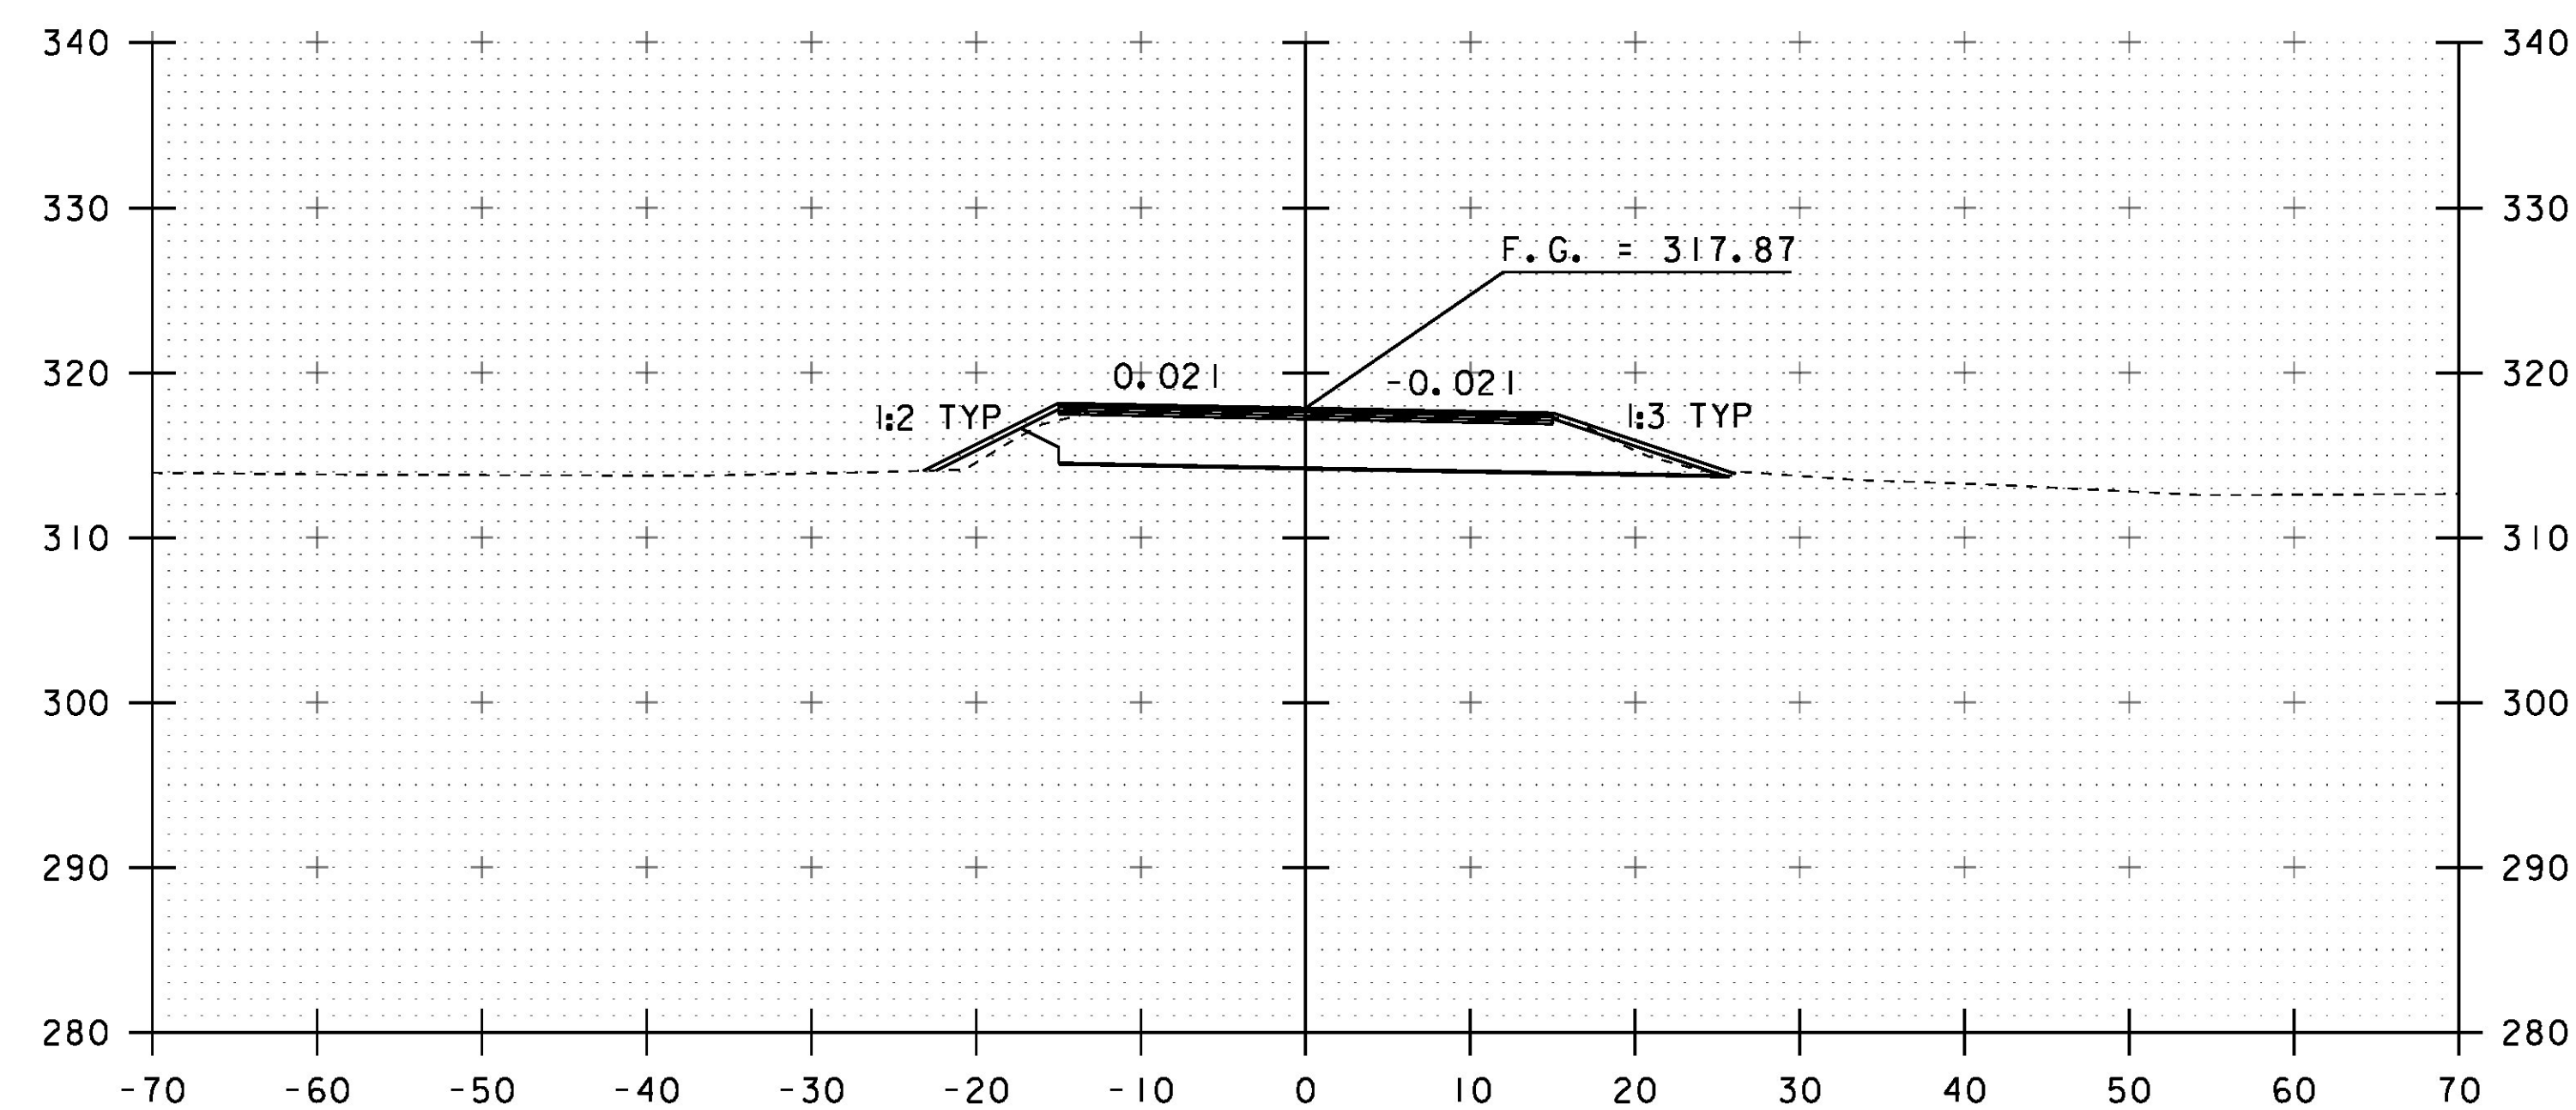

270+00
BEGIN PROJECT

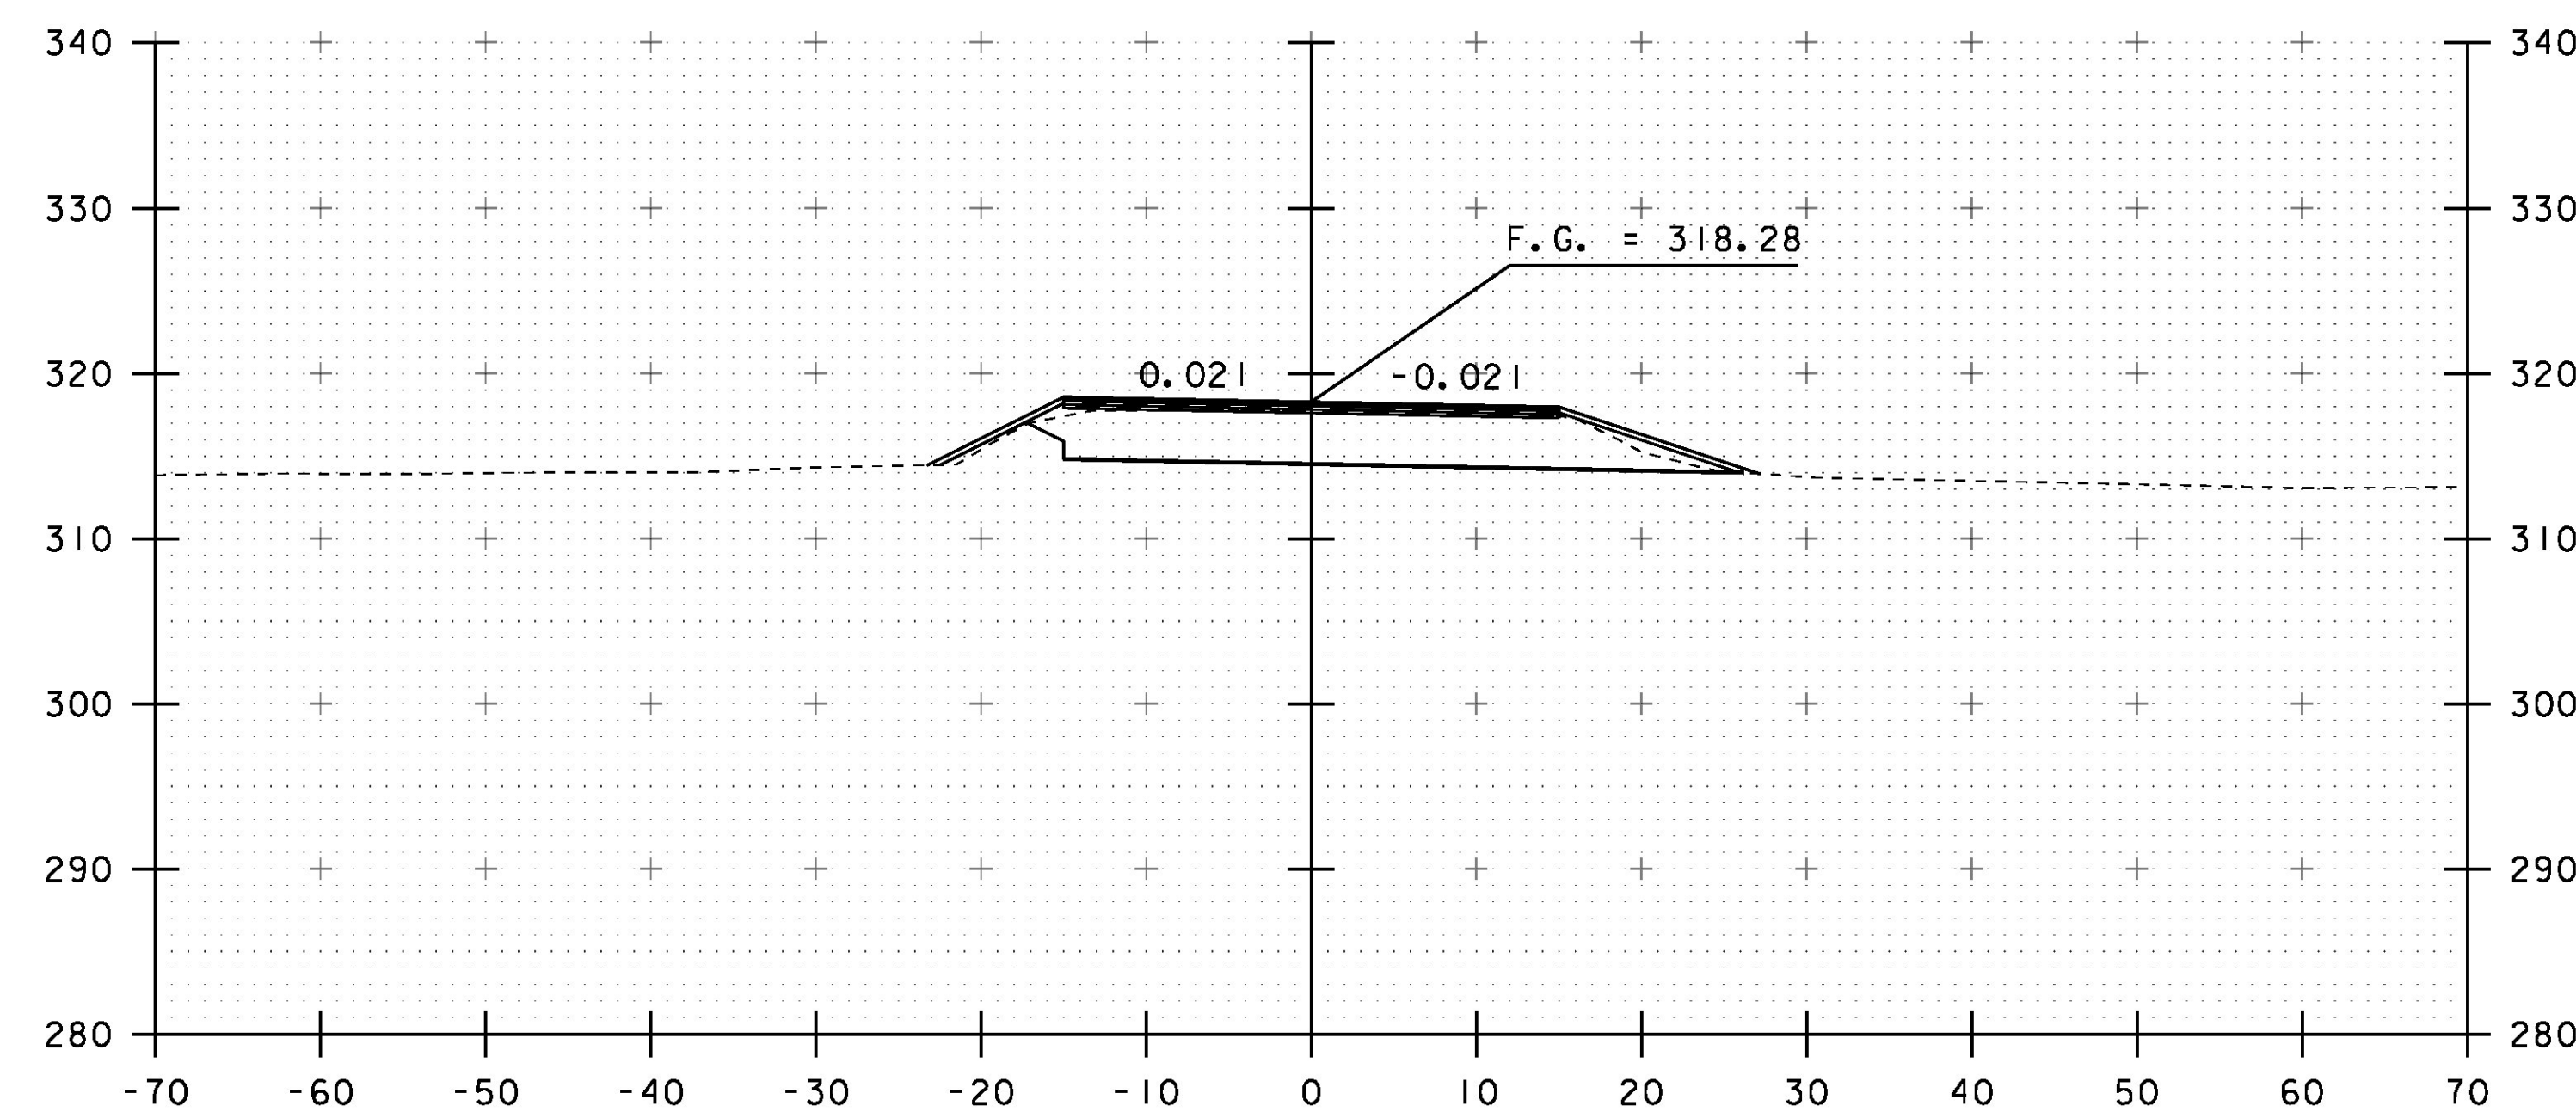

270+50

STA. 270+00 TO STA. 270+75

PROJECT NAME: RICHMOND	PLOT DATE: 13-SEP-2016
PROJECT NUMBER: BF 0284(28)	DRAWN BY: S. COLEY
FILE NAME: s13c070xs.dgn	DESIGNED BY: S. COLEY
PROJECT LEADER: R. YOUNG	CHECKED BY: W. LAMMER
ROADWAY CROSS SECTIONS 2	SHEET 37 OF 54