




271+25

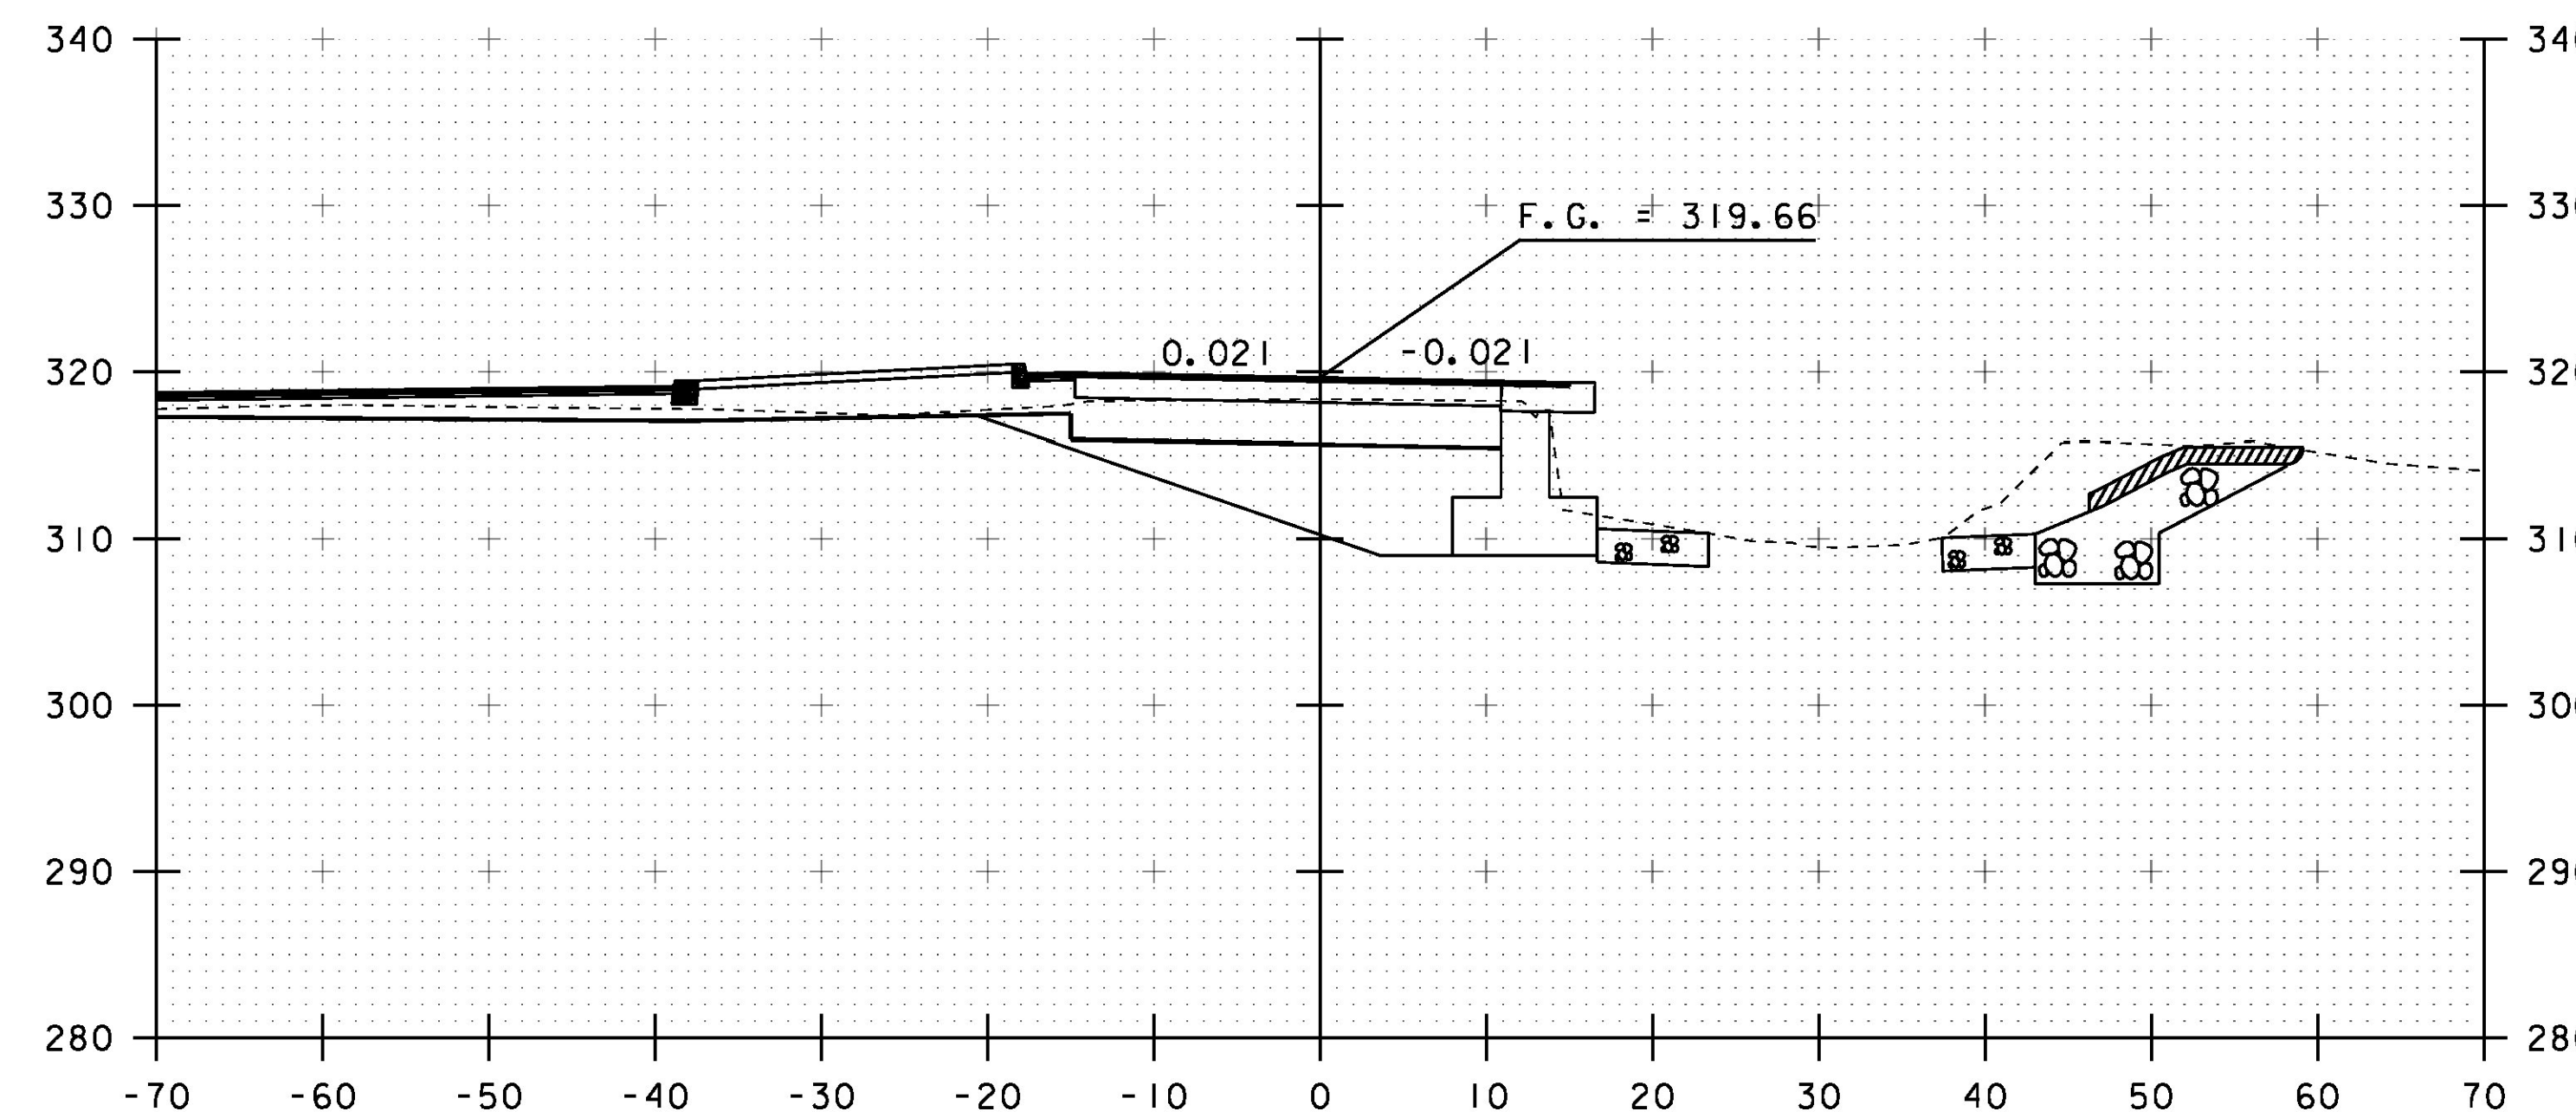

271+75
STA 271+79.00
BEGIN BRIDGE

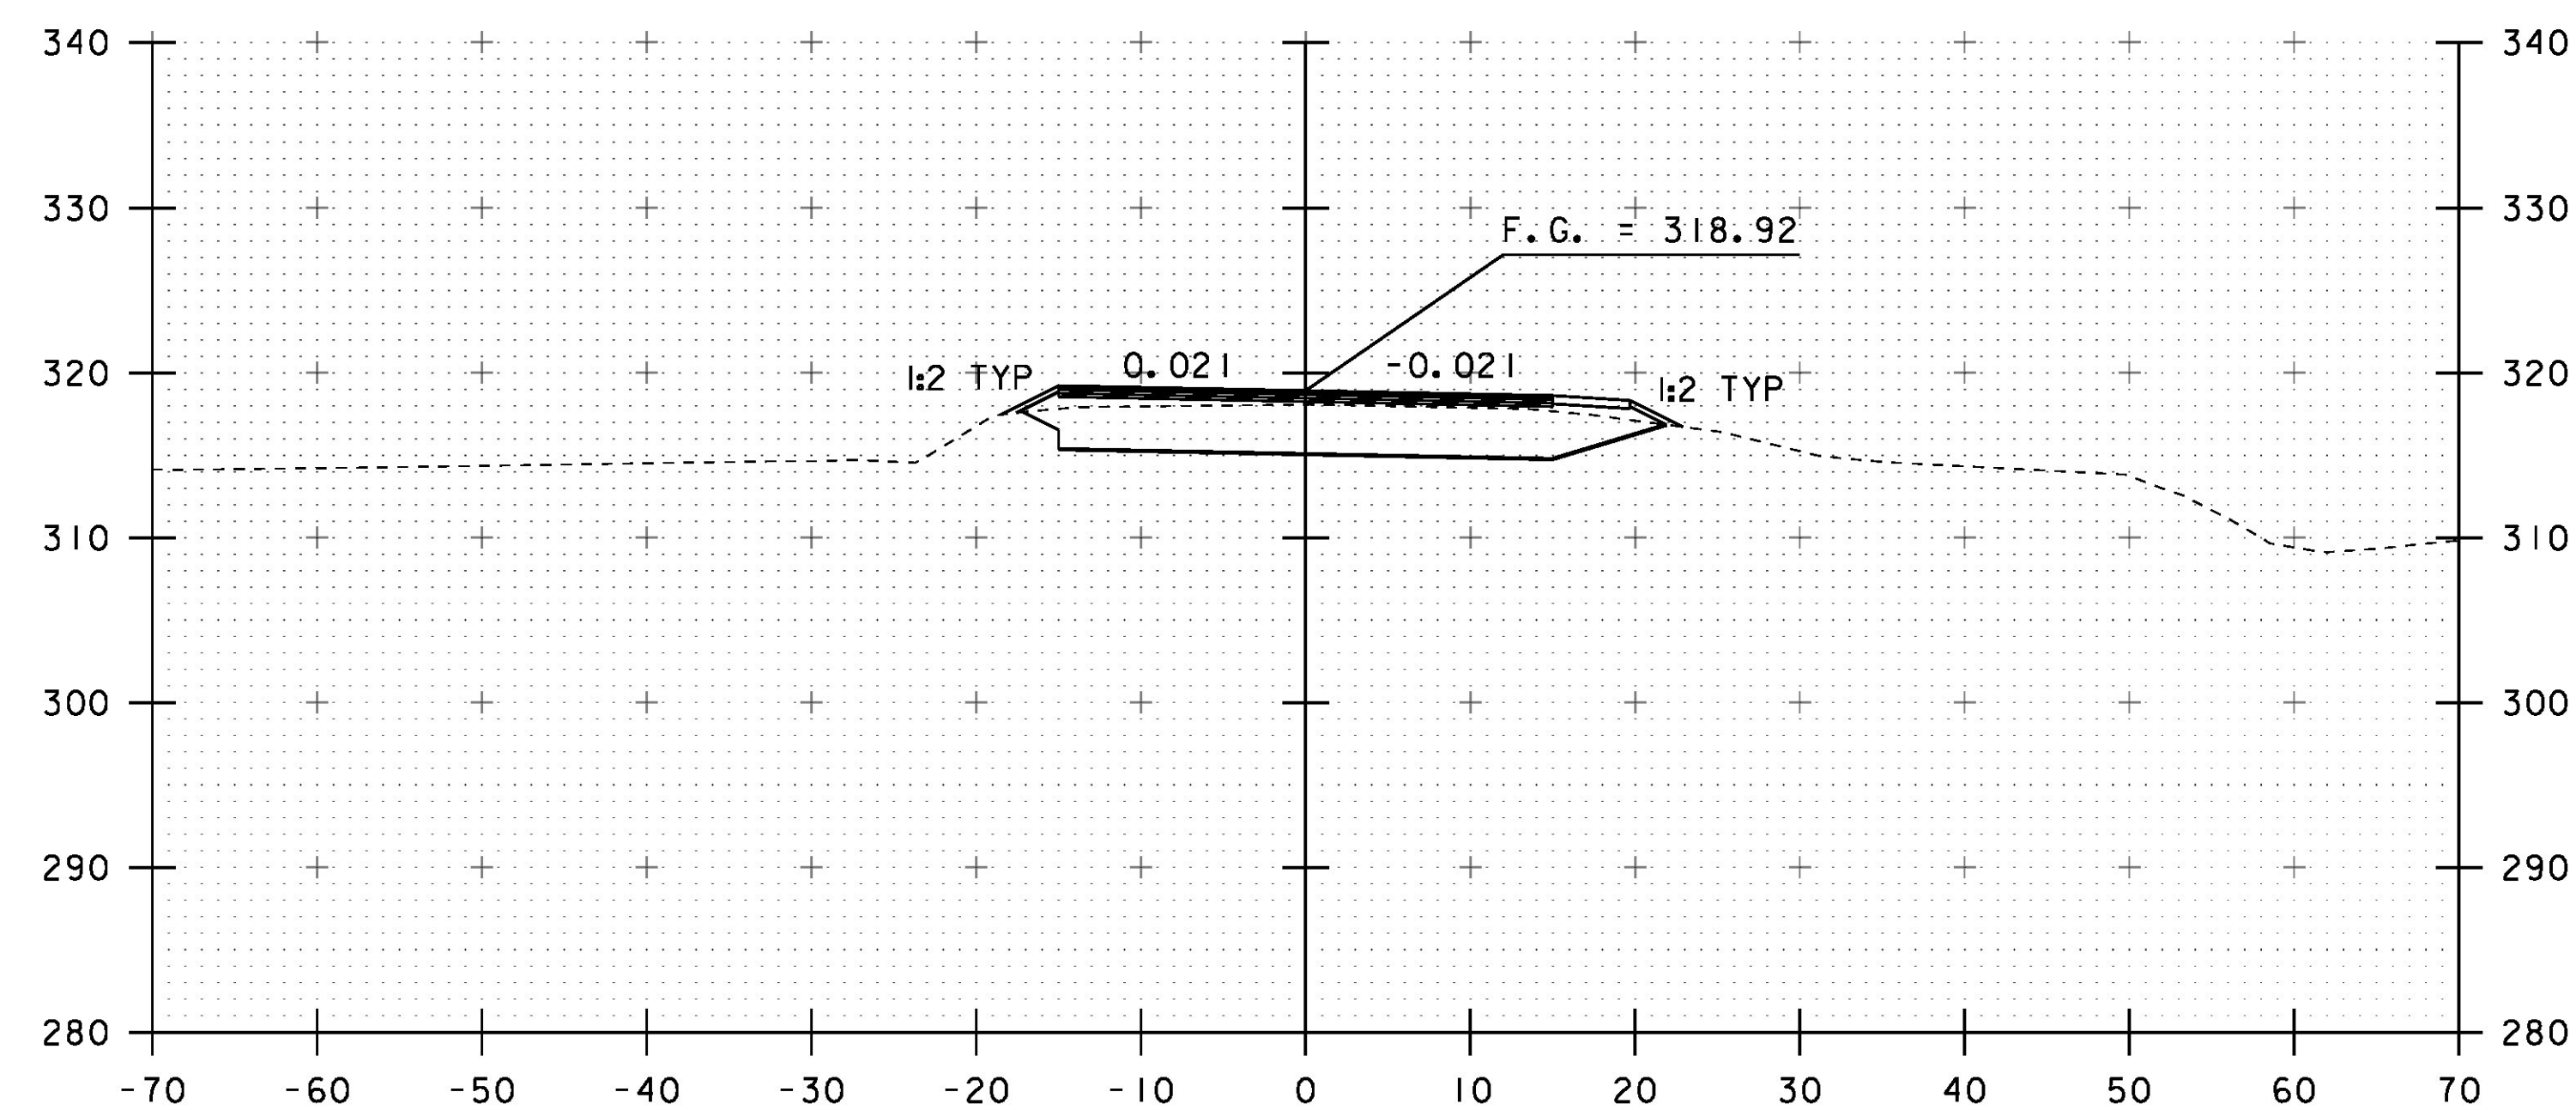

271+00

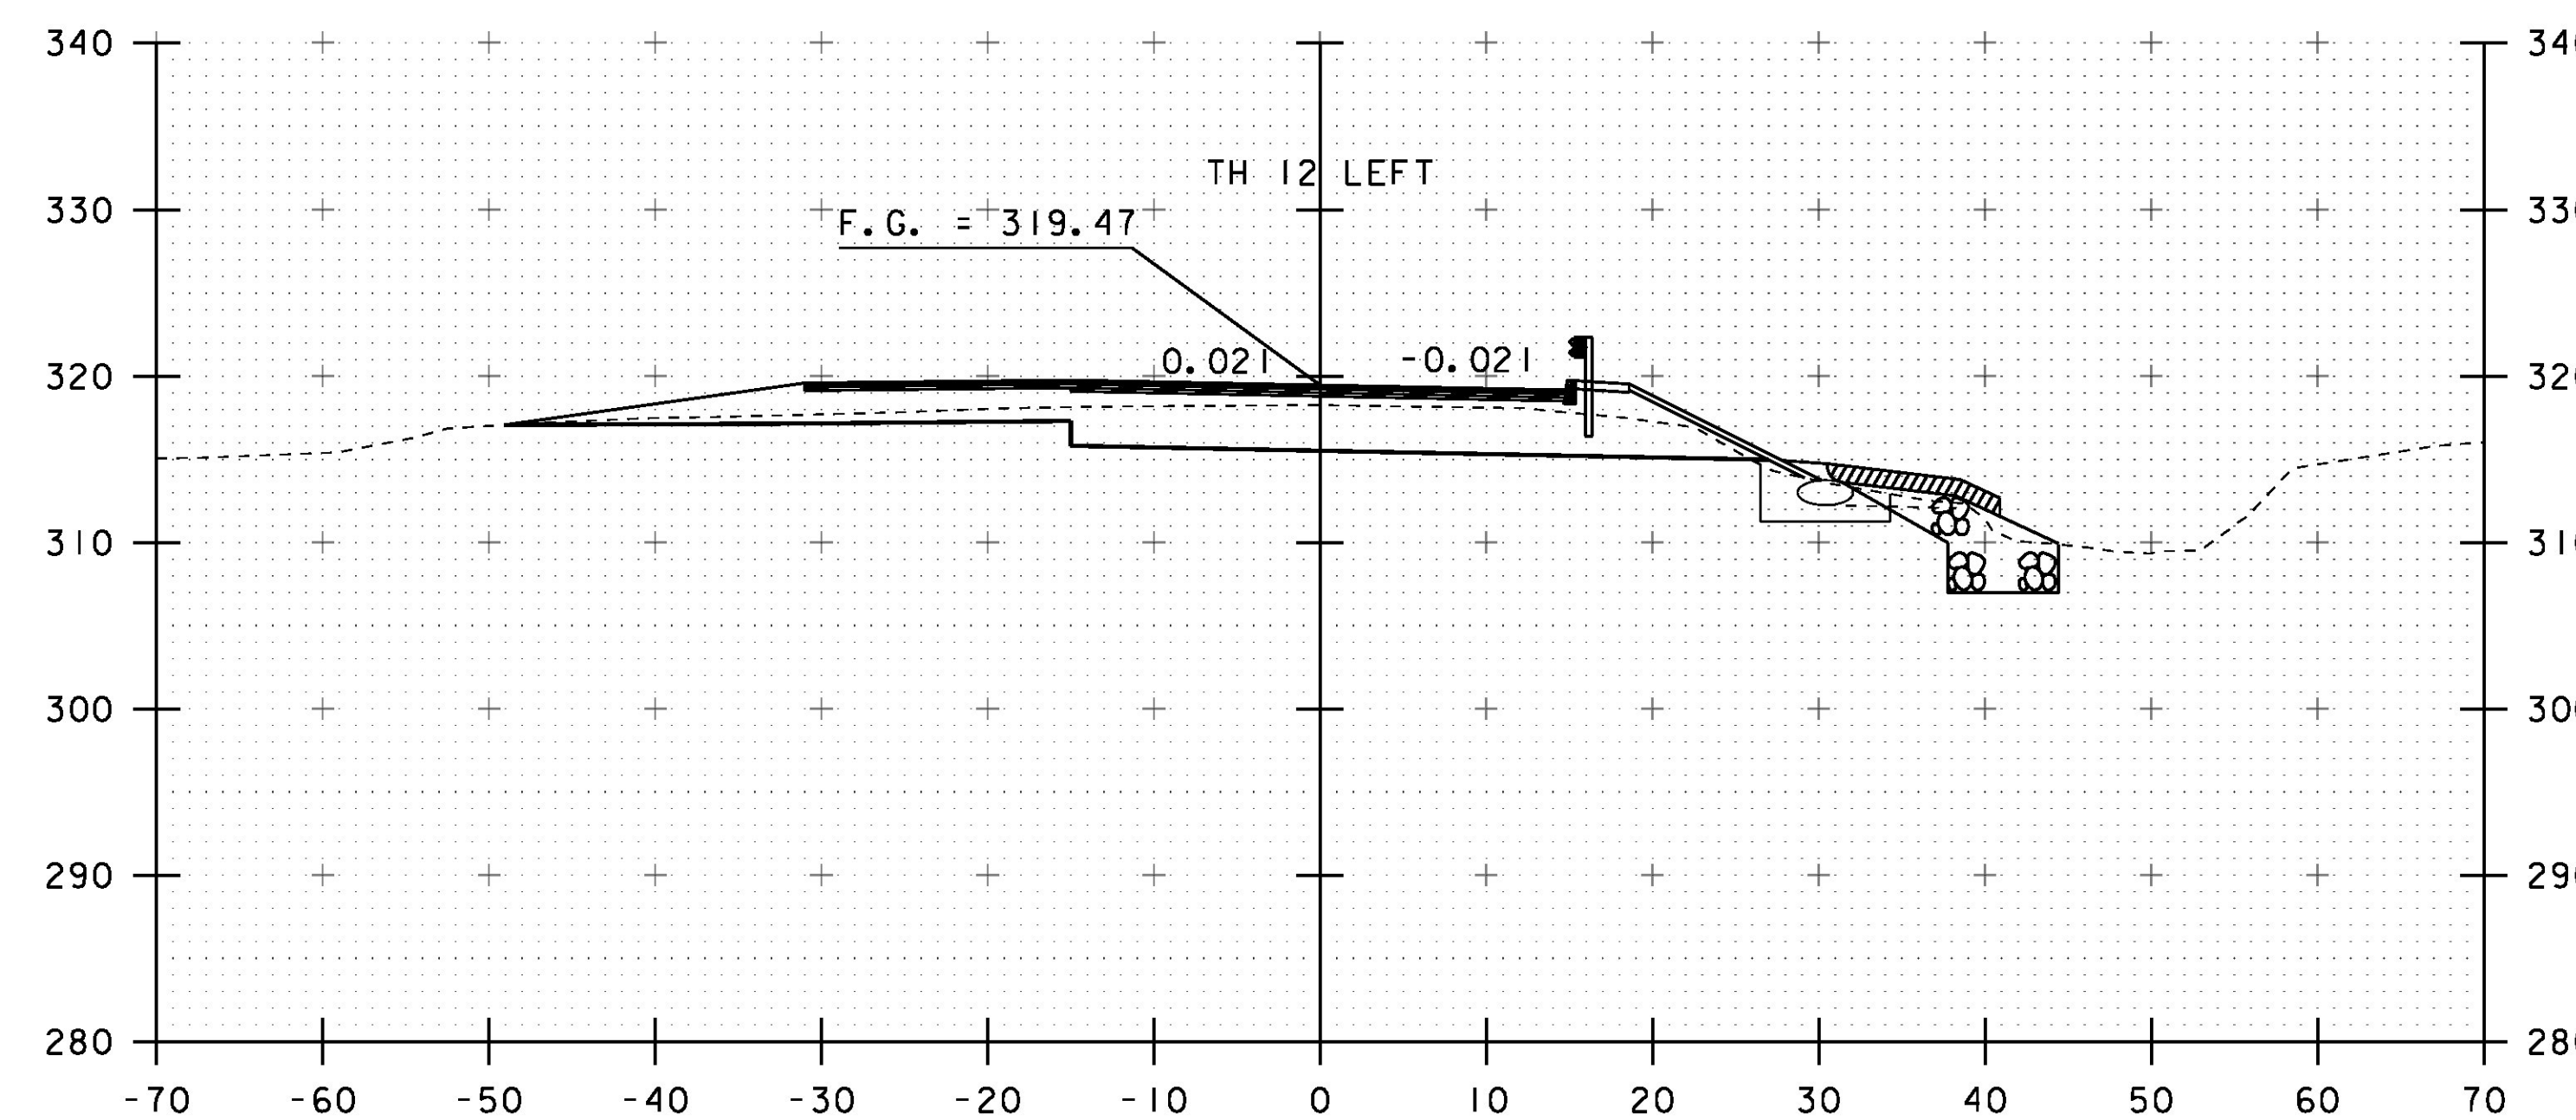

271+50

PROJECT NAME:	RICHMOND
PROJECT NUMBER:	BF 0284(28)
FILE NAME:	sl3c070xs.dgn
PROJECT LEADER:	R. YOUNG
DESIGNED BY:	S. COLEY
ROADWAY CROSS SECTIONS 3	
PLOT DATE:	13-SEP-2016
DRAWN BY:	S. COLEY
CHECKED BY:	W. LAMMER
SHEET	38 OF 54

STA. 271+00 TO STA. 271+75