



272+25

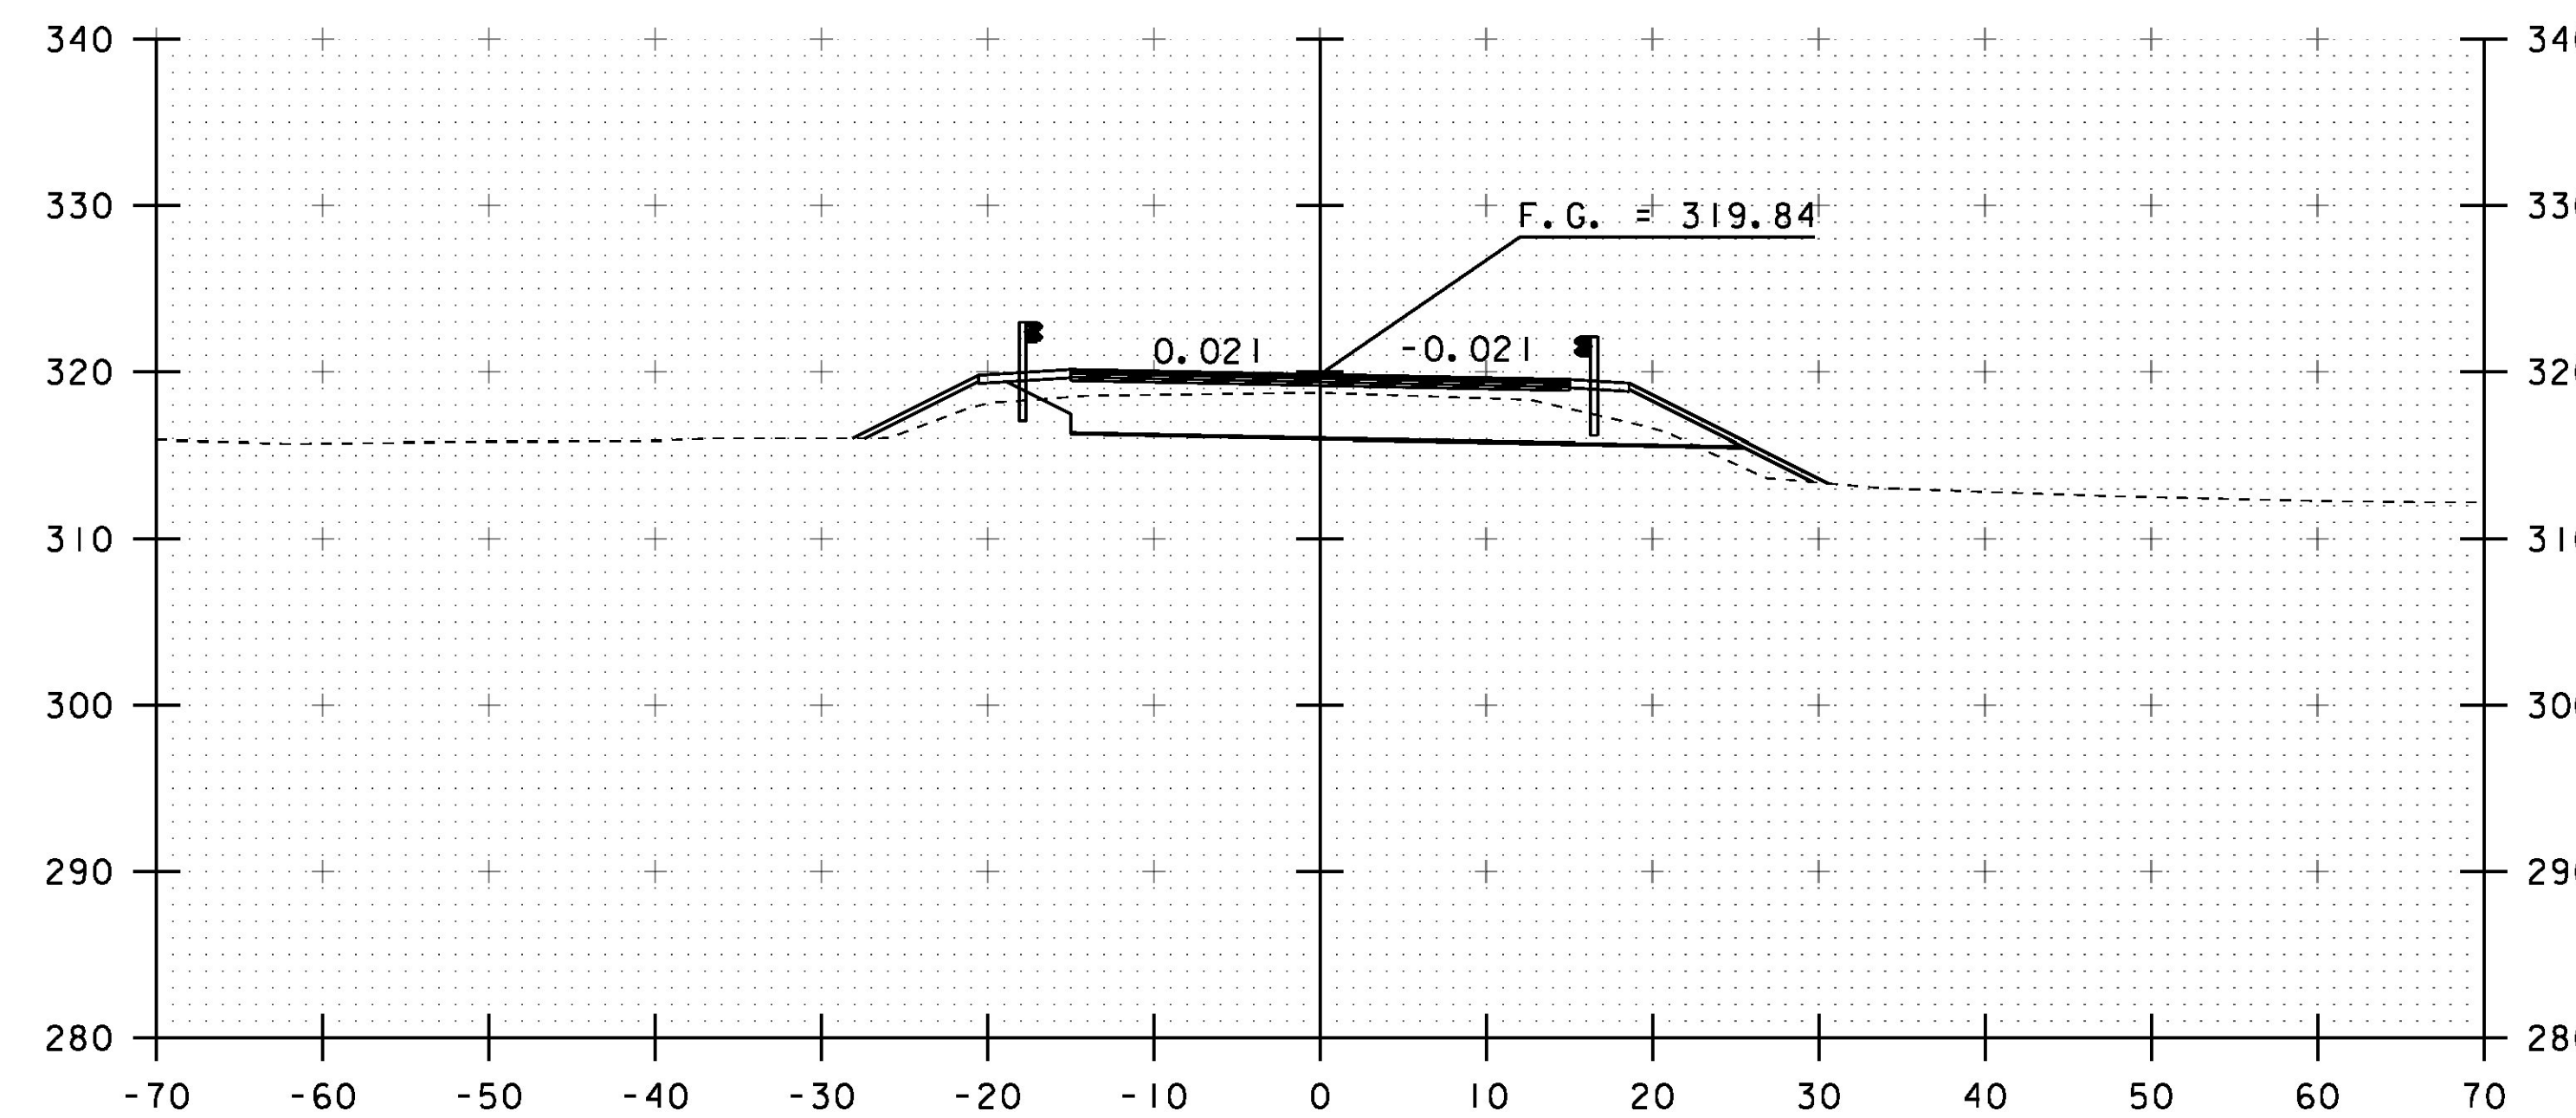


272+75

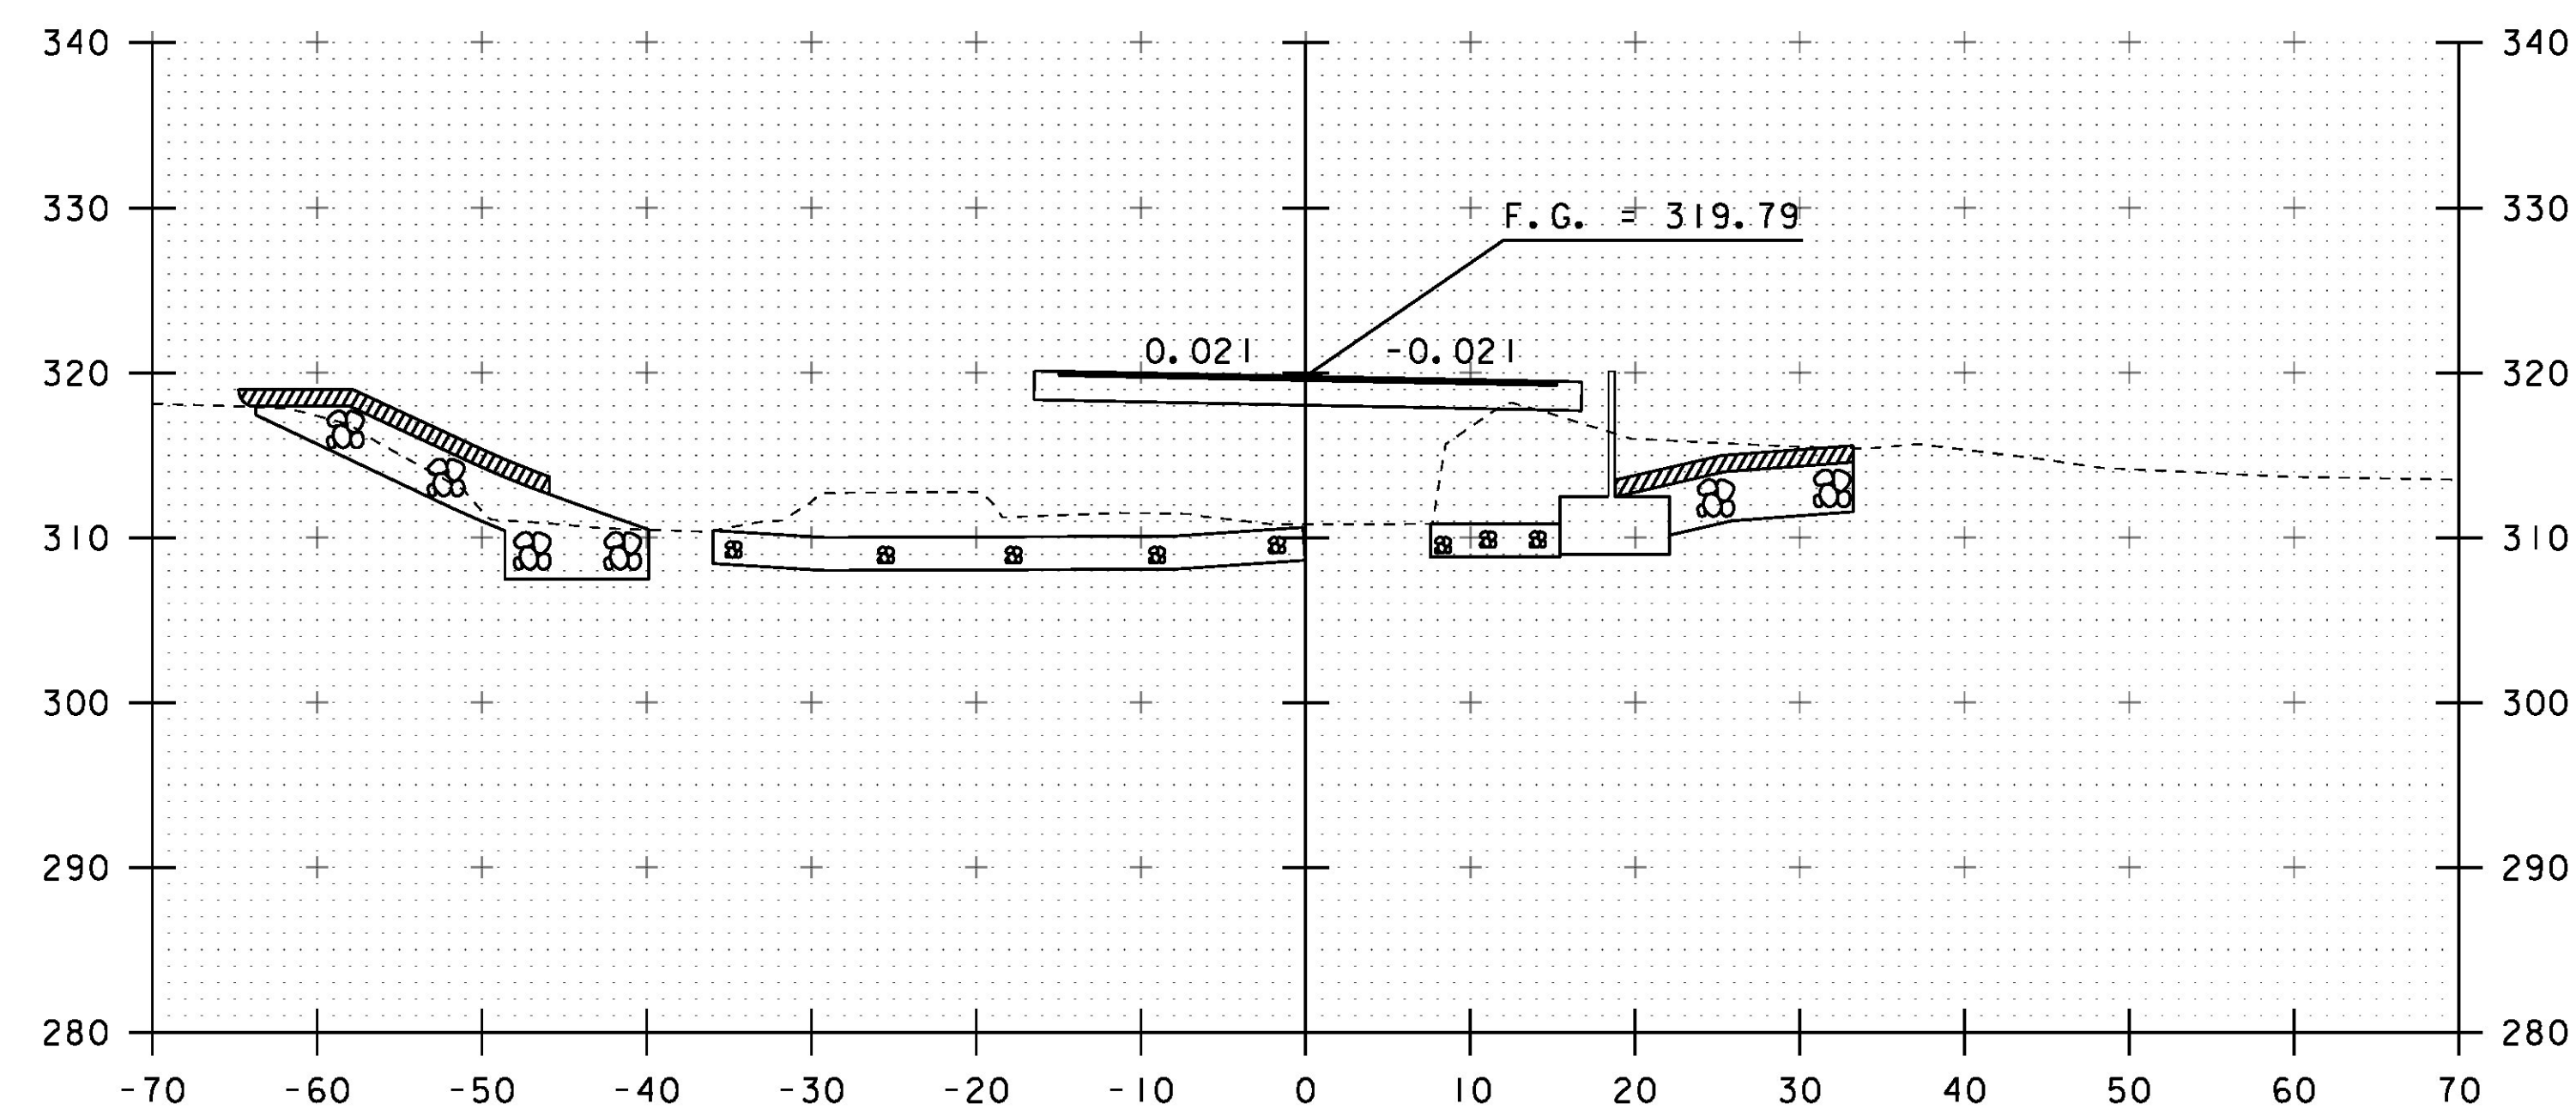

272+00

STA 272+07.73
END BRIDGE

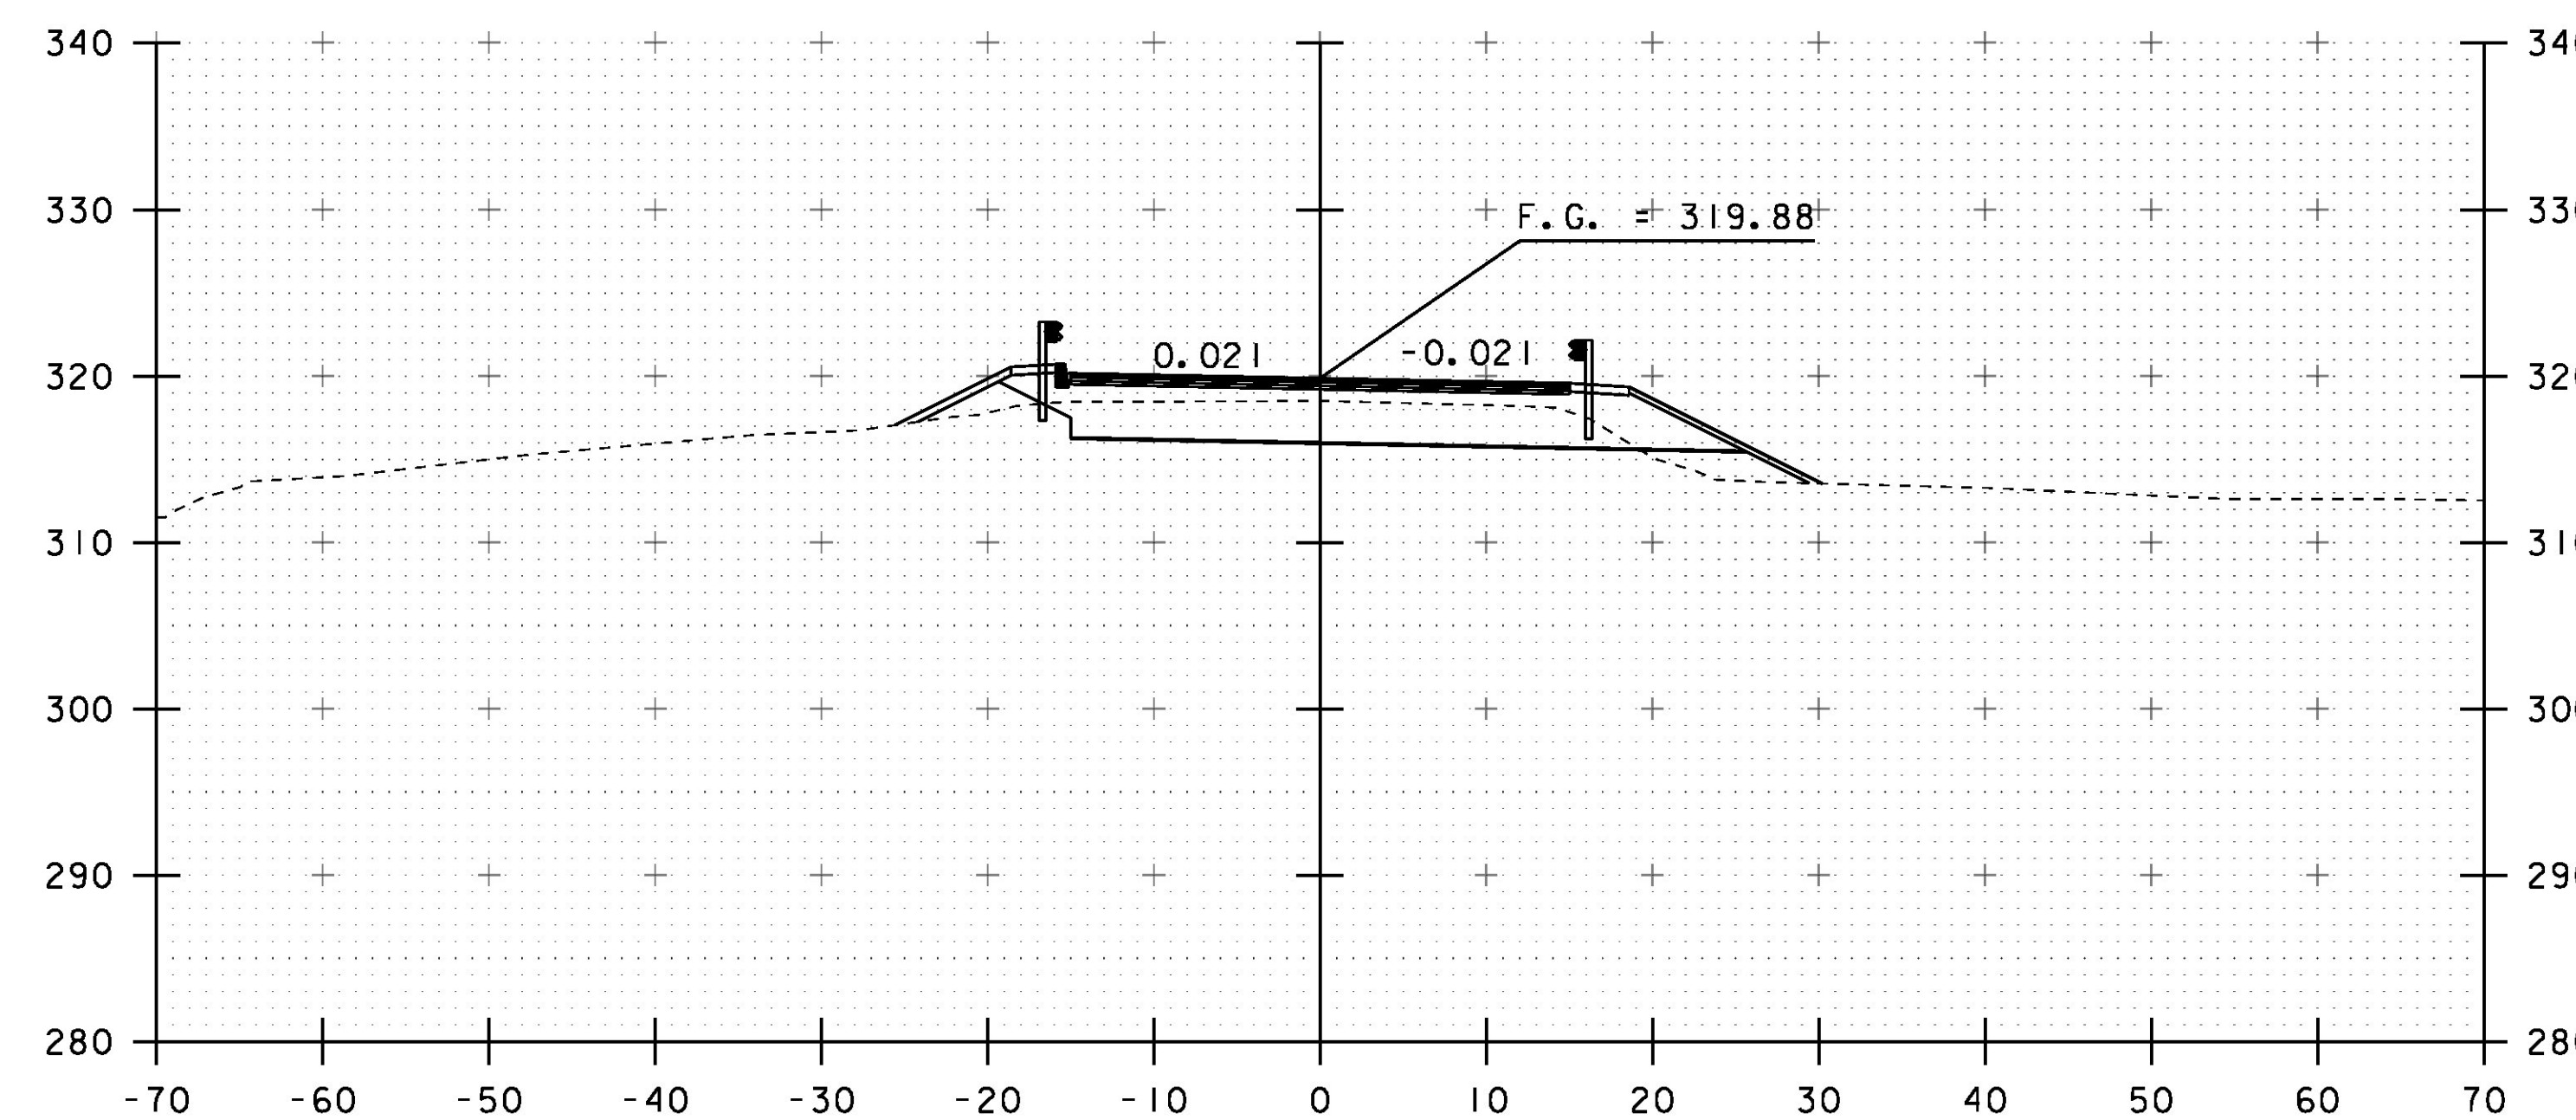

272+50

STA. 272+00 TO STA. 272+75

PROJECT NAME:	RICHMOND	PLOT DATE:	13-SEP-2016
PROJECT NUMBER:	BF 0284(28)	DRAWN BY:	S. COLEY
FILE NAME:	sl3c070xs.dgn	DESIGNED BY:	S. COLEY
PROJECT LEADER:	R. YOUNG	CHECKED BY:	W. LAMMER
ROADWAY CROSS SECTIONS 4		SHEET	39 OF 54