




273+25

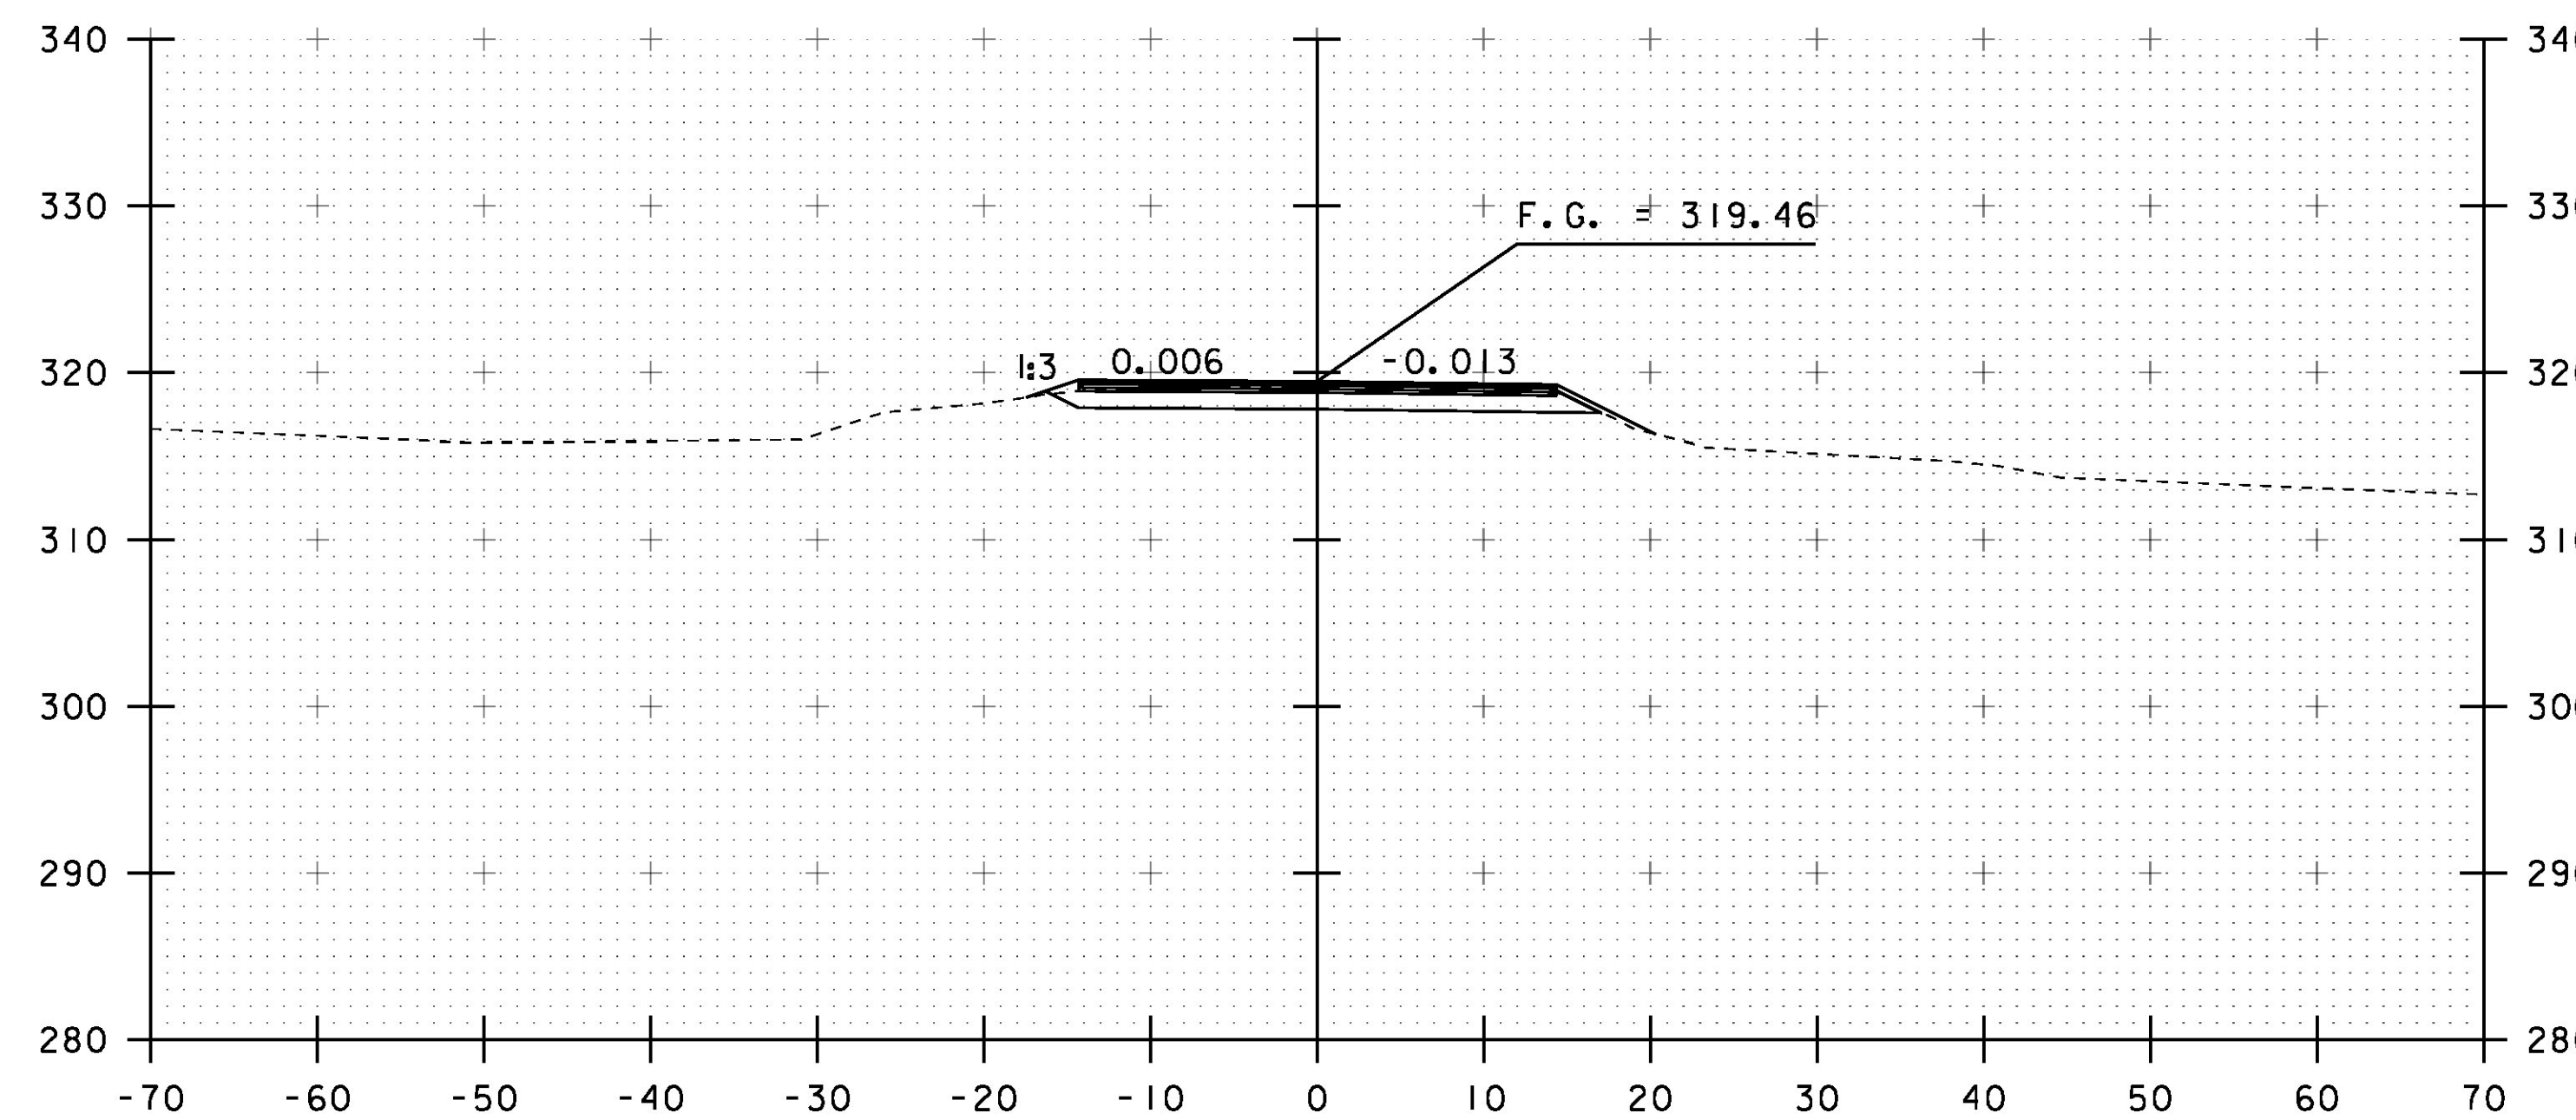

273+75

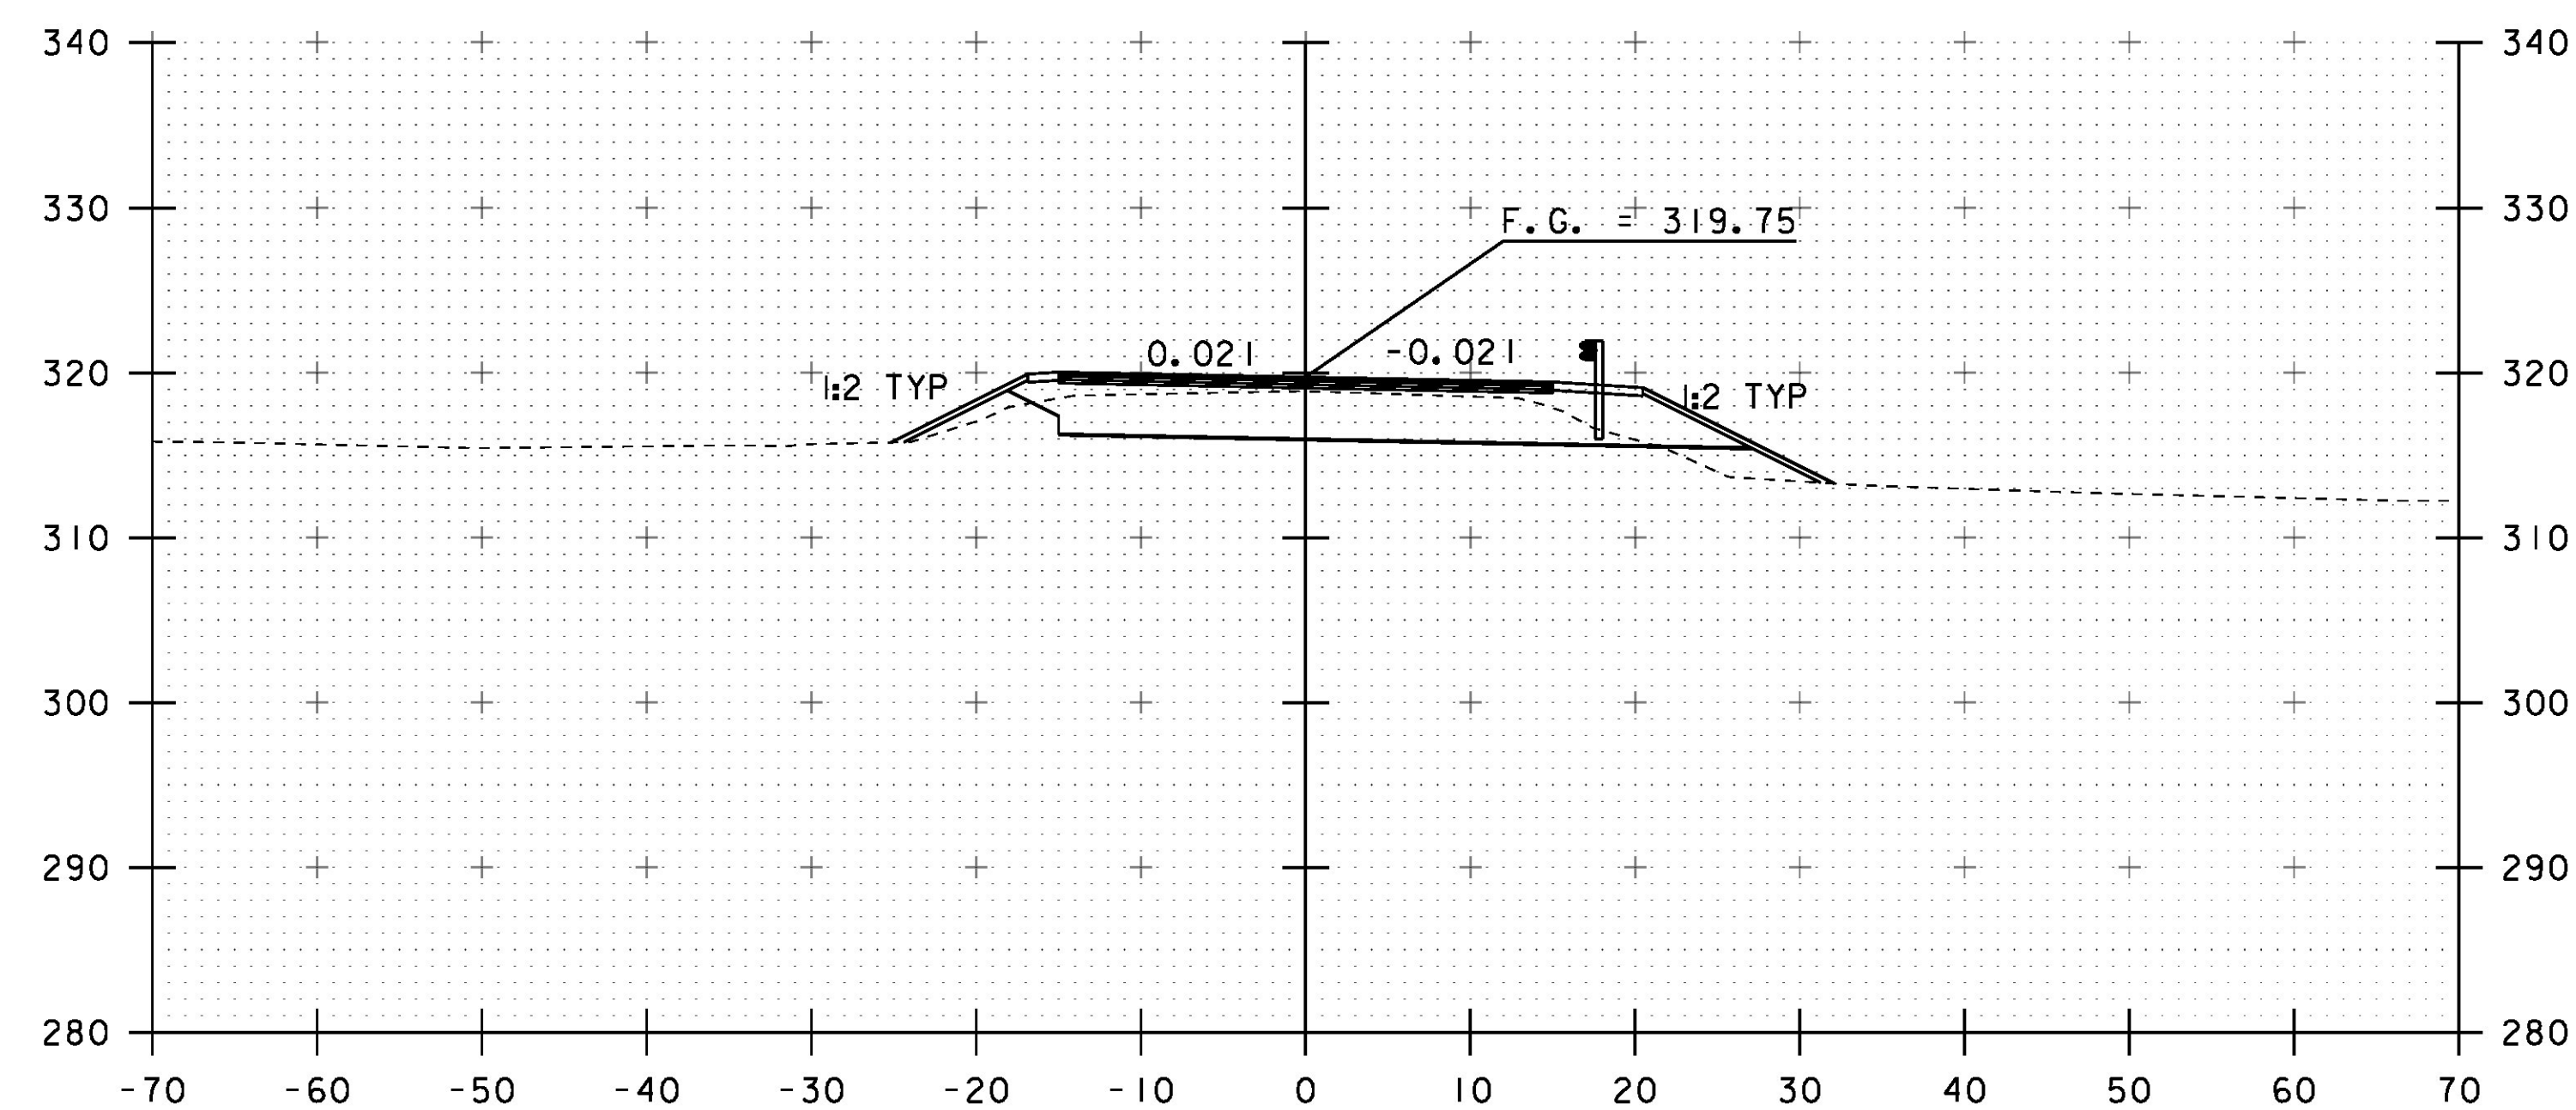

273+00

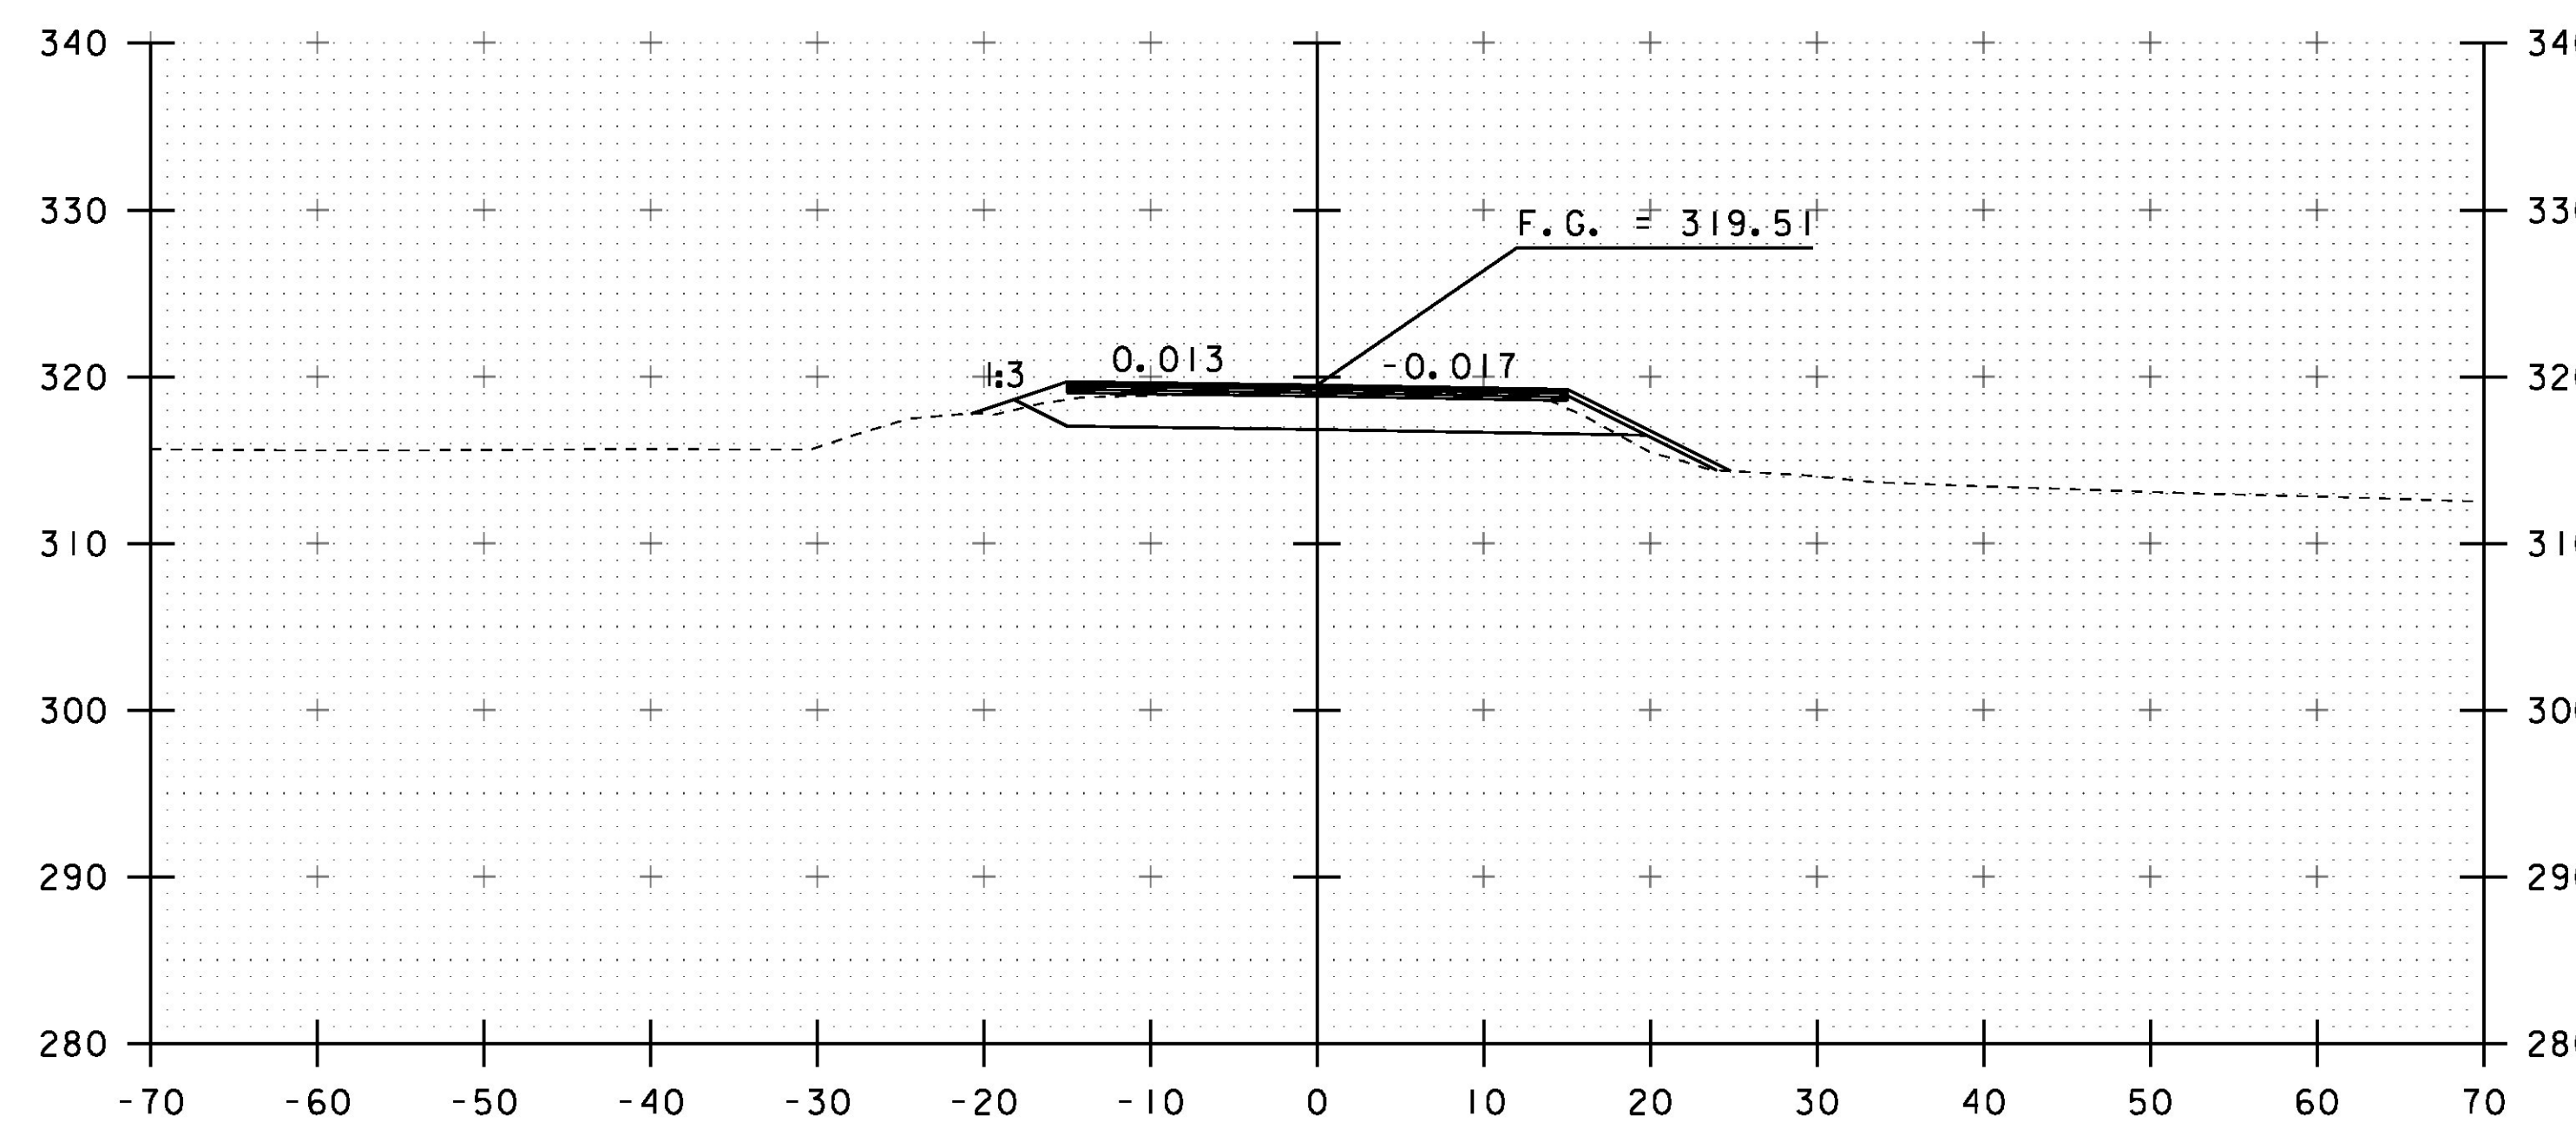

273+50

END PROJECT

STA. 273+00 TO STA. 273+75

PROJECT NAME:	RICHMOND	PLOT DATE:	13-SEP-2016
PROJECT NUMBER:	BF 0284(28)	DRAWN BY:	S. COLEY
FILE NAME:	sl3c070xs.dgn	DESIGNED BY:	S. COLEY
PROJECT LEADER:	R. YOUNG	CHECKED BY:	W. LAMMER
ROADWAY CROSS SECTIONS 5		SHEET	40 OF 54