



274+25

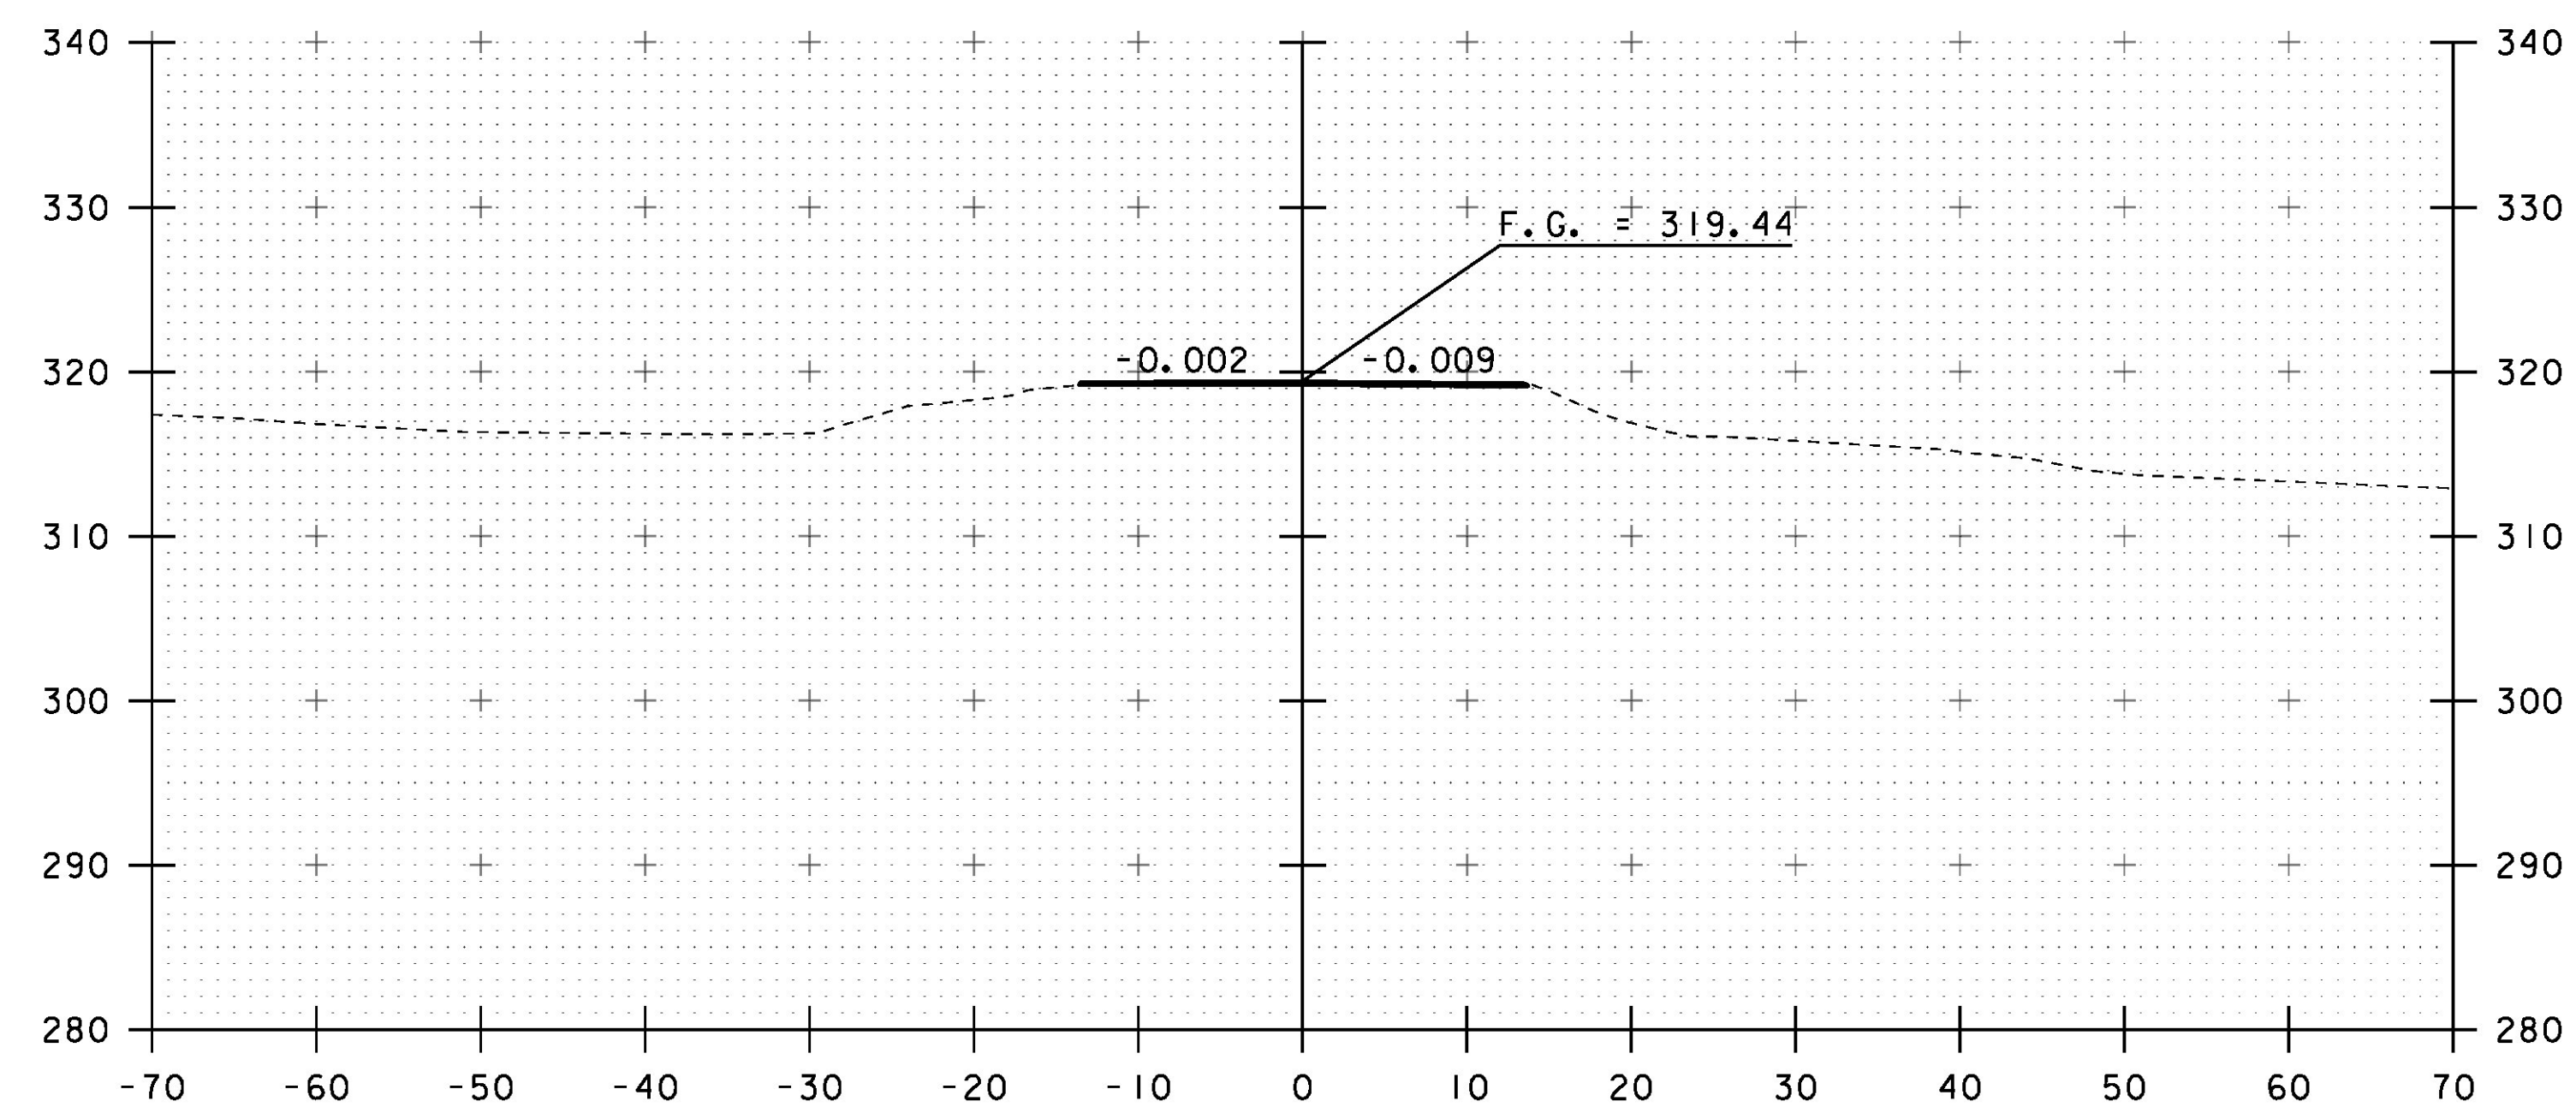

274+00

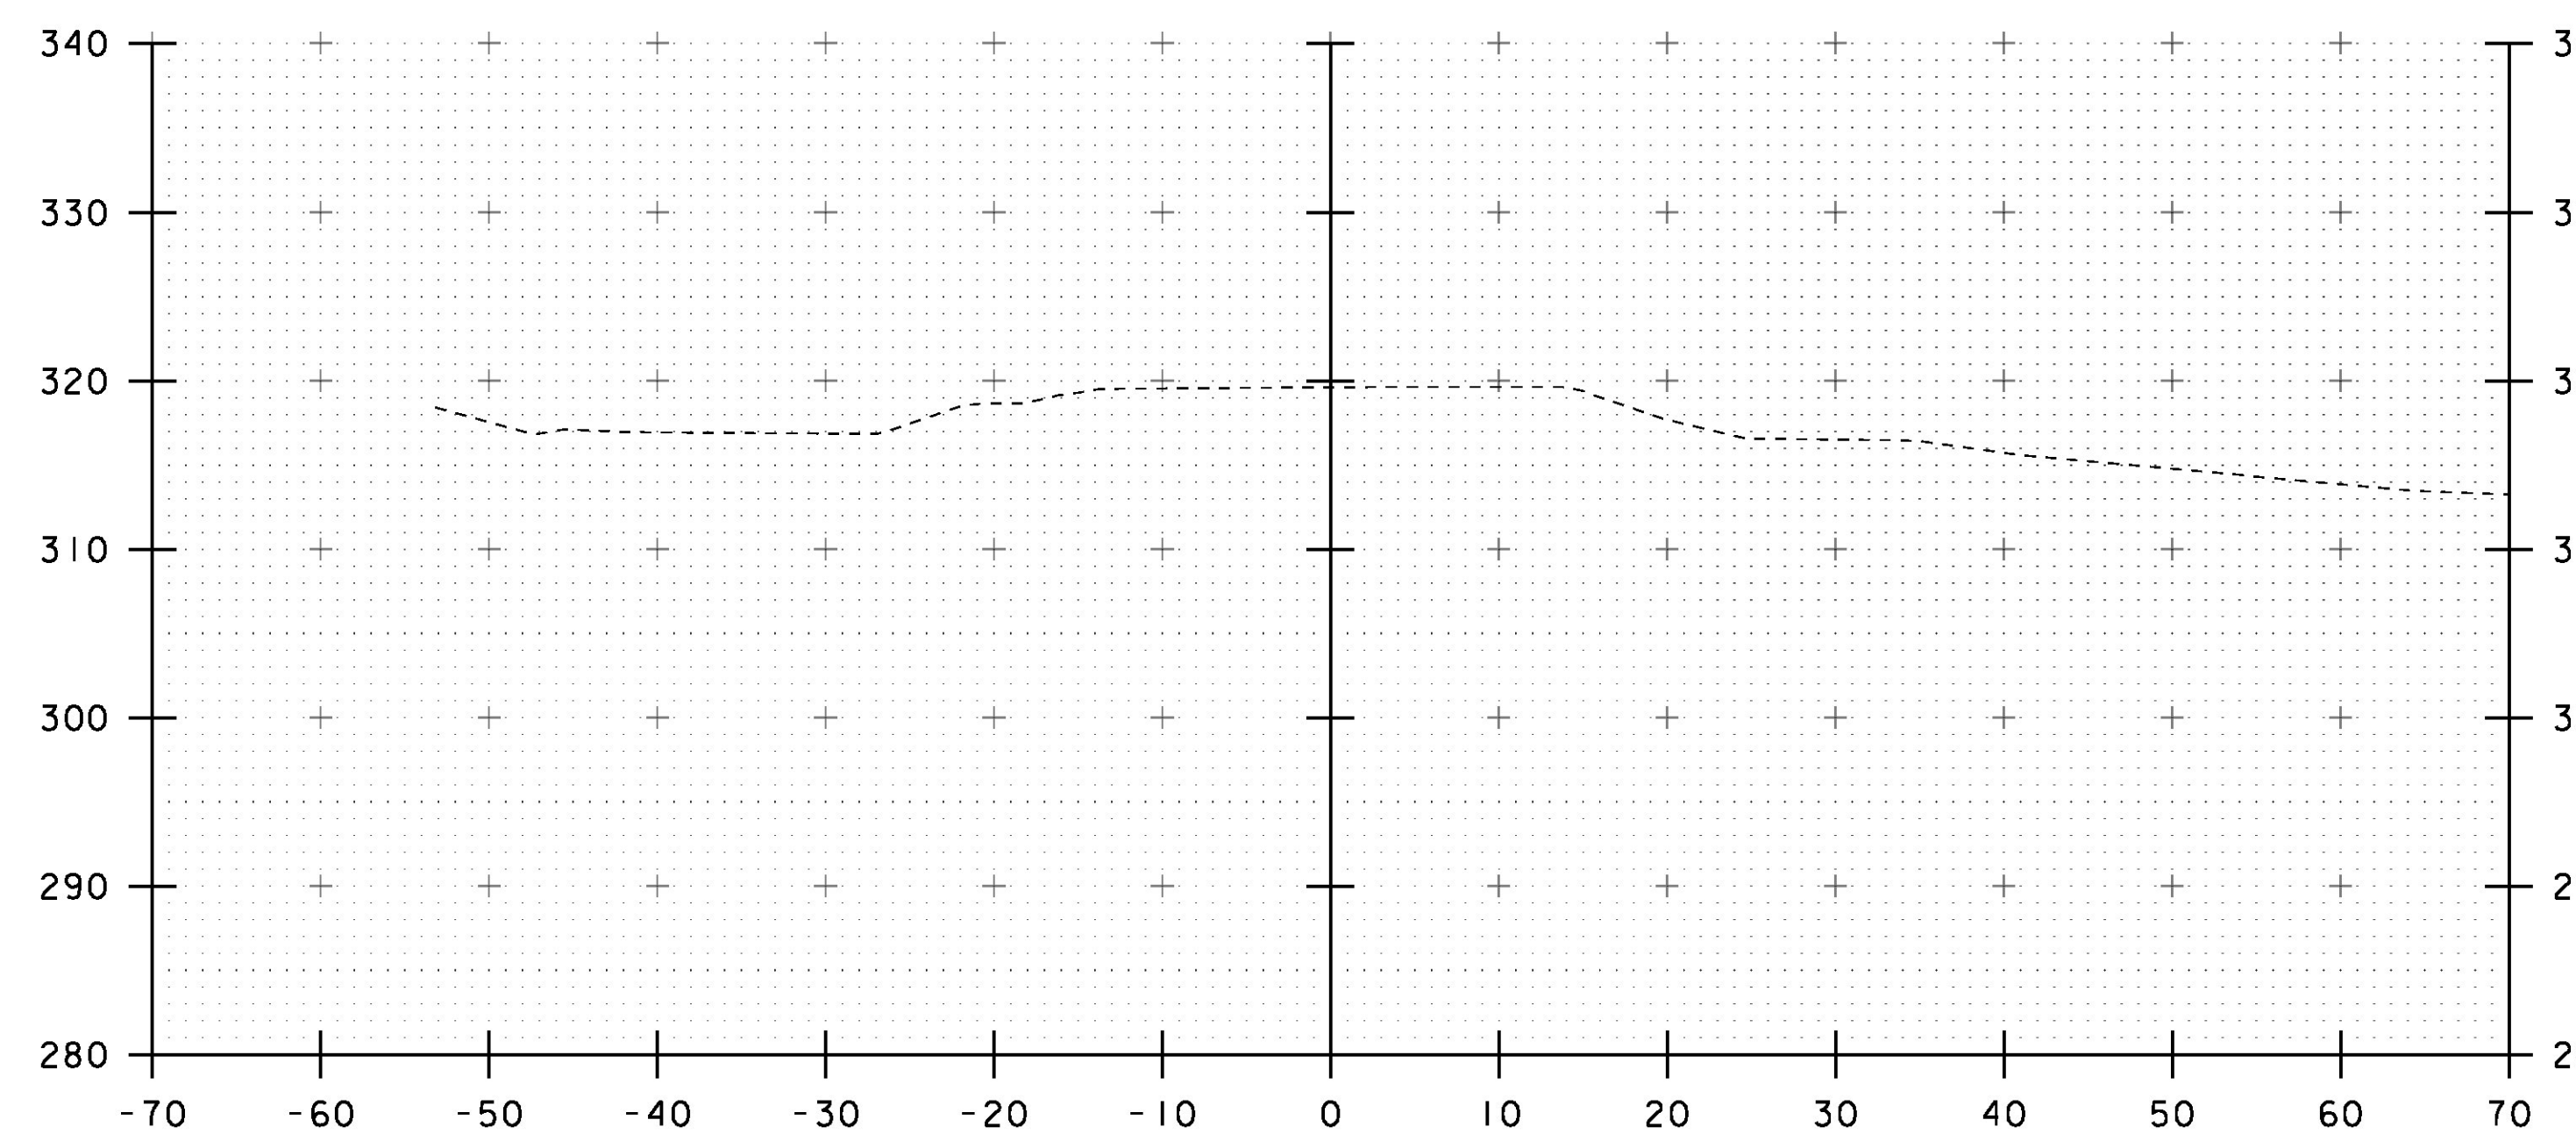

274+50

END APPROACH

STA. 274+00 TO STA. 274+50

PROJECT NAME: RICHMOND	PLOT DATE: 13-SEP-2016
PROJECT NUMBER: BF 0284(28)	DRAWN BY: S. COLEY
FILE NAME: s13c070xs.dgn	CHECKED BY: W. LAMMER
PROJECT LEADER: R. YOUNG	SHEET 41 OF 54
DESIGNED BY: S. COLEY	
ROADWAY CROSS SECTIONS 6	