



STA 51+66.15 LT  
 END SPECIAL PROVISION (STONE FILL,  
 STREAM BED MATERIAL)(TYPE II)

STA 51+71.89 LT  
 END UNCLASSIFIED CHANNEL EXCAVATION  
 END STONE FILL, TYPE III  
 END GRUBBING MATERIAL

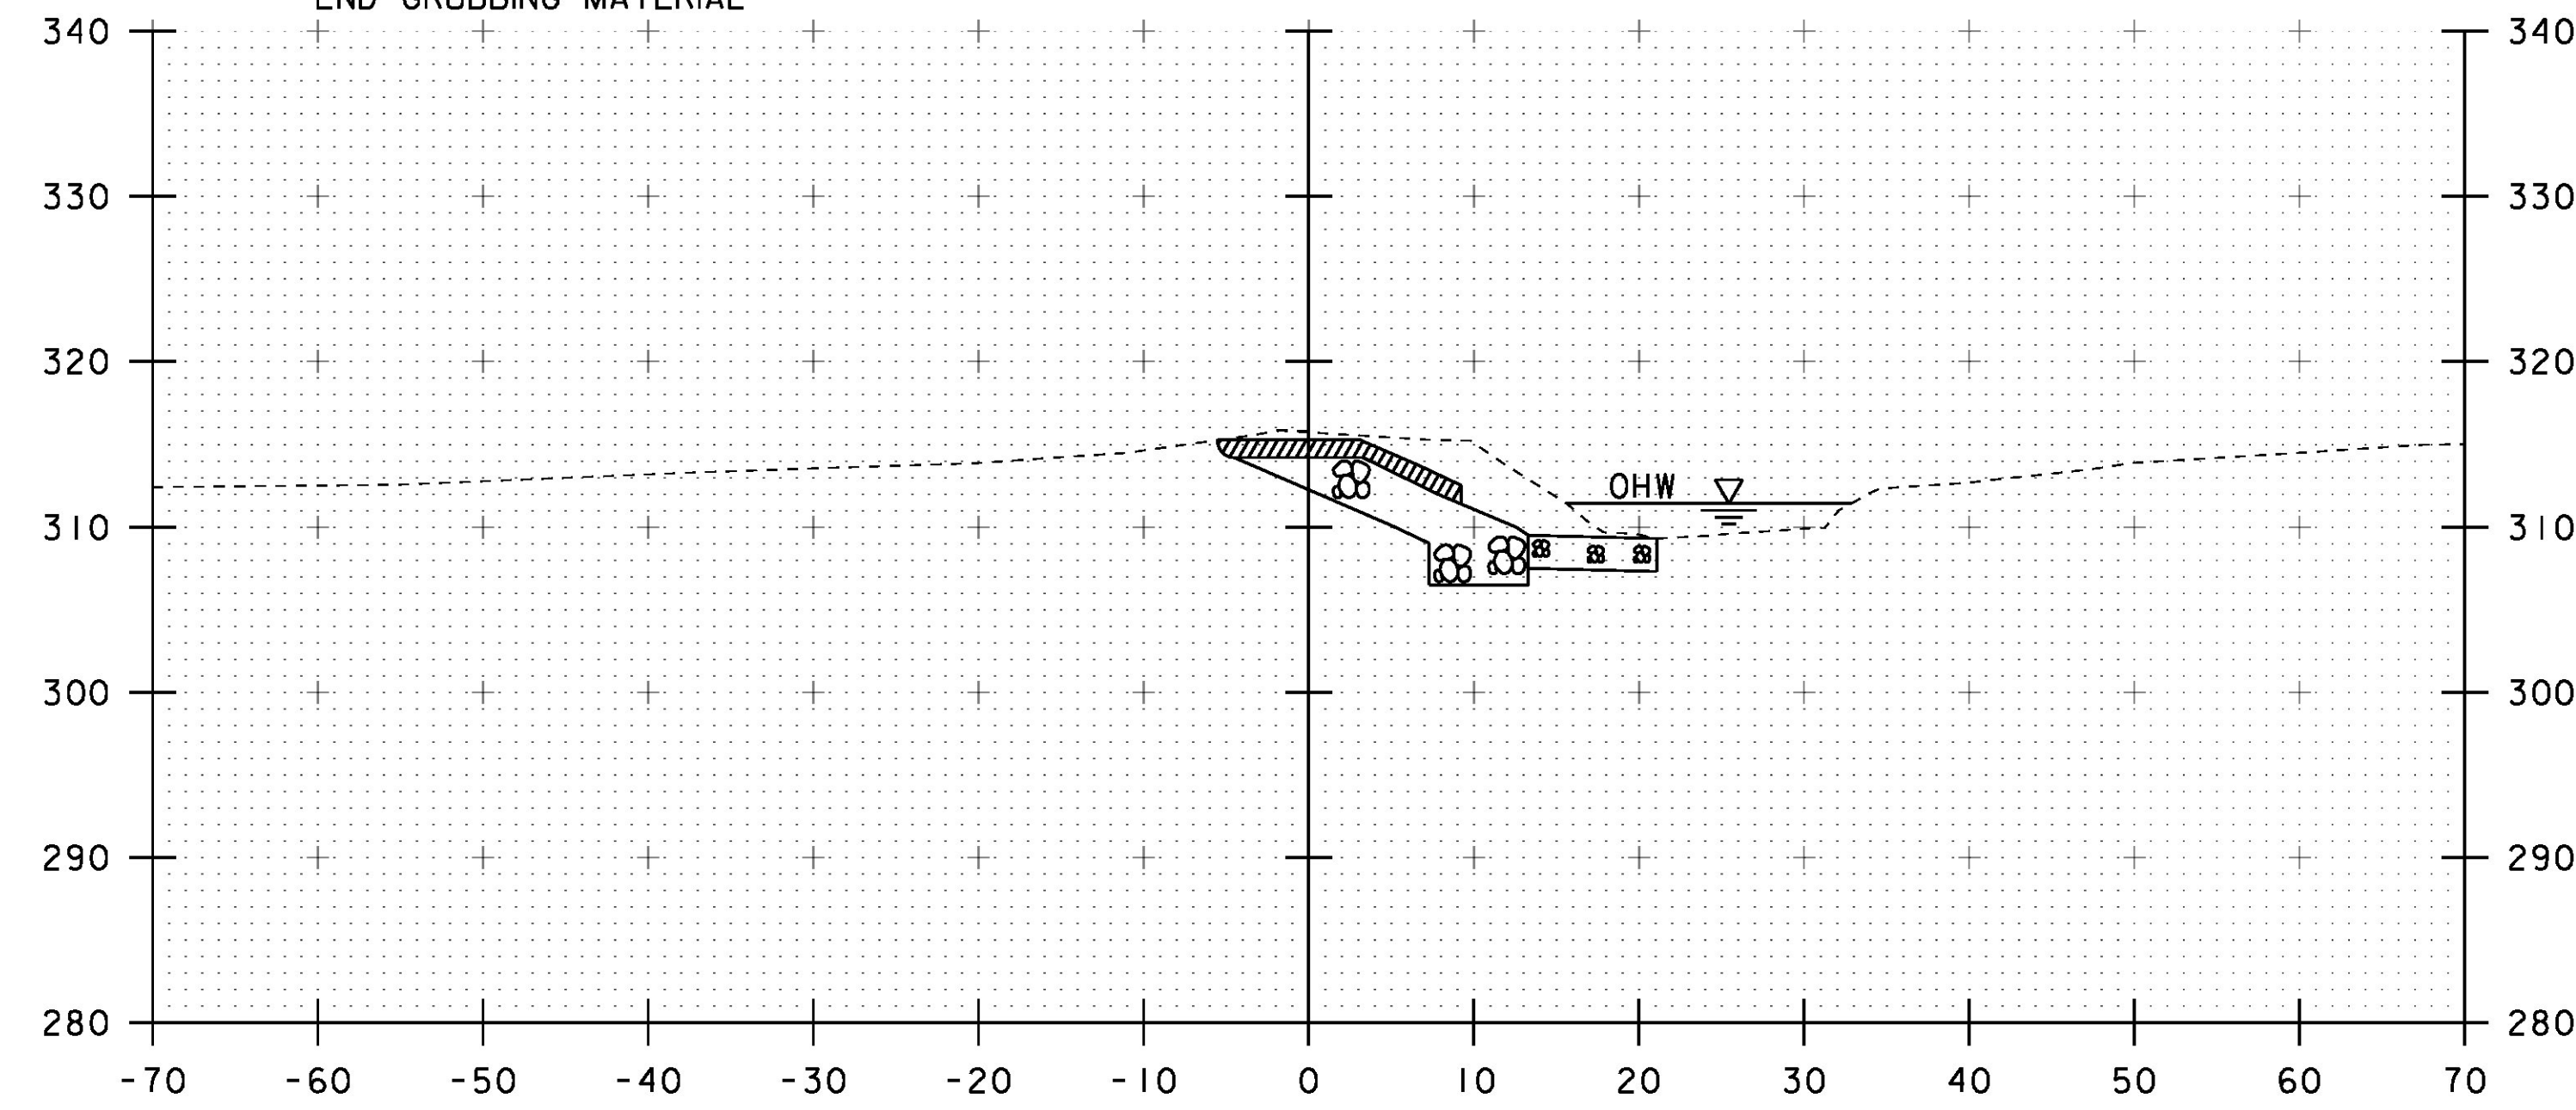


51+60


STA 51+59.42 RT  
 END UNCLASSIFIED CHANNEL EXCAVATION  
 END STONE FILL, TYPE III  
 END GEOTEXTILE UNDER STONE FILL  
 END GRUBBING MATERIAL

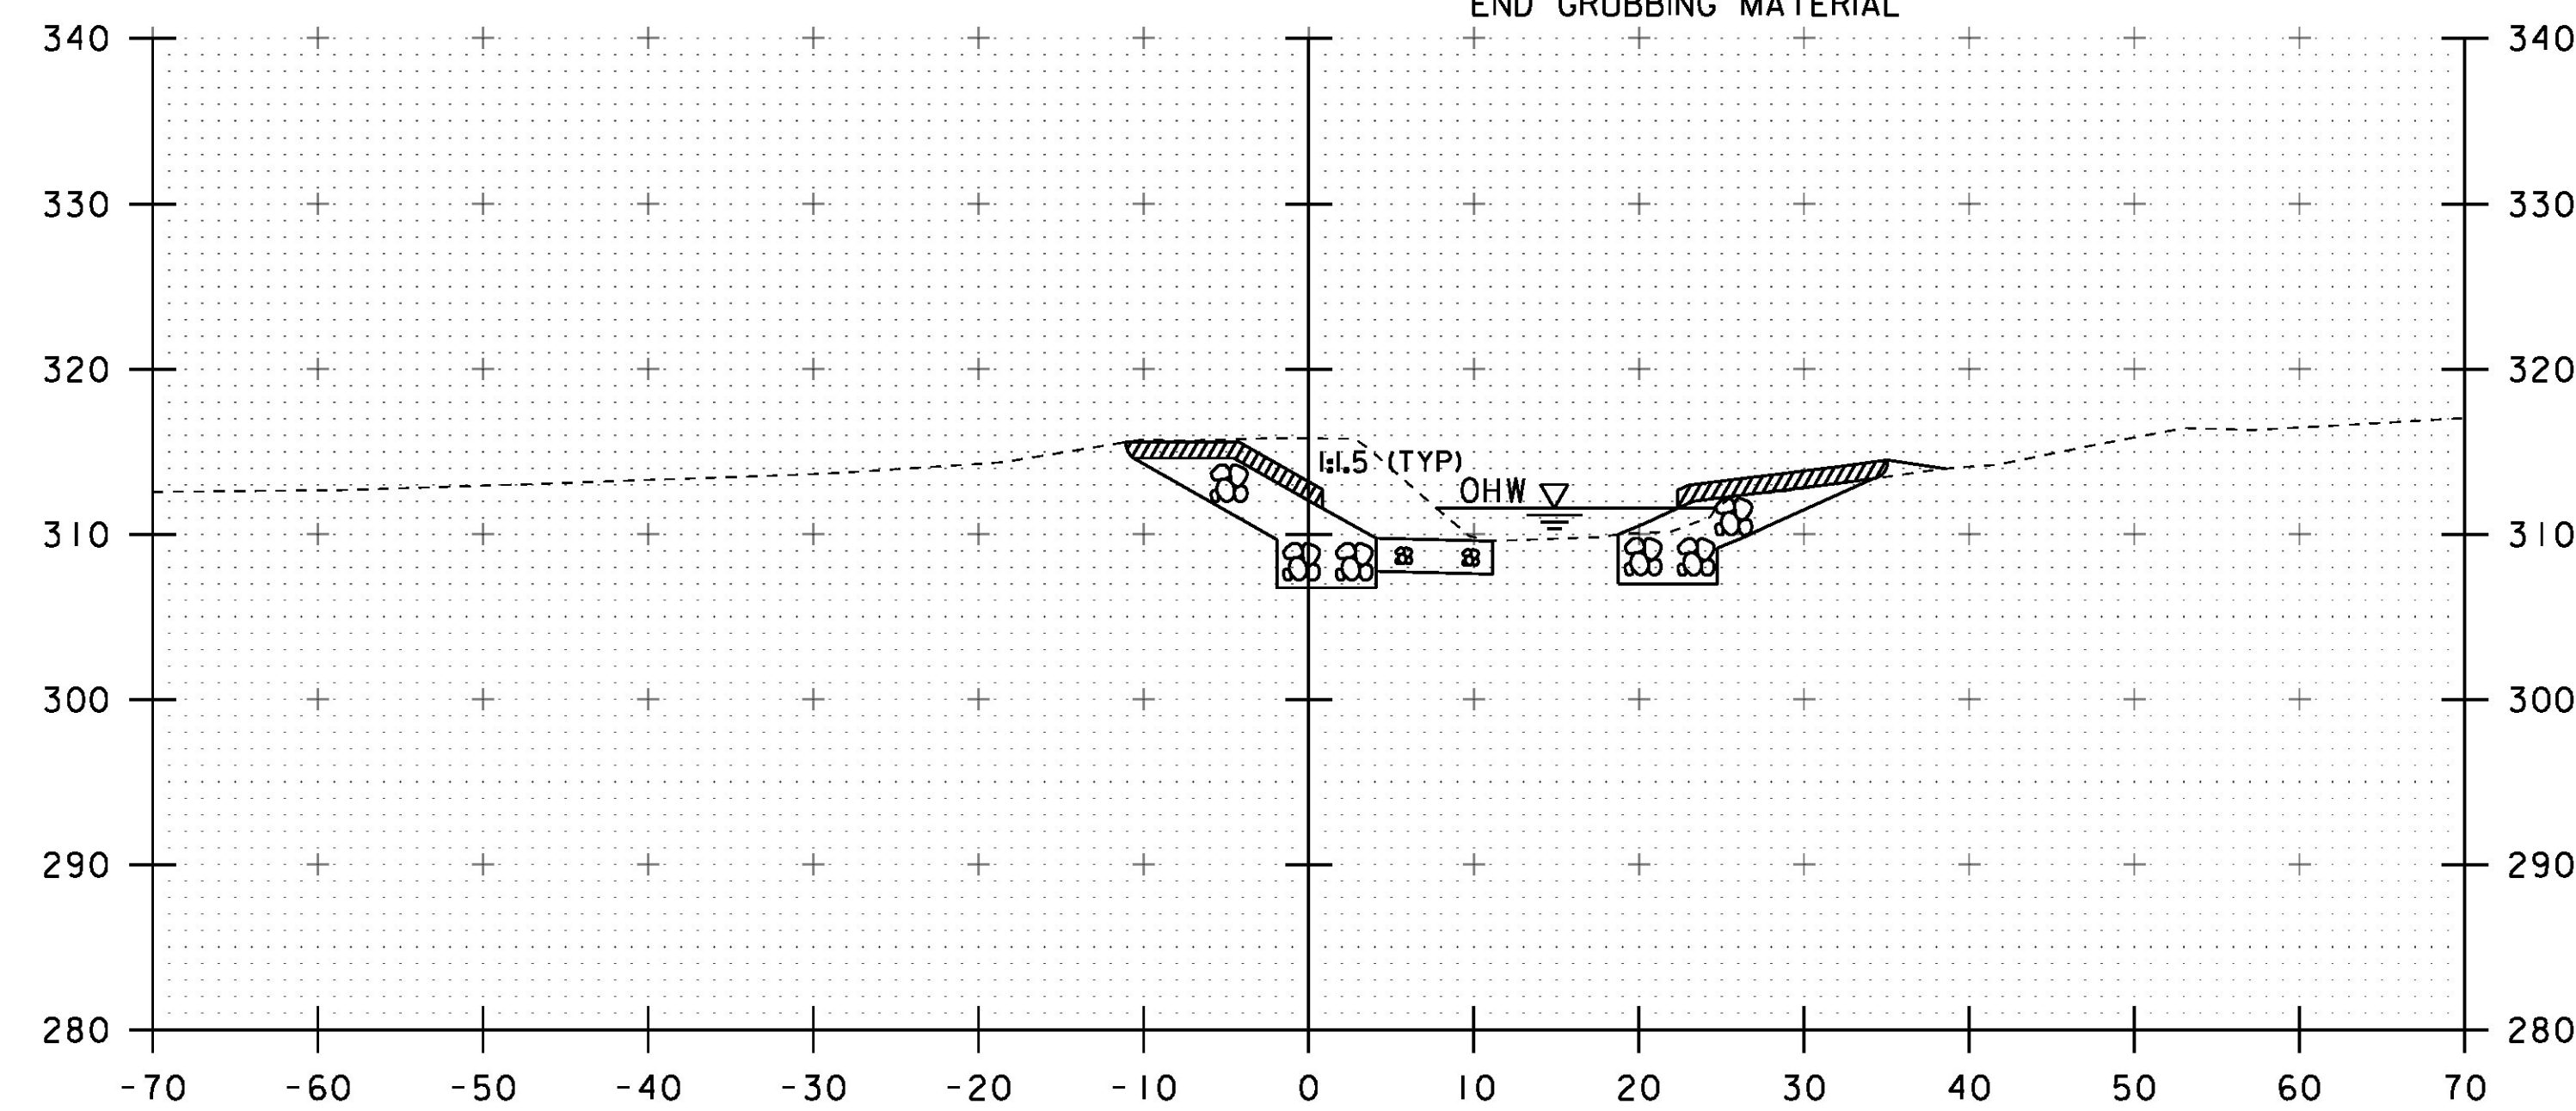

51+50

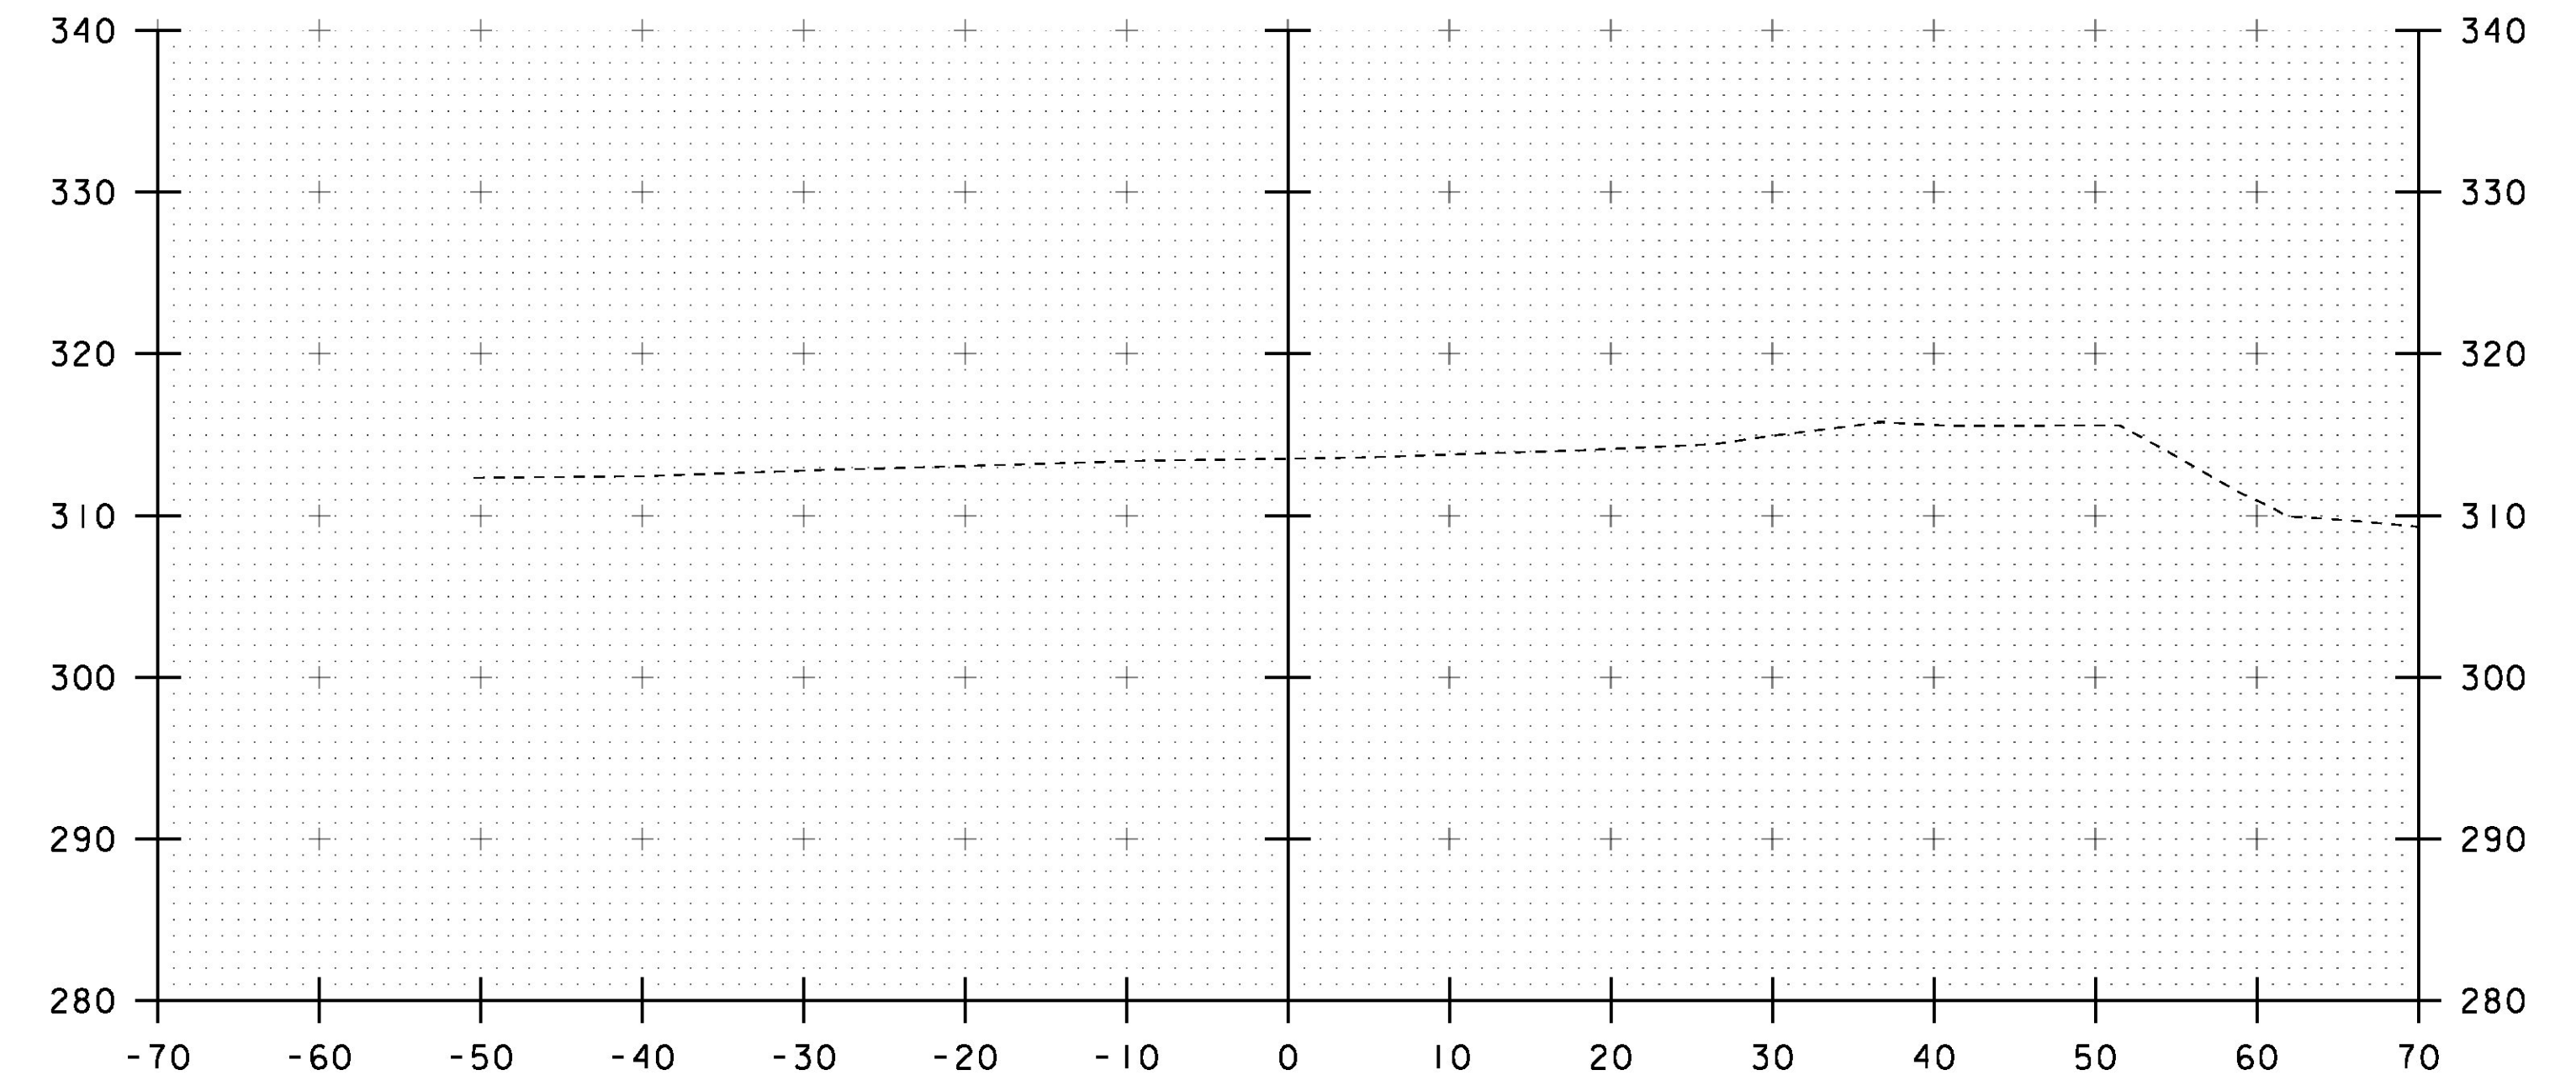

52+00

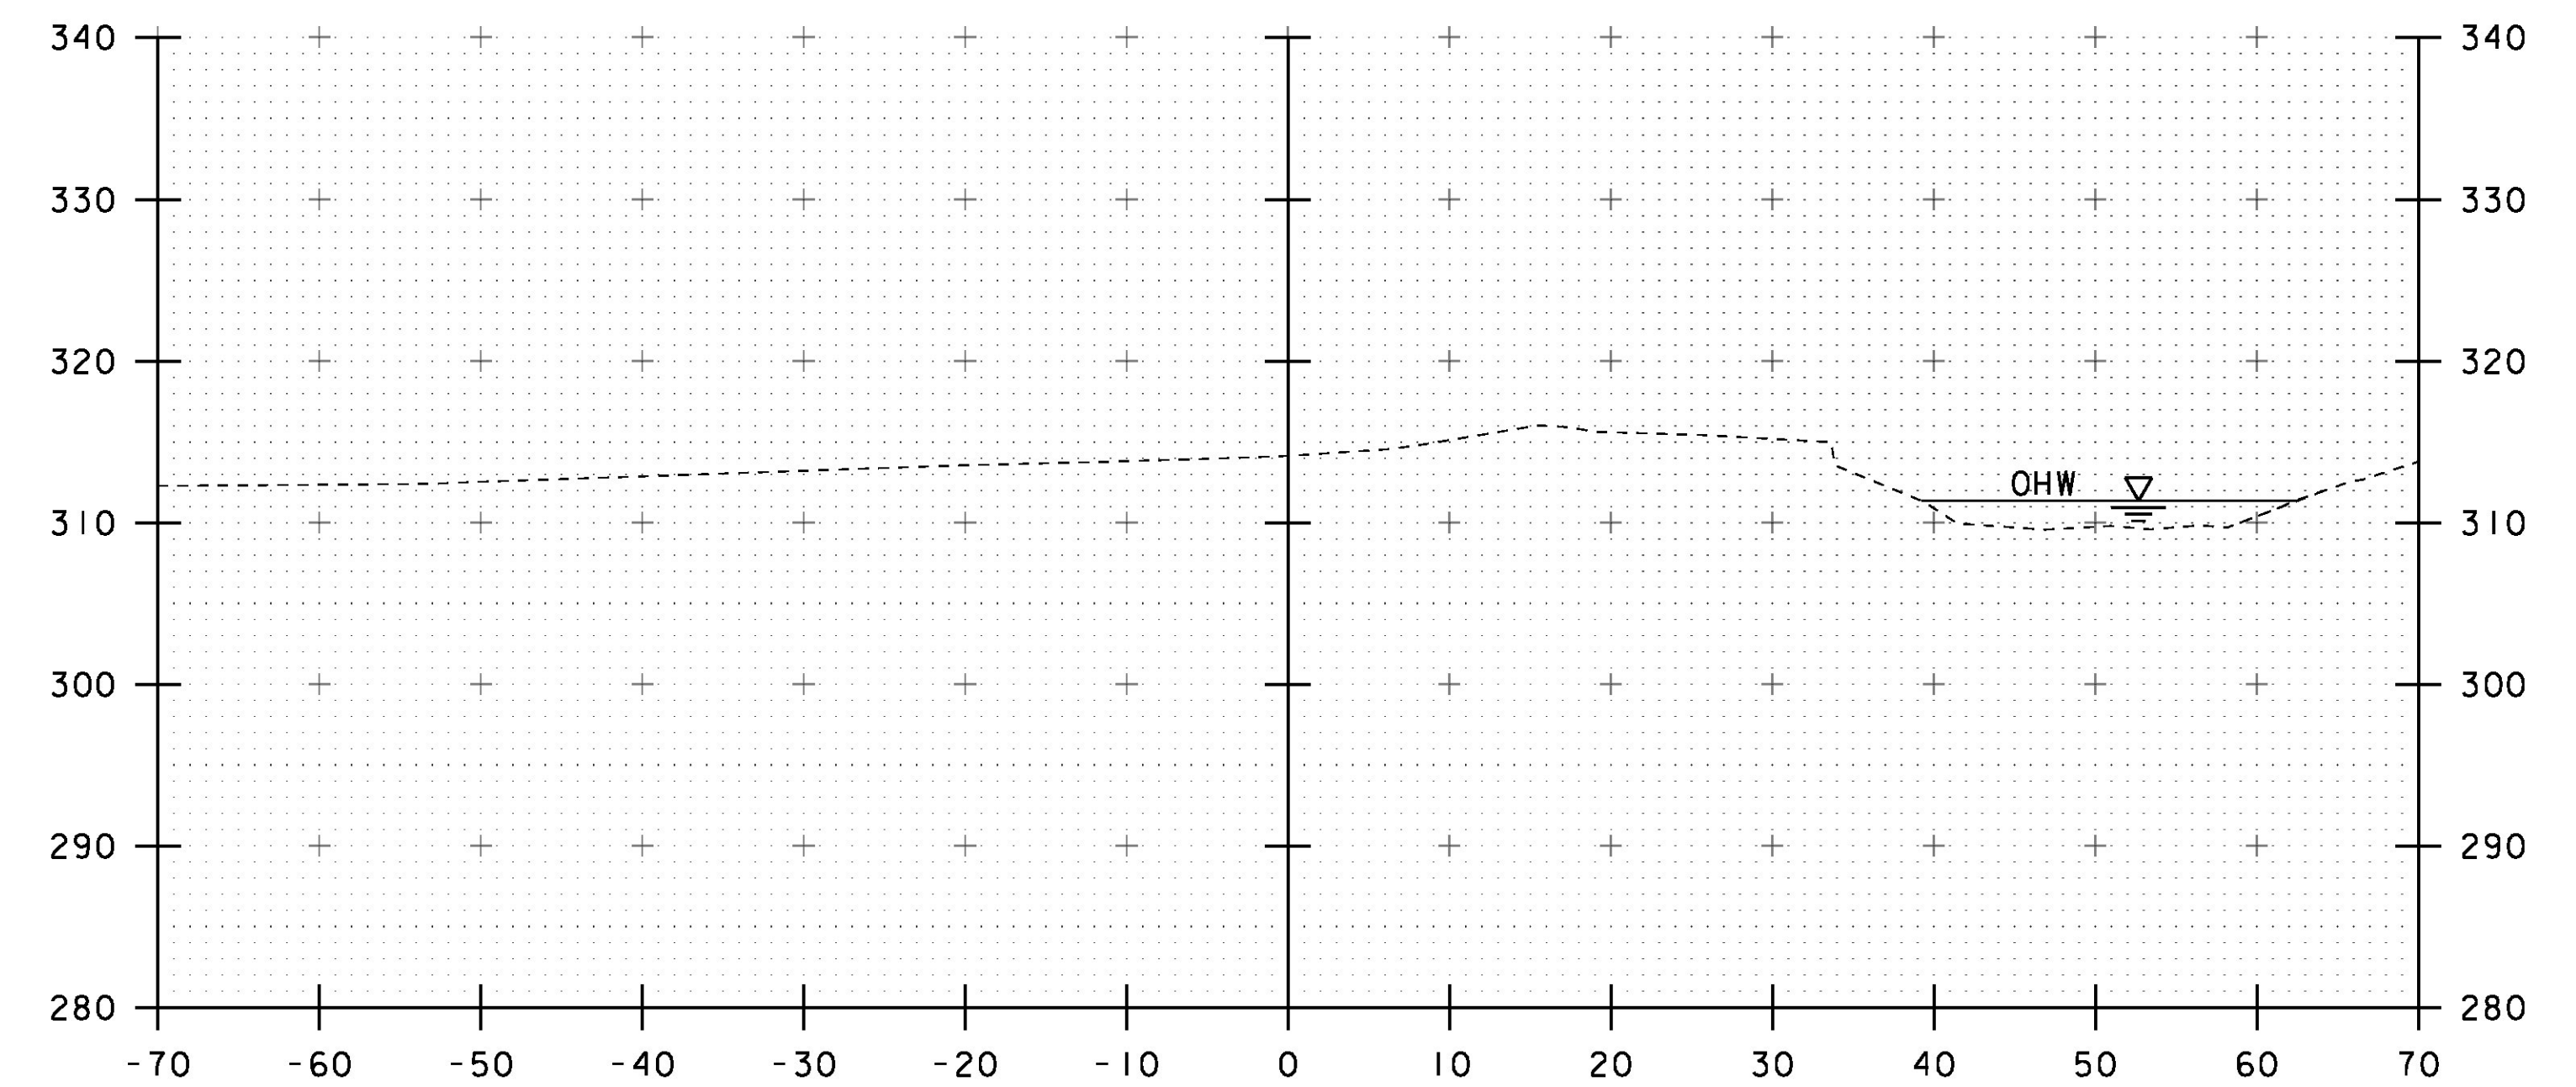

51+80

STA. 51+50 TO STA. 52+00

PROJECT NAME: RICHMOND	PLOT DATE: 13-SEP-2016
PROJECT NUMBER: BF 0284(28)	DRAWN BY: S. COLEY
FILE NAME: s13c070xs.dgn	CHECKED BY: W. LAMMER
PROJECT LEADER: R. YOUNG	SHEET 45 OF 54
DESIGNED BY: S. COLEY	
CHANNEL CROSS SECTIONS 4	