


31+25

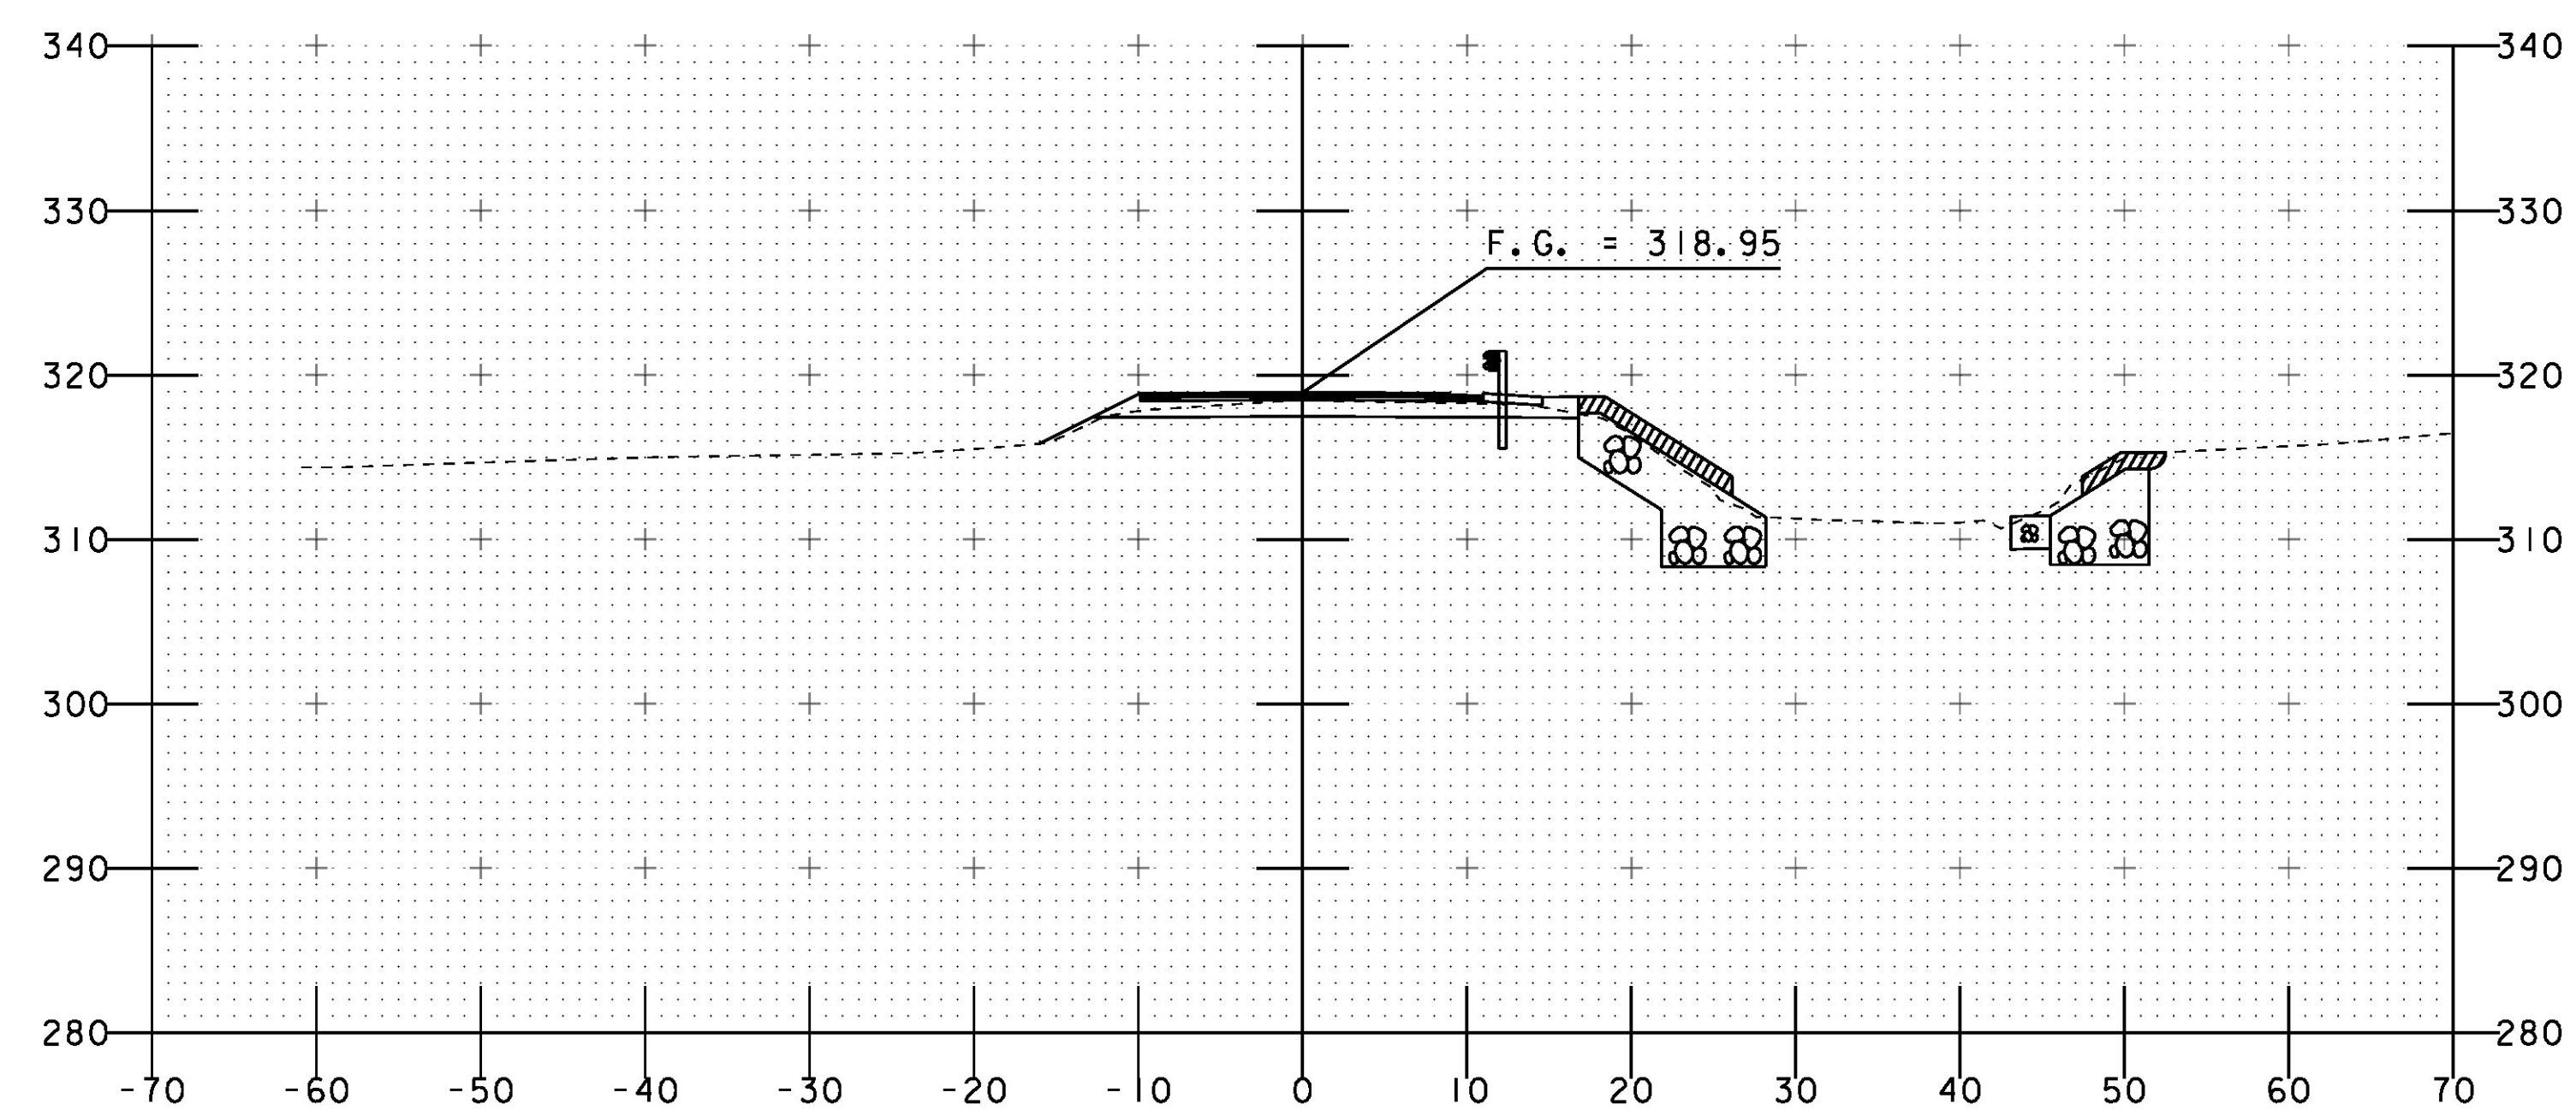

31+00

STA 31+17  
END TH-12

STA. 31+00 TO STA. 31+25

PROJECT NAME: RICHMOND	PLOT DATE: 13-SEP-2016
PROJECT NUMBER: BF 0284(28)	DRAWN BY: S. COLEY
FILE NAME: s13c070xs.dgn	DESIGNED BY: S. COLEY
PROJECT LEADER: R. YOUNG	CHECKED BY: W. LAMMER
TH2 CROSS SECTION 2	SHEET 47 OF 54