


LIMERICK SILT LOAM
 0%-3% SLOPE
 NOT HIGHLY ERODIBLE
 K = 0.49

COLTON GRAVELLY LOAMY SAND
 12%-20% SLOPE
 POTENTIALLY HIGHLY ERODIBLE
 K = 0.17

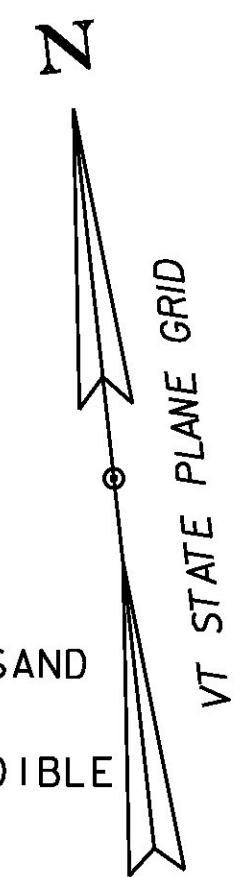

EPSC EXISTING SITE PLAN

SCALE 1" = 20'-0"
 20 0 20

PROJECT NAME:	RICHMOND	PLOT DATE:	13-SEP-2016
PROJECT NUMBER:	BF 0284(28)	DRAWN BY:	S. COLEY
FILE NAME:	si3c070bdr_ero.dgn	CHECKED BY:	W. LAMMER
PROJECT LEADER:	C.P. WILLIAMS		
DESIGNED BY:	S. COLEY		
EPSC EXISTING SITE PLAN			SHEET 49 OF 54