

**COLD PLANING
BITUMINOUS PAVEMENT**
 STA. 269+00 - 269+50
 STA. 274+00 - 274+50

REMOVAL AND DISPOSAL OF GUARDRAIL
 STA. 271+09.17 - 271+74.76 RT
 STA. 271+99.99 - 272+70.84 RT
 STA. 30+15.12 - 30+82.48 RT
 STA. 272+11.12 - 272+80.74 LT


REMOVAL OF EXISTING DELINEATOR
 STA. 271+09.17 RT
 STA. 272+70.84 RT

BITUMINOUS CONCRETE PAVEMENT
 STA. 269+00 - 274+50
 STA. 30+15 - 31+17


**PRECAST REINFORCED CONCRETE
OR CAST-IN-PLACE CURB OPTION**
 STA. 271+33.52 - 271+73.49 RT
 STA. 30+52.39 - 271+84.46 LT
 STA. 272+02.29 - 272+42.42 RT
 STA. 272+13.12 - 272+53.01 LT

18" OPTION PIPE
 STA. 271+22.92 LT - 271+54.02 RT

*GW Tatro
Richmond, VT*

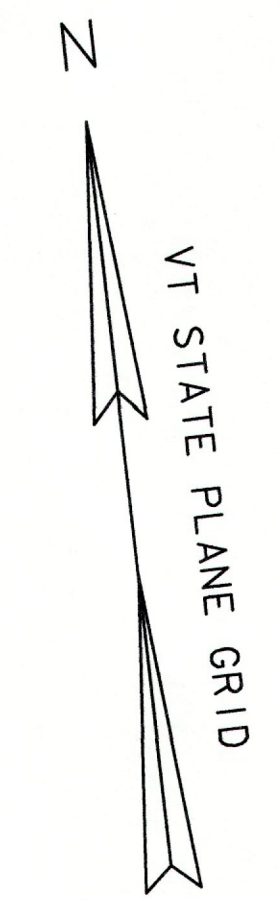

*State of VT
Proposed Bridge Imp.
Project Town of Richmond*

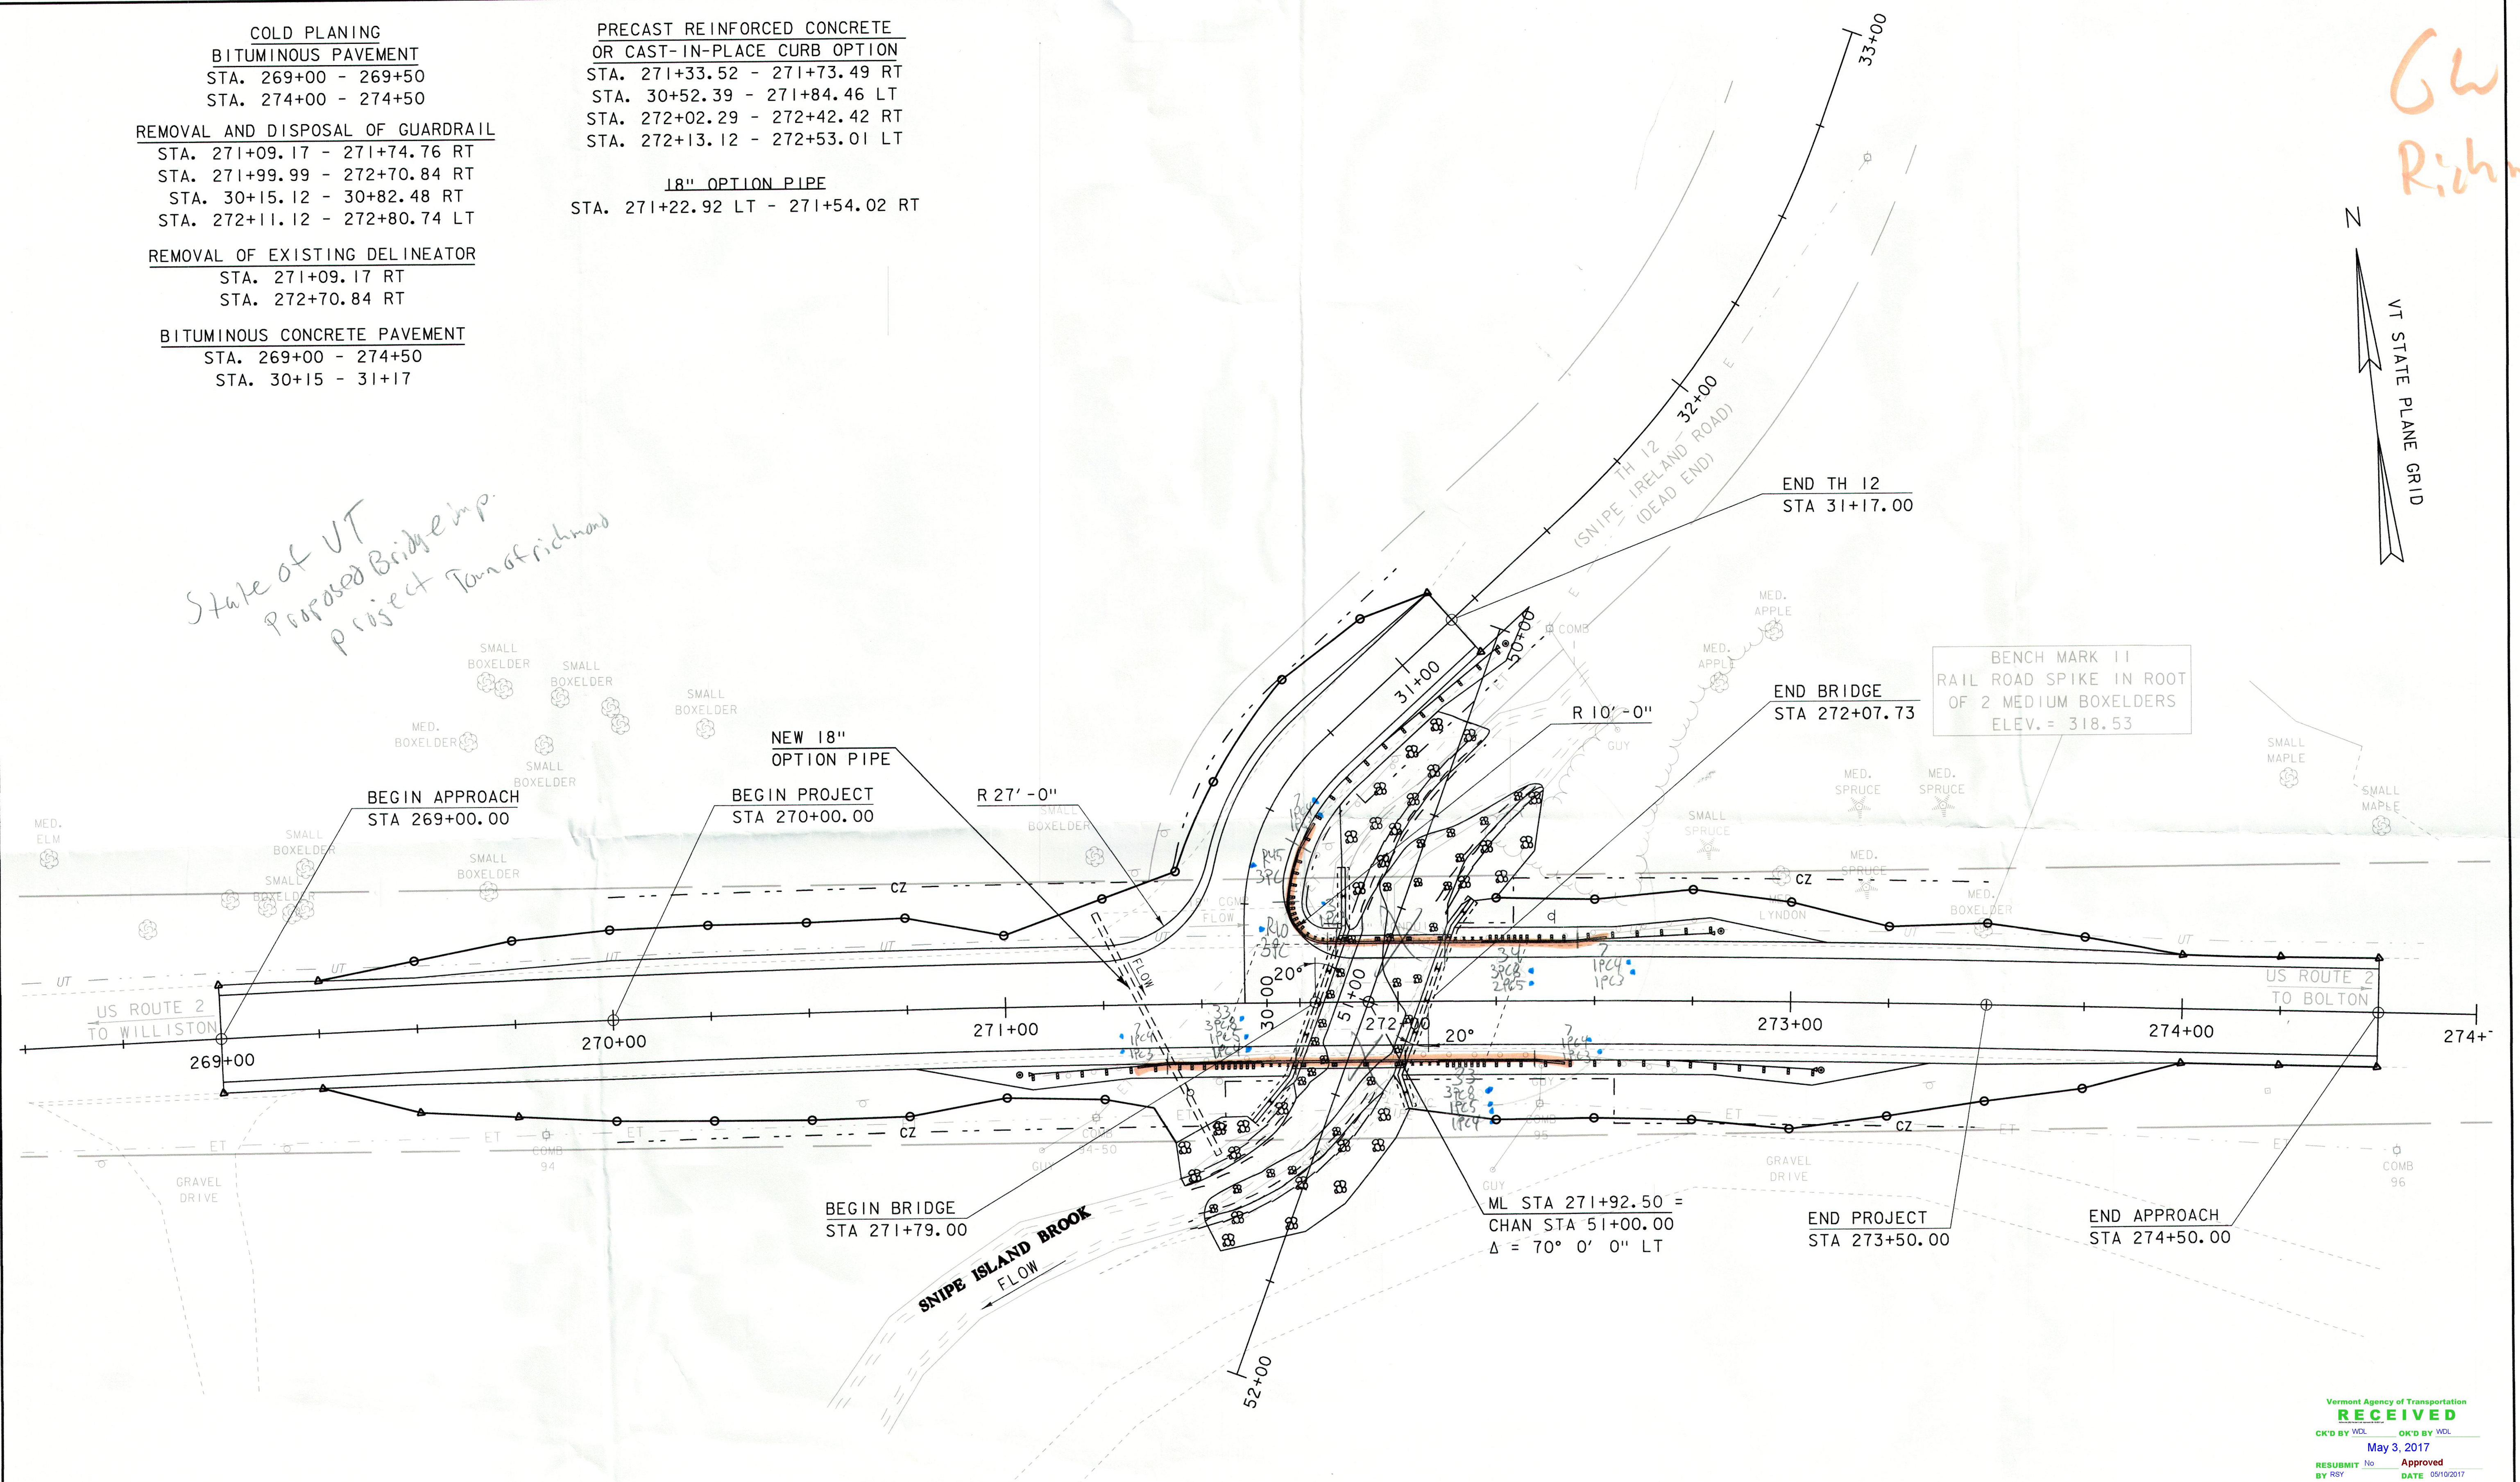

EXISTING BRIDGE DATA
 SINGLE SPAN CONCRETE T-BEAM
 BUILT 1929
 25' LONG, 27'-7" CURB TO CURB

SCALE 1" = 20'-0"
 20 0 20

Vermont Agency of Transportation
RECEIVED
 CK'D BY WCL OK'D BY WCL
 May 3, 2017
 RESUBMIT No Approved
 BY RBY DATE 05/10/2017

PROJECT NAME:	RICHMOND	FILE NAME:	sl3c070bdr.dgn	PLOT DATE:	13-SEP-2016
PROJECT NUMBER:	BF 0284(28)	PROJECT LEADER:	R. YOUNG	DRAWN BY:	S. COLEY
		DESIGNED BY:	S. COLEY	CHECKED BY:	W. LAMMER
		LAYOUT SHEET		SHEET	13 OF 54