


STATE OF VERMONT
AGENCY OF TRANSPORTATION

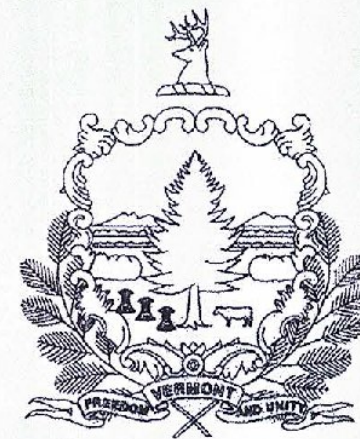

PROPOSED IMPROVEMENT
BRIDGE PROJECT
TOWN OF LYNDON
COUNTY OF CALEDONIA
US ROUTE 5 BRIDGES NO. 144 & 147


PROJECT LOCATIONS: BRIDGE 144 IS LOCATED ON US ROUTE 5 (M.M. 3.64) OVER PASSUMPSIC RIVER IN THE TOWN OF LYNDON.

BRIDGE 147 IS LOCATED ON US ROUTE 5 (M.M. 6.52) OVER CALENDAR BROOK IN THE TOWN OF LYNDON.



PROJECT DESCRIPTION: REMOVAL AND REPLACEMENT OF BITUMINOUS CONCRETE WEARING SURFACE AND MEMBRANE ON BRIDGES AND MINOR ASSOCIATED WORK.

LENGTH OF BRIDGES: 144 147.00 FEET = 0.028 MILES
147 54.00 FEET = 0.010 MILES

TOTAL LENGTH OF BRIDGES: 201.00 FEET = 0.038 MILES

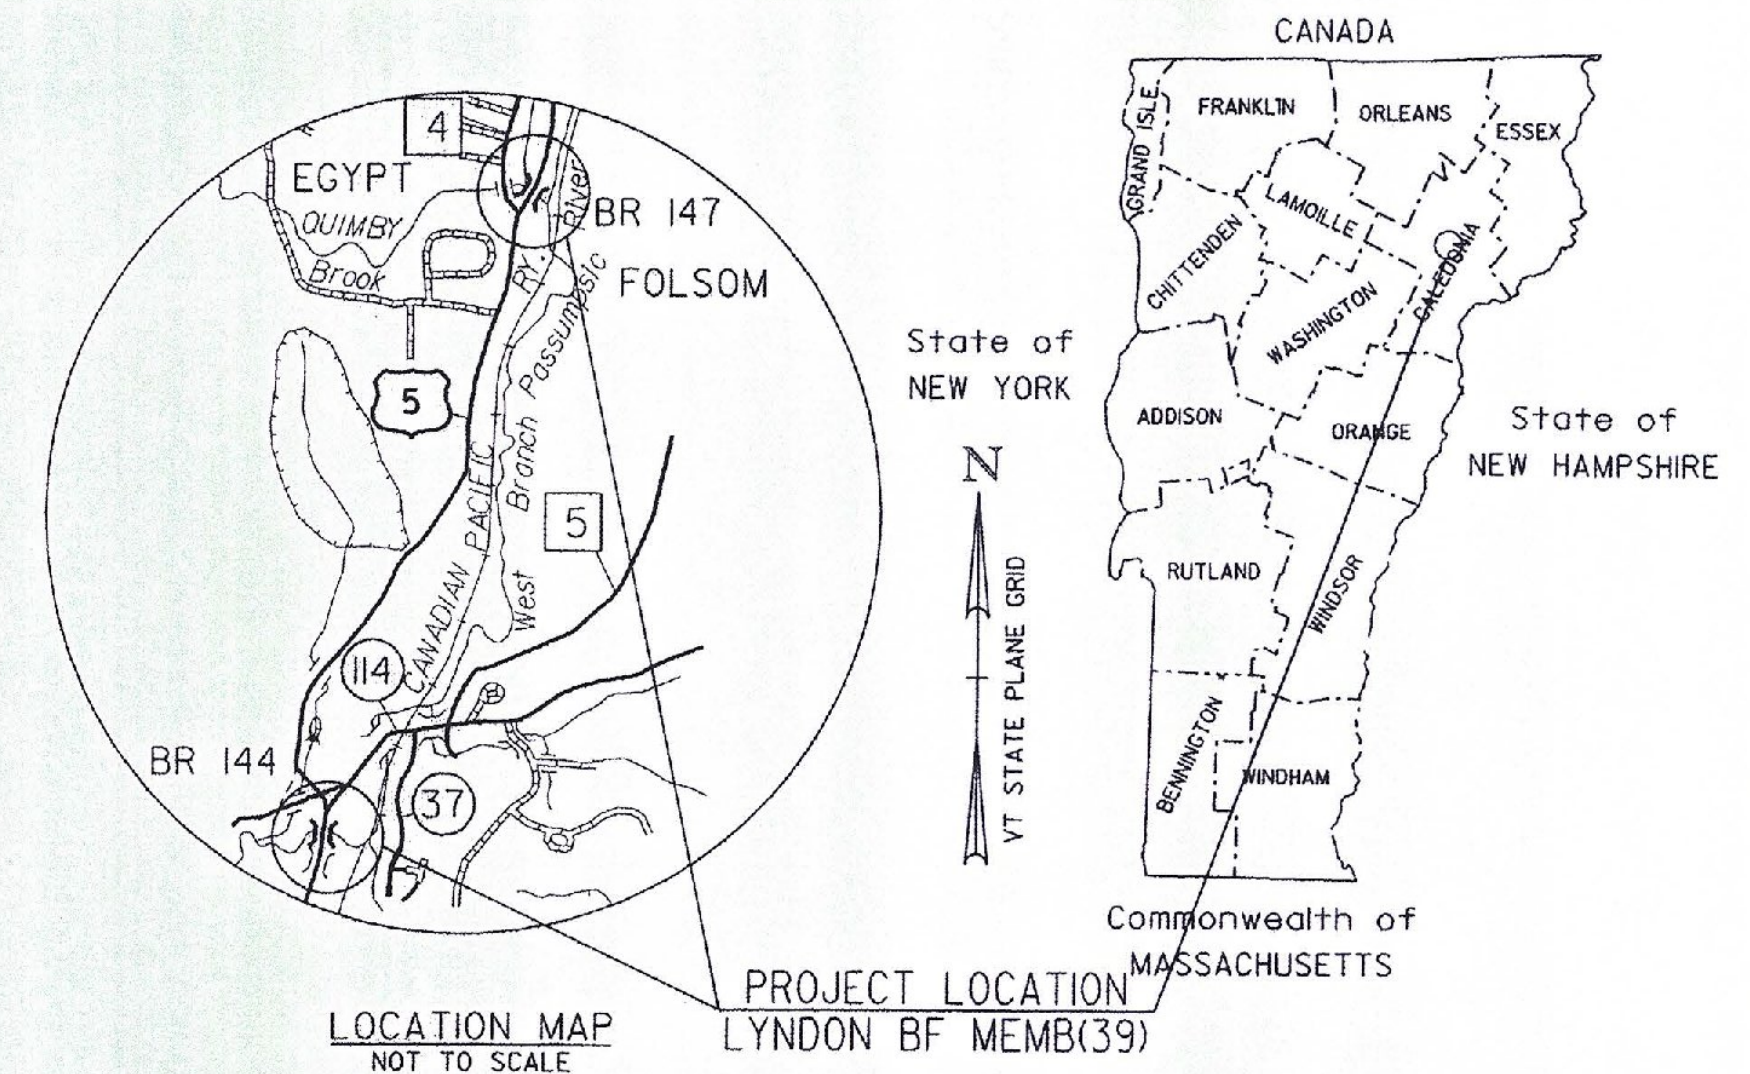


RECORD PLANS	
CONTRACTOR:	J.P. SICARD, INC. - BARTON, VT
RESIDENT ENGINEER:	KEVIN MCCLURE
CONSTRUCTION BEGAN:	AUGUST 11, 2014
CONSTRUCTION COMPLETE:	NOVEMBER 13, 2014
RECORD PLANS BY:	KEVIN MCCLURE
I HEREBY CERTIFY THAT ALL THE CONSTRUCTION REQUIRED BY THIS SET OF DRAWINGS HAS BEEN ACCOMPLISHED AS INDICATED HEREIN.	
BY	<i>Kevin McClure</i> RESIDENT ENGINEER
DATE	5-8-15
NOTE: Any further information concerning final quantities, amounts or other details relative to this project may be found at Central Files in the electronic archives.	

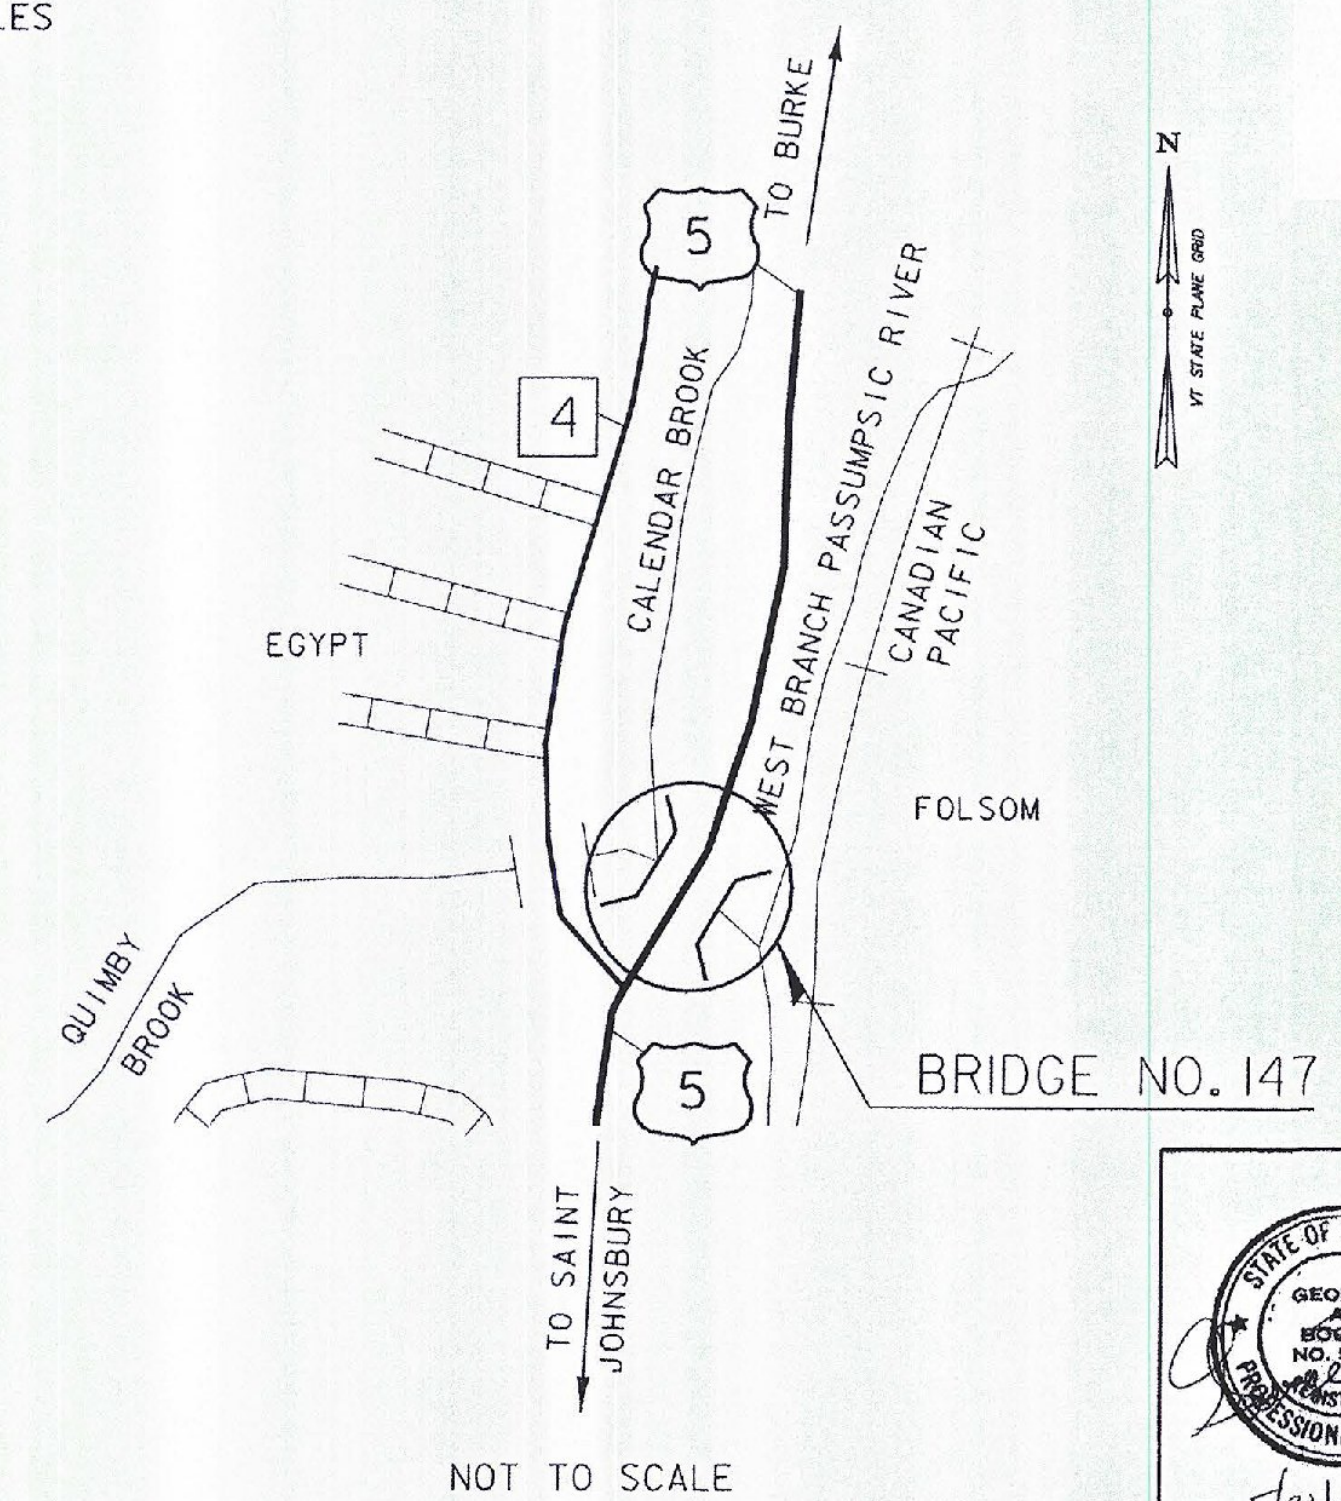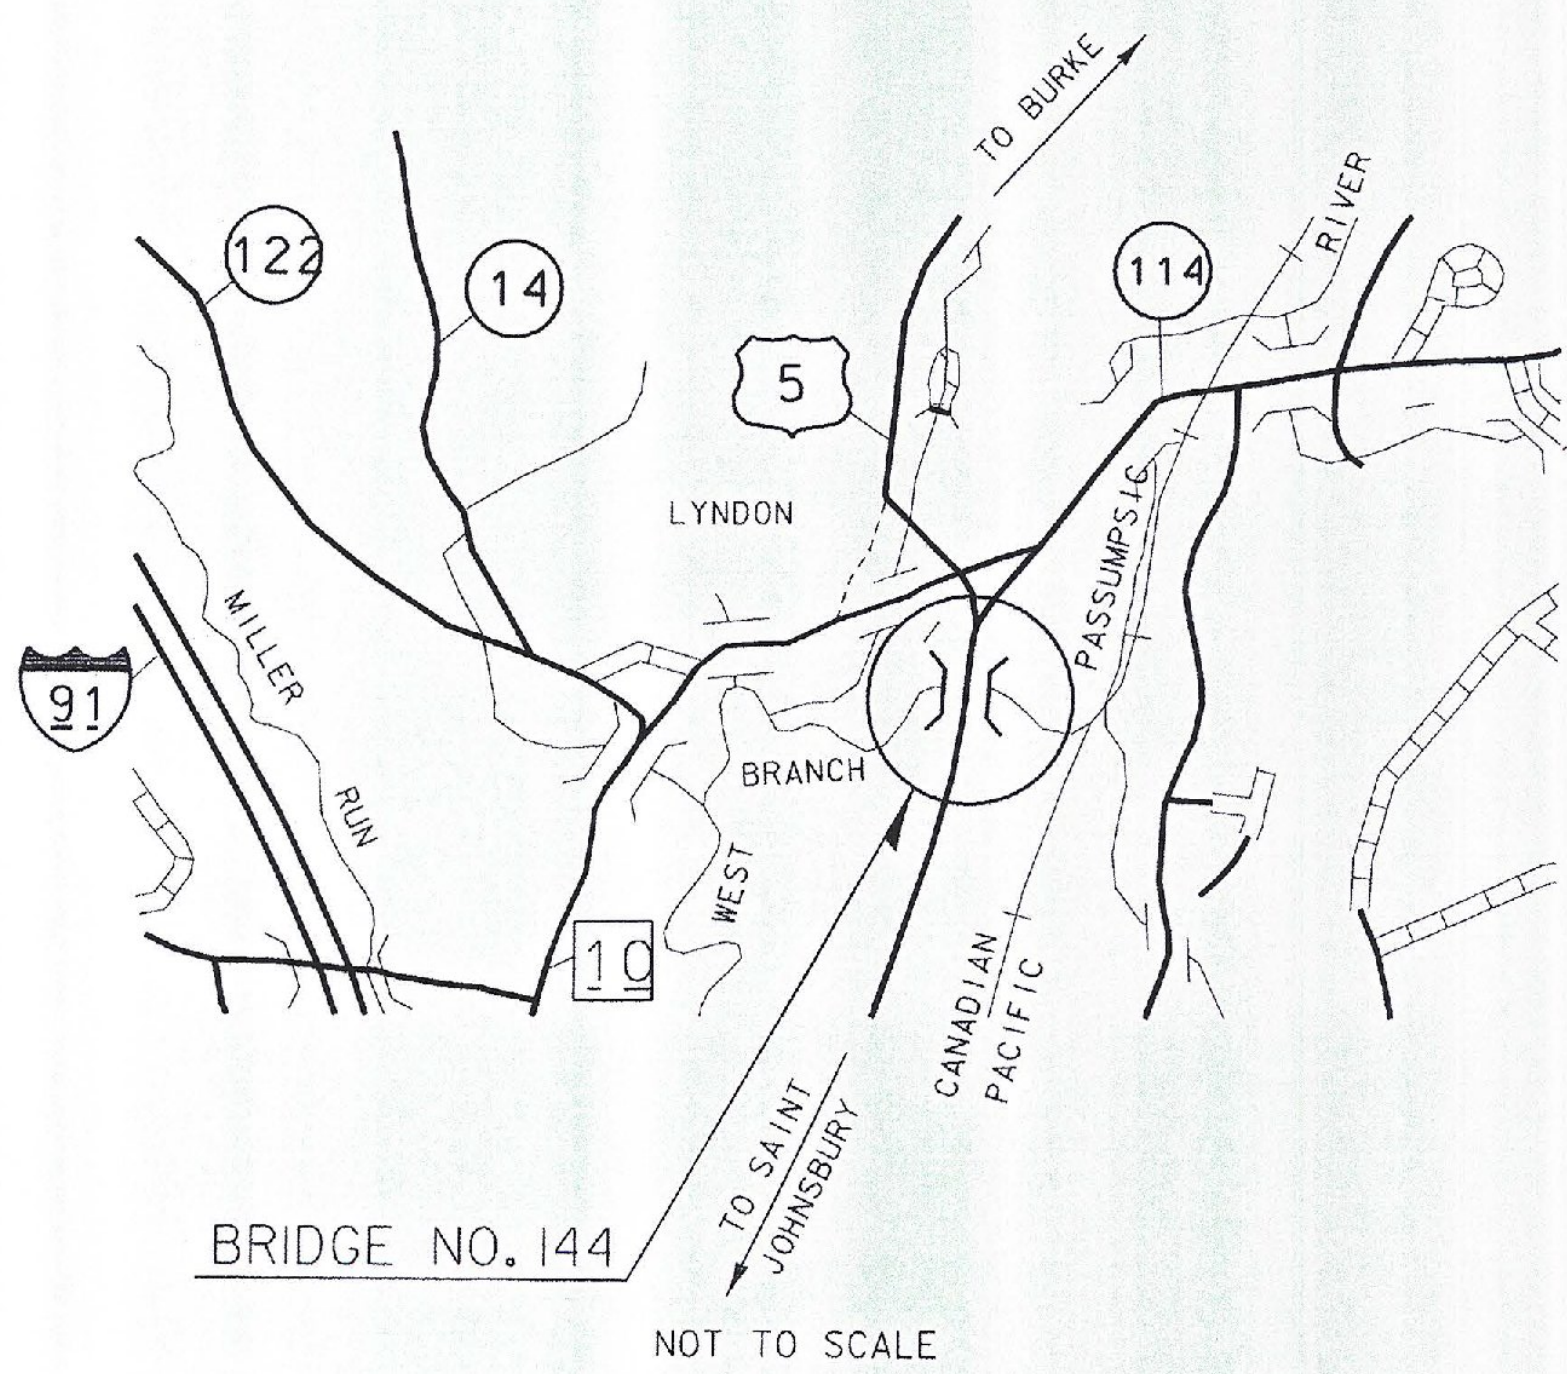

BUILT AS DESIGNED

THESE PLANS ARE SUBJECT TO SUCH ENGINEERING CHANGES AS MAY BE REQUIRED BY THE FEDERAL HIGHWAY ADMINISTRATION OR THE DIRECTOR OF PROGRAM DEVELOPMENT.
CONSTRUCTION IS TO BE CARRIED ON IN ACCORDANCE WITH THESE PLANS AND THE STANDARD SPECIFICATIONS FOR CONSTRUCTION DATED 2011, AS APPROVED BY THE FEDERAL HIGHWAY ADMINISTRATION ON JULY 20, 2011 FOR USE ON THIS PROJECT, INCLUDING ALL SUBSEQUENT REVISIONS AND SUCH REVISED SPECIFICATIONS AND SPECIAL PROVISIONS AS ARE INCORPORATED IN THESE PLANS.

QUALITY ASSURANCE PROGRAM : LEVEL I	
SURVEYED BY :	N/A
SURVEYED DATE :	N/A
DATUM	
VERTICAL	N/A
HORIZONTAL	N/A

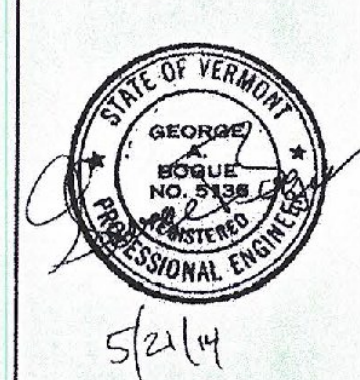

Stantec
Stantec Consulting Services Inc.
35 Green Mountain Drive
South Burlington VT U.S.A. 05403
Phone: (802) 864-0223
Fax: (802) 864-0165
www.stantec.com

DIRECTOR OF PROGRAM DEVELOPMENT	APPROVED <i>Kevin A. Marshall</i> DATE 5/22/14
PROJECT MANAGER : DOUG BONNEAU	
PROJECT NAME : LYNDON	
PROJECT NUMBER : BF MEMB (39)	
SHEET 1 OF 28 SHEETS	