
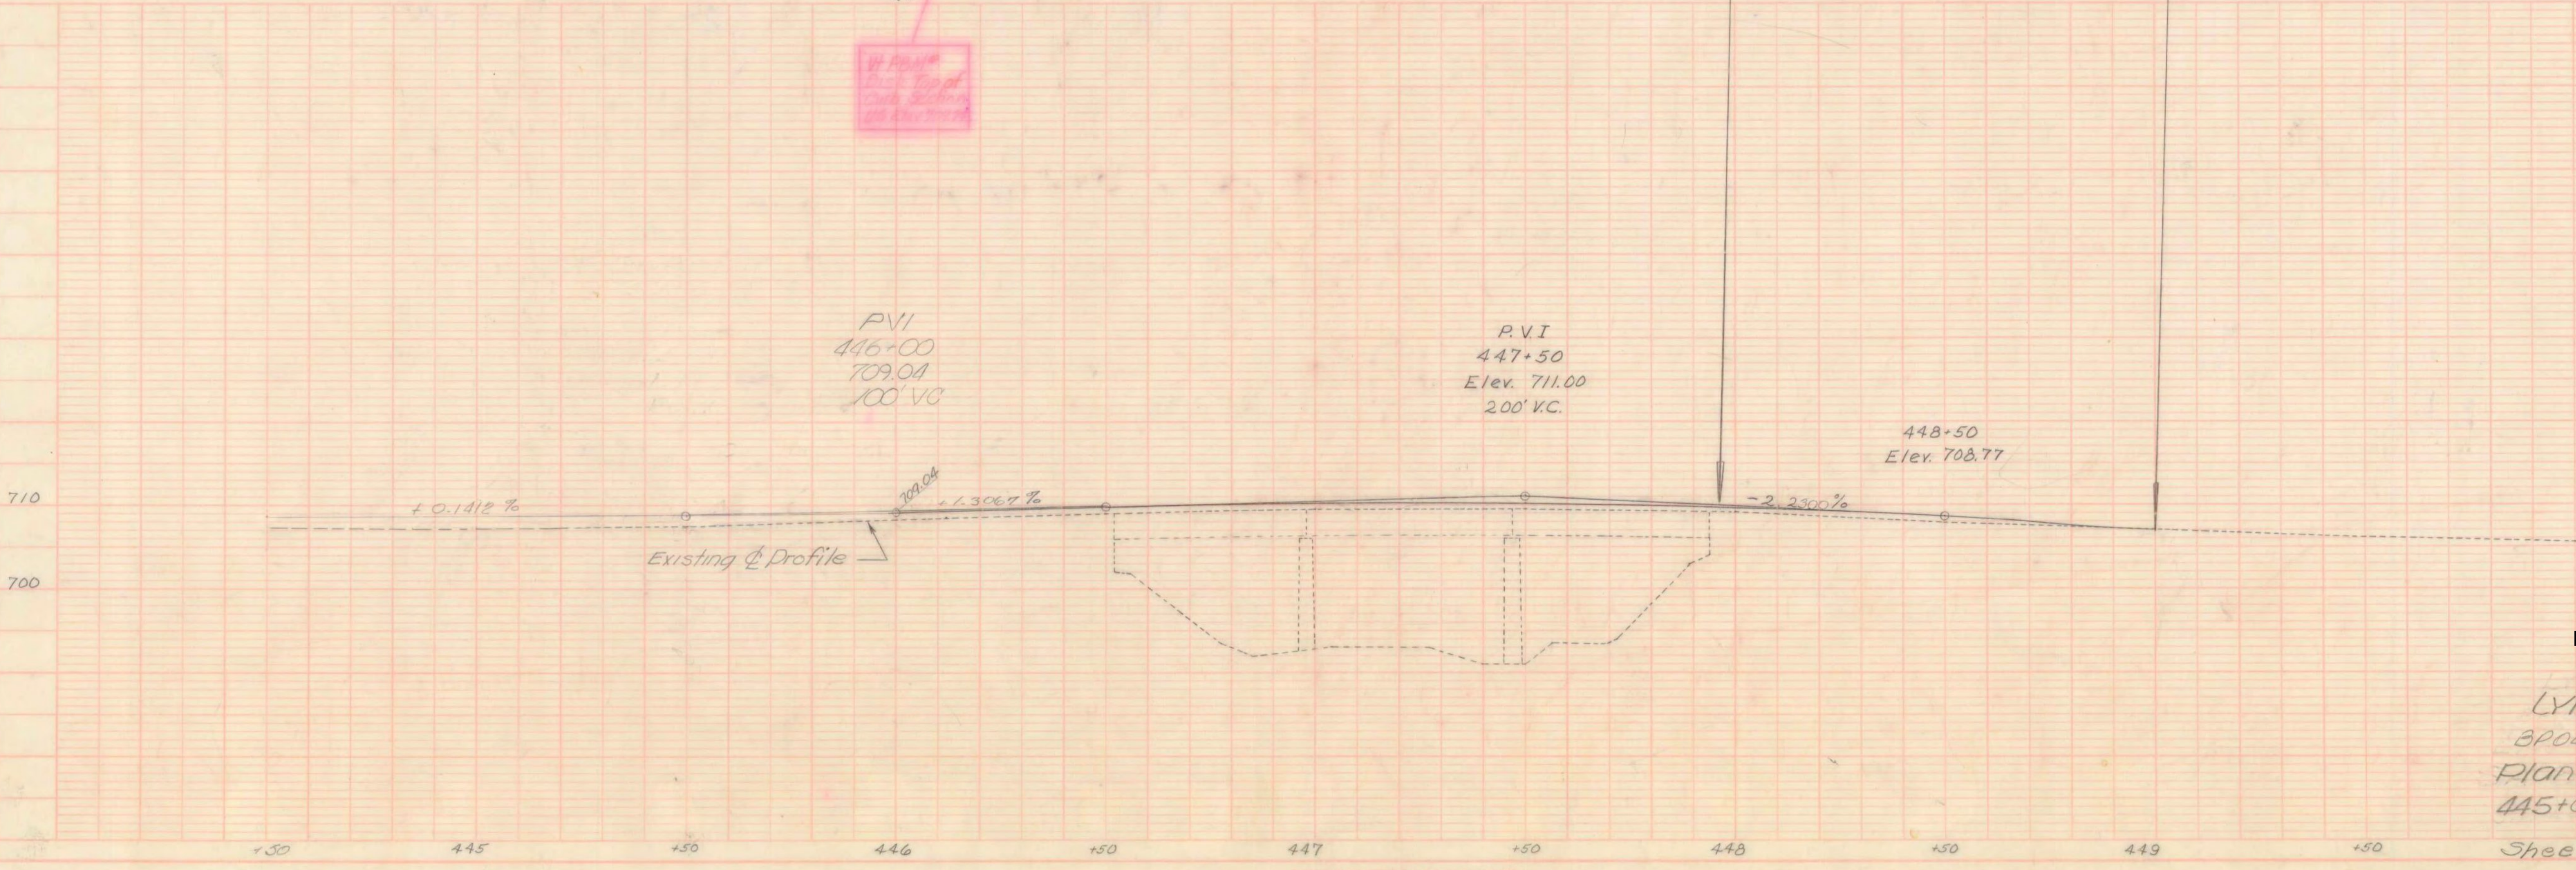


REMOVAL AND DISPOSAL OF PRESENT  
GUARD RAIL, ITEM 549  
~~445+00 - 445+95 Rt.~~  
~~446+28 - 446+43 Rt.~~  
~~446+43 - 446+57 Lt.~~  
~~447+91 - 447+94 Rt.~~  
~~448+03 - 448+25 Lt.~~

VERTICAL GRANITE CURB, ITEM 556-B  
445+00 - 446+36 Rt.

\* BITUMINOUS CONCRETE  
SIDEWALK, ITEM 562  
445+00 - 446+36 Rt.

STANDARD STEEL BEAM GUARD RAIL  
W/ STEEL POSTS, ITEM 545-A  
 445+61.5 - 446+24 Rt. ✓  
 445+935 - 446+56 Lt. ✓  
 447+86 - 448+36 Rt. ✓  
 448+15 - 449+15 Lt. ✓

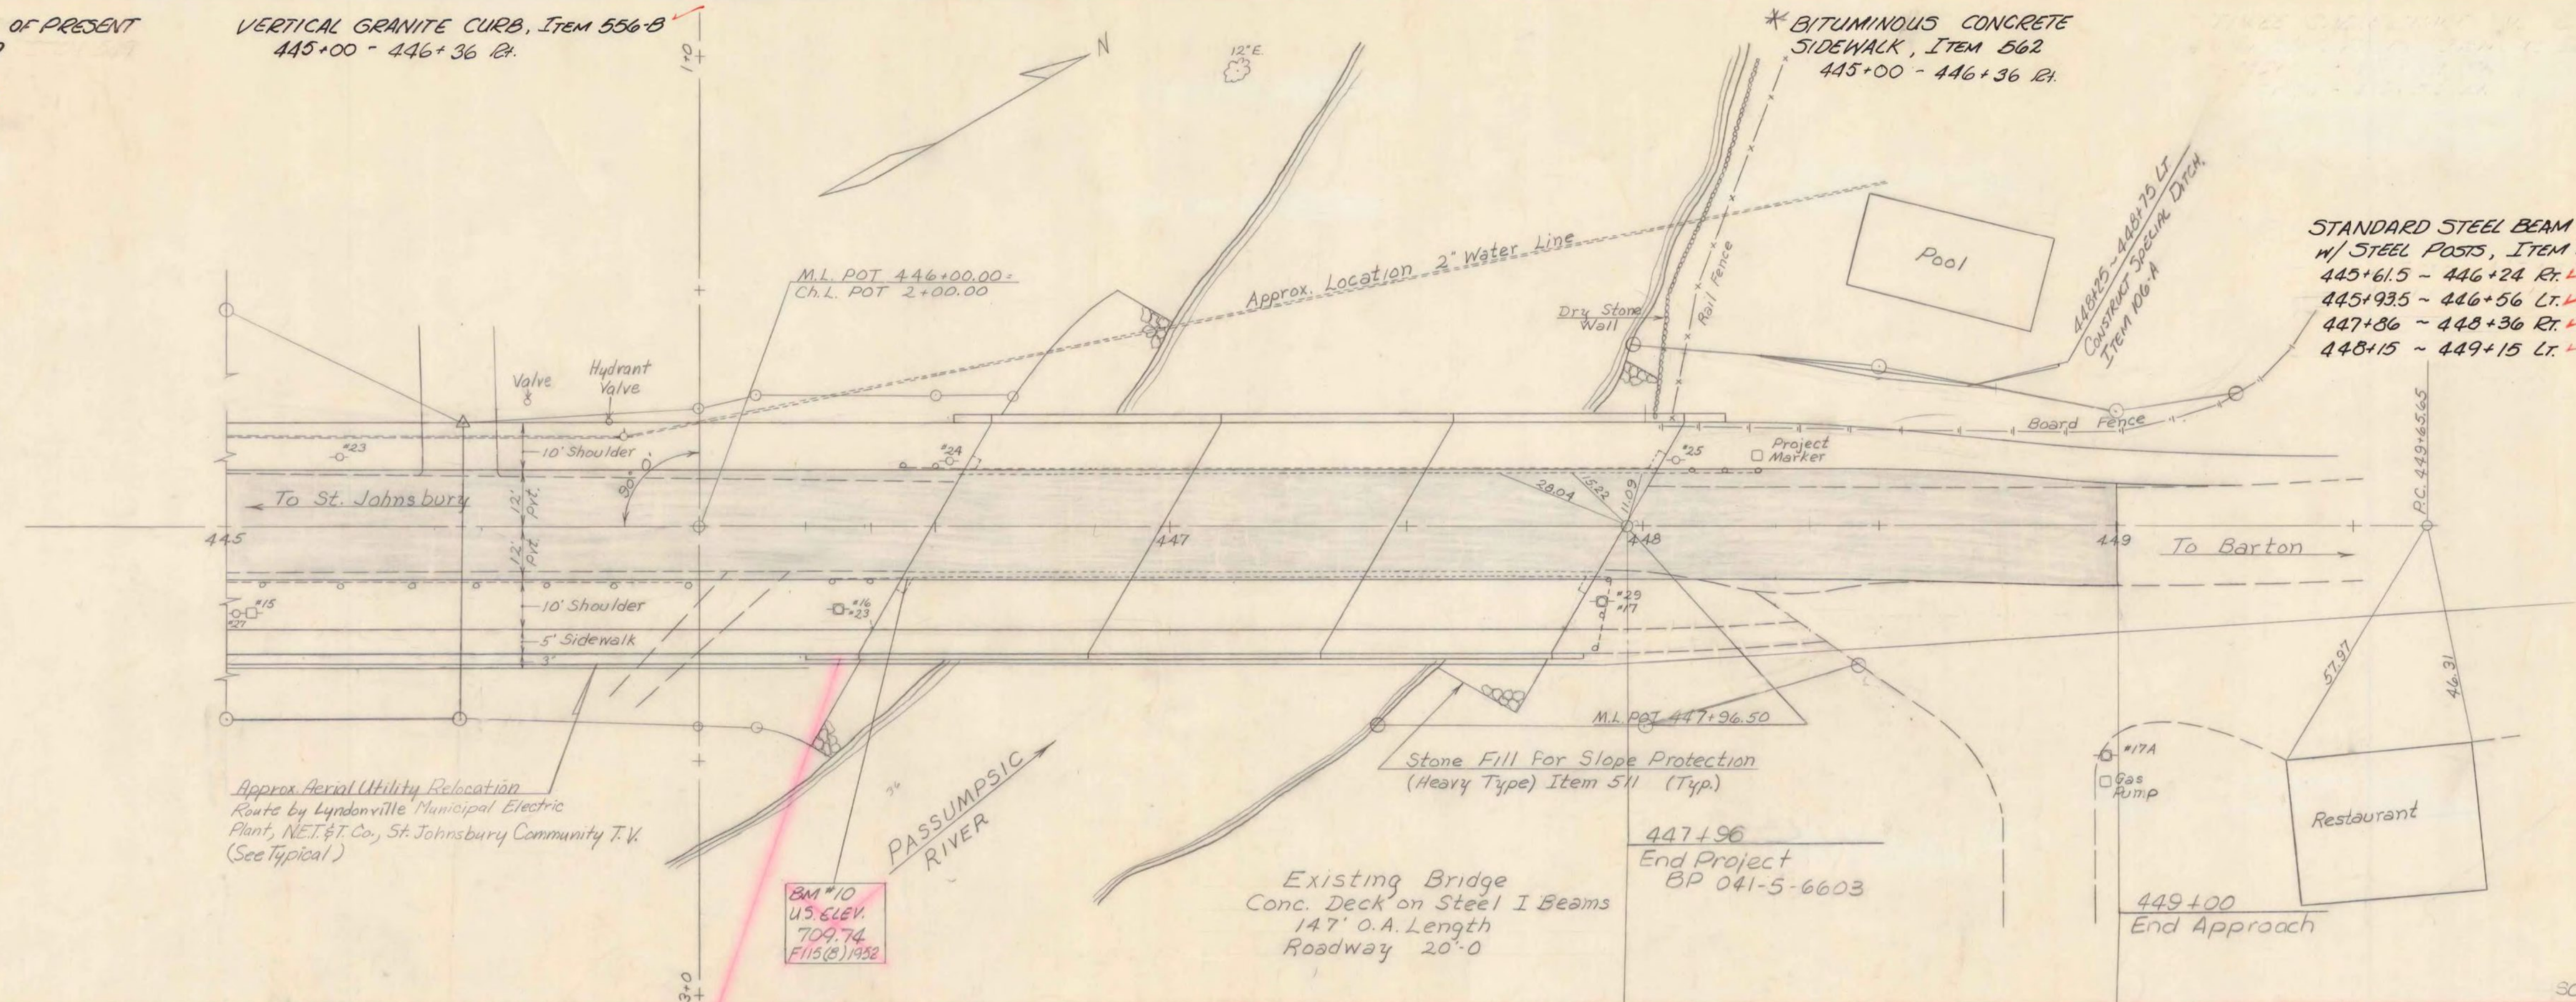

SCALE: 1" = 20'

LYNDON  
BF MEMB(39)

SHEET 13 OF 28  
BRIDGE 144  
FOR REFERENCE ONLY

LYNDON  
BP041-5-6603  
Plan & Profile  
445+00-445+50  
Sheet 4 of 50

PLAN  
DATE: 10/1/50  
DRAWN BY: [illegible]  
CHECKED BY: [illegible]  
SCALE: AS SHOWN

PROFILE  
DATE: 10/1/50  
DRAWN BY: [illegible]  
CHECKED BY: [illegible]  
SCALE: AS SHOWN