


# STATE OF VERMONT AGENCY OF TRANSPORTATION



## PROPOSED IMPROVEMENT BRIDGE PROJECT TOWN OF HIGHGATE COUNTY OF FRANKLIN

### VT ROUTE 78 (MAJOR COLLECTOR), BRIDGE #10

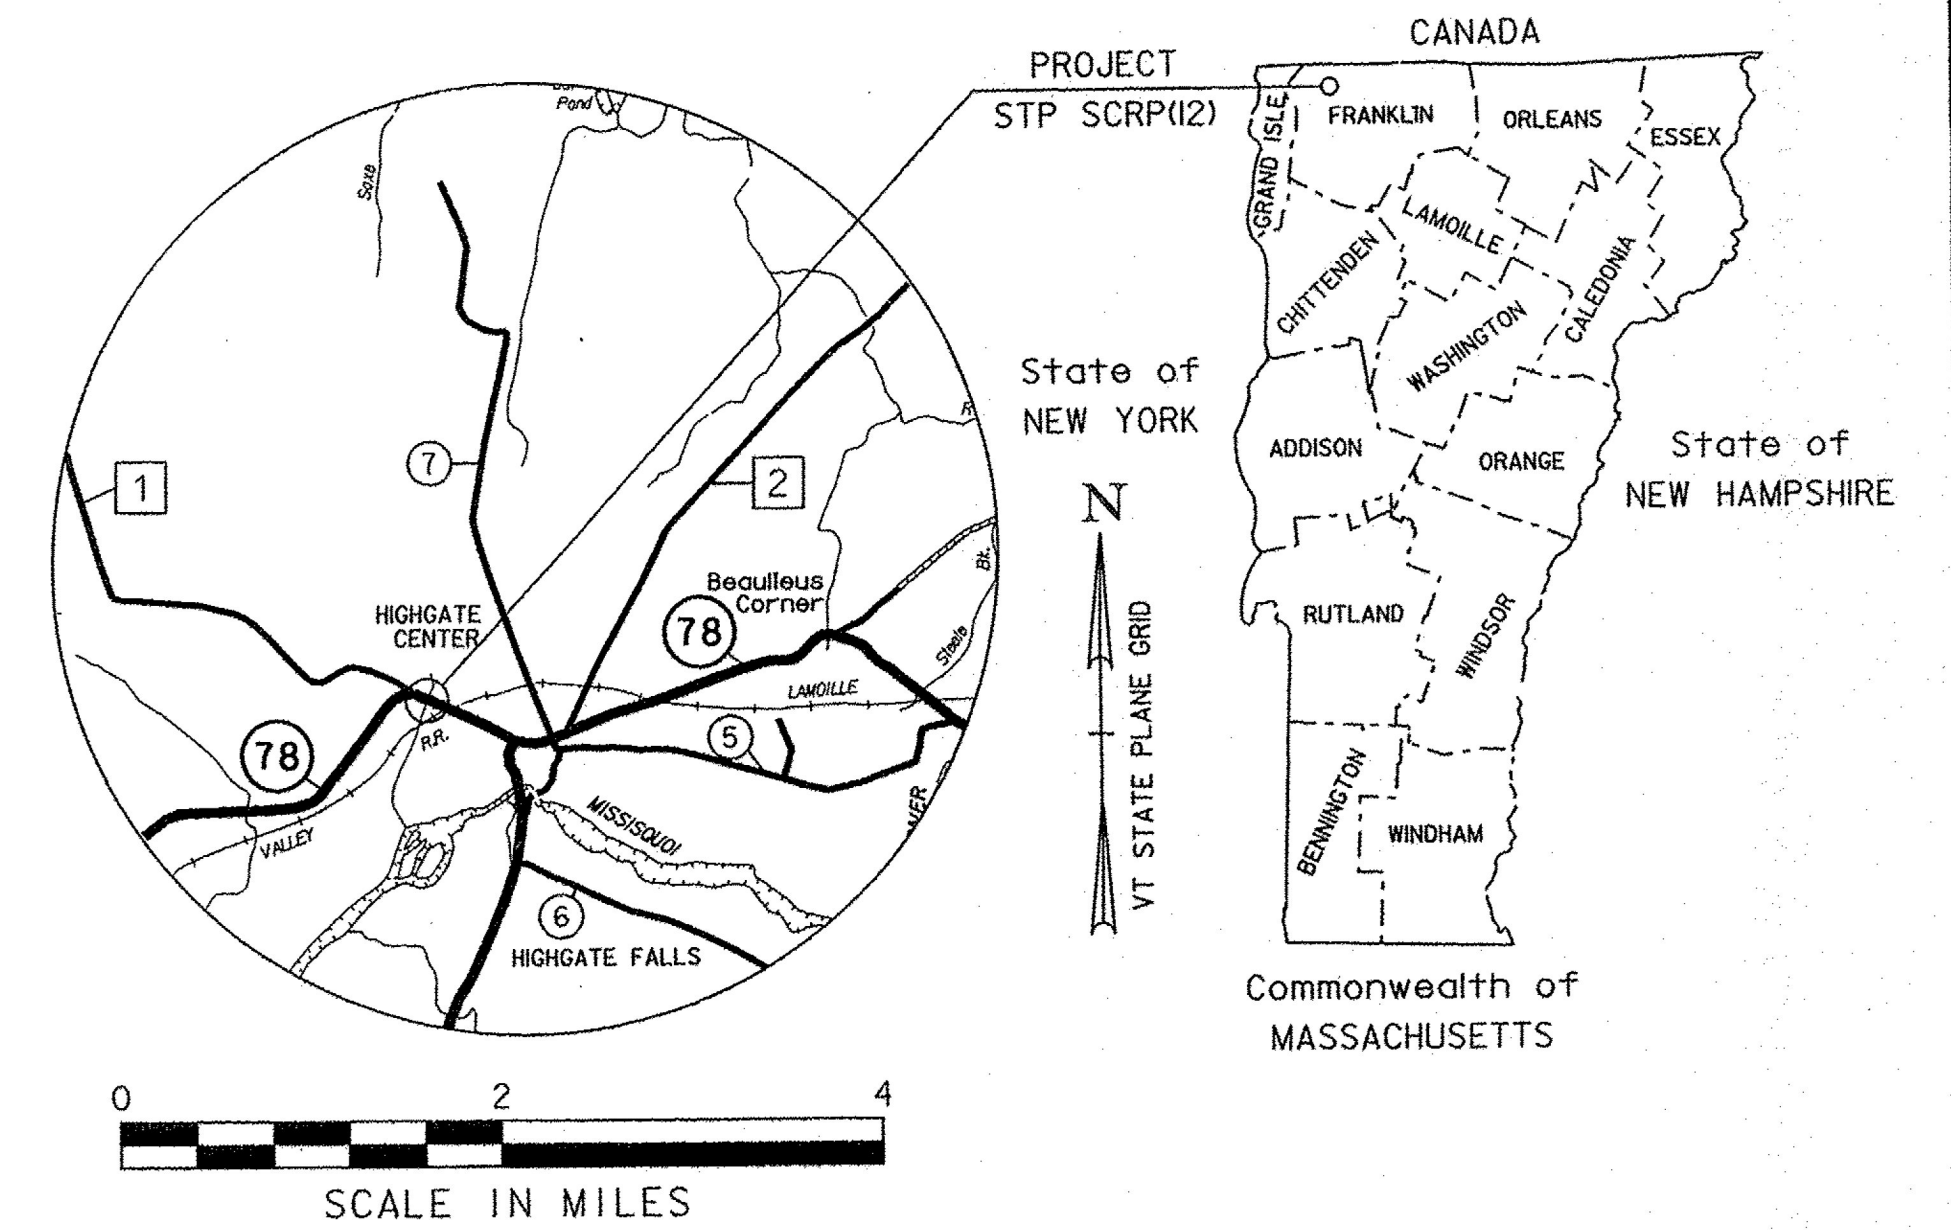


RECORD PLANS	
CONTRACTOR:	CASELLA CONSTRUCTION, INC. - MENDON, VT.
RESIDENT ENGINEER:	SCOTT WHEATLEY
CONSTRUCTION BEGAN:	APRIL 17, 2017
CONSTRUCTION COMPLETE:	APRIL 10, 2018
RECORD PLANS BY:	SCOTT WHEATLEY & JESSE IVES
I HEREBY CERTIFY THAT ALL THE CONSTRUCTION REQUIRED BY THIS SET OF DRAWINGS HAS BEEN ACCOMPLISHED AS INDICATED HEREIN.	
BY:	RESIDENT ENGINEER
DATE:	Nov. 1, 2018
NOTE: Any further information concerning final quantities, amounts or other details relative to this project may be found at Central Files in the electronic archives.	

BEGINNING IN THE TOWN OF HIGHGATE ON VT ROUTE 78 AT STATION 124+50.00 (MM 2.358)  
EXTENDING EASTERLY TO STATION 126+00.00 (MM 2.386)

LENGTH OF ROADWAY: 143.95 FEET = 0.027 MILES  
LENGTH OF BRIDGE: 6.05 FEET = 0.001 MILES  
LENGTH OF PROJECT: 150.00 FEET = 0.028 MILES

WORK TO BE PERFORMED UNDER THIS PROJECT INCLUDES INSTALLATION OF A NEW PIPE, HEADWALLS, WINGWALLS,  
SLOPE STABILIZATION, ABANDONMENT OF THE EXISTING BOX CULVERT AND OTHER HIGHWAY RELATED ITEMS.

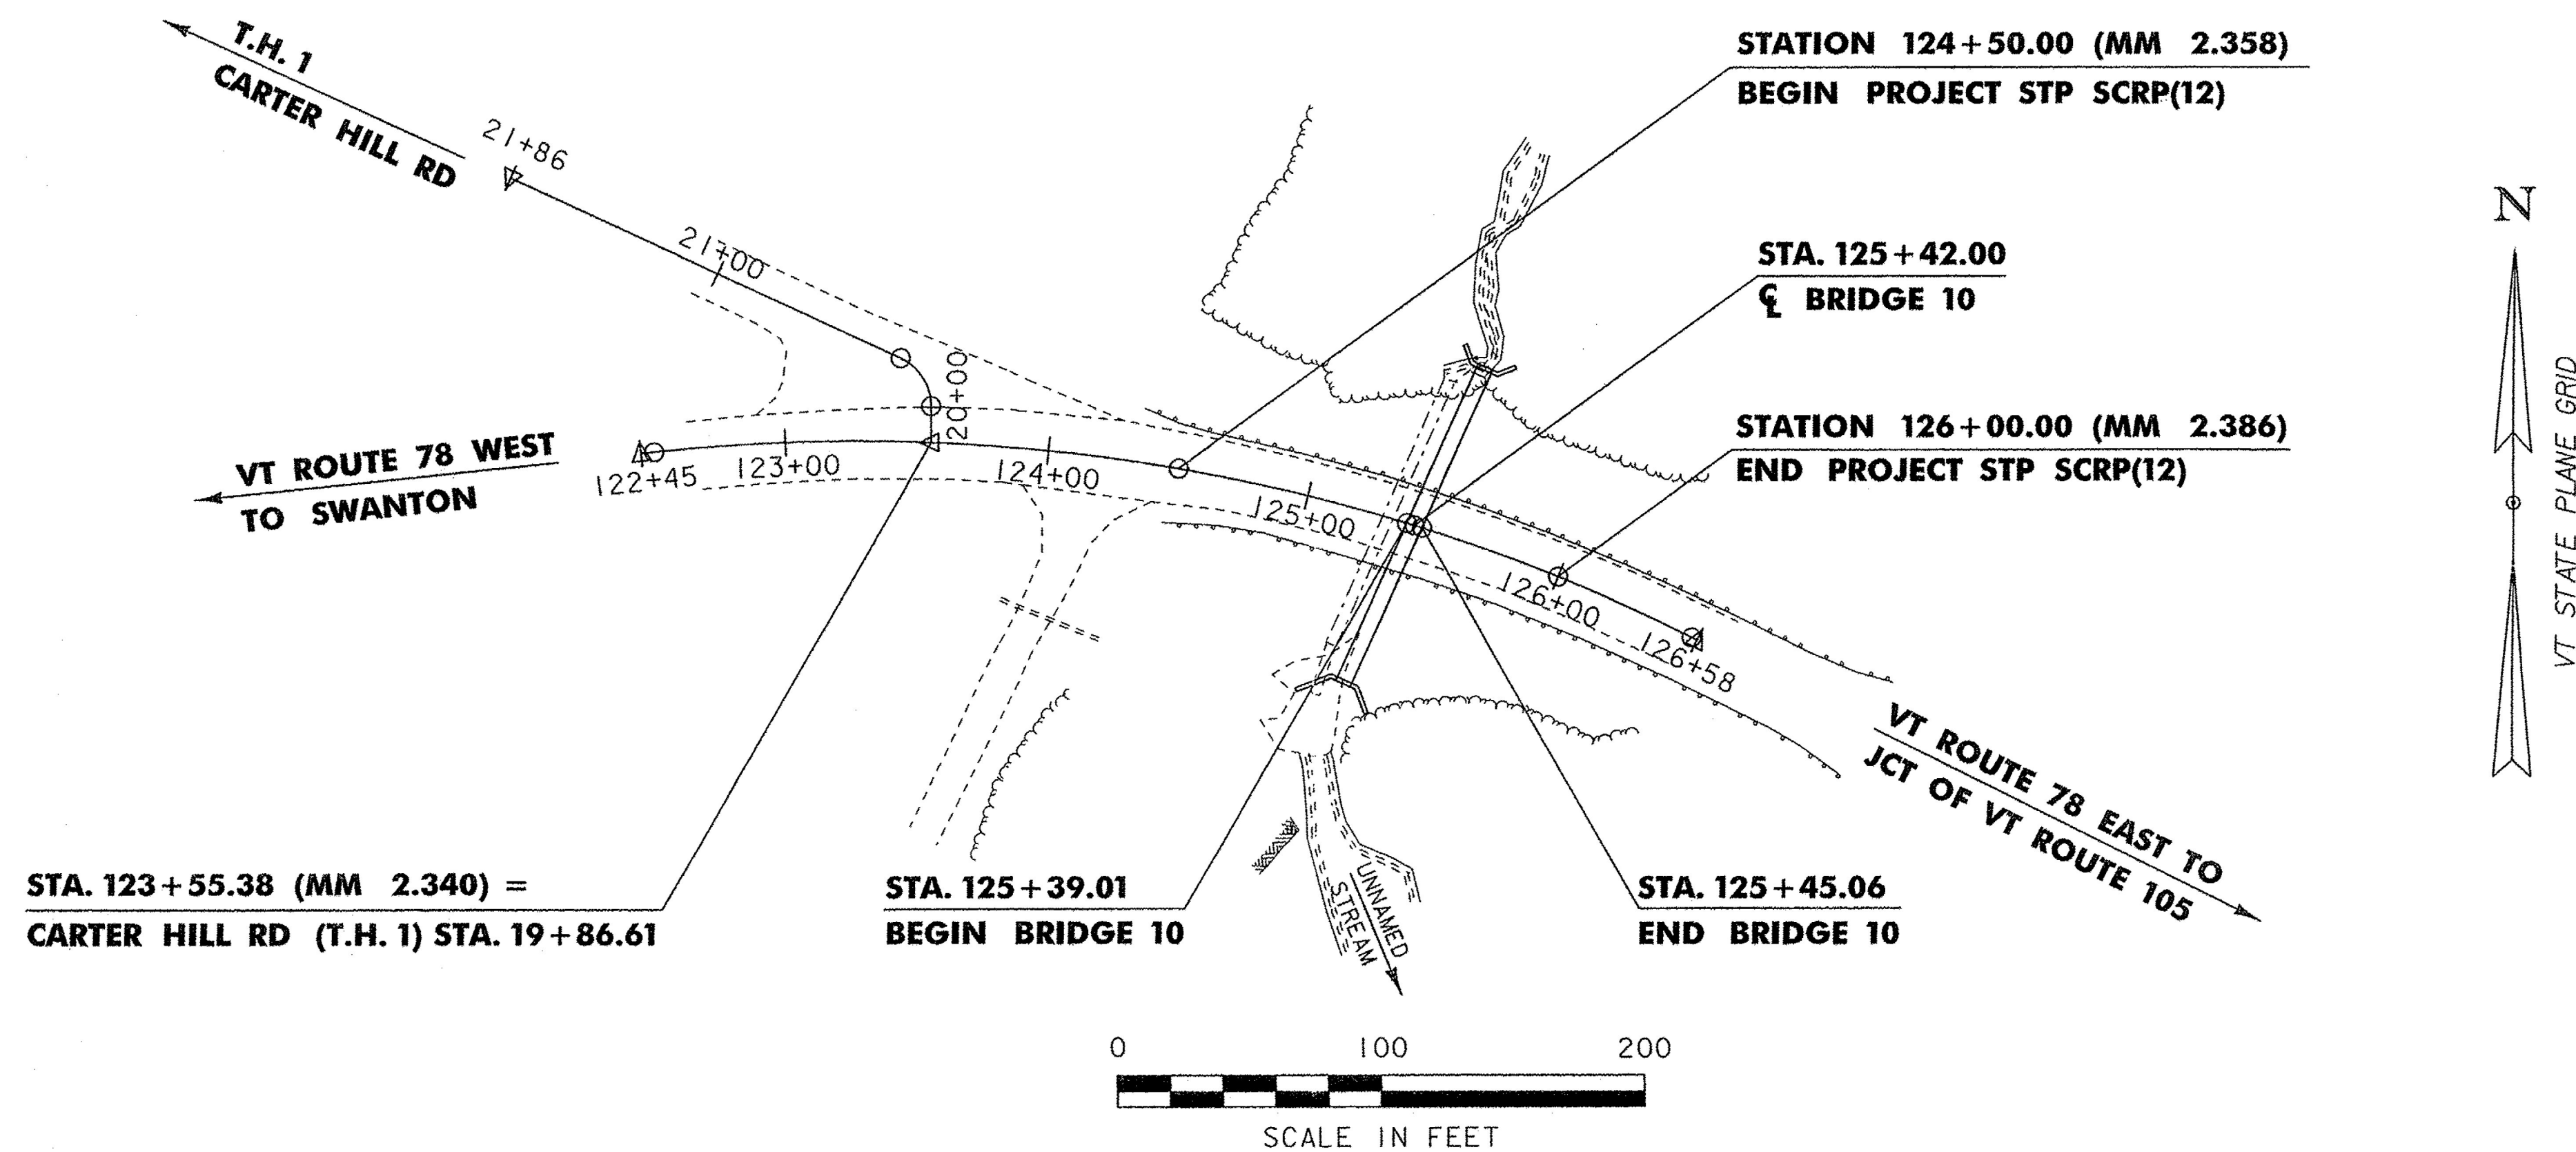

CONSTRUCTION IS TO BE CARRIED ON IN ACCORDANCE WITH THESE PLANS AND THE STANDARD SPECIFICATIONS FOR CONSTRUCTION DATED 2011, AS APPROVED BY THE FEDERAL HIGHWAY ADMINISTRATION ON JULY 20, 2011 FOR USE ON THIS PROJECT, INCLUDING ALL SUBSEQUENT REVISIONS AND SUCH REVISED SPECIFICATIONS AND SPECIAL PROVISIONS AS ARE INCORPORATED IN THESE PLANS.

QUALITY ASSURANCE PROGRAM : LEVEL 2	
SURVEYED BY :	VAOT - R. GILMAN
SURVEYED DATE :	09/11/2014
DATUM	
VERTICAL	NAVD 88
HORIZONTAL	NAD 83 (2011)

DIRECTOR OF PROJECT DELIVERY	
APPROVED:	DATE: 9/19/2016
PROJECT MANAGER : BRUCE MARTIN, P.E.	
PROJECT NAME :	HIGHGATE
PROJECT NUMBER :	STP SCR(12)
SHEET 1 OF 40 SHEETS	