


125+50

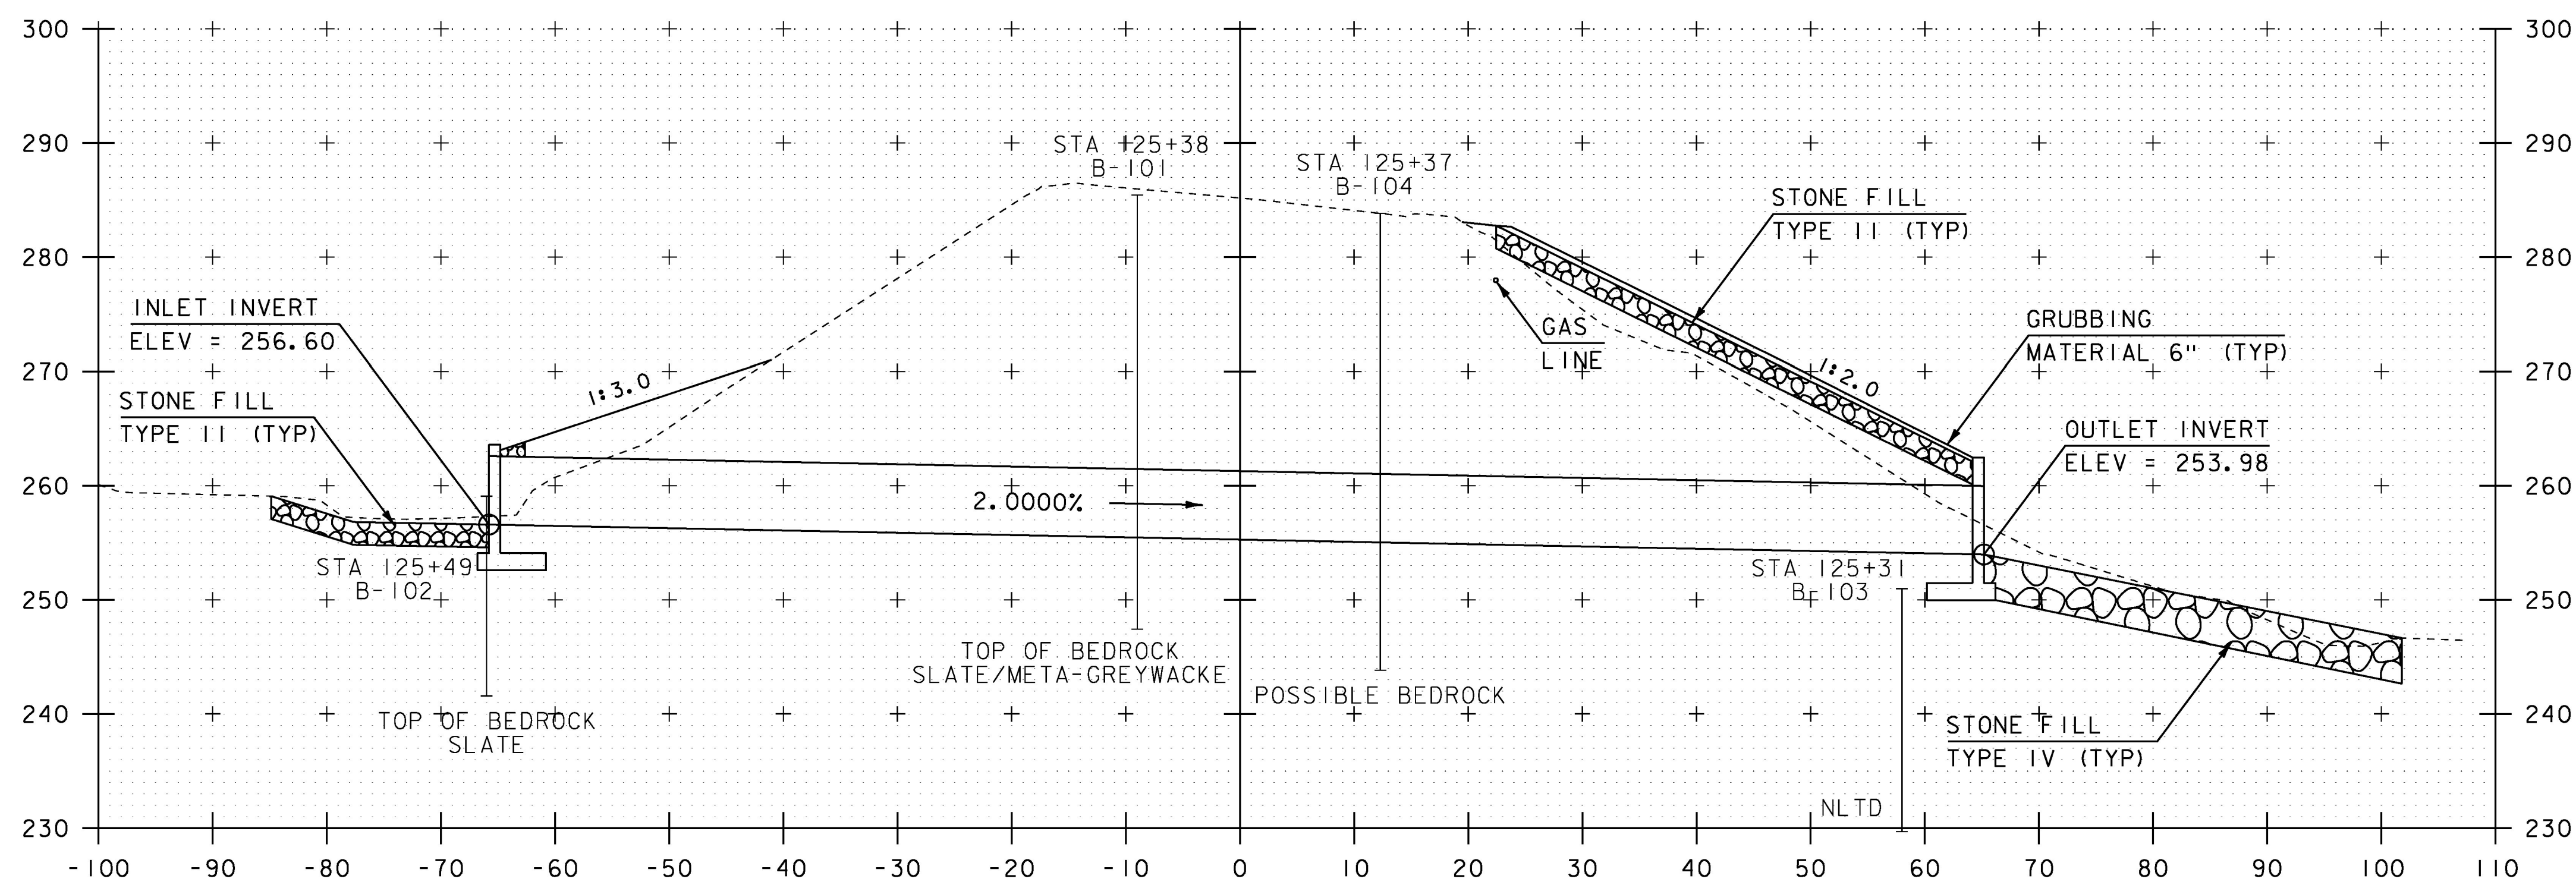

- NOTES:
- BORING LOCATIONS HAVE BEEN PROJECTED ON TO THE CROSS SECTION FROM THE STATION INDICATED ON THE BORING LOGS.
 - BORING LOCATIONS AND STRATA ELEVATIONS ARE APPROXIMATE.

125+42.00
 SKEWED 83°00'00" LT
 (BR 10)

SCALE IN FEET

STA. 125+42 TO STA. 125+50

PROJECT NAME:	HIGHGATE	PLOT DATE:	14-OCT-2016
PROJECT NUMBER:	STP SCRPI(2)	DRAWN BY:	A. KEMPTON
FILE NAME:	d13ci34xs.dgn	CHECKED BY:	M. GAMELIN
PROJECT LEADER:	B. MARTIN		
DESIGNED BY:	A. KEMPTON		
VT 78 CROSS SECTION SHEET 3			SHEET 27 OF 40