




0+50

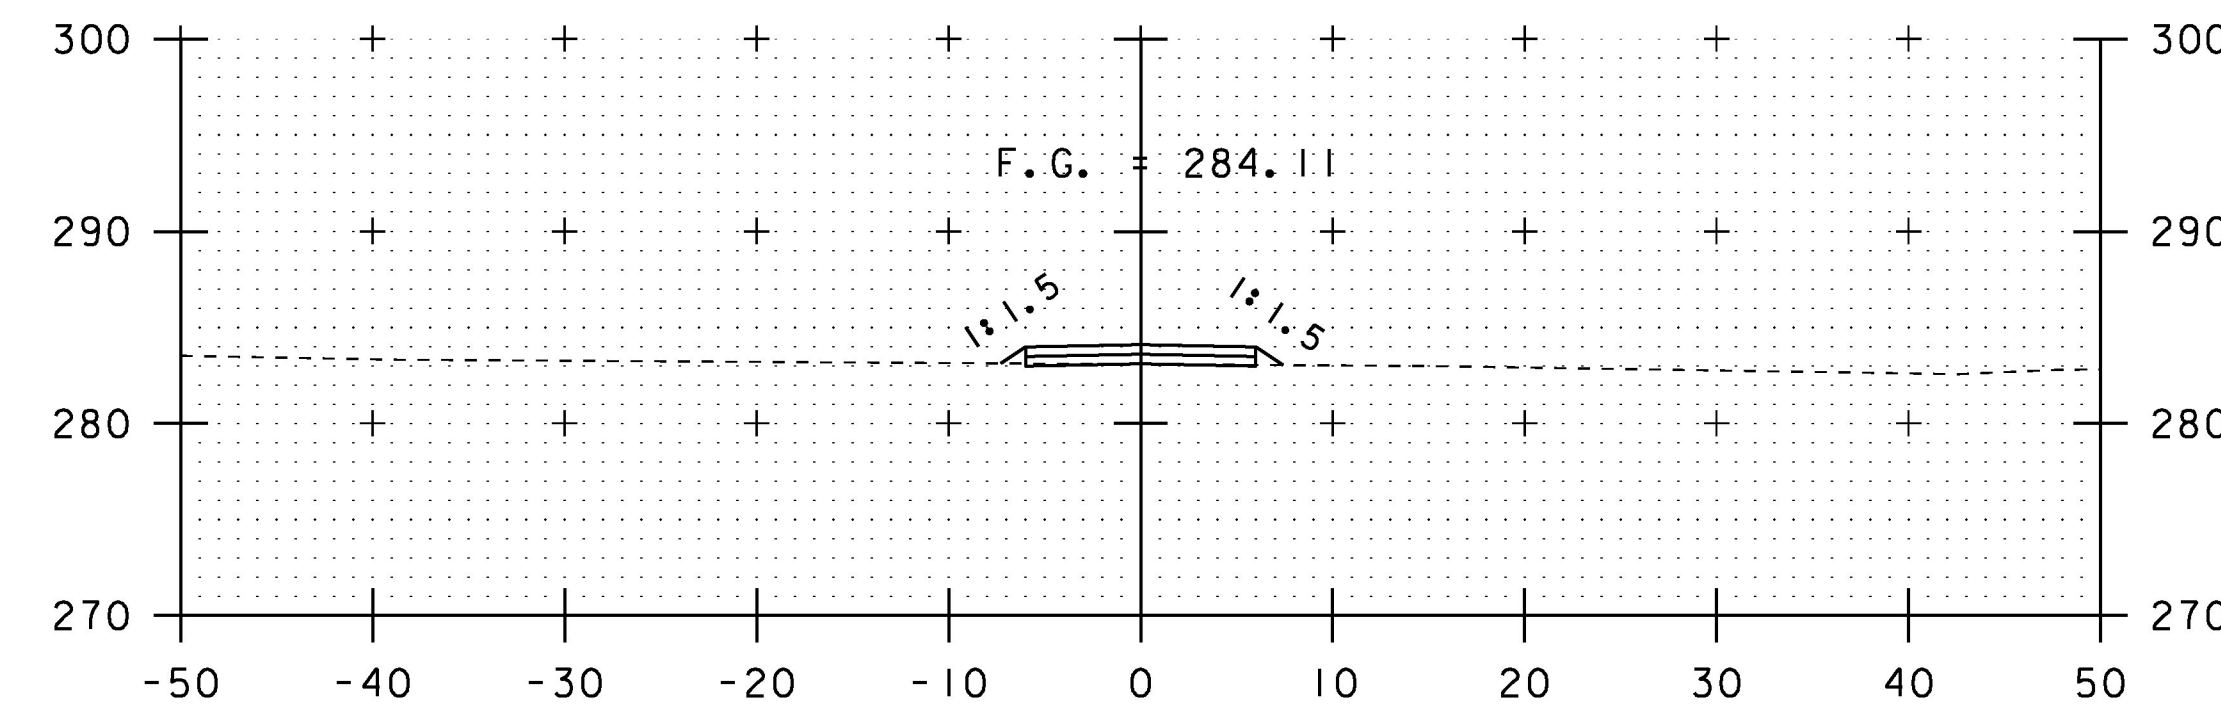


1+25

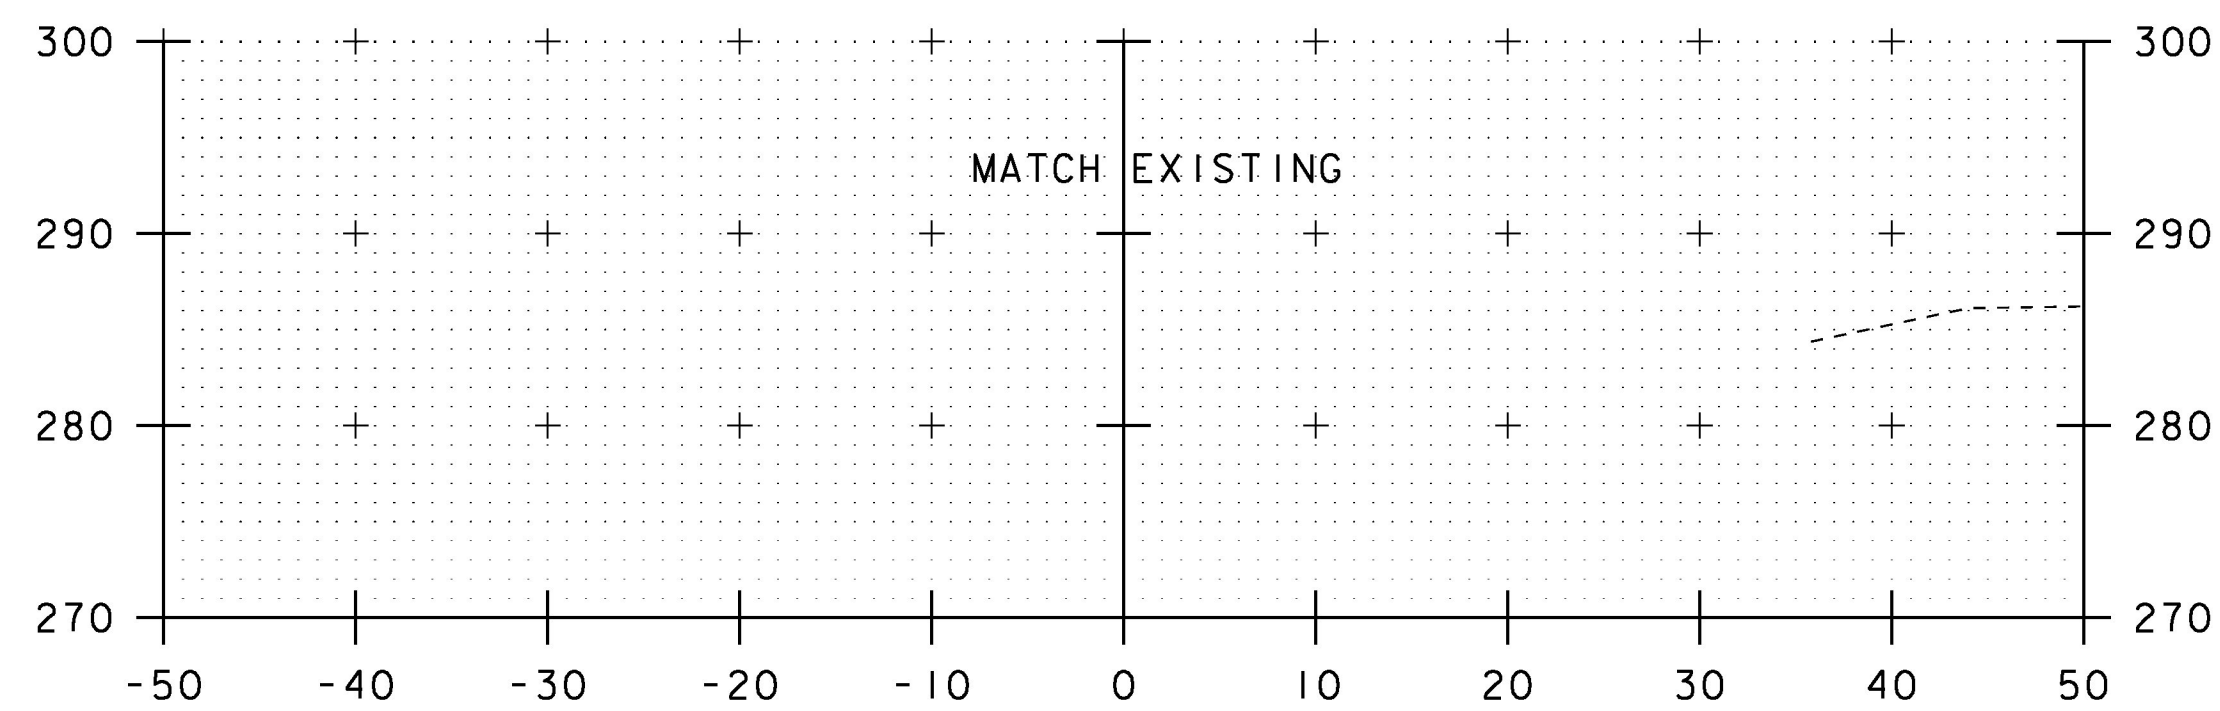


0+25

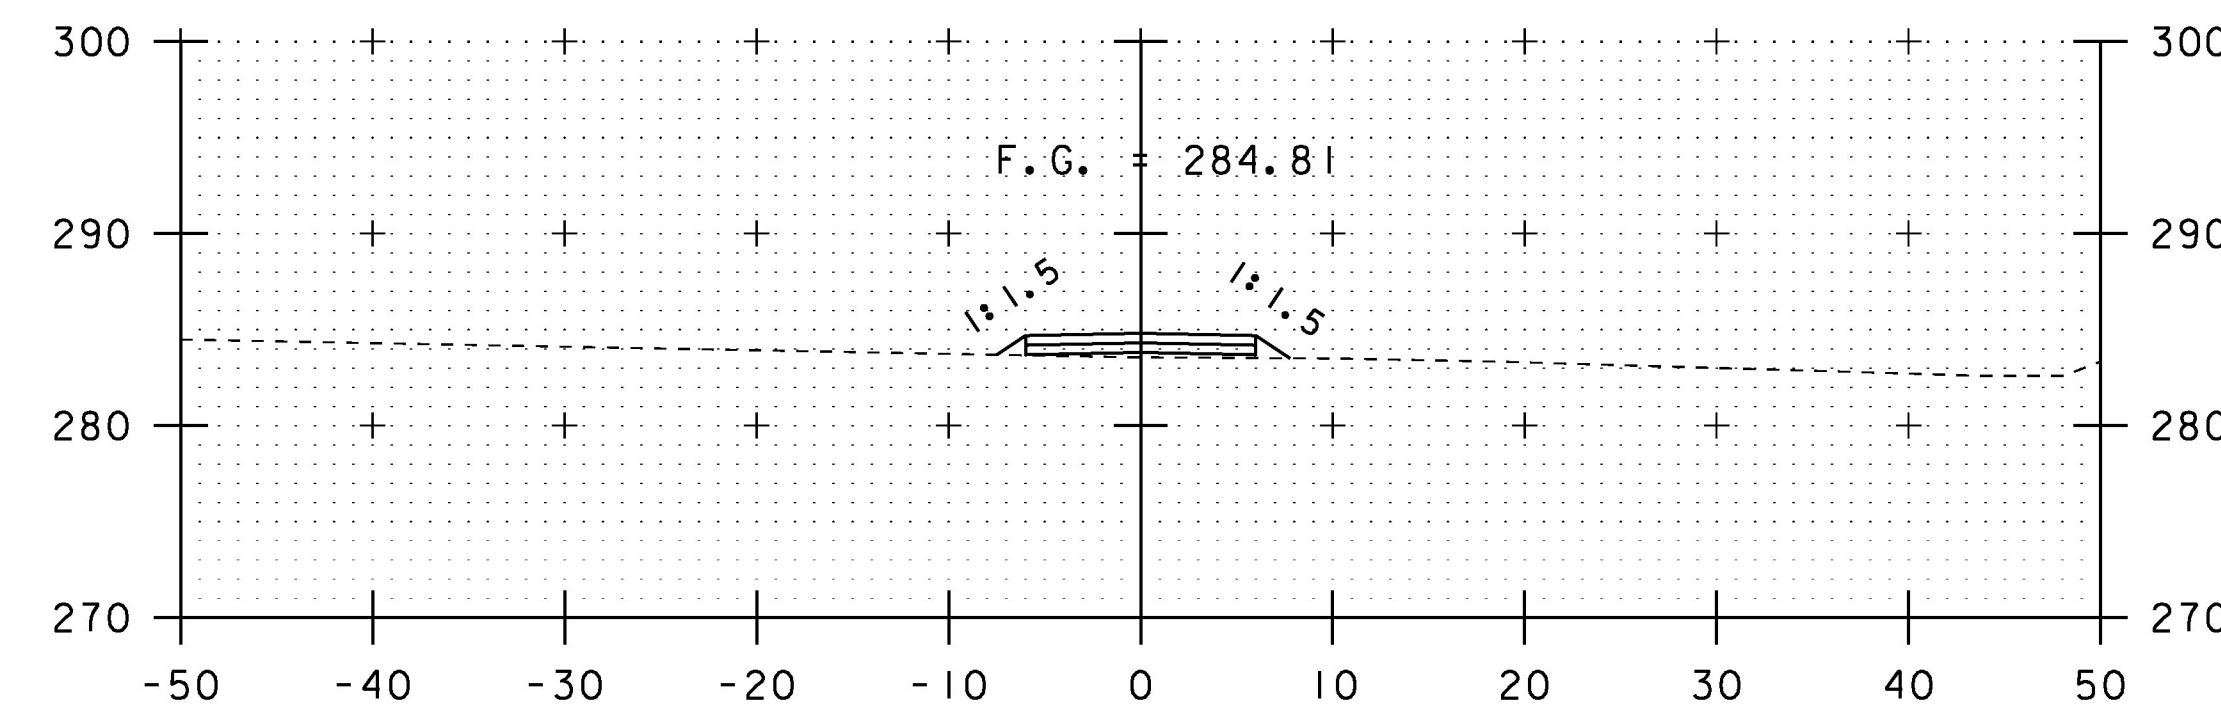

1+00

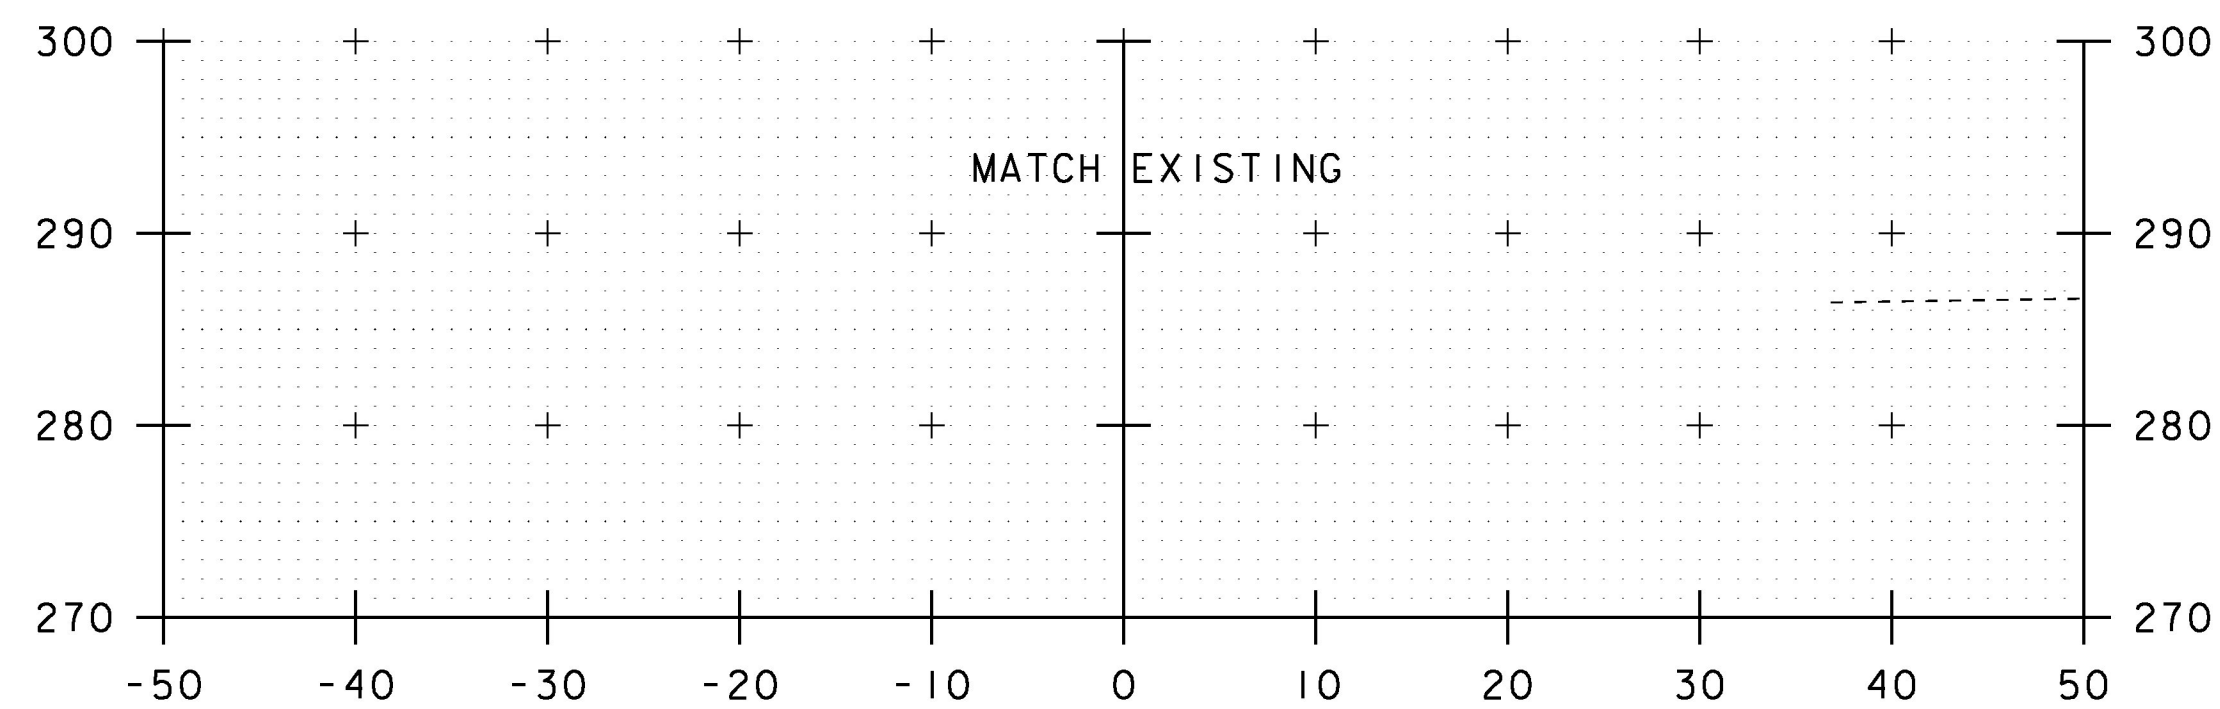

0+00  
BEGIN ACCESS ROAD

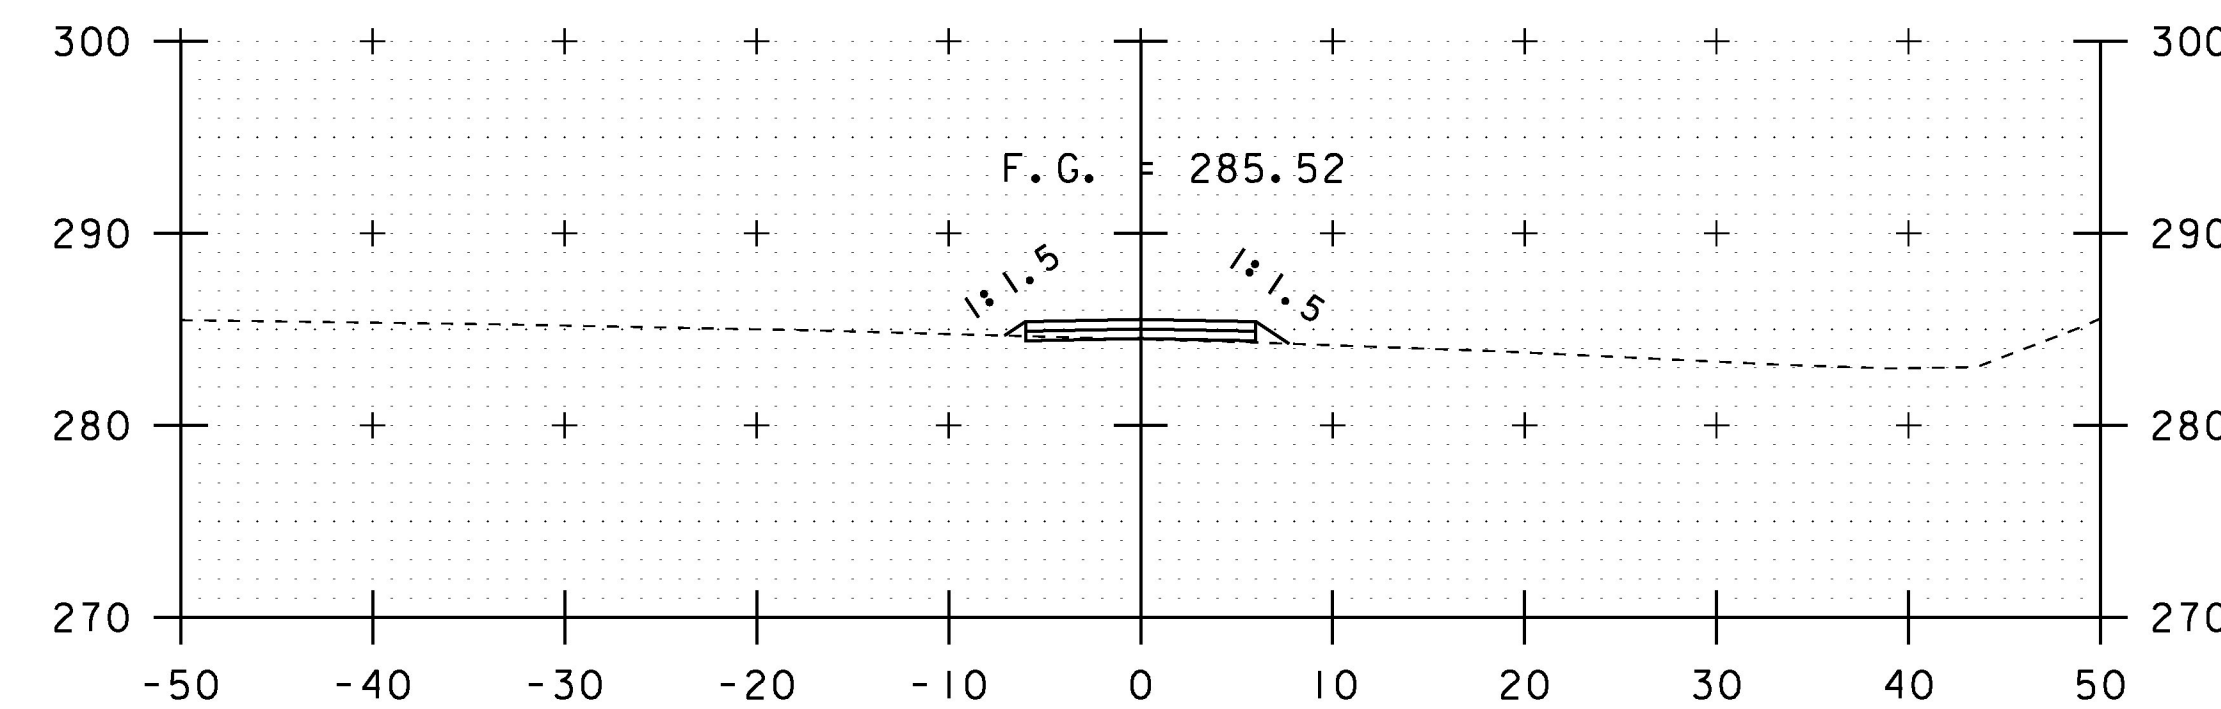

0+75

SCALE IN FEET

PROJECT NAME:	HIGHGATE
PROJECT NUMBER:	STP SCRPI(2)
FILE NAME:	d13ci34xs.dgn
PROJECT LEADER:	B. MARTIN
DESIGNED BY:	A. KEMPTON
NORTH ACCESS RD CROSS SECTION SHEET 1	SHEET 29 OF 40
PLOT DATE:	14-OCT-2016
DRAWN BY:	A. KEMPTON
CHECKED BY:	M. GAMELIN

STA. 0+00 TO STA. 1+25