






2+00

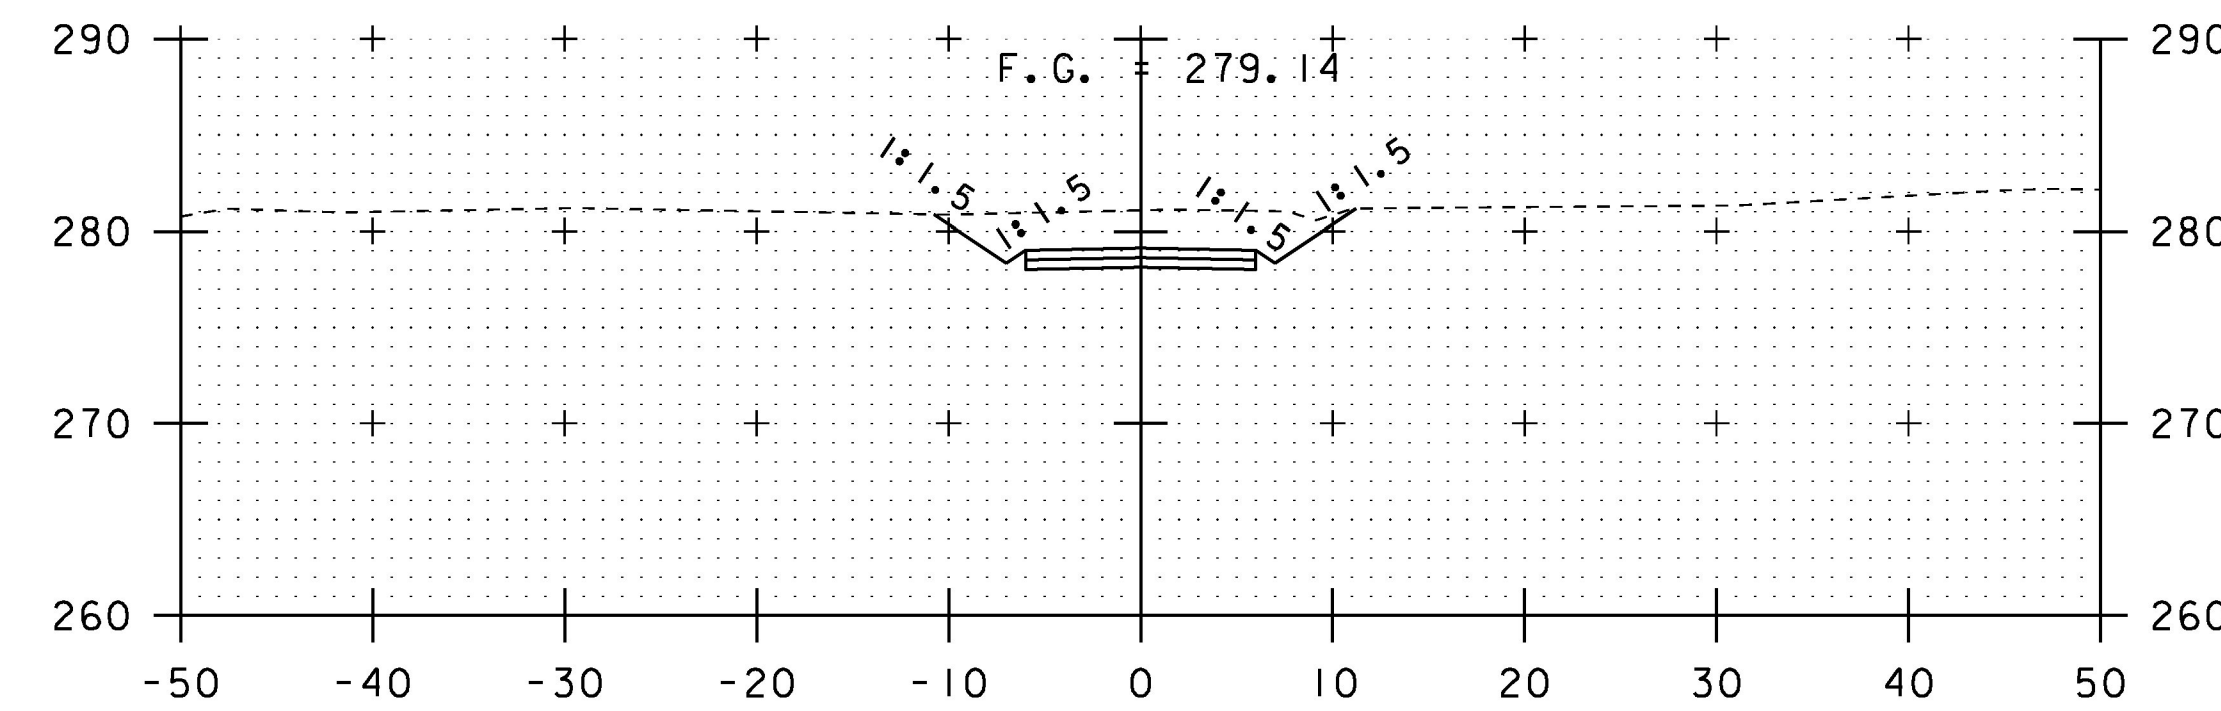


2+75

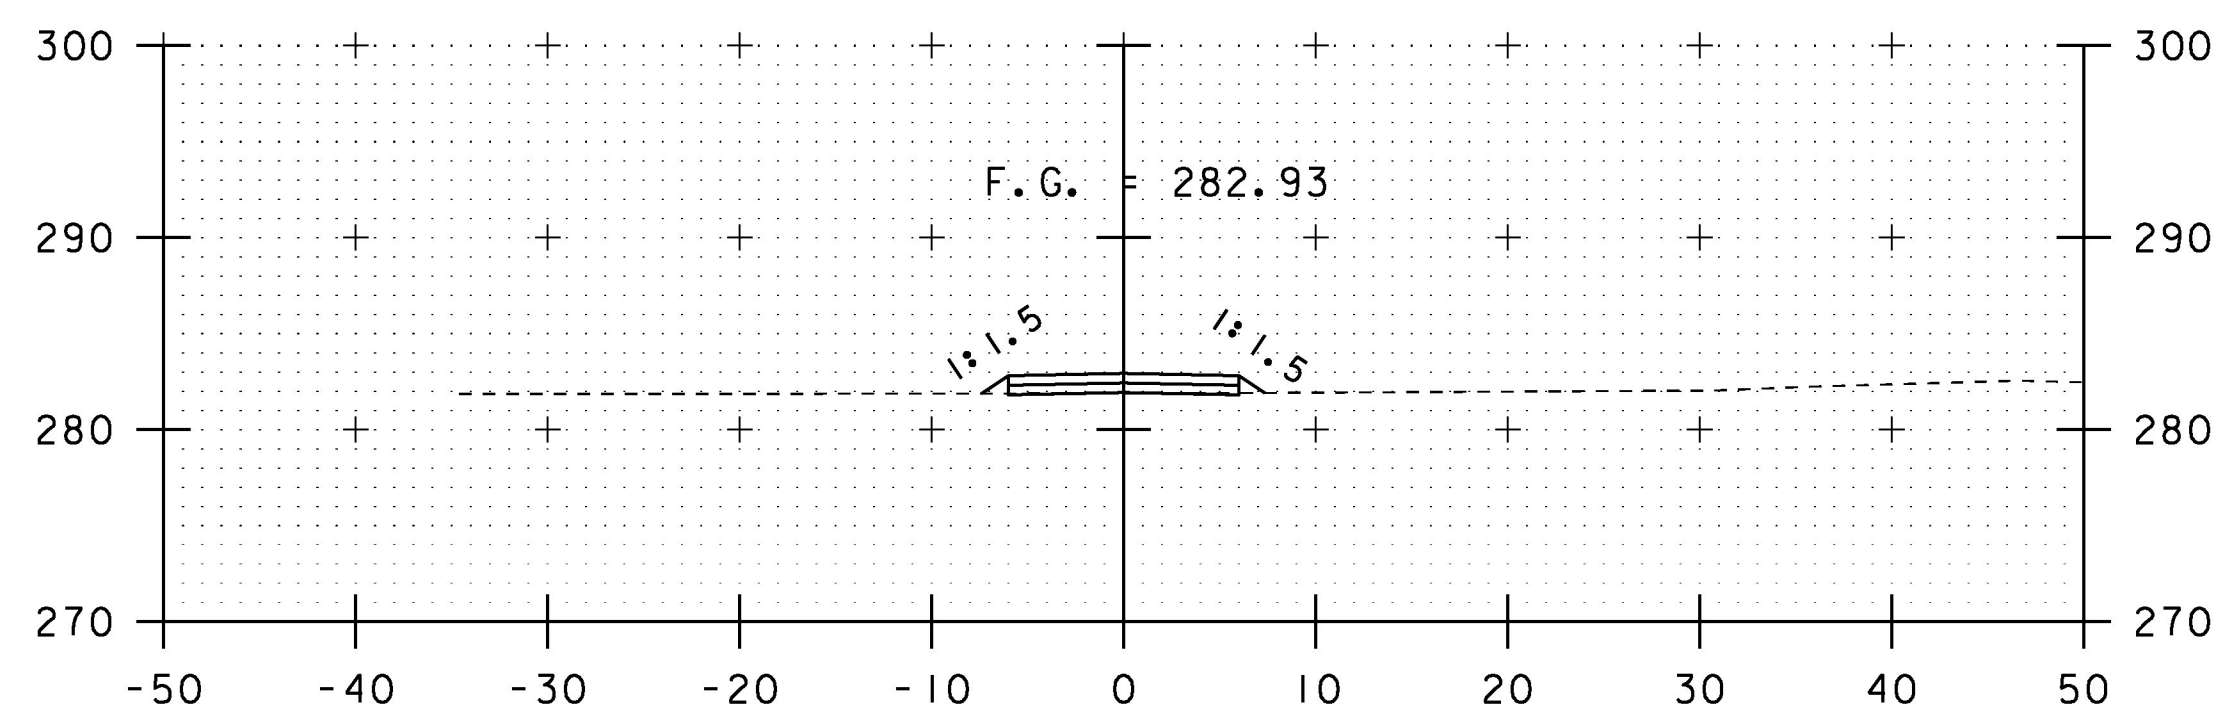


1+75

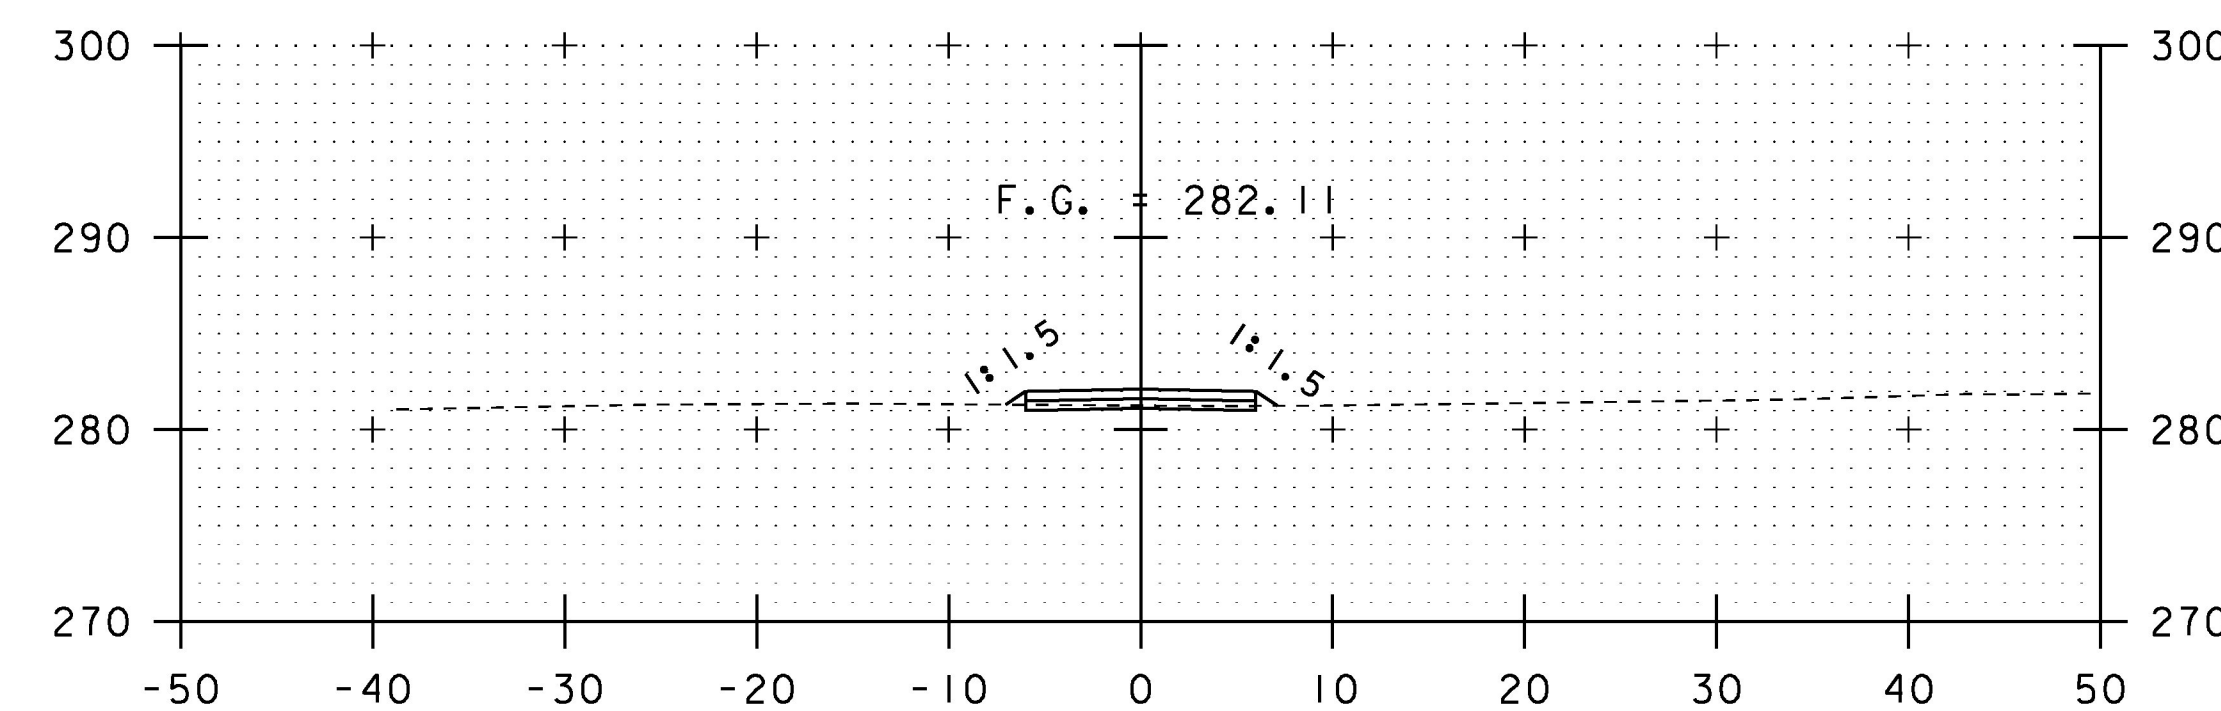

2+50

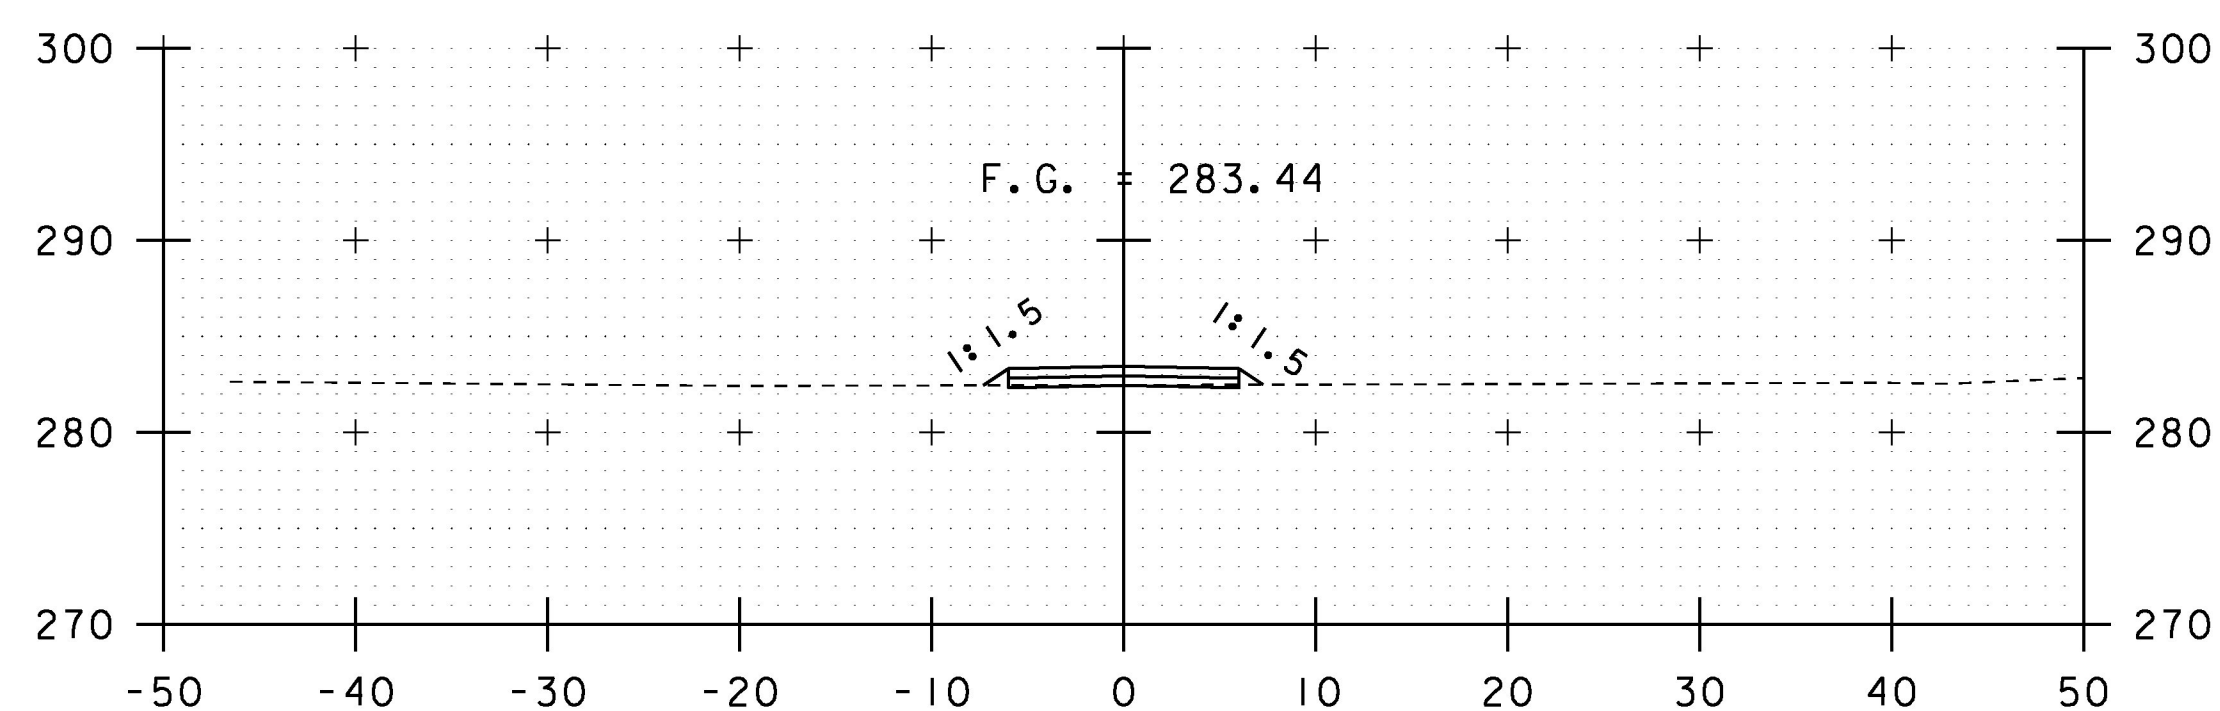

1+50

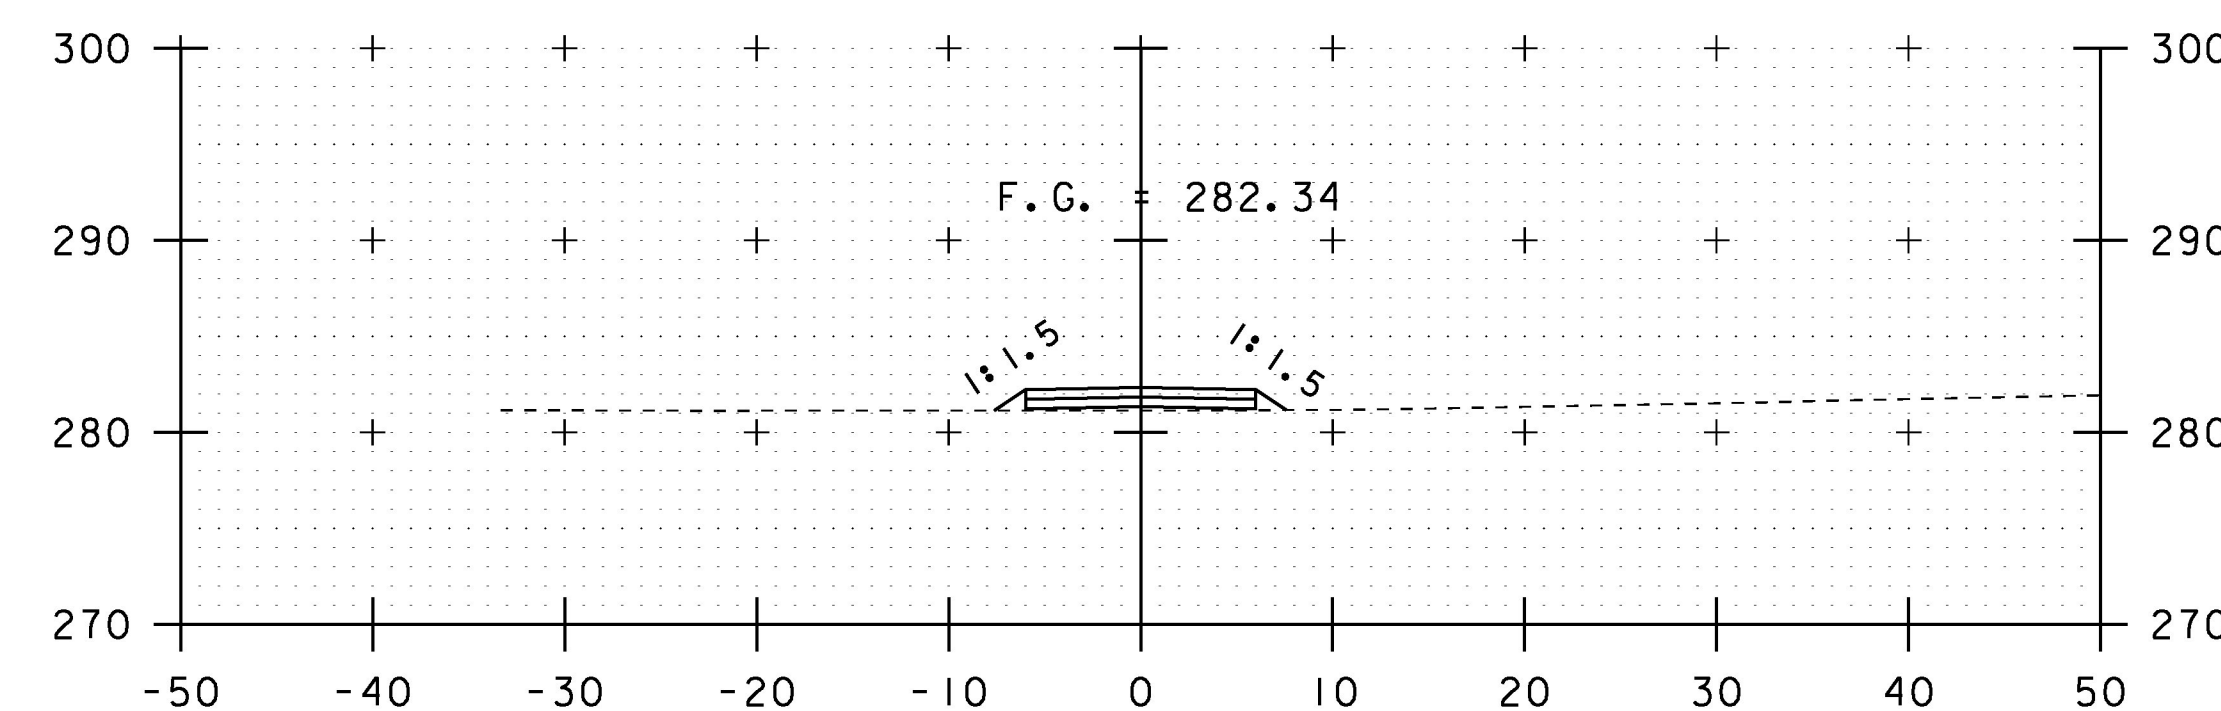

2+25

SCALE IN FEET

PROJECT NAME:	HIGHGATE
PROJECT NUMBER:	STP SCRPI(2)
FILE NAME:	d13ci34xs.dgn
PROJECT LEADER:	B. MARTIN
DESIGNED BY:	A. KEMPTON
NORTH ACCESS RD CROSS SECTION SHEET 2	SHEET 30 OF 40
PLOT DATE:	14-OCT-2016
DRAWN BY:	A. KEMPTON
CHECKED BY:	M. GAMELIN

STA. 1+50 TO STA. 2+75