



3+43
END ACCESS ROAD

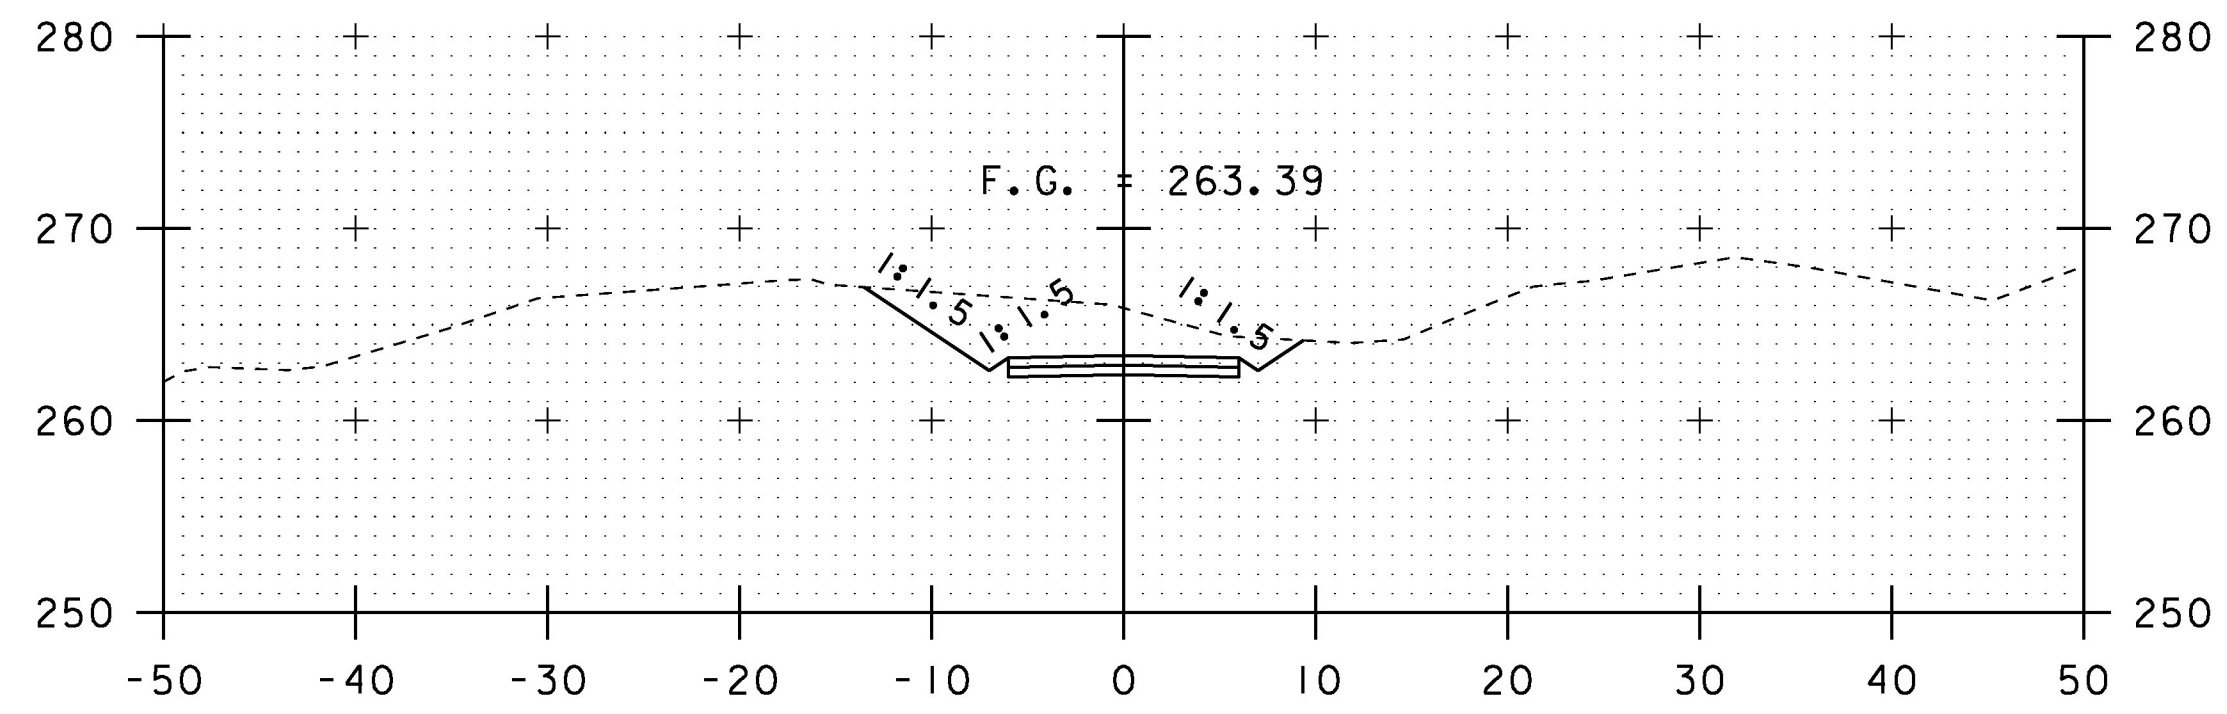

3+25

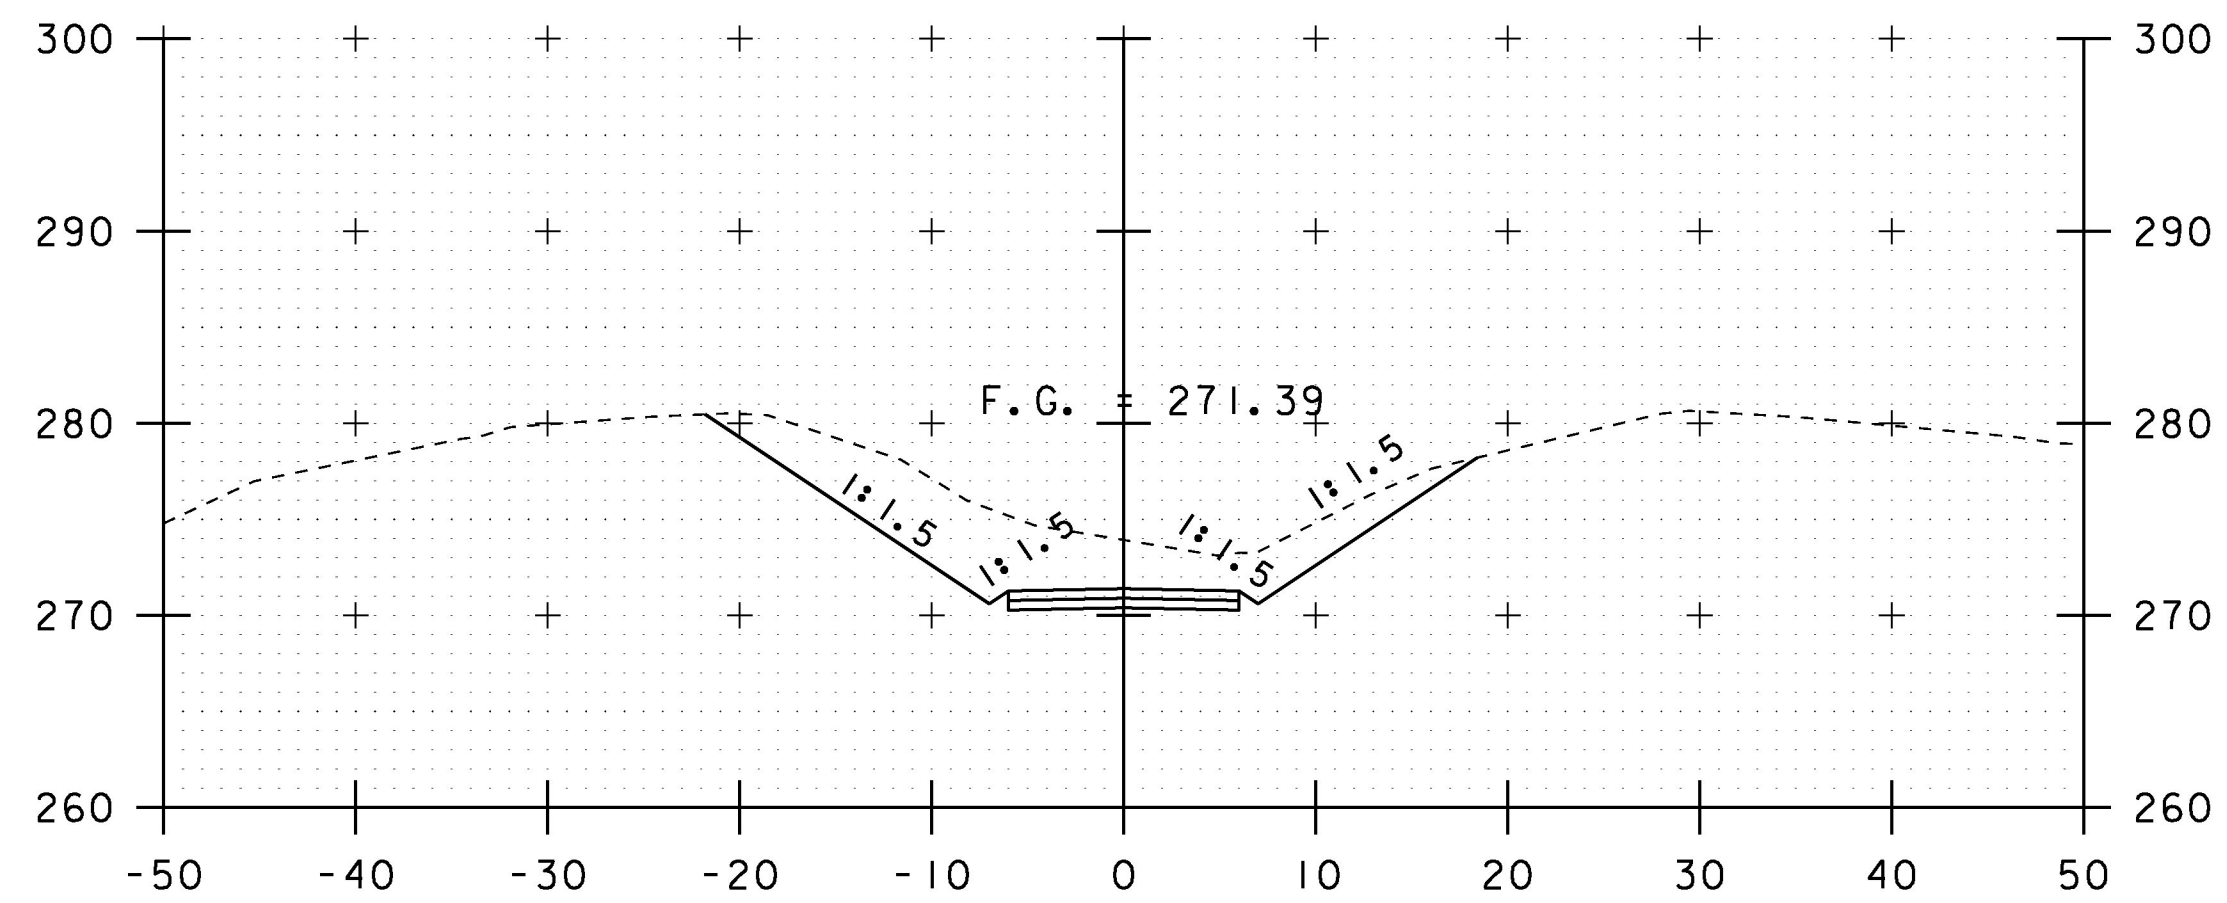

3+00

SCALE IN FEET

| | |
|---------------------------------------|----------------|
| PROJECT NAME: | HIGHGATE |
| PROJECT NUMBER: | STP_SCRP(12) |
| FILE NAME: | d13ci34xs.dgn |
| PROJECT LEADER: | B. MARTIN |
| DESIGNED BY: | A. KEMPTON |
| NORTH ACCESS RD CROSS SECTION SHEET 3 | SHEET 31 OF 40 |
| PLOT DATE: | 14-OCT-2016 |
| DRAWN BY: | A. KEMPTON |
| CHECKED BY: | M. GAMELIN |

STA. 3+00 TO STA. 3+43