




I+25

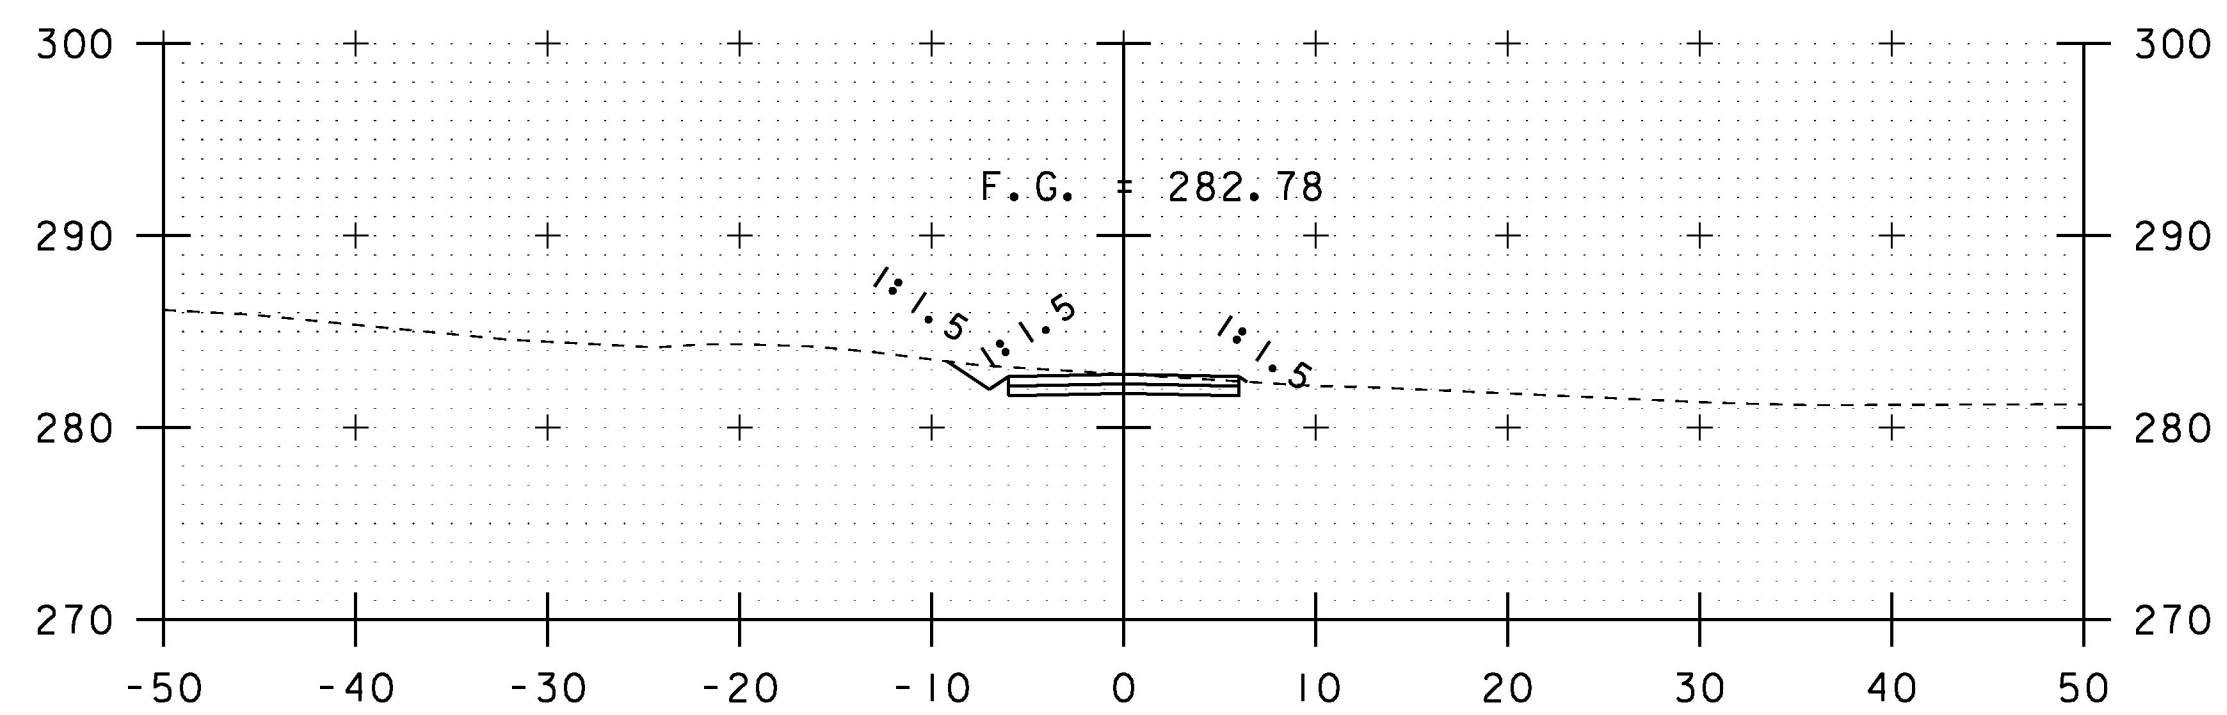


I+06
BEGIN ACCESS ROAD

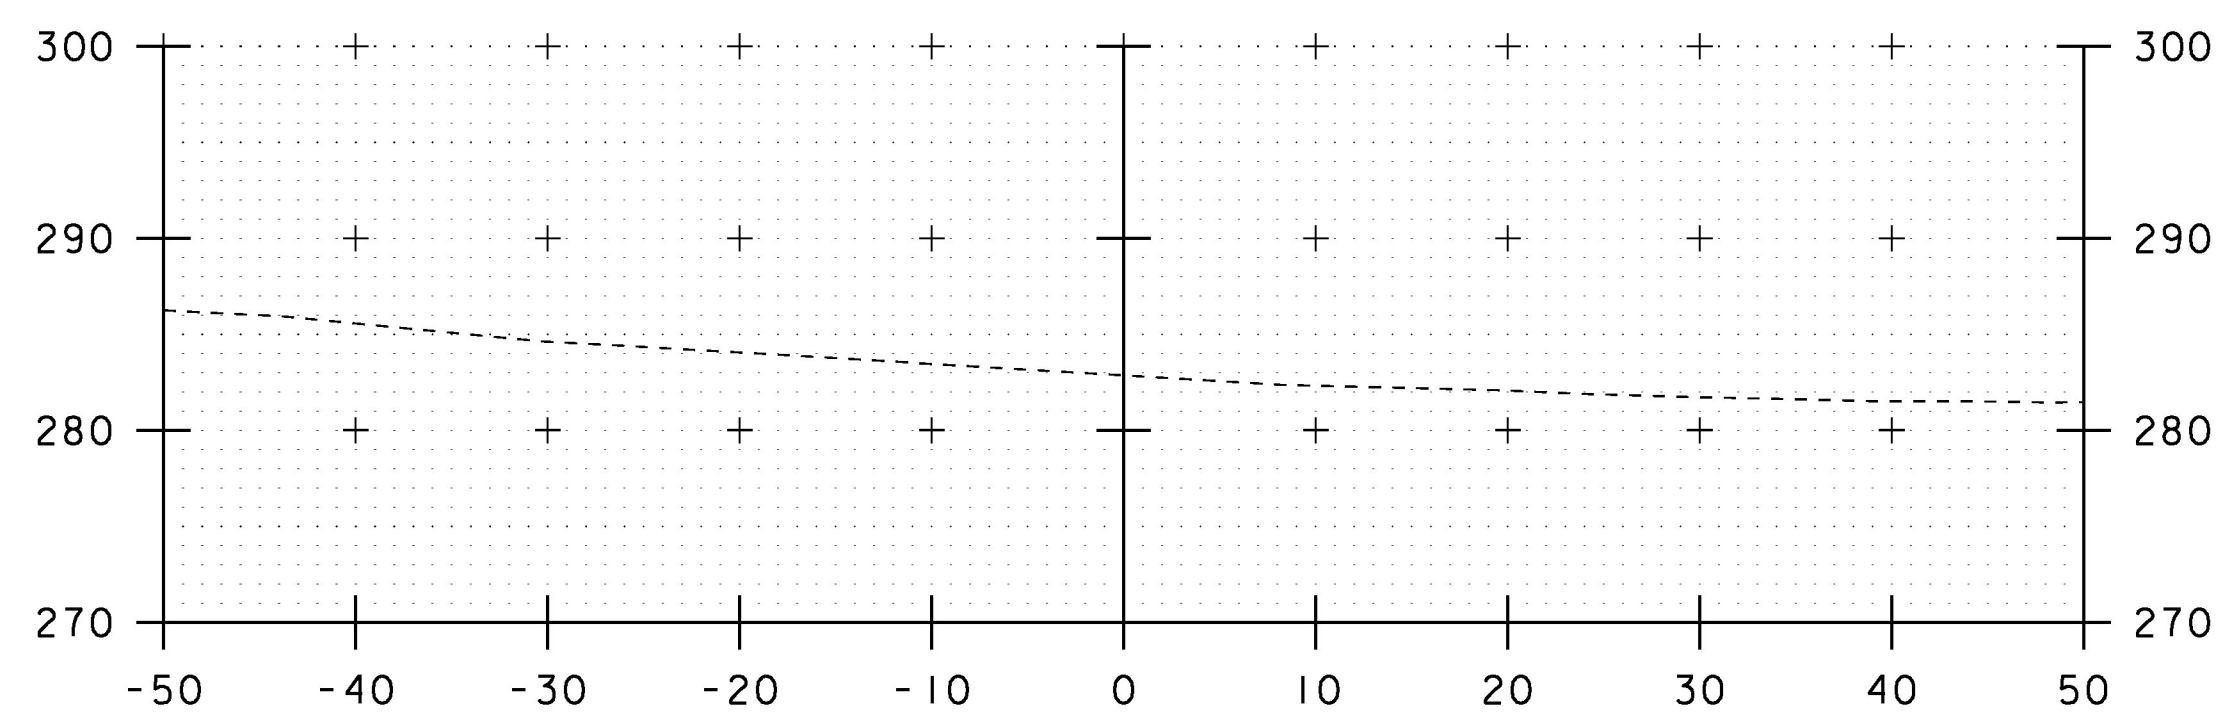

I+00

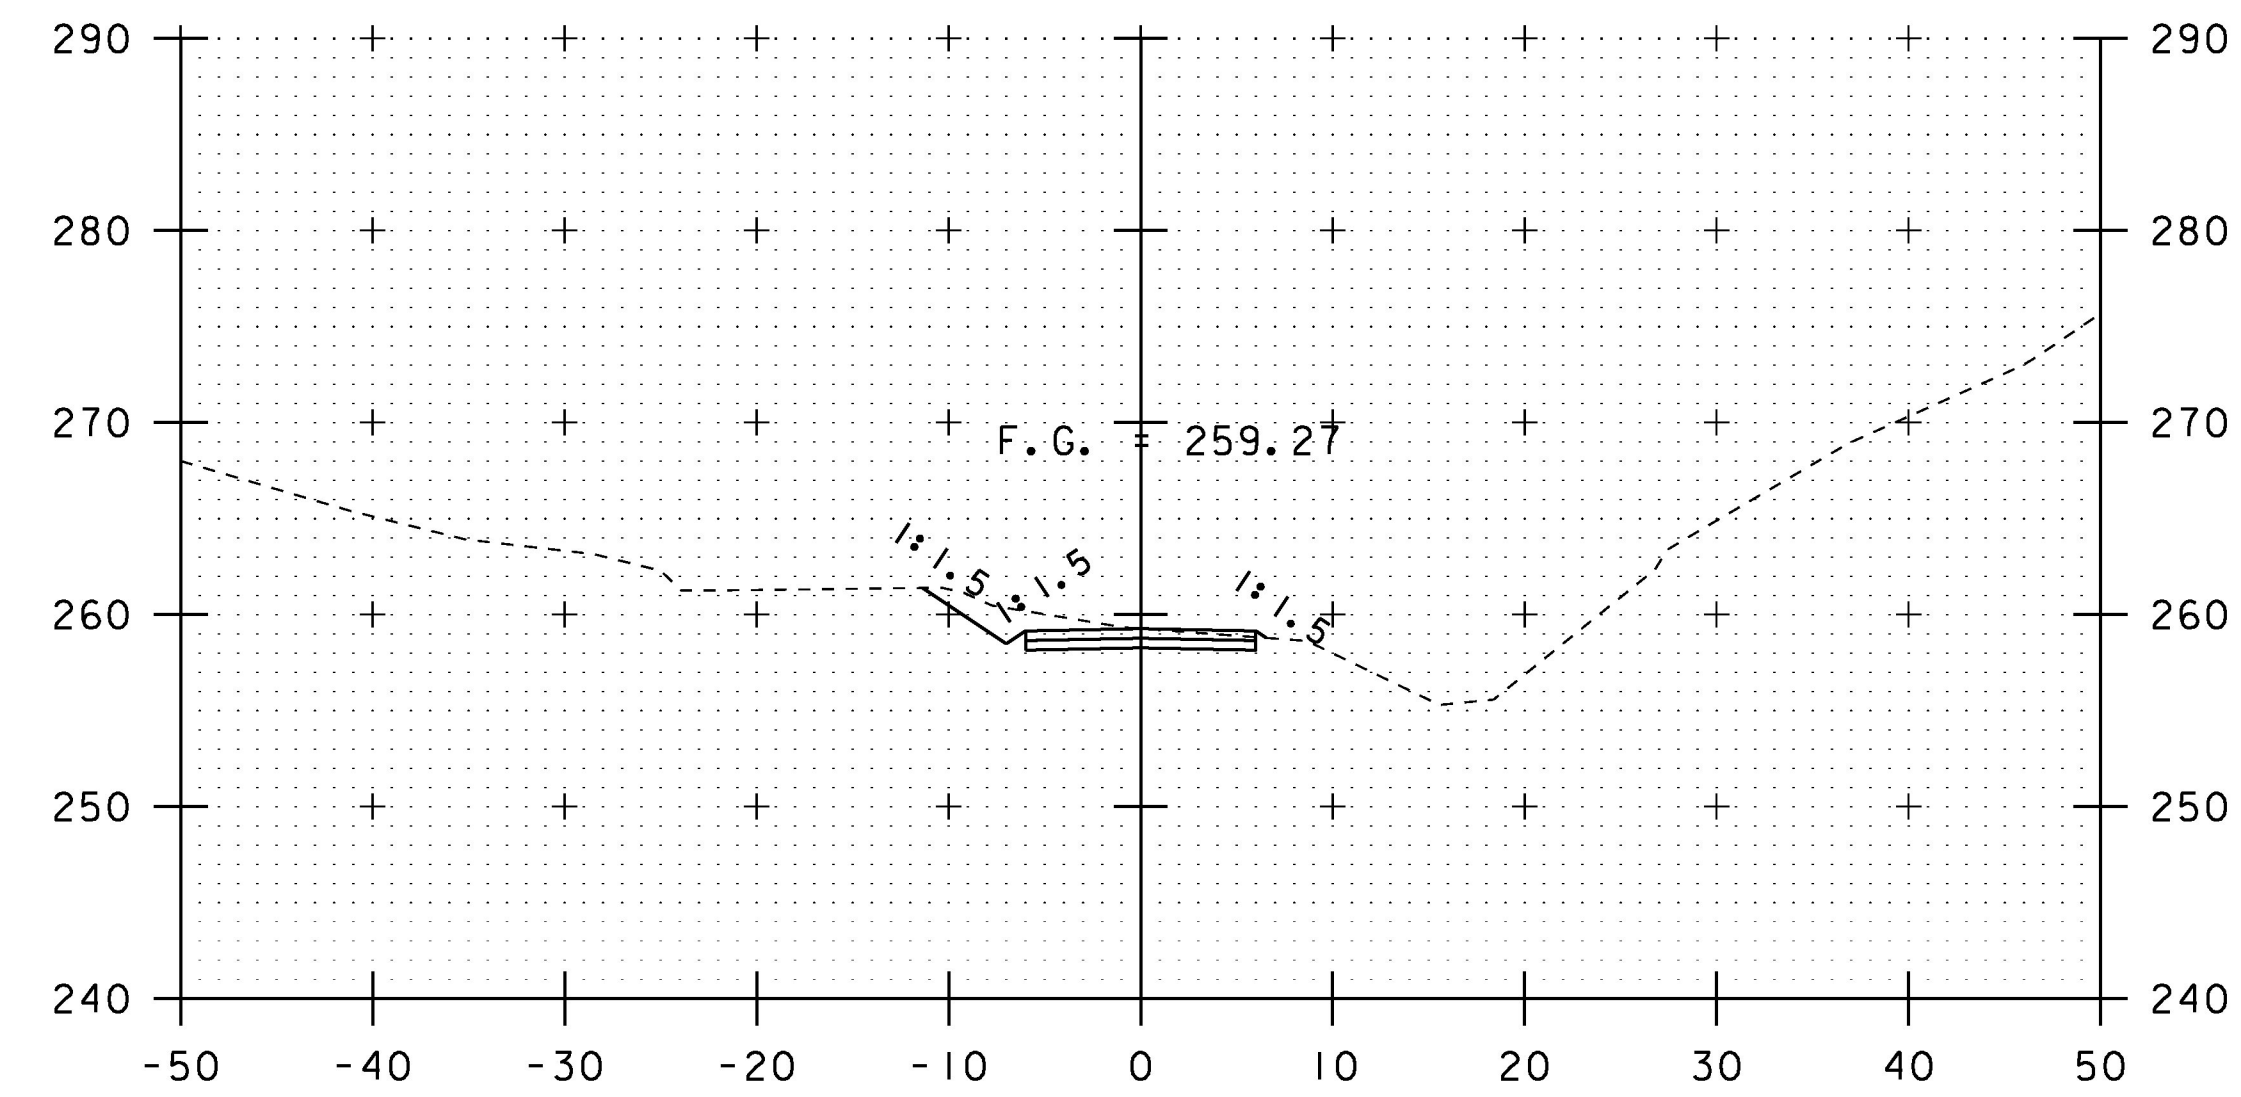

I+75

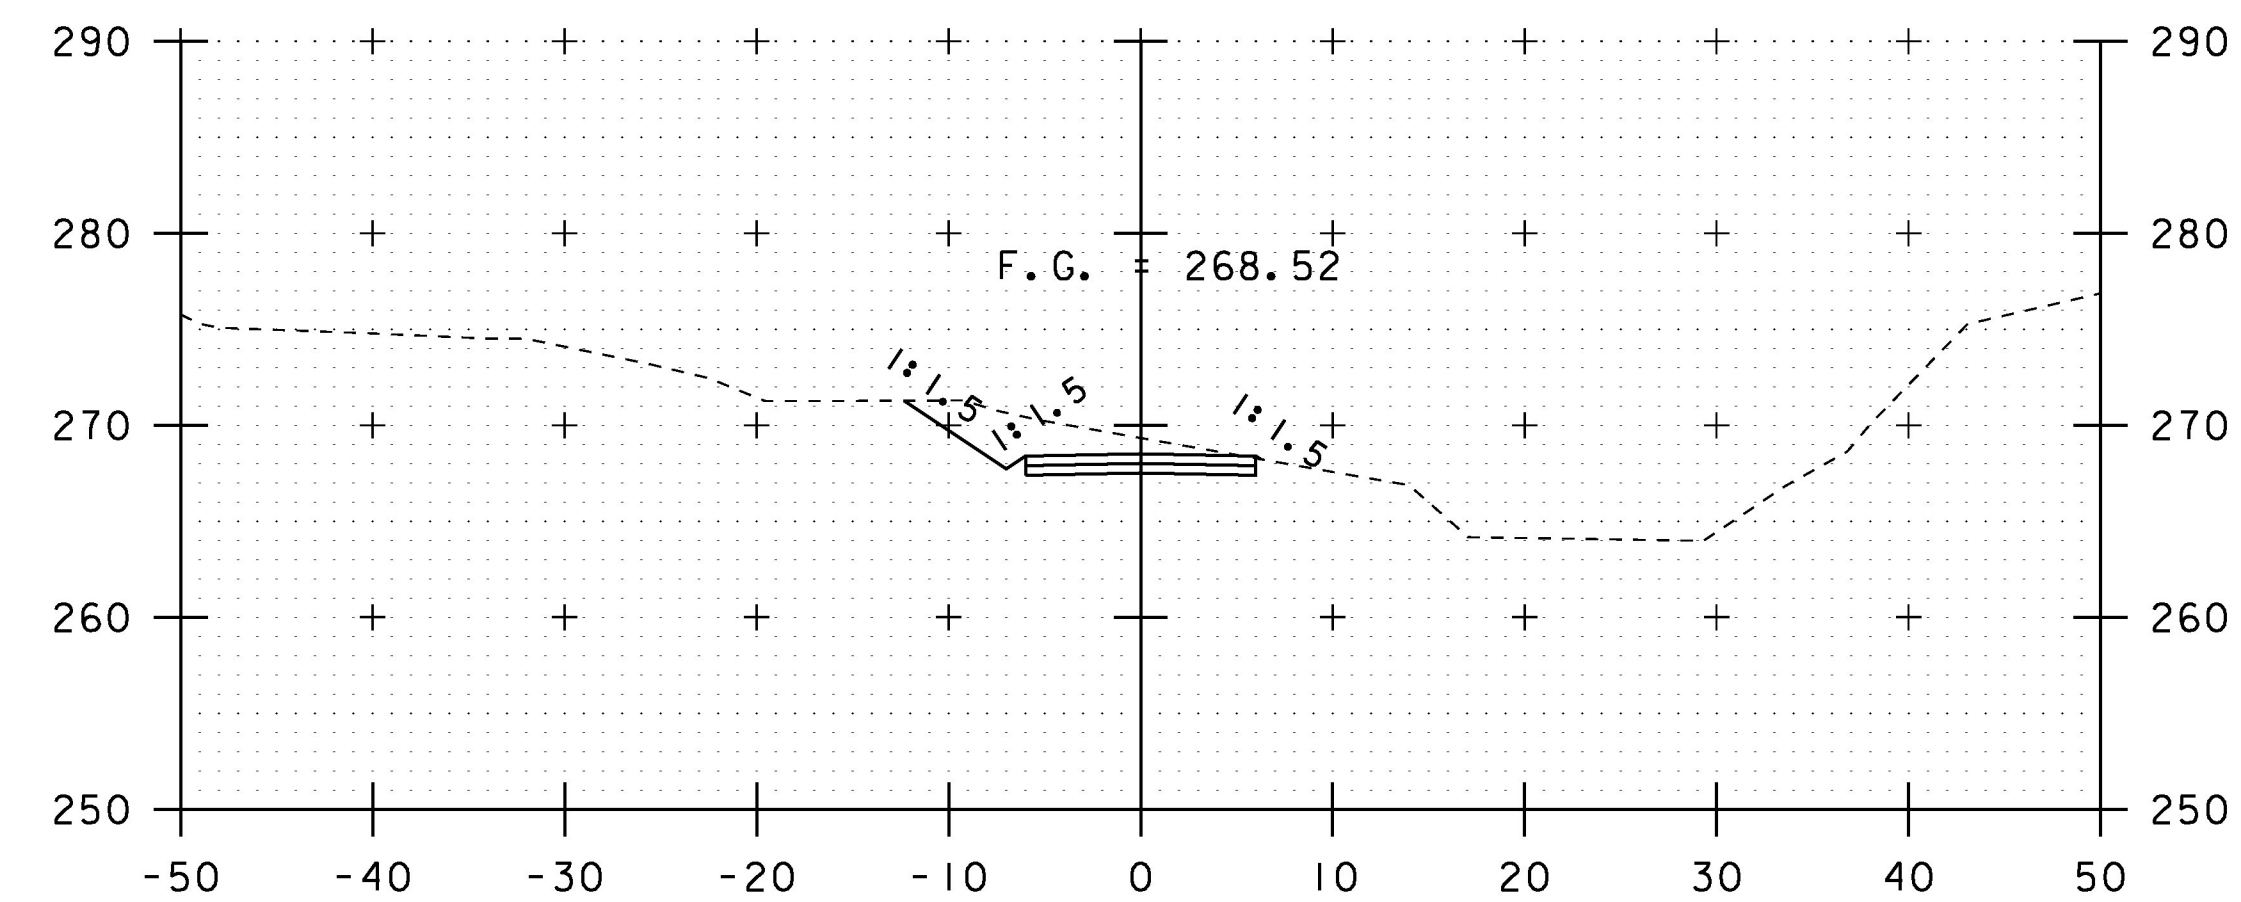

I+50

SCALE IN FEET

STA. I+00 TO STA. I+75

PROJECT NAME:	HIGHGATE
PROJECT NUMBER:	STP SCR(12)
FILE NAME:	d13ci34xs.dgn
PROJECT LEADER:	B. MARTIN
DESIGNED BY:	A. KEMPTON
SOUTH ACCESS RD CROSS SECTION SHEET I	SHEET 32 OF 40
PLOT DATE:	14-OCT-2016
DRAWN BY:	A. KEMPTON
CHECKED BY:	M. GAMELIN