


STATE OF VERMONT AGENCY OF TRANSPORTATION



PROPOSED IMPROVEMENT BRIDGE PROJECT TOWN OF HIGHGATE COUNTY OF FRANKLIN

VT ROUTE 78 (MAJOR COLLECTOR), BRIDGE #10

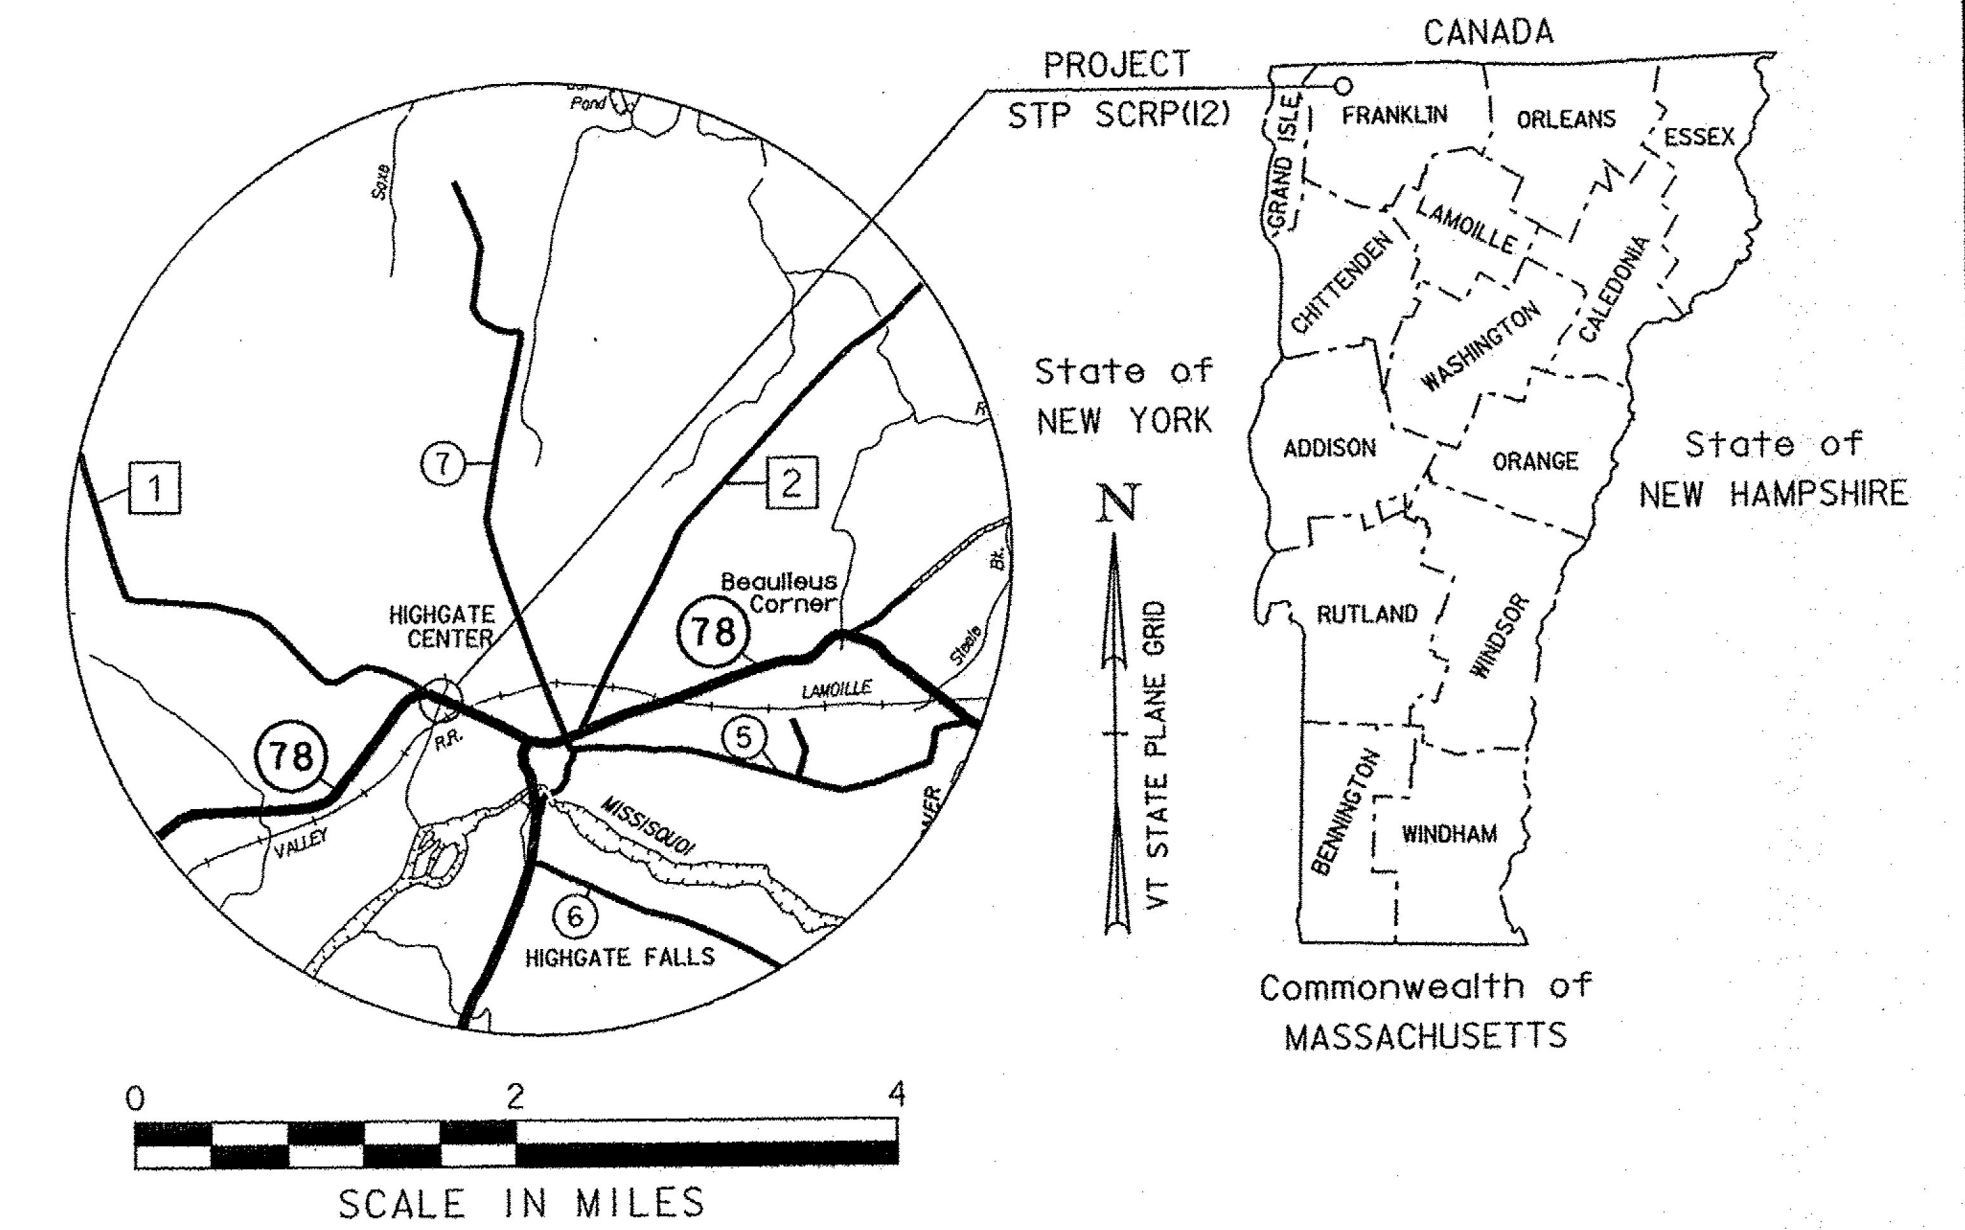


RECORD PLANS	
CONTRACTOR:	CASELLA CONSTRUCTION, INC. - MENDON, VT.
RESIDENT ENGINEER:	SCOTT WHEATLEY
CONSTRUCTION BEGAN:	APRIL 17, 2017
CONSTRUCTION COMPLETE:	APRIL 10, 2018
RECORD PLANS BY:	SCOTT WHEATLEY & JESSE IVES
I HEREBY CERTIFY THAT ALL THE CONSTRUCTION REQUIRED BY THIS SET OF DRAWINGS HAS BEEN ACCOMPLISHED AS INDICATED HEREIN.	
BY	<i>[Signature]</i> RESIDENT ENGINEER
DATE	Nov. 1, 2018
NOTE: Any further information concerning final quantities, amounts or other details relative to this project may be found at Central Files in the electronic archives.	

BEGINNING IN THE TOWN OF HIGHGATE ON VT ROUTE 78 AT STATION 124+50.00 (MM 2.358)
EXTENDING EASTERLY TO STATION 126+00.00 (MM 2.386)

LENGTH OF ROADWAY: 143.95 FEET = 0.027 MILES
LENGTH OF BRIDGE: 6.05 FEET = 0.001 MILES
LENGTH OF PROJECT: 150.00 FEET = 0.028 MILES

WORK TO BE PERFORMED UNDER THIS PROJECT INCLUDES INSTALLATION OF A NEW PIPE, HEADWALLS, WINGWALLS,
SLOPE STABILIZATION, ABANDONMENT OF THE EXISTING BOX CULVERT AND OTHER HIGHWAY RELATED ITEMS.

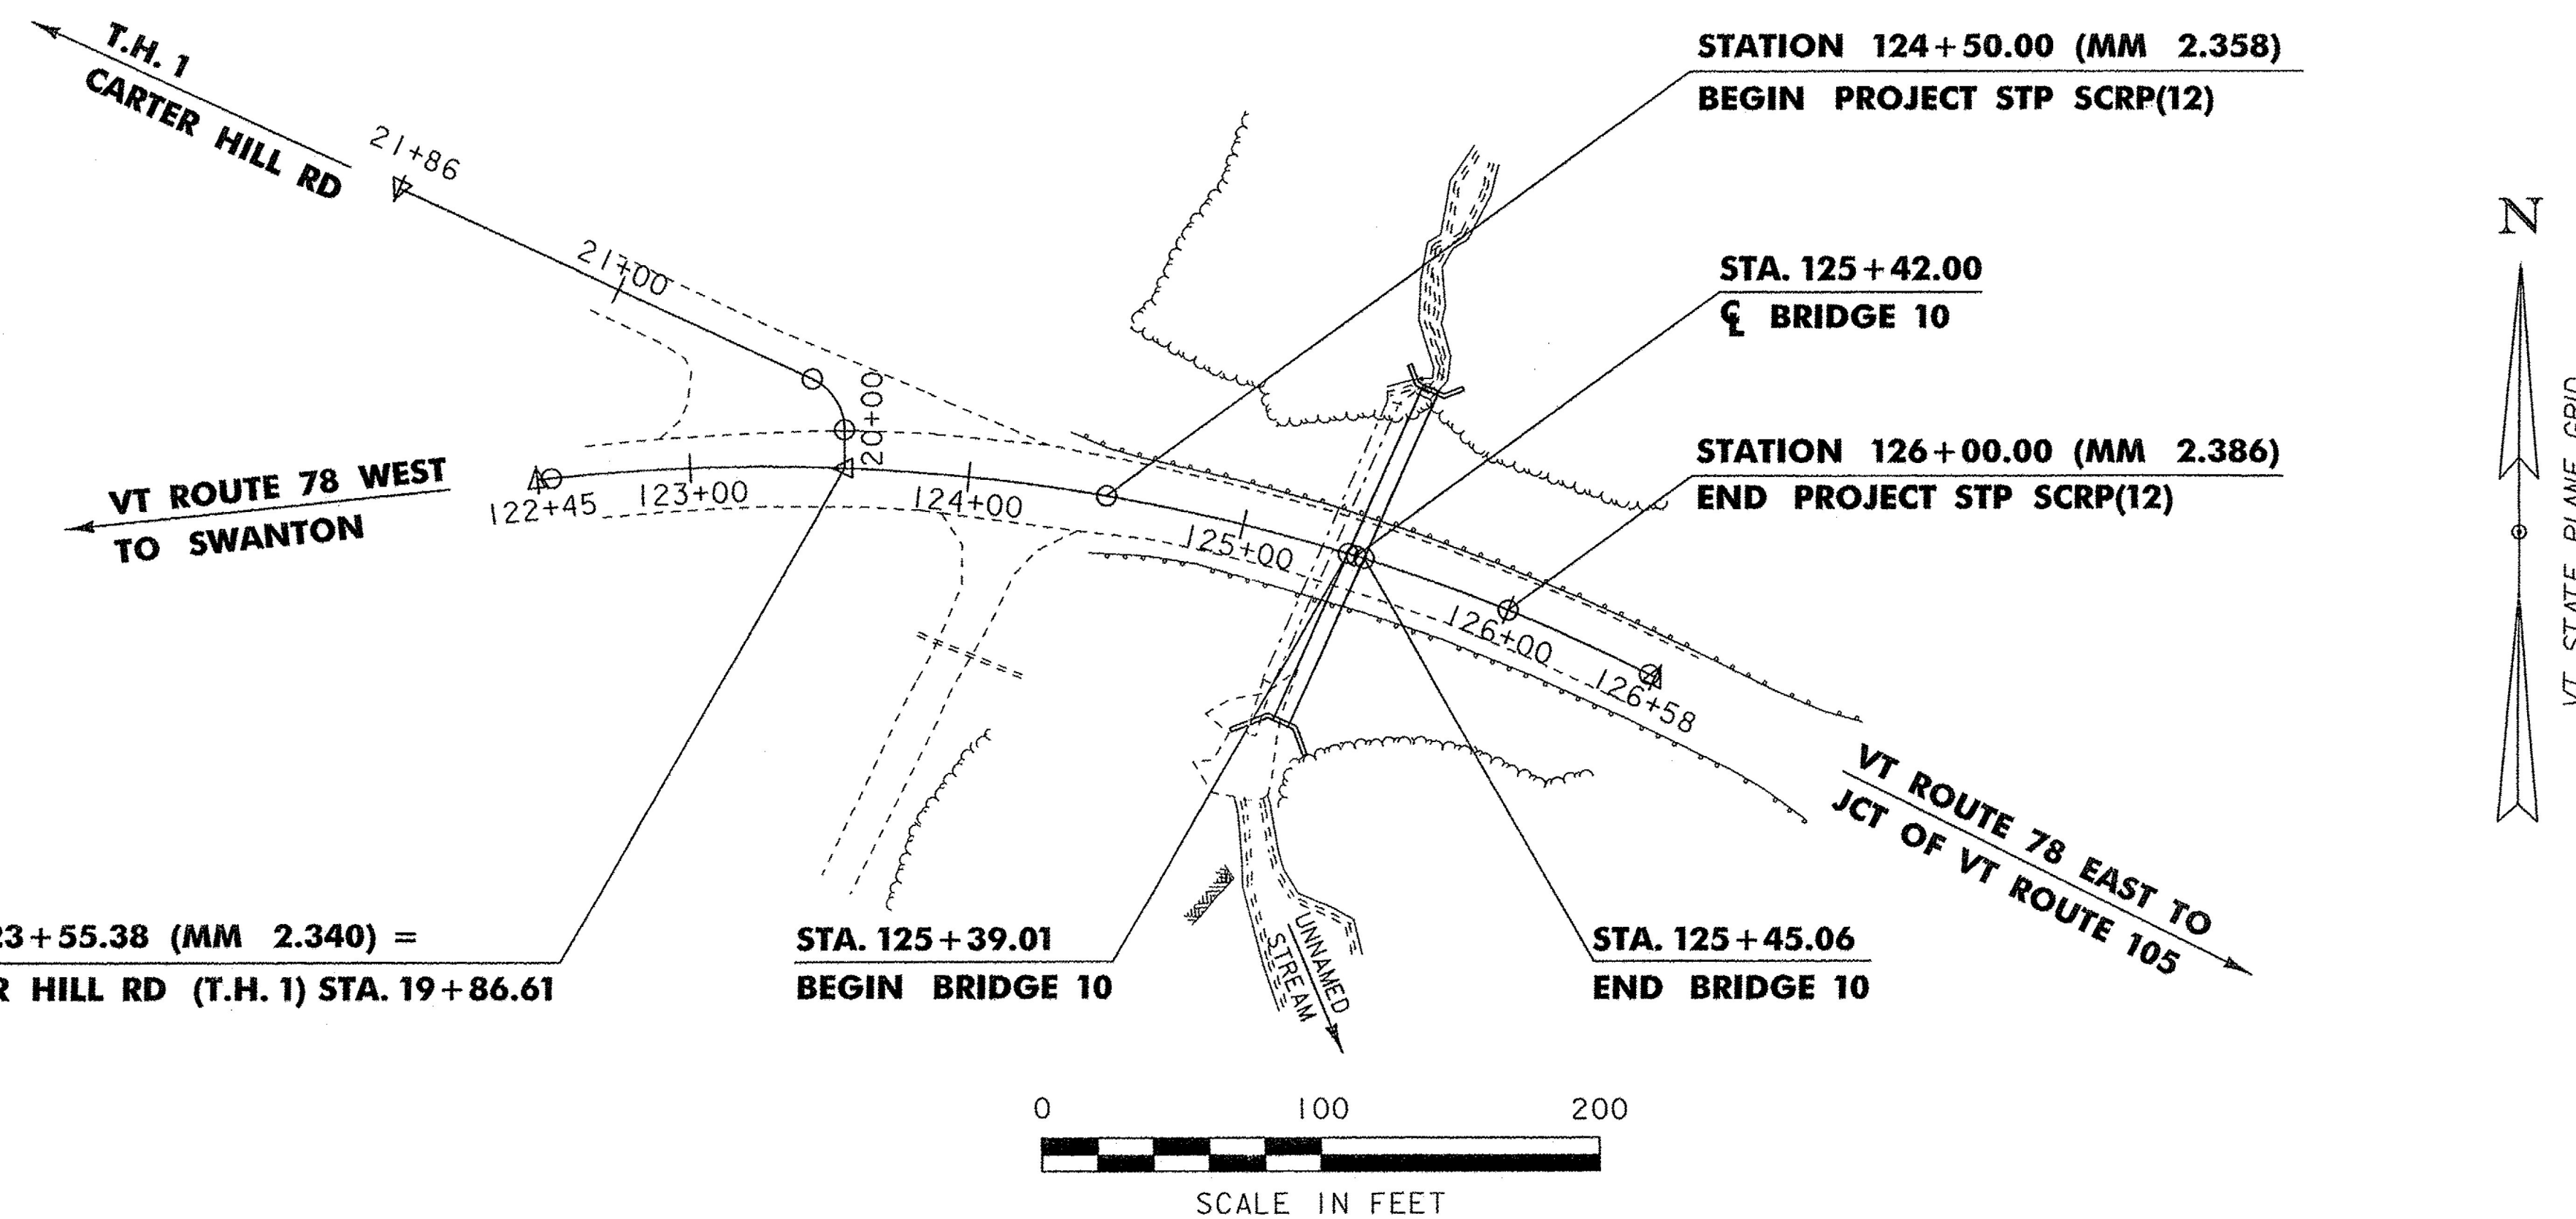

CONSTRUCTION IS TO BE CARRIED ON IN ACCORDANCE WITH THESE PLANS AND THE STANDARD SPECIFICATIONS FOR CONSTRUCTION DATED 2011, AS APPROVED BY THE FEDERAL HIGHWAY ADMINISTRATION ON JULY 20, 2011 FOR USE ON THIS PROJECT, INCLUDING ALL SUBSEQUENT REVISIONS AND SUCH REVISED SPECIFICATIONS AND SPECIAL PROVISIONS AS ARE INCORPORATED IN THESE PLANS.

QUALITY ASSURANCE PROGRAM : LEVEL	2
SURVEYED BY :	VAOT - R. GILMAN
SURVEYED DATE :	09/11/2014
DATUM	
VERTICAL	NAVD 88
HORIZONTAL	NAD 83 (2011)

DIRECTOR OF PROJECT DELIVERY	
APPROVED	<i>[Signature]</i> DATE 9/19/2016
PROJECT MANAGER :	BRUCE MARTIN, P.E.
PROJECT NAME :	HIGHGATE
PROJECT NUMBER :	STP SCR(12)
SHEET	1 OF 40 SHEETS

PRELIMINARY INFORMATION SHEET (CULVERT)

INDEX OF SHEETS

FINAL HYDRAULIC REPORT

PLAN SHEETS

1	TITLE SHEET
2	PRELIMINARY INFORMATION SHEET
3	CONVENTIONAL SYMBOLOLOGY LEGEND SHEET
4	TYPICAL SECTIONS SHEET
5	PROJECT NOTES SHEET
6	DETAIL SHEET
7	LANDSCAPE DETAILS SHEET
8 - 9	TIE SHEETS
10	CHANNEL ALIGNMENT SHEET
11 - 12	BORING SHEETS
13 - 14	QUANTITY SHEETS
15	R.O.W. DETAIL SHEET
16	R.O.W. LAYOUT SHEET
17	PLAN SHEET
18	ACCESS ROAD PLAN SHEET
19	ACCESS ROAD PROFILE SHEET
20	LANDSCAPE PLAN SHEET
21	EPSC NARRATIVE SHEET
22 - 23	EPSC DETAIL SHEETS
24	EPSC PLAN SHEET
25 - 28	VT 78 CROSS SECTION SHEETS
29 - 31	NORTH ACCESS RD CROSS SECTION SHEETS
32 - 33	SOUTH ACCESS RD CROSS SECTION SHEETS
34 - 39	CHANNEL CROSS SECTION SHEETS
40	CONSTRUCTION APPROACH SIGNING SHEET

STANDARDS LIST

G-1	11-10-2015
T-1	04-25-2016
T-10	08-06-2012
T-28	08-06-2012
T-29	08-06-2012
T-30	08-06-2012
T-42	04-09-2014
T-45	01-02-2013

STRUCTURES DETAIL SHEETS

SD-501.00	CONCRETE DETAILS AND NOTES	5/7/2010
SD-502.00	CONCRETE DETAILS AND NOTES	5/7/2010

HYDROLOGIC DATA

Date: March 2015

DRAINAGE AREA : 0.34 sq. mi.
 CHARACTER OF TERRAIN : Hilly, mixture of open and forested land cover
 STREAM CHARACTERISTICS : Sinuous, alluvial, low grade upstream & steep downstream
 NATURE OF STREAMBED : Silt & sand upstream, stone, gravel, silt & sand downstream

PEAK FLOW DATA

Q 2.33 =	45 cfs	Q 50 =	120 cfs
Q 10 =	80 cfs	Q 100 =	140 cfs
Q 25 =	100 cfs	Q 500 =	190 cfs

DATE OF FLOOD OF RECORD : Unknown
 ESTIMATED DISCHARGE : Unknown
 WATER SURFACE ELEV. : Unknown
 NATURAL STREAM VELOCITY : @ Q50 = 13.3 fps
 ICE CONDITIONS : Light to moderate
 DEBRIS : Moderate to heavy
 DOES THE STREAM REACH MAXIMUM HIGHWATER ELEV. RAPIDLY? : Yes
 IS ORDINARY RISE RAPID? : Yes
 IS STAGE AFFECTED BY UPSTREAM OR DOWNSTREAM CONDITIONS? : No
 IF YES, DESCRIBE :

WATERSHED STORAGE : < 1% HEADWATERS :
 UNIFORM : X
 IMMEDIATELY ABOVE SITE :

EXISTING STRUCTURE INFORMATION

STRUCTURE TYPE : Reinforced Concrete Box
 YEAR BUILT : Unknown
 CLEAR SPAN(NORMAL TO STREAM) : 4.0'
 VERTICAL CLEARANCE ABOVE STREAMBED : 4.0'
 WATERWAY OF FULL OPENING : 16 sq. ft.
 DISPOSITION OF STRUCTURE : Abandon and fill with flowable fill
 TYPE OF MATERIAL UNDER SUBSTRUCTURE : See boring logs

WATER SURFACE ELEVATIONS AT:

Q2.33 =	259.5'	VELOCITY =	11.2 fps
Q10 =	260.7'	"	12.9 fps
Q25 =	261.3'	"	13.6 fps
Q50 =	262.0'	"	14.2 fps
Q100 =	262.7'	"	14.7 fps

LONG TERM STREAMBED CHANGES : The only changes noted are deposition upstream and erosion downstream, likely due to the inadequate size and failure of the existing structure.

IS THE ROADWAY OVERTOPPED BELOW Q100 : No
 FREQUENCY : Above Q100
 RELIEF ELEVATION : 285.0'
 DISCHARGE OVER ROAD @Q100 : None

UPSTREAM STRUCTURE

TOWN : None DISTANCE :
 HIGHWAY # : STRUCTURE # :
 CLEAR SPAN : CLEAR HEIGHT :
 YEAR BUILT : FULL WATERWAY :
 STRUCTURE TYPE :

DOWNSTREAM STRUCTURE

TOWN : Highgate DISTANCE : 800'
 HIGHWAY # : Rail trail STRUCTURE # : -
 CLEAR SPAN : Unknown CLEAR HEIGHT : Unknown
 YEAR BUILT : Unknown FULL WATERWAY : -
 STRUCTURE TYPE : Unknown

LRFR LOAD RATING FACTORS

LOADING LEVELS	TRUCK						
	H-20	HL-93	3S2	6 AXLE	3A STR.	4A STR.	5A SEM
TONNAGE	20	36	36	66	30	34.5	38
INVENTORY							
POSTING							
OPERATING							
COMMENTS:	TABLE TO BE COMPLETED BY CONTRACTOR'S DESIGNER						

AS BUILT "REBAR" DETAIL

AS BUILT "REBAR" DETAIL		
LEVEL I	LEVEL II	LEVEL III
TYPE:	TYPE:	TYPE:
GRADE:	GRADE:	GRADE:

CULVERT DESIGN CRITERIA

- PROPOSED CULVERT IS A STEEL CORRUGATED (6'-0" X 6'-0" X 131'-0" PIPE).
- CULVERT ENDS ARE NOT SKEWED.
- CULVERT WILL BE SET AT A SLOPE OF 12.00 IN. ON 50 FT.
- CULVERT WILL NOT REQUIRE FISH PASSAGE ACCOMODATIONS
- CULVERT CONSTRUCTION WILL NOT REQUIRE A TEMPORARY PIPE

TRAFFIC DATA

YEAR	ADT	DHV	% D	% T	ADTT	
0	0	0	0	0	0	20 year ESAL for flexible pavement from XXXX to XXXX : 0
XXXX	0	0	0	0	0	40 year ESAL for flexible pavement from XXXX to XXXX : 0
						Design Speed : 0 mph

PROPOSED STRUCTURE

STRUCTURE TYPE : Smooth interior steel pipe with cement mortar lining
 CLEAR SPAN(NORMAL TO STREAM) : 5.9'
 VERTICAL CLEARANCE ABOVE STREAMBED : 5.9'
 WATERWAY OF FULL OPENING : 27 sq. ft.

WATER SURFACE ELEVATIONS AT:

Q2.33 =	259.1'	VELOCITY=	13.0 fps
Q10 =	260.1'	"	14.6 fps
Q25 =	260.6'	"	15.2 fps
Q50 =	261.0'	"	15.7 fps
Q100 =	261.5'	"	16.2 fps

IS THE ROADWAY OVERTOPPED BELOW Q100 : No
 FREQUENCY : Above Q100
 RELIEF ELEVATION : 285.0'
 DISCHARGE OVER ROAD @Q100 : None

AVERAGE LOW ELEVATION OF SUPERSTRUCTURE : 262.6' (top of pipe at inlet)
 VERTICAL CLEARANCE : @ Q50 = 1.6'

SCOUR : Not applicable for a pipe

REQUIRED CHANNEL PROTECTION : Stone Fill, Type II at inlet and Type IV at outlet

PERMIT INFORMATION

AVERAGE DAILY FLOW : 1 cfs DEPTH OR ELEVATION :
 ORDINARY LOW WATER : 0.5 cfs Depth < 0.5'
 ORDINARY HIGH WATER : 20 cfs Depth = 2'

TEMPORARY BRIDGE REQUIREMENTS

STRUCTURE TYPE : No temporary structure required
 CLEAR SPAN (NORMAL TO STREAM) :
 VERTICAL CLEARANCE ABOVE STREAMBED :
 WATERWAY AREA OF FULL OPENING :

ADDITIONAL INFORMATION

TRAFFIC MAINTENANCE NOTES

- MAINTAIN TWO-WAY TRAFFIC ON THE EXISTING STRUCTURE.
- TRAFFIC SIGNALS ARE NOT NECESSARY.
- SIDEWALKS ARE NOT NECESSARY

DESIGN VALUES

1. DESIGN LIVE LOAD	HL-93
2. FUTURE PAVEMENT	d _p : 3.0 INCH
3. CULVERT OPENING	D: 6.00 FT
4. MIN. MID-SPAN POS. CAMBER @ RELEASE (PRESTRESSED UNITS)	Δ: ---
5. PRESTRESSING STRAND	f _y : ---
6. PRESTRESSED CONCRETE STRENGTH	f' _c : ---
7. PRESTRESSED CONCRETE RELEASE STRENGTH	f' _{cr} : ---
8. CONCRETE, HIGH PERFORMANCE CLASS AA	f' _c : 4.0 KSI
9. CONCRETE, HIGH PERFORMANCE CLASS A	f' _c : 4.0 KSI
10. CONCRETE, HIGH PERFORMANCE CLASS B	f' _c : 3.5 KSI
11. CONCRETE, CLASS C	f' _c : 3.0 KSI
12. REINFORCING STEEL	f _y : 60 KSI
13. STRUCTURAL STEEL AASHTO M270	f _y : ---
14. NOMINAL BEARING RESISTANCE OF SOIL	q _n : ---
15. SOIL BEARING RESISTANCE FACTOR (REFER TO AASHTO LRFD)	φ: 0.45
16. NOMINAL BEARING RESISTANCE OF ROCK	q _n : 10.0 KSF
17. ROCK BEARING RESISTANCE FACTOR (REFER TO AASHTO LRFD)	φ: 0.45
18. PILE RESISTANCE FACTOR	φ: ---
19. LATERAL PILE DEFLECTION	Δ: ---
20. BASIC WIND SPEED	V _{3s} : ---
21. MINIMUM GROUND SNOW LOAD	p _g : ---
22. SEISMIC DATA	PGA: 0 S: --- S _i : ---
23.	---
24.	---
25.	---
26.	---

PROJECT NAME : **HIGHGATE**
 PROJECT NUMBER : **STP SCR(12)**
 FILE NAME : d13c134_P1.xls PLOT DATE: 10/13/2016
 PROJECT LEADER : B. MARTIN DRAWN BY: A. KEMPTON
 DESIGNED BY: A. KEMPTON CHECKED BY: D. WILLEY
 PRELIMINARY INFORMATION SHEET 1 SHEET 2 OF 40

GENERAL INFORMATION

SYMBOLGY LEGEND NOTE

THE SYMBOLGY ON THIS SHEET IS INTENDED TO COVER STANDARD CONVENTIONAL SYMBOLGY. THE SYMBOLGY IS USED FOR EXISTING & PROPOSED FEATURES WITH HEAVIER LINEWEIGHT, IN COMBINATION WITH PROJECT ANNOTATION, AS NOTED ON PROJECT PLAN SHEETS. THIS LEGEND SHEET COVERS THE BASICS. SYMBOLGY ON PLANS MAY VARY, PLAN ANNOTATIONS AND NOTES SHOULD BE USED TO CLARIFY AS NEEDED.

R. O. W. ABBREVIATIONS (CODES) & SYMBOLS

POINT	CODE	DESCRIPTION
	CH	CHANNEL EASEMENT
	CONST	CONSTRUCTION EASEMENT
	CUL	CULVERT EASEMENT
	D&C	DISCONNECT & CONNECT
	DIT	DITCH EASEMENT
	DR	DRAINAGE EASEMENT
	DRIVE	DRIVEWAY EASEMENT
	EC	EROSION CONTROL
	HWY	HIGHWAY EASEMENT
	I&M	INSTALL & MAINTAIN EASEMENT
	LAND	LANDSCAPE EASEMENT
	R&RES	REMOVE & RESET
	R&REP	REMOVE & REPLACE
	SR	SLOPE RIGHT
	UE	UTILITY EASEMENT
	(P)	PERMANENT EASEMENT
	(T)	TEMPORARY EASEMENT
■	BNDNS	BOUND SET
▣	BNDNS	BOUND TO BE SET
●	IPNS	IRON PIN SET
◎	IPNS	IRON PIN TO BE SET
⊠	CALC	EXISTING ROW POINT
○	PROW	PROPOSED ROW POINT
[LENGTH]		LENGTH CARRIED ON NEXT SHEET

COMMON TOPOGRAPHIC POINT SYMBOLS

POINT	CODE	DESCRIPTION
⊠	APL	BOUND APPARENT LOCATION
□	BM	BENCHMARK
▣	BND	BOUND
▣	CB	CATCH BASIN
⊕	COMB	COMBINATION POLE
▣	DITHR	DROP INLET THROATED DNC
⊕	EL	ELECTRIC POWER POLE
○	FPOLE	FLAGPOLE
○	GASFIL	GAS FILLER
○	GP	GUIDE POST
×	GSO	GAS SHUT OFF
○	GUY	GUY POLE
○	GUYW	GUY WIRE
×	GV	GATE VALUE
⊕	H	TREE HARDWOOD
△	HCTRL	CONTROL HORIZONTAL
△	HVCTRL	CONTROL HORIZ. & VERTICAL
◇	HYD	HYDRANT
●	IP	IRON PIN
⊕	IPIPE	IRON PIPE
⊕	LI	LIGHT - STREET OR YARD
⊕	MB	MAILBOX
○	MH	MANHOLE (MH)
□	MM	MILE MARKER
●	PM	PARKING METER
□	PMK	PROJECT MARKER
○	POST	POST STONE/WOOD
⊕	RRSIG	RAILROAD SIGNAL
⊕	RRSL	RAILROAD SWITCH LEVER
⊕	S	TREE SOFTWOOD
⊕	SAT	SATELLITE DISH
⊕	SHRUB	SHRUB
⊕	SIGN	SIGN
⊕	STUMP	STUMP
○	TEL	TELEPHONE POLE
○	TIE	TIE
⊕	TSIGN	SIGN W/DOUBLE POST
⊕	VCTRL	CONTROL VERTICAL
○	WELL	WELL
×	WSO	WATER SHUT OFF

THESE ARE COMMON VAOT SURVEY POINT SYMBOLS FOR EXISTING FEATURES, ALSO USED FOR PROPOSED FEATURES WITH HEAVIER LINEWEIGHT, IN COMBINATION WITH PROPOSED ANNOTATION.

PROPOSED GEOMETRY CODES

CODE	DESCRIPTION
PC	POINT OF CURVATURE
PI	POINT OF INTERSECTION
CC	CENTER OF CURVE
PT	POINT OF TANGENCY
PCC	POINT OF COMPOUND CURVE
PRC	POINT OF REVERSE CURVE
POB	POINT OF BEGINNING
POE	POINT OF ENDING
STA	STATION PREFIX
AH	AHEAD STATION SUFFIX
BK	BACK STATION SUFFIX
D	CURVE DEGREE OF (100FT)
R	CURVE RADIUS OF
T	CURVE TANGENT LENGTH
L	CURVE LENGTH OF
E	CURVE EXTERNAL DISTANCE

UTILITY SYMBOLGY

UNDERGROUND UTILITIES	
— UGU —	UTILITY (GENERIC-UNKNOWN)
— UT —	TELEPHONE
— UE —	ELECTRIC
— UC —	CABLE (TV)
— UEC —	ELECTRIC+CABLE
— UET —	ELECTRIC+TELEPHONE
— UCT —	CABLE+TELEPHONE
— UECT —	ELECTRIC+CABLE+TELEP.
— G —	GAS LINE
— W —	WATER LINE
— S —	SANITARY SEWER (SEPTIC)

ABOVE GROUND UTILITIES (AERIAL)	
— AGU —	UTILITY (GENERIC-UNKNOWN)
— T —	TELEPHONE
— E —	ELECTRIC
— C —	CABLE (TV)
— EC —	ELECTRIC+CABLE
— ET —	ELECTRIC+TELEPHONE
— AER E&T —	ELECTRIC+TELEPHONE
— CT —	CABLE+TELEPHONE
— ECT —	ELECTRIC+CABLE+TELEP.
—	UTILITY POLE GUY WIRE

PROJECT CONSTRUCTION SYMBOLGY	
— — — — — CZ — — — — —	CLEAR ZONE
— — — — —	PLAN LAYOUT MATCHLINE

PROJECT CONSTRUCTION FEATURES	
△ — △ — △ — △ — △	TOP OF CUT SLOPE
⊕ — ⊕ — ⊕ — ⊕ — ⊕	TOE OF FILL SLOPE
⊕ ⊕ ⊕ ⊕ ⊕ ⊕	STONE FILL
— — — — —	BOTTOM OF DITCH
— — — — —	CULVERT PROPOSED
— — — — —	STRUCTURE SUBSURFACE
PDF — PDF —	PROJECT DEMARCATION FENCE
BF — — — — — BF — — — — —	BARRIER FENCE
XXXXXXXXXXXXXXXXXXXX	TREE PROTECTION ZONE (TPZ)
//// //// //// ////	STRIPING LINE REMOVAL
~~~~ ~~~~ ~~~~ ~~~~	SHEET PILES

CONVENTIONAL BOUNDARY SYMBOLGY	
— — — — —	TOWN BOUNDARY LINE
— — — — —	COUNTY BOUNDARY LINE
— — — — —	STATE BOUNDARY LINE
— — — — —	PROPOSED STATE R.O.W. (LIMITED ACCESS)
— — — — —	PROPOSED STATE R.O.W.
— — — — —	STATE ROW (LIMITED ACCESS)
— — — — —	STATE ROW
— — — — —	TOWN ROW
— — — — —	PERMANENT EASEMENT LINE (P)
— — — — —	TEMPORARY EASEMENT LINE (T)
— — — — —	SURVEY LINE
P — — — — — P	PROPERTY LINE (P/L)
SR — — — — — SR	SLOPE RIGHTS
6f — — — — — 6f	6F PROPERTY BOUNDARY
4f — — — — — 4f	4F PROPERTY BOUNDARY
HAZ — — — — — HAZ	HAZARDOUS WASTE

**EPSC LAYOUT PLAN SYMBOLGY**


EPSC MEASURES	
ONNOONNOONNO	FILTER CURTAIN
— — — — —	SILT FENCE
— — — — —	SILT FENCE WOVEN WIRE
— — — — —	CHECK DAM
— — — — —	DISTURBED AREAS REQUIRING RE-VEGETATION
— — — — —	EROSION MATTING

ENVIRONMENTAL RESOURCES	
— — — — —	WETLAND BOUNDARY
— — — — —	RIPARIAN BUFFER ZONE
— — — — —	WETLAND BUFFER ZONE
— — — — —	SOIL TYPE BOUNDARY
— — — — —	THREATENED & ENDANGERED SPECIES
HAZ — — — — — HAZ	HAZARDOUS WASTE AREA
AG — — — — —	AGRICULTURAL LAND
HABITAT — — — — —	FISH & WILDLIFE HABITAT
FLOOD PLAIN — — — — —	FLOOD PLAIN
OHW — — — — —	ORDINARY HIGH WATER (OHW)
— — — — —	STORM WATER
— — — — —	USDA FOREST SERVICE LANDS
— — — — —	WILDLIFE HABITAT SUIT/CONN

ARCHEOLOGICAL & HISTORIC	
— — — — —	ARCHEOLOGICAL BOUNDARY
— — — — —	HISTORIC DISTRICT BOUNDARY
— — — — —	HISTORIC AREA
(H)	HISTORIC STRUCTURE


CONVENTIONAL TOPOGRAPHIC SYMBOLGY	
— — — — —	EXISTING FEATURES
— — — — —	ROAD EDGE PAVEMENT
— — — — —	ROAD EDGE GRAVEL
— — — — —	DRIVEWAY EDGE
— — — — —	DITCH
— — — — —	FOUNDATION
x — x — x — x — x	FENCE (EXISTING)
□ — □ — □ — □ — □	FENCE WOOD POST
○ — ○ — ○ — ○ — ○	FENCE STEEL POST
— — — — —	GARDEN
— — — — —	ROAD GUARDRAIL
— — — — —	RAILROAD TRACKS
— — — — —	CULVERT (EXISTING)
— — — — —	STONE WALL
— — — — —	WALL
— — — — —	WOOD LINE
— — — — —	BRUSH LINE
— — — — —	HEDGE
— — — — —	BODY OF WATER EDGE
— — — — —	LEDGE EXPOSED

PROJECT NAME: HIGHGATE  
 PROJECT NUMBER: STP SCRPI(2)  
 FILE NAME: d13ci34_frm.dgn PLOT DATE: 14-OCT-2016  
 PROJECT LEADER: B. MARTIN DRAWN BY: A. KEMPTON  
 DESIGNED BY: A. KEMPTON CHECKED BY: M. GAMELIN  
 CONVENTIONAL SYMBOLGY LEGEND SHEET SHEET 3 OF 40

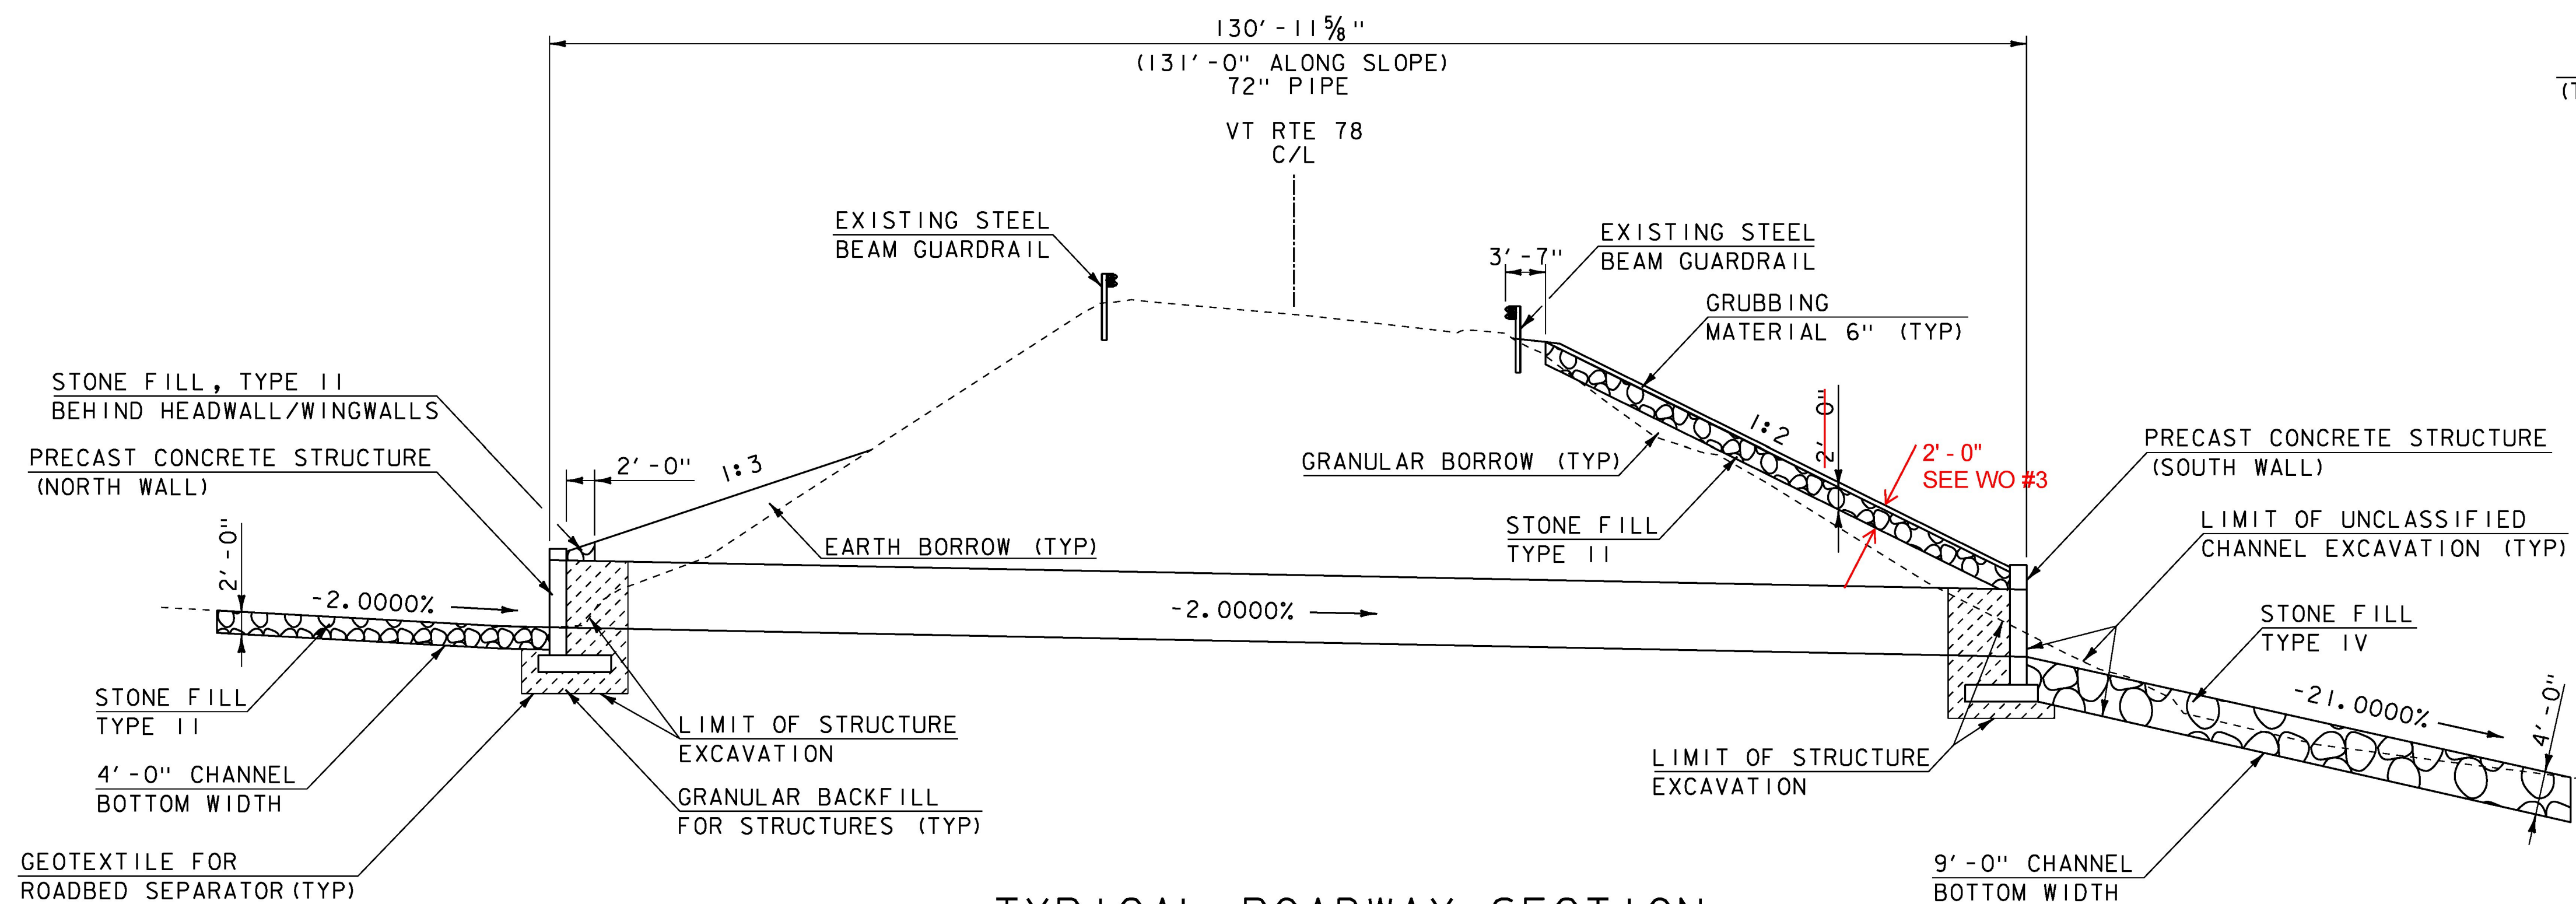

**TYPICAL ROADWAY SECTION  
(AT CENTERLINE OF PIPE)**

NOT TO SCALE

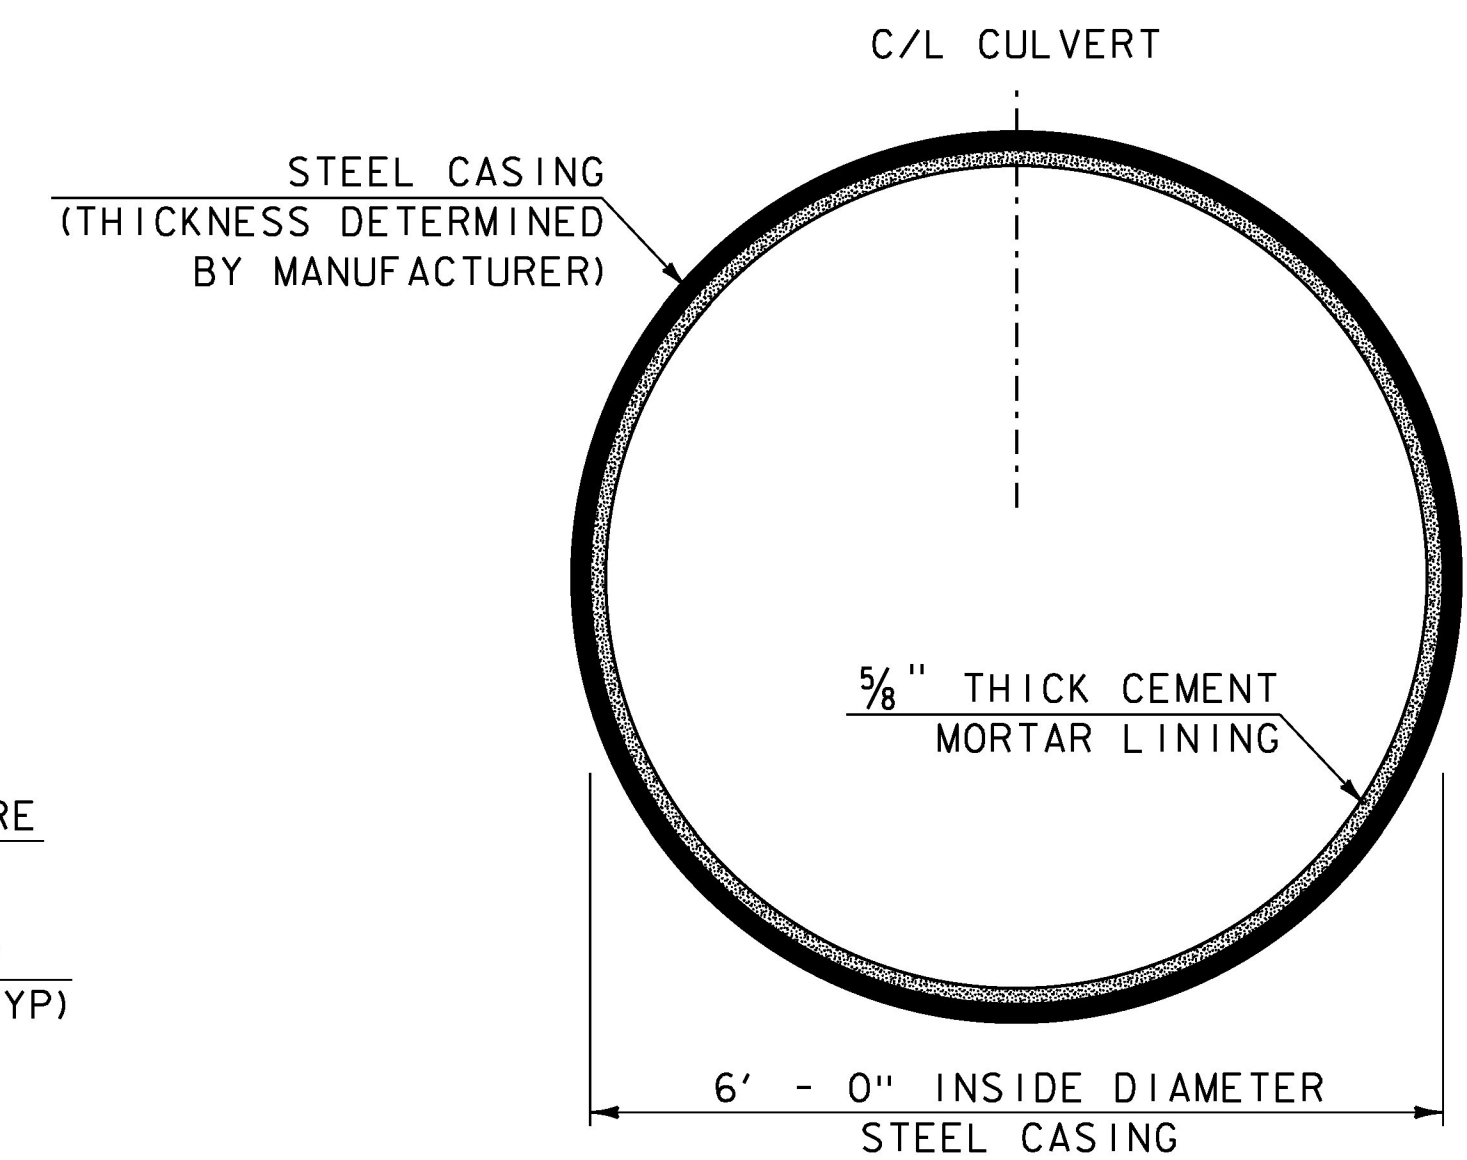


**TYPICAL CULVERT SECTION**

NOT TO SCALE


**GENERAL NOTES:**

1. A MINIMUM OF 1.5 FEET OF MATERIAL SHALL BE EXCAVATED BELOW THE BOTTOM OF THE OUTLET FOOTINGS AND 2.0 FEET BELOW THE INLET FOOTINGS.
2. GRANULAR BACKFILL FOR STRUCTURES SHALL BE PLACED TO A MINIMUM DISTANCE OF 1.5 FEET BELOW AND 1.5 FEET BEHIND ALL WINGWALLS AND HEADWALLS.
3. IF THE EXISTING GUARDRAIL IS DAMAGED OR REMOVED FOR THE CONTRACTORS CONVENIENCE, IT SHALL BE REPLACED AT THE CONTRACTORS EXPENSE.
4. EARTH BORROW SHALL BE PLACED AT A 1:3 SLOPE TO BACKFILL THE HEADWALL AND WINGWALLS ON THE NORTH SLOPE FROM STATION 125+12 TO STATION 125+90 LT.
5. THE SOUTH SLOPE SHALL SMOOTHLY TRANSITION FROM A 1:4 SIDE SLOPE AT STATION 124+50 RT. TO A 1:2 SIDE SLOPE AT STATION 125+00 RT.
6. THE SOUTH SLOPE SHALL BE STABILIZED WITH TYPE II STONE FILL AND 6" OF GRUBBING MATERIAL FROM STATION 125+00 TO STATION 125+50 RT.
7. THE EXISTING BOX CULVERT SHALL BE ABANDONED IN PLACE AND SHALL BE FILLED WITH CONTROLLED DENSITY (FLOWABLE) FILL.
8. IN ORDER TO CONSTRUCT THE PROPOSED INLET WINGWALLS AND FOOTINGS THE EXISTING INLET WINGWALLS SHALL BE REMOVED. THIS WORK WILL BE PAID FOR UNDER ITEM 203.16 SOLID ROCK EXCAVATION.
9. A 50' X 20' RAMMING PAD SHALL BE CONSTRUCTED AT THE INLET OF THE PIPE. ALL WORK AND MATERIALS ASSOCIATED WITH THE STAGING AREA WILL BE CONSIDERED INCIDENTAL TO SPECIAL PROVISION (TRENCHLESS PIPE WITH CEMENT MORTAR LINING) (72" DIAMETER). THE RAMMING PAD SHALL BE OFFSET TO THE WEST (SEE TYPICAL SECTION) OF THE PIPE INVERT TO MINIMIZE IMPACTS TO THE CHANNEL EMBANKMENT. THE STAGING AREA SHALL BE RESTORED TO ITS ORIGINAL CONDITION AND LINED WITH STONE FILL, TYPE II AFTER THE PIPE HAS BEEN INSTALLED.

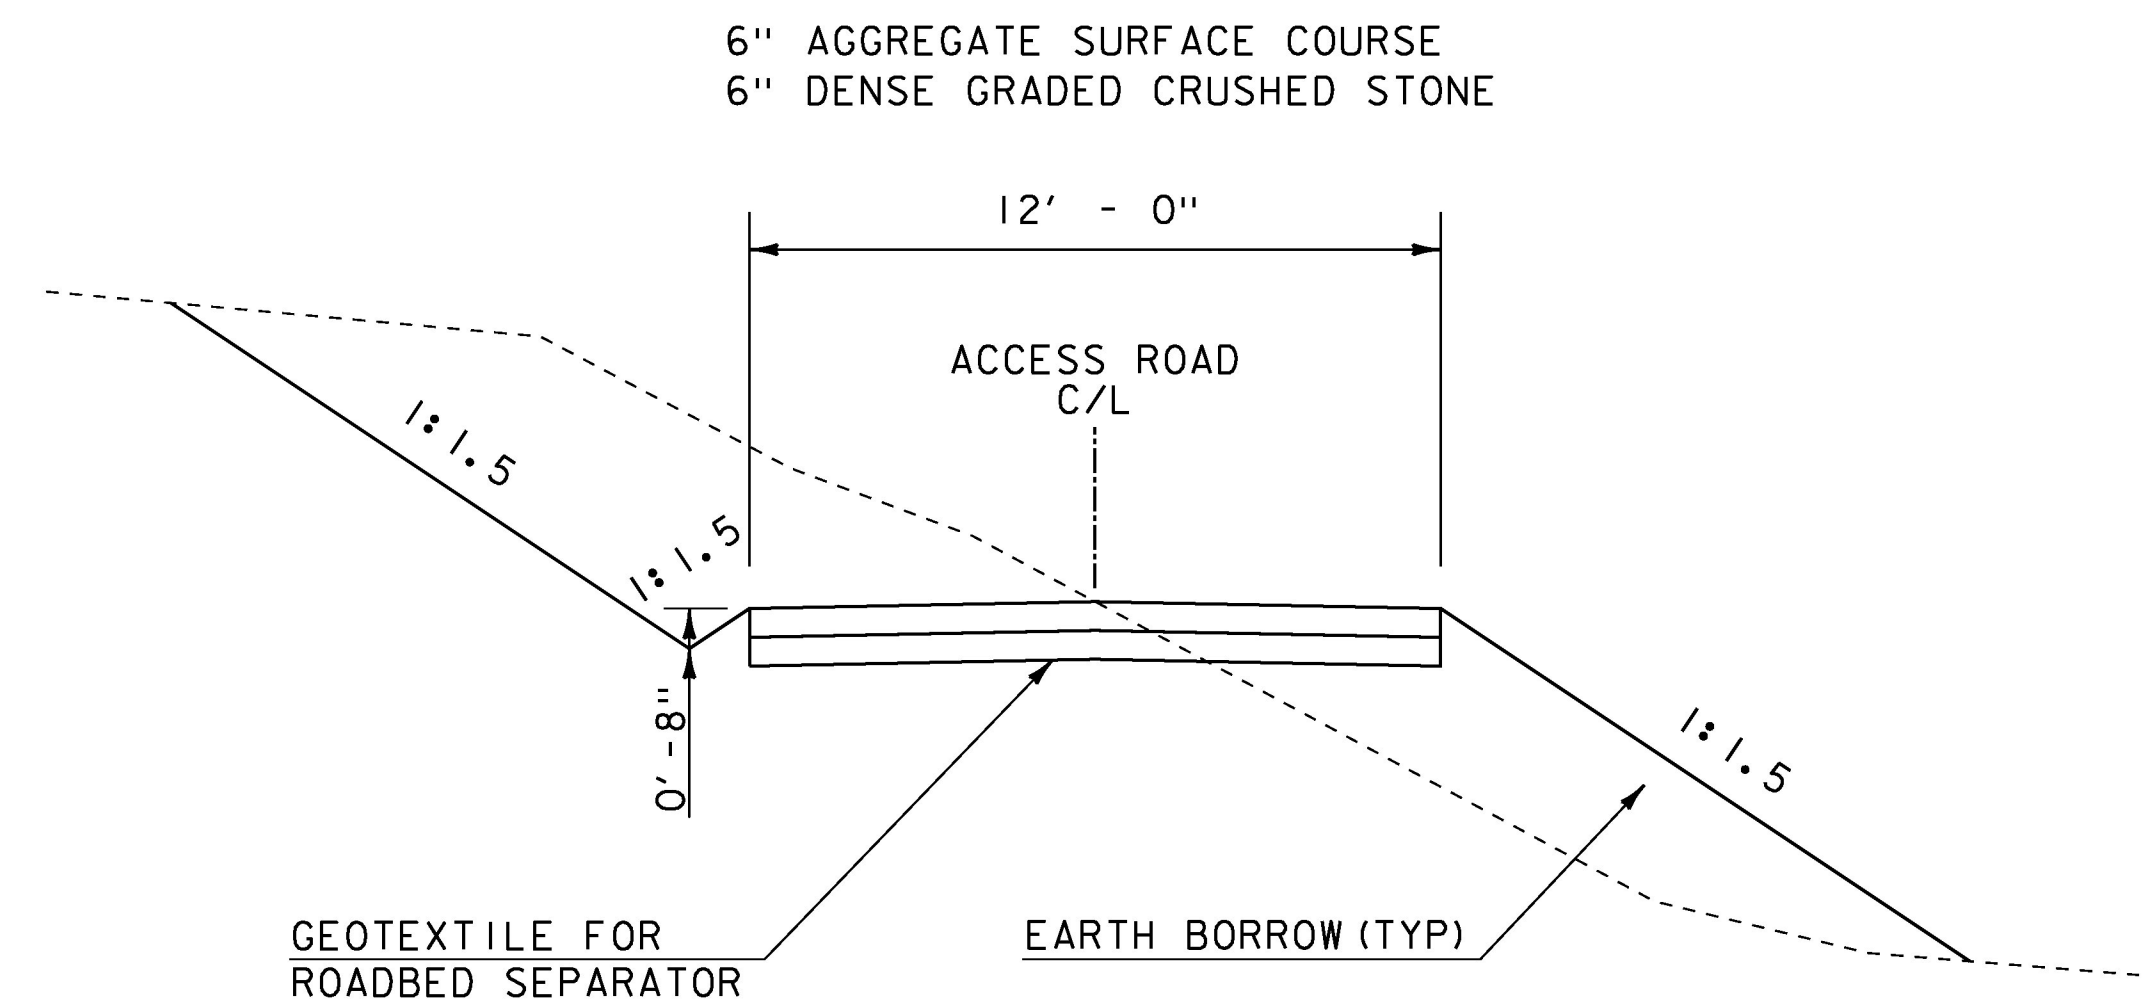

**TYPICAL ACCESS ROAD SECTION**

NOT TO SCALE

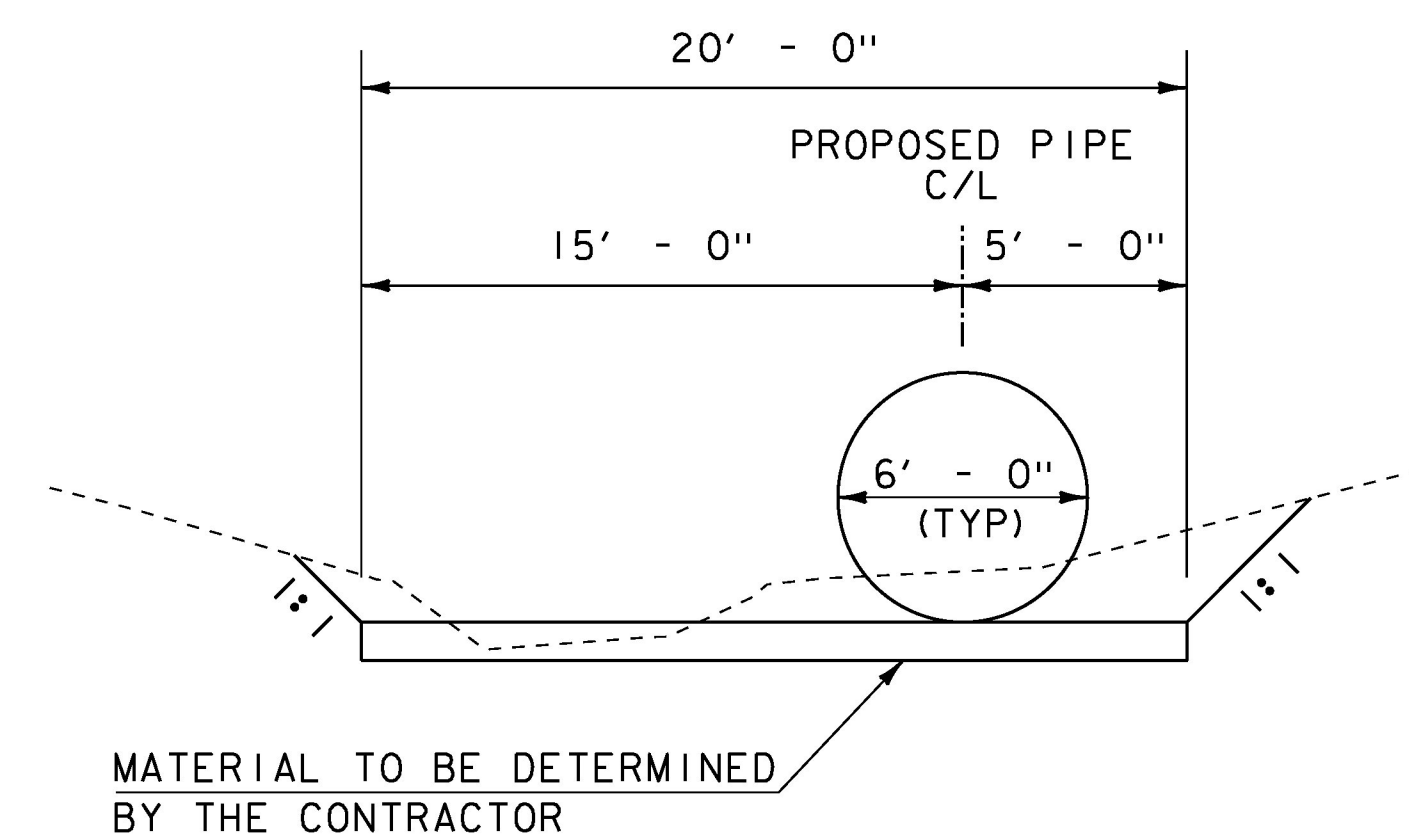

**TYPICAL STAGING AREA  
(RAMMING PAD) SECTION**

NOT TO SCALE

PROJECT NAME:	HIGHGATE
PROJECT NUMBER:	STP SCR(12)
FILE NAME:	d13ci34+typ.dgn
PROJECT LEADER:	B. MARTIN
DESIGNED BY:	A. KEMPTON
TYPICAL SECTIONS SHEET	
PLOT DATE:	14-OCT-2016
DRAWN BY:	A. KEMPTON
CHECKED BY:	M. GAMELIN
SHEET	4 OF 40

### CULVERT NOTES:



1. ITEM 900.640 SPECIAL PROVISION (TRENCHLESS PIPE WITH CEMENT MORTAR LINING)(72" DIAMETER) WILL INCLUDE, BUT IS NOT LIMITED TO THE DESIGN, FABRICATION, DELIVERY, HANDLING, REPAIR AND CONSTRUCTION OF ALL THE CULVERT AND CEMENT MORTAR ELEMENTS.
2. THE REMOVAL AND DISPOSAL OF ALL MATERIAL FROM INSIDE THE TRENCHLESS PIPE WILL BE CONSIDERED INCIDENTAL TO ITEM 900.640 SPECIAL PROVISION (TRENCHLESS PIPE WITH CEMENT MORTAR LINING)(72" DIAMETER).

### HEADWALL NOTES:

1. ITEM 540.10 PRECAST CONCRETE STRUCTURE (SOUTH WALL) AND ITEM 540.10 PRECAST CONCRETE STRUCTURE (NORTH WALL) WILL INCLUDE, BUT ARE NOT LIMITED TO THE DESIGN, FABRICATION, FURNISHING AND CONSTRUCTION OF THE HEADWALLS, WINGWALLS AND FOOTINGS. EACH WALL SHALL BE DESIGNED AND FABRICATED TO THE ELEVATIONS SHOWN ON THE PLANS. THE WALL AND FOOTING THICKNESSES ARE SHOWN FOR REFERENCE ONLY. THE ACTUAL DIMENSIONS WILL BE DEPENDENT ON THE CONTRACTOR.
2. THE CULVERT AND WALL SYSTEM SHALL BE DESIGNED PER THE AASHTO LRFD BRIDGE DESIGN SPECIFICATIONS, 7TH EDITION, DATED 2014, AND ITS LATEST REVISIONS, AND SHALL CONSIDER THE FOLLOWING DESIGN CRITERIA:
  - A. DESIGN LOADING = HL-93
  - B. WEIGHT OF BACKFILL MATERIAL = 140 PCF
  - C. SEE GEOTECHNICAL REPORT FOR FACTORED SOIL BEARING RESISTANCES.
  - D. PRECAST CONCRETE COMPRESSIVE STRENGTH:  $f'c = 5000 \text{ psi}$   
CAST-IN-PLACE CONCRETE COMPRESSIVE STRENGTH:  $f'c = 3500 \text{ psi}$
  - E. REINFORCING STEEL (CAST-IN-PLACE CONCRETE WALLS):  $Fy = 60,000 \text{ psi}$
3. IT SHALL BE NOTED THAT THE SOIL CONDITIONS VARY GREATLY BETWEEN THE NORTH AND SOUTH WALLS. ALL REQUIREMENTS IN THE GEOTECHNICAL REPORT SHALL BE MET.
4. WEEP HOLES IN THE HEADWALLS SHALL BE PLACED APPROXIMATELY EVERY 10'. WEEP HOLES SHALL BE COVERED WITH GEOTEXTILE, OR EQUIVALENT, TO RETAIN BACKFILL MATERIAL AND TO PREVENT ENTRY BY ANIMALS. PAYMENT WILL BE CONSIDERED INCIDENTAL TO ITEM 540.10 PRECAST CONCRETE STRUCTURE.
5. ALL REINFORCING STEEL SHALL HAVE A MINIMUM CLEAR COVER OF 2".
6. REINFORCING STEEL PLACEMENT TOLERANCES SHALL BE AS FOLLOWS:
  - A. SPACING  $\pm 1/2"$
  - B. CLEARANCE  $\pm 1/4"$
7. ALL EXPOSED EDGES OF CONCRETE SHALL BE CHAMFERED 1" X 1".
8. WATER REPELLENT, SILANE SHALL BE FURNISHED IN ACCORDANCE WITH SECTION 514 AND SHALL BE FIELD APPLIED TO ALL EXPOSED EXTERIOR SURFACES OF PRECAST CONCRETE. PAYMENT WILL BE MADE UNDER ITEM 514.10 WATER REPELLENT, SILANE.

PROJECT NAME: HIGHGATE  
PROJECT NUMBER: STP SCRP(12)


FILE NAME: d13ci34def.dgn	PLOT DATE: 14-OCT-2016
PROJECT LEADER: B. MARTIN	DRAWN BY: A. KEMPTON
DESIGNED BY: A. KEMPTON	CHECKED BY: M. GAMELIN
PROJECT NOTES SHEET	SHEET 5 OF 40

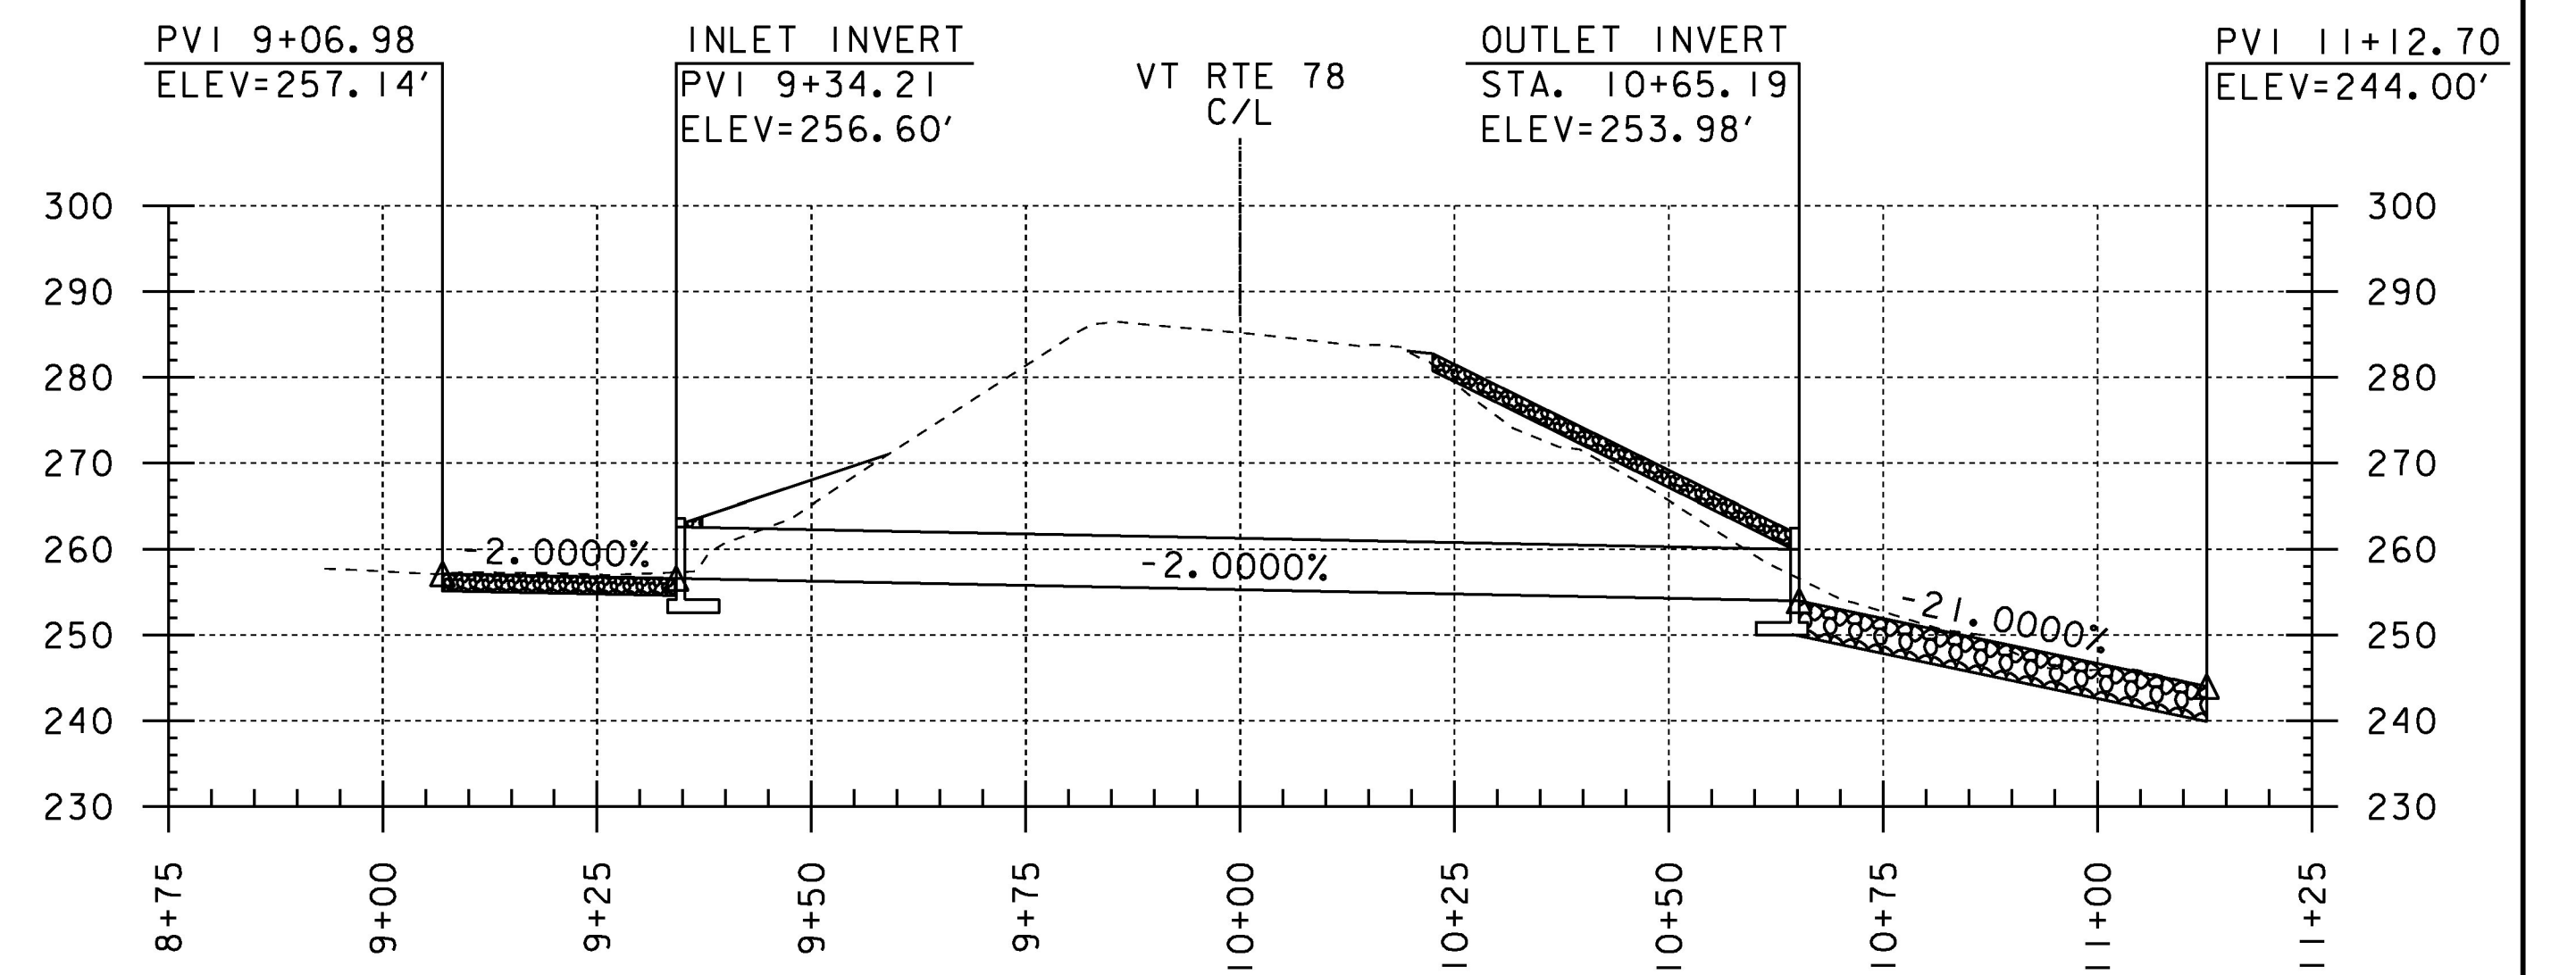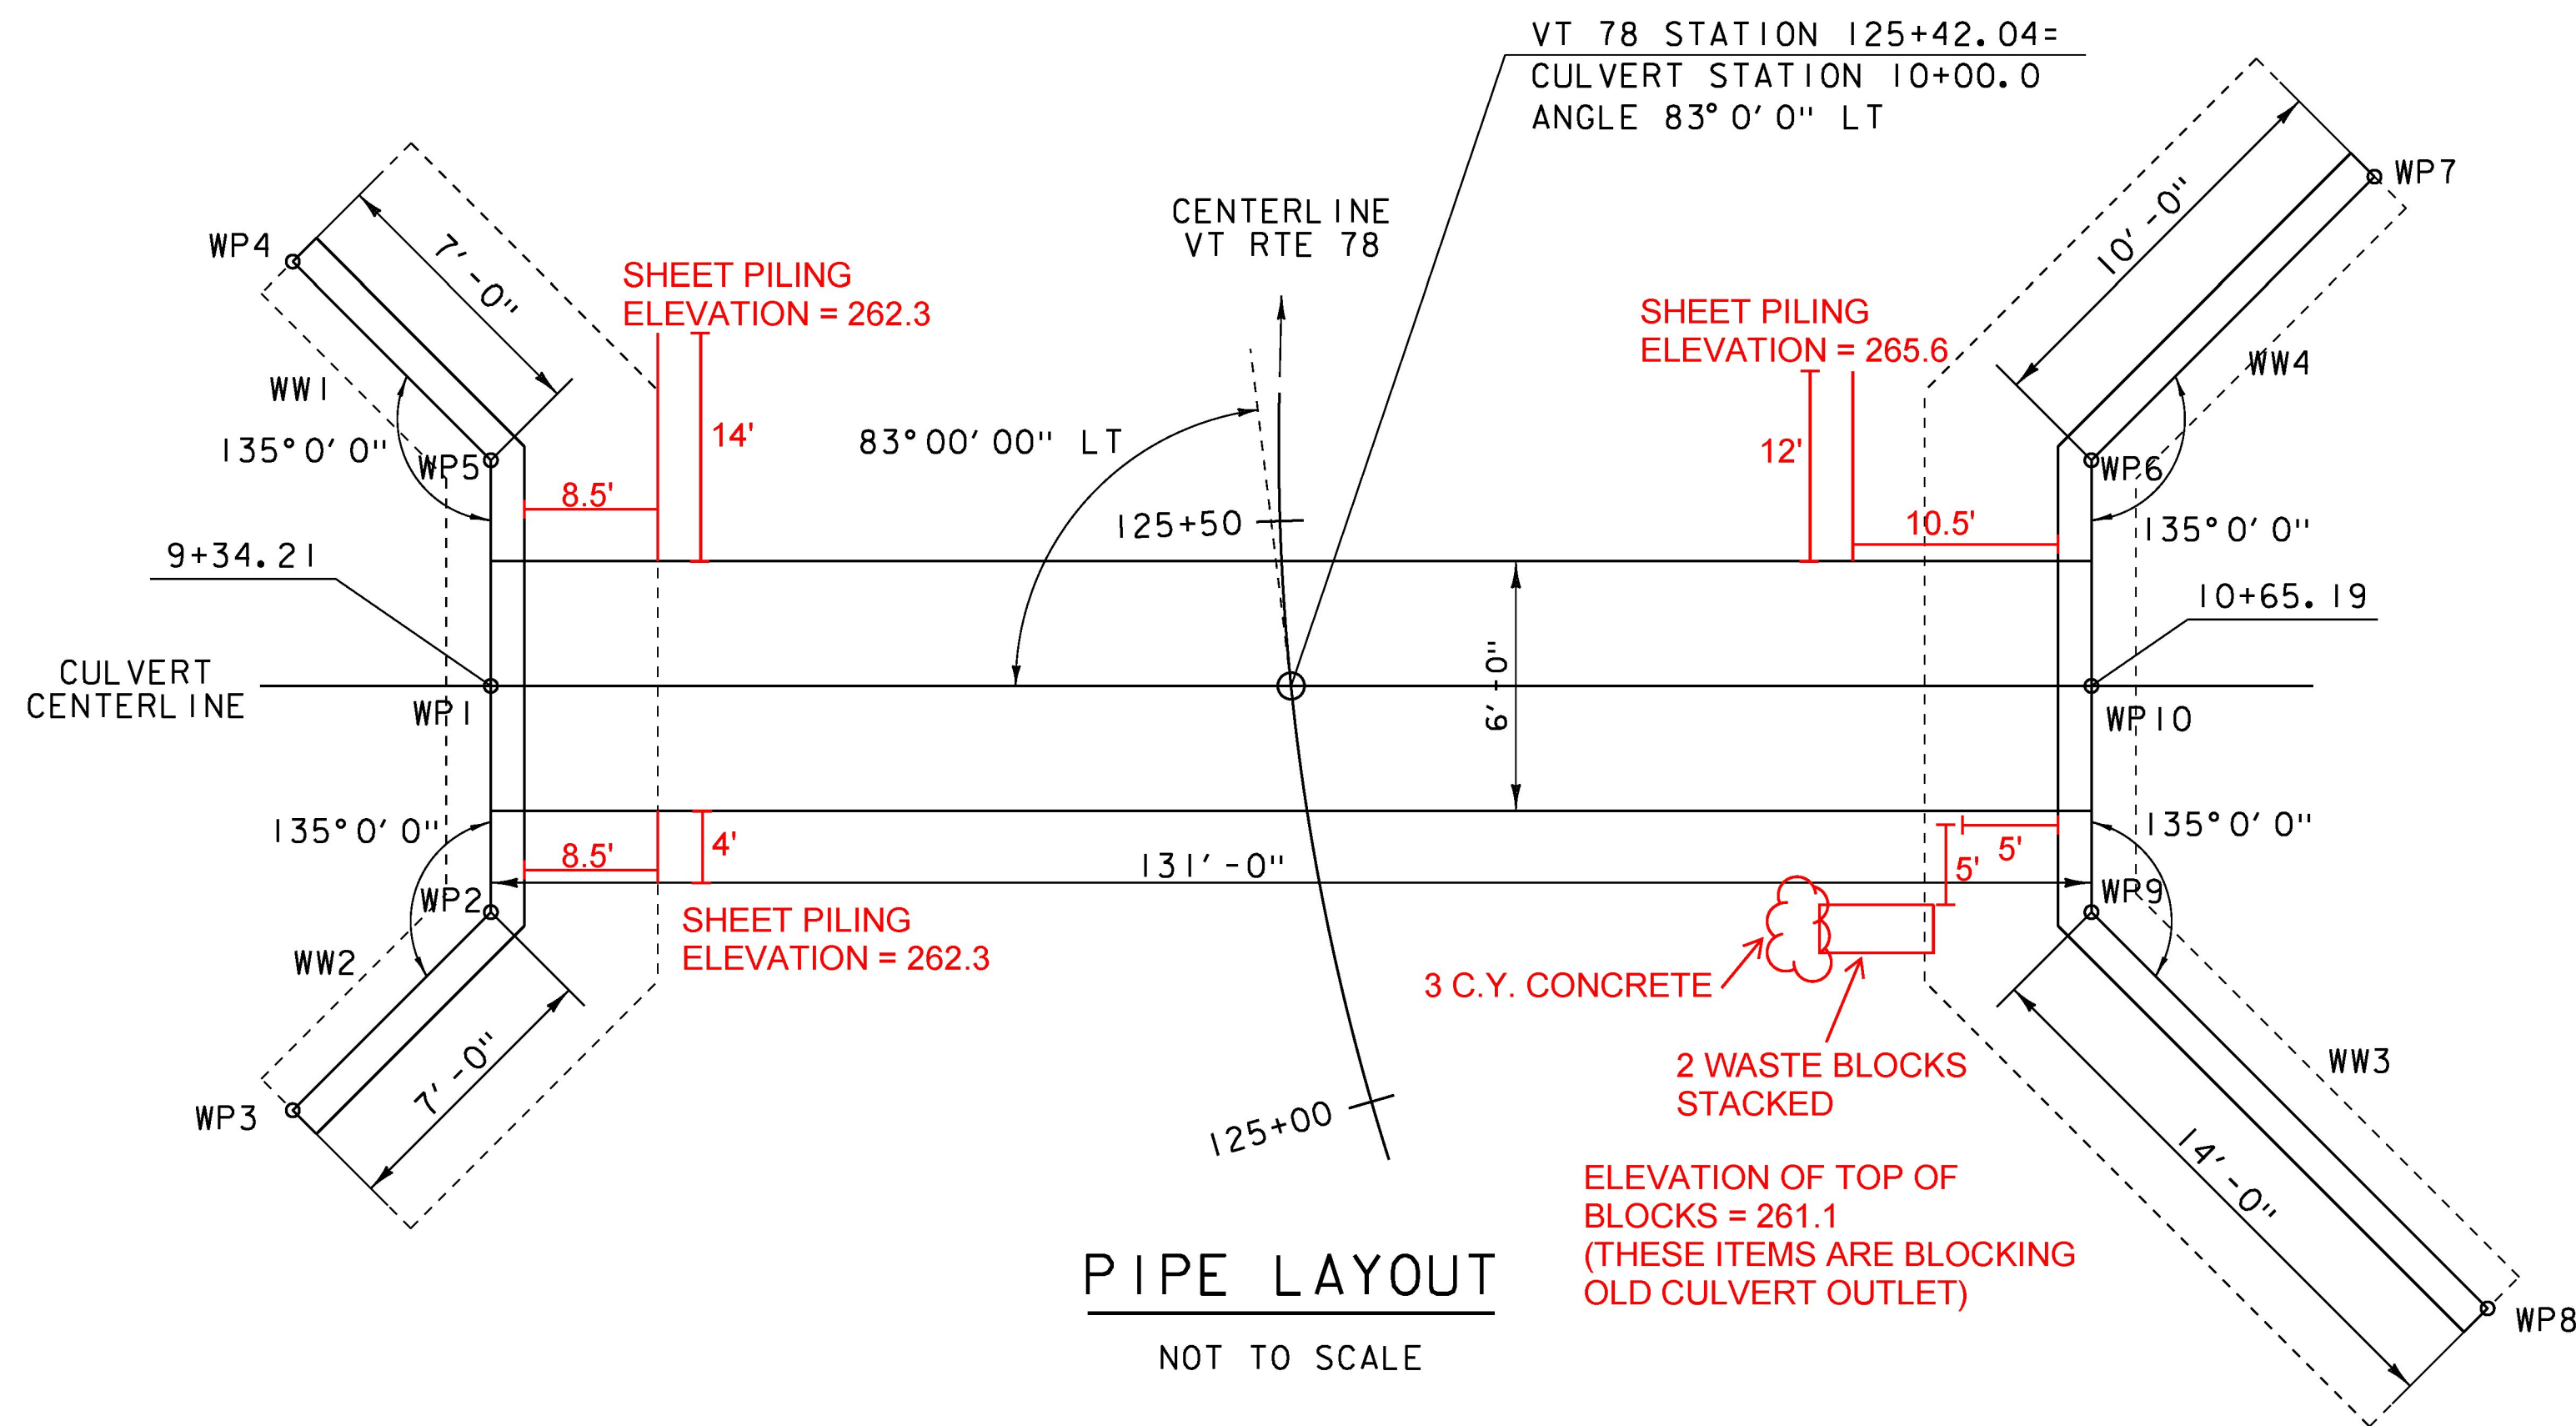

CHANNEL PROFILE

WORKING POINTS  
STATIONS AND OFFSETS


WP#	STATION	OFFSET
WP1	9+34.21	0.00
WP2	9+34.21	R 5.00
WP3	9+29.26	R 9.95
WP4	9+29.26	L 9.95
WP5	9+34.21	L 5.00
WP6	10+65.19	L 5.00
WP7	10+72.26	L 12.07
WP8	10+75.09	R 14.90
WP9	10+65.19	R 5.00
WP10	10+65.19	0.00

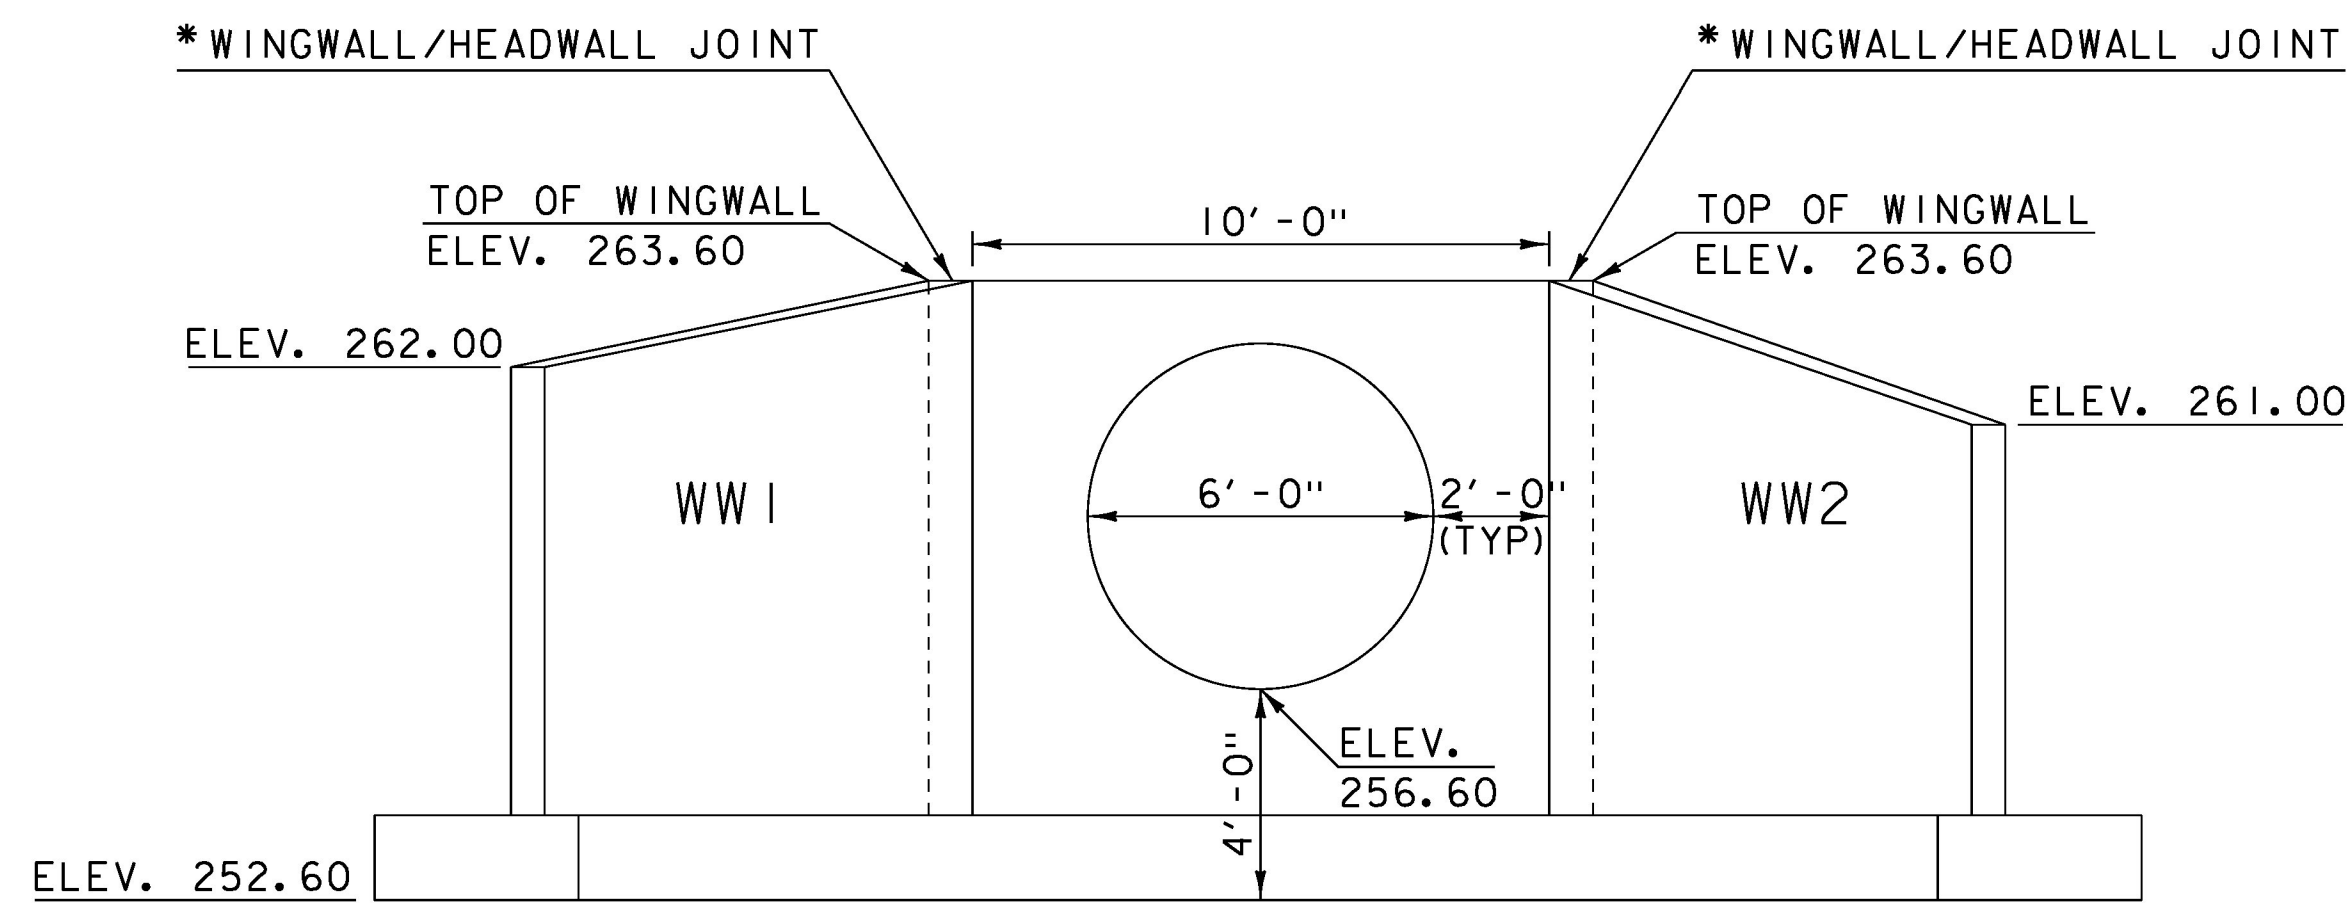

PIPE  
INLET ELEVATION

NOT TO SCALE

* JOINT SHALL BE FABRICATED TO ALLOW ONE INCH OF DIFFERENTIAL SETTLEMENT BETWEEN THE HEADWALL AND WINGWALLS (SEE GEOTECHNICAL REPORT)

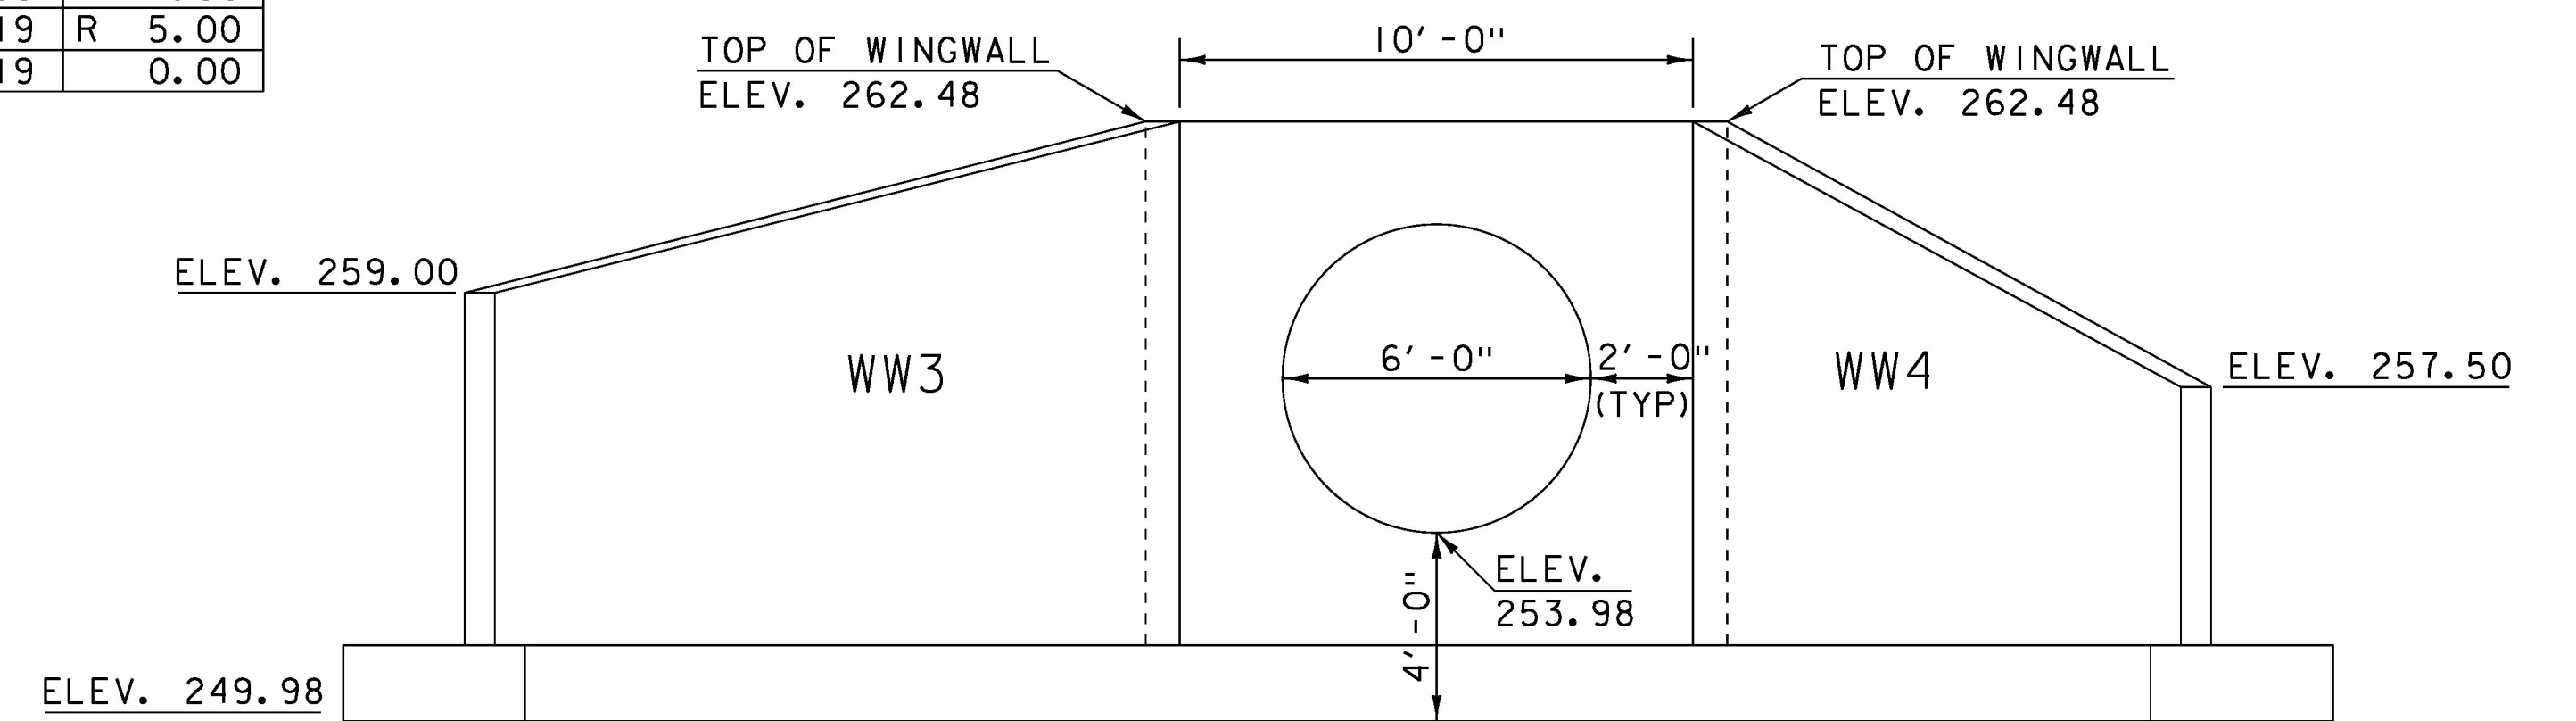


PIPE  
OUTLET ELEVATION

NOT TO SCALE

PROJECT NAME: HIGHGATE  
PROJECT NUMBER: STP SCRPI(2)


FILE NAME: d13ci34def.dgn  
PROJECT LEADER: B. MARTIN  
DESIGNED BY: A. KEMPTON  
DETAIL SHEET

PLOT DATE: 14-OCT-2016  
DRAWN BY: A. KEMPTON  
CHECKED BY: M. GAMELIN  
SHEET 6 OF 40

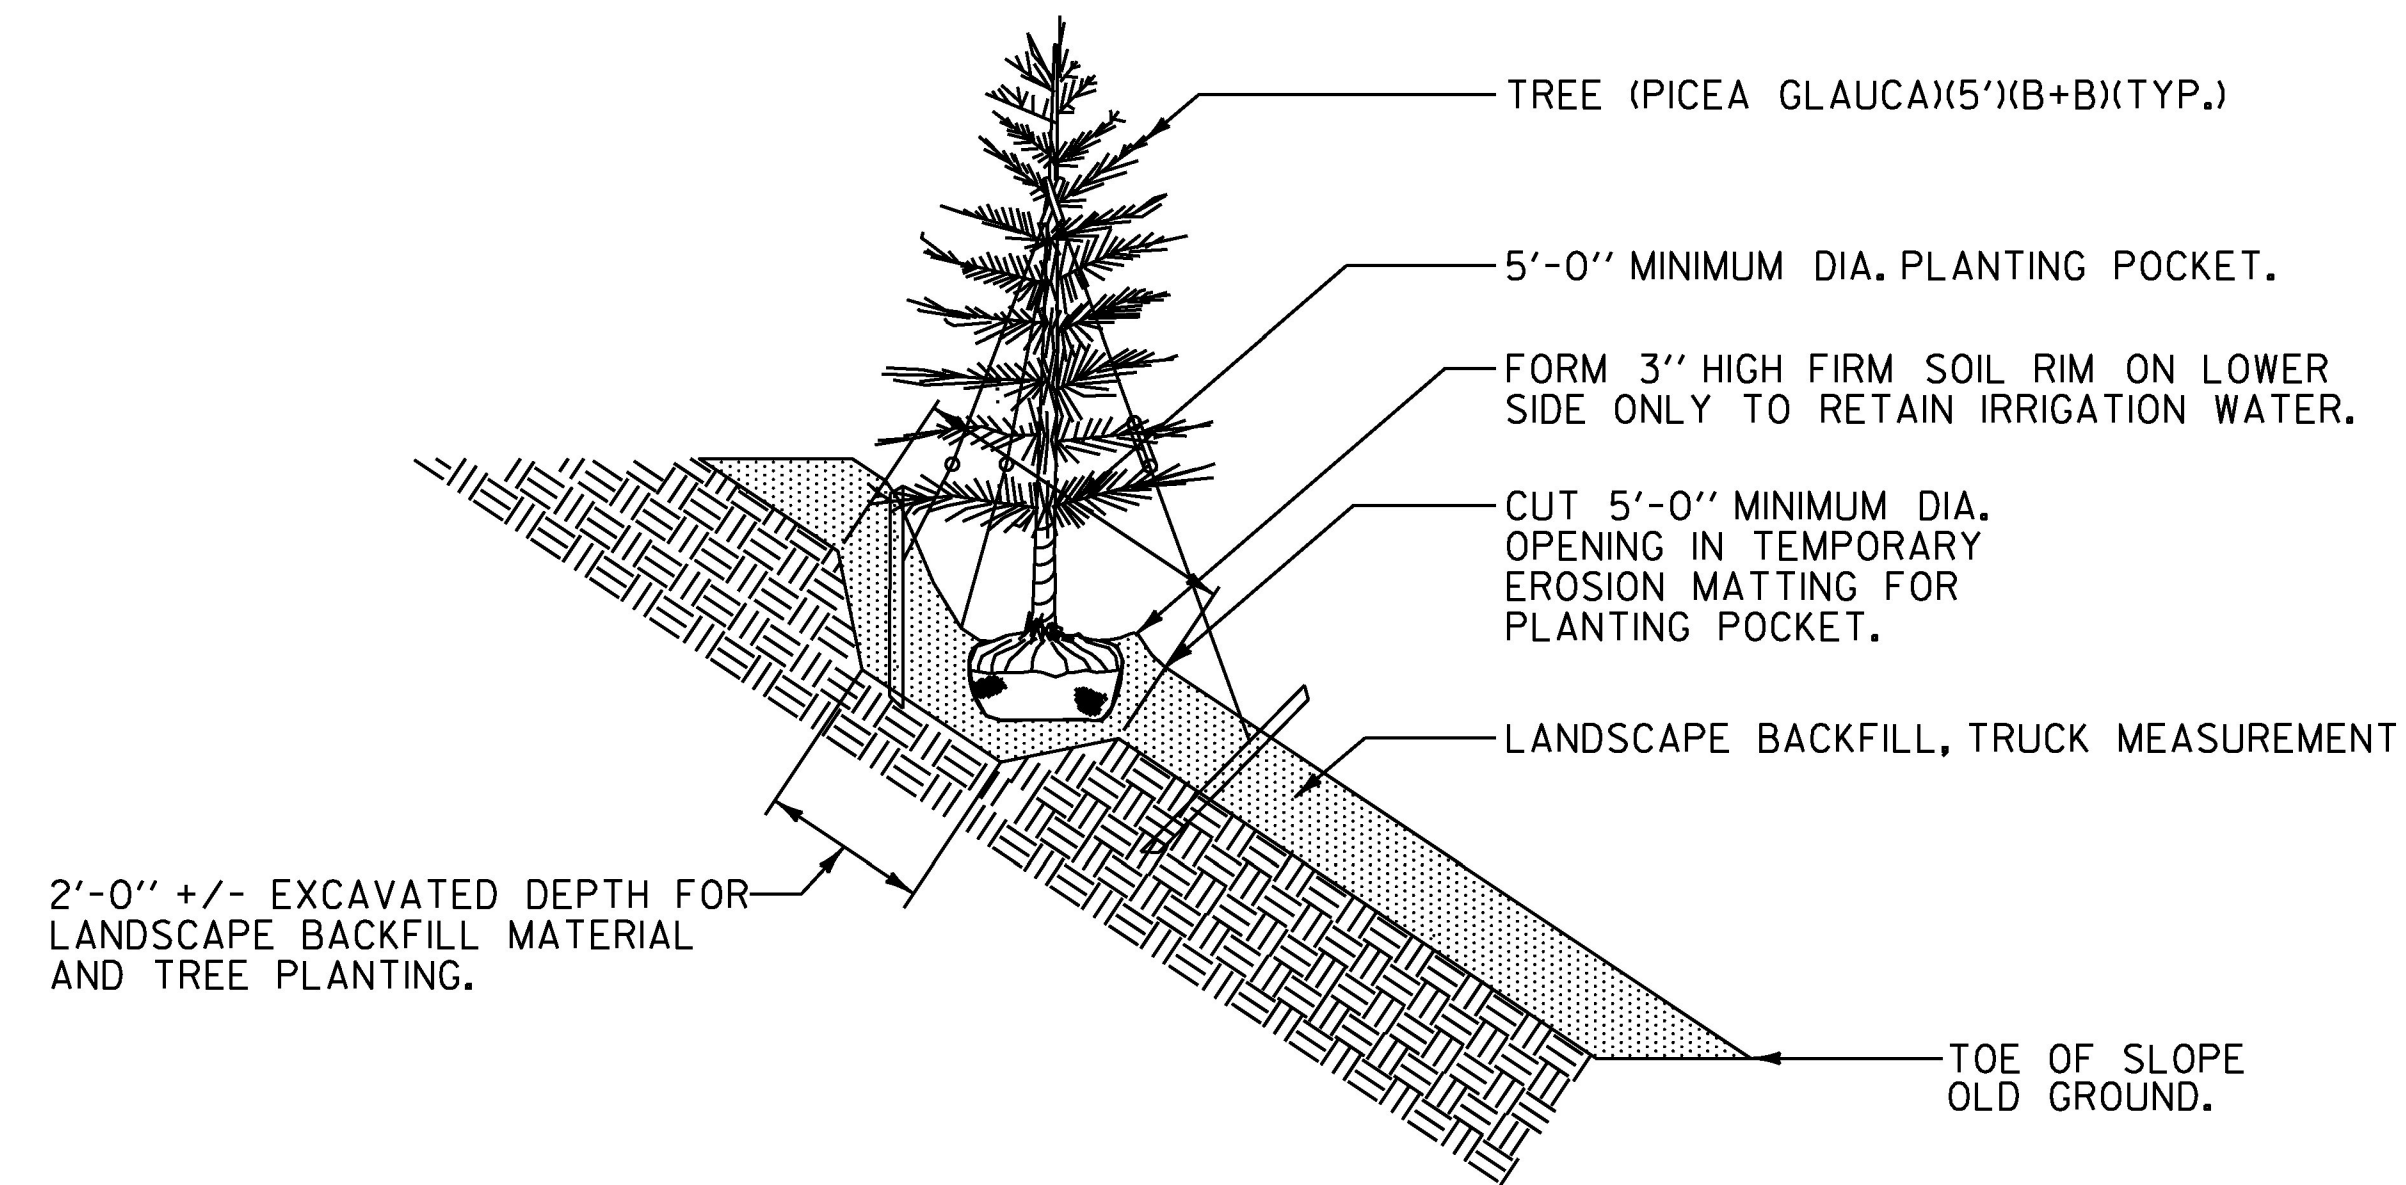

EVERGREEN TREE PLANTING SLOPE DETAIL

NOT TO SCALE

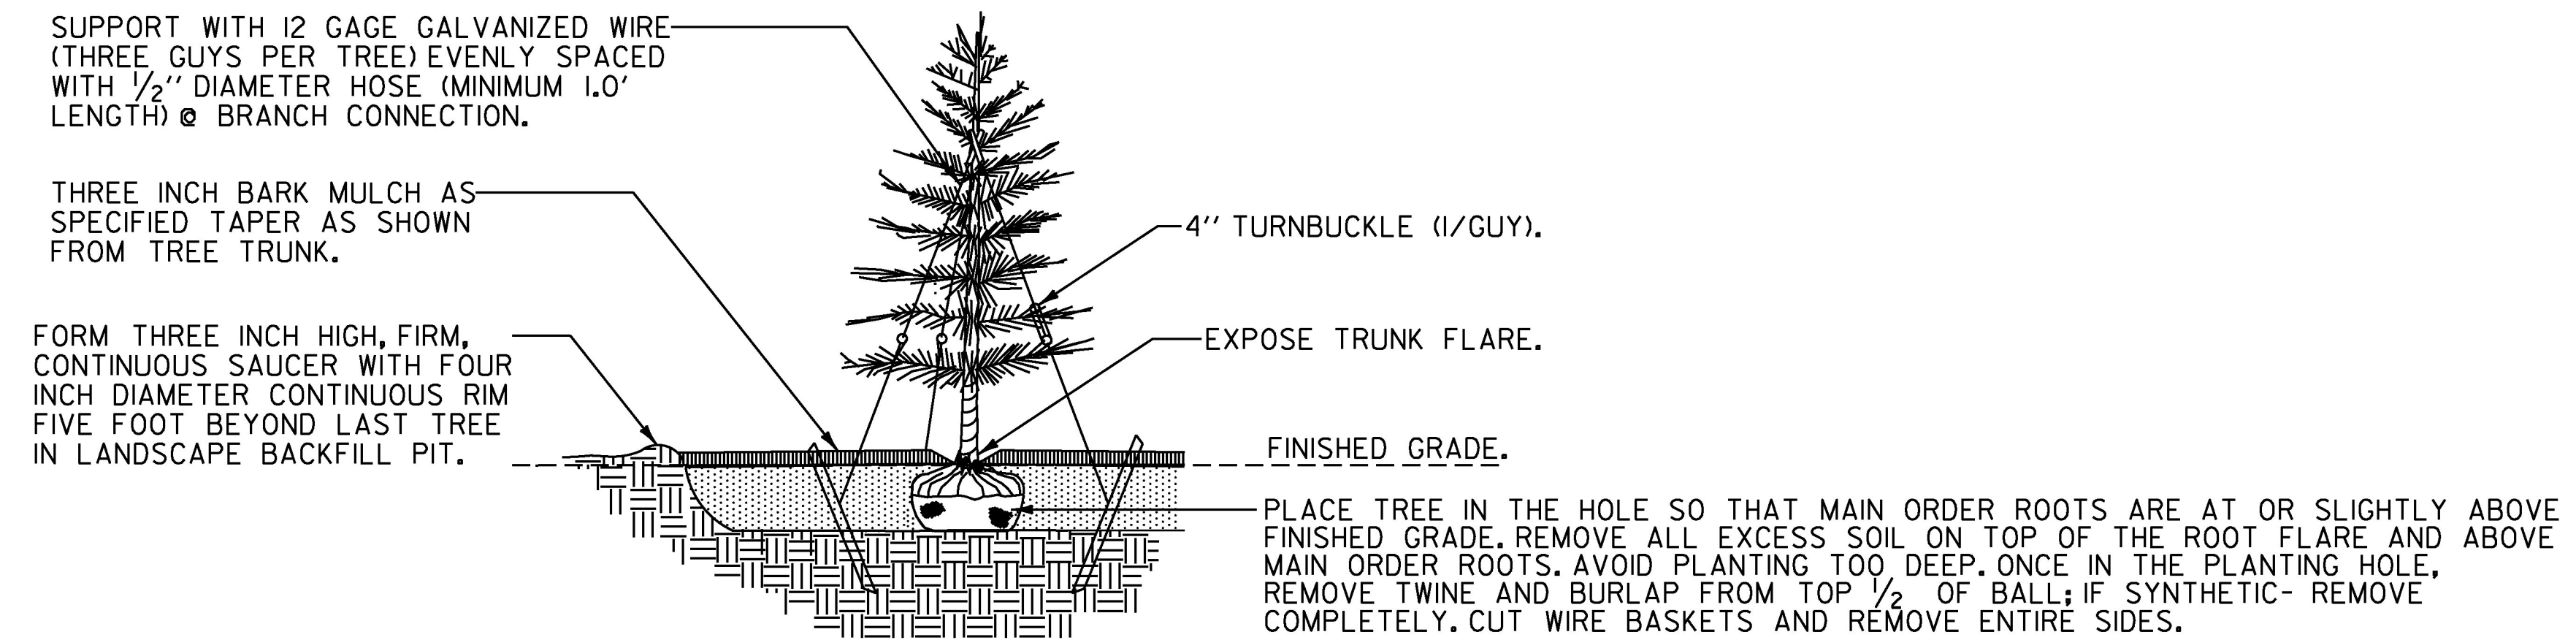

EVERGREEN TREE PLANTING DETAIL

NOT TO SCALE

**NOTES:**

1. ANTI-DESICCANT SPRAY SHALL BE APPLIED TO ALL EVERGREENS PER MANUFACTURER SPECIFICATIONS.
2. COMPLETELY REMOVE ALL GUY-WIRES AND TURNBUCKLE ONE YEAR AFTER PLANTING.

**GENERAL LANDSCAPE NOTES:**

1. **ORGANIC MATERIAL**  
TOPSOIL, COMPOST AND NATIVE EXISTING SOIL SHALL BE TESTED AT AN APPROVED LAB PRIOR TO DELIVERY ON SITE AND INSTALLATION. ORGANIC MATTER SHALL BE A MINIMUM OF FIVE PERCENT.
2. **TOPSOIL BACK FILL MIX**  
TAMP TO REMOVE AIR POCKETS AND WATER THOROUGHLY IMMEDIATELY AFTER PLANTING, TO RECEIVE A MINIMUM OF 10 GALLONS AT EACH WATERING, TWICE WEEKLY DURING THE ESTABLISHMENT PERIOD. UNSUITABLE NATIVE MATERIAL SHALL BE REPLACED WITH IMPORTED APPROVED TOPSOIL AS DIRECTED BY ENGINEER.

PROJECT NAME:	HIGHGATE
PROJECT NUMBER:	STP_SCRP(12)
FILE NAME:	d13ci34frm.dgn
PROJECT LEADER:	B. MARTIN
DESIGNED BY:	A. AGRAWAL
LANDSCAPE DETAILS SHEET	
PLOT DATE:	14-OCT-2016
DRAWN BY:	A. AGRAWAL
CHECKED BY:	A. KEMPTON
SHEET	7 OF 40

GPS CONTROL POINTS


HVCTRL #1  
 FSO B 1998  
 NORTH = 888880.200  
 EAST = 1485628.790  
 ELEV. = 230.92

THE STATION IS LOCATED APPROXIMATELY 9.7 KM (6.00 MI) SOUTH OF THE U.S. AND CANADA BORDER, 4.43 KM (2.75 MI) WEST OF HIGHGATE CENTER, 2.9 KM (1.80 MI) EAST OF SWANTON, 1.6 KM (1.00 MI) EAST OF INTERSTATE HIGHWAY 89 AND IS AT THE HIGHGATE/FRANKLIN COUNTY STATE AIRPORT. TO REACH THE STATION FROM THE JUNCTION OF INTERSTATE HIGHWAY 89 (EXIT 21) AND STATE HIGHWAY 78, PROCEED NORTHEAST 1.8 KM (1.10 MI) TO A ROAD ON THE LEFT LEADING TO THE AIRPORT. TURN LEFT AND PROCEED NORTH 0.89 KM (0.55 MI) ALONG THE AIRPORT ACCESS ROAD TO THE GATE ON THE LEFT, SOUTH OF THE TERMINAL. TURN LEFT AND PROCEED THROUGH THE GATE WEST 0.2 KM (0.10 MI) ACROSS THE APRON AND ALONG TAXIWAY ALPHA TO THE JUNCTION OF TAXIWAY ALPHA AND RUNWAY 1-19. PROCEED DIRECTLY ACROSS RUNWAY 1-19 AND THEN PROCEED APPROXIMATELY 80 M (262.5 FT) IN A WEST SOUTHWESTERLY DIRECTION TO THE STATION SOUTH OF A SIGN MARKED-- NO UNAUTHORIZED PERSONNEL BEYOND THIS POINT--. THE STATION IS A STANDARD NGS DISK STAMPED--FSO B 1998--, SET IN THE TOP OF A ROUND CONCRETE MONUMENT 0.3 M (1.0 FT) IN DIAMETER, WITH A STEEL ROD IMBEDDED IN THE CONCRETE AND SET FLUSH WITH THE GROUND. THE STATION IS LOCATED 78.30 M (256.89 FT) ON A MAGNETIC COMPASS BEARING OF SOUTH 81 DEGREES WEST FROM A RUNWAY LIGHT ACROSS RUNWAY 1-19 FROM TAXIWAY ALPHA, 63.30 M (207.68 FT) ON A MAGNETIC COMPASS BEARING OF NORTH 85 DEGREES WEST FROM A SLOPE INDICATOR LIGHT, 22.40 M (73.49 FT) ON A MAGNETIC COMPASS BEARING OF SOUTH 80 DEGREES EAST FROM THE CENTERLINE OF A DIRT ACCESS ROAD, AND 18.13 M (59.48 FT) ON A MAGNETIC COMPASS BEARING OF SOUTH 05 DEGREES WEST FROM A SIGN MARKED-- NO UNAUTHORIZED PERSONNEL BEYOND THIS POINT.


HVCTRL #2  
 S 48  
 NORTH = 886449.590  
 EAST = 1487636.010  
 ELEV. = 238.250

DESCRIBED BY NATIONAL GEODETIC SURVEY 1978  
 1.85 MI NE FROM SWANTON. 1.85 MILES EAST ALONG STATE HIGHWAY 78 FROM THE POST OFFICE AT SWANTON, AT THE T-JUNCTION OF A PAVED ROAD LEADING NORTHWEST TO THE FRANKLIN COUNTY STATE AIRPORT, 75.7 FT. NORTHWEST OF THE CENTER LINE OF THE HIGHWAY, 27.2 FT. NORTHEAST OF THE CENTER LINE OF THE ROAD, 101.5 FT. NORTH OF AND ACROSS THE HIGHWAY FROM POWER POLE 8, 57.9 FT. NORTHEAST OF AND ACROSS THE ROAD FROM A STOP SIGN, 5.5 FT. SOUTHEAST OF A POWER POLE. THE DISK IS 4-INCHES BELOW THE SURFACE OF THE GROUND, ACCESS TO WHICH IS HAD THROUGH A 4-INCH PLASTIC SCREW PLUG. ABOUT LEVEL WITH HIGHWAY. 3 FEET NORTHWEST OF A WITNESS POST.

TRAVERSE TIES

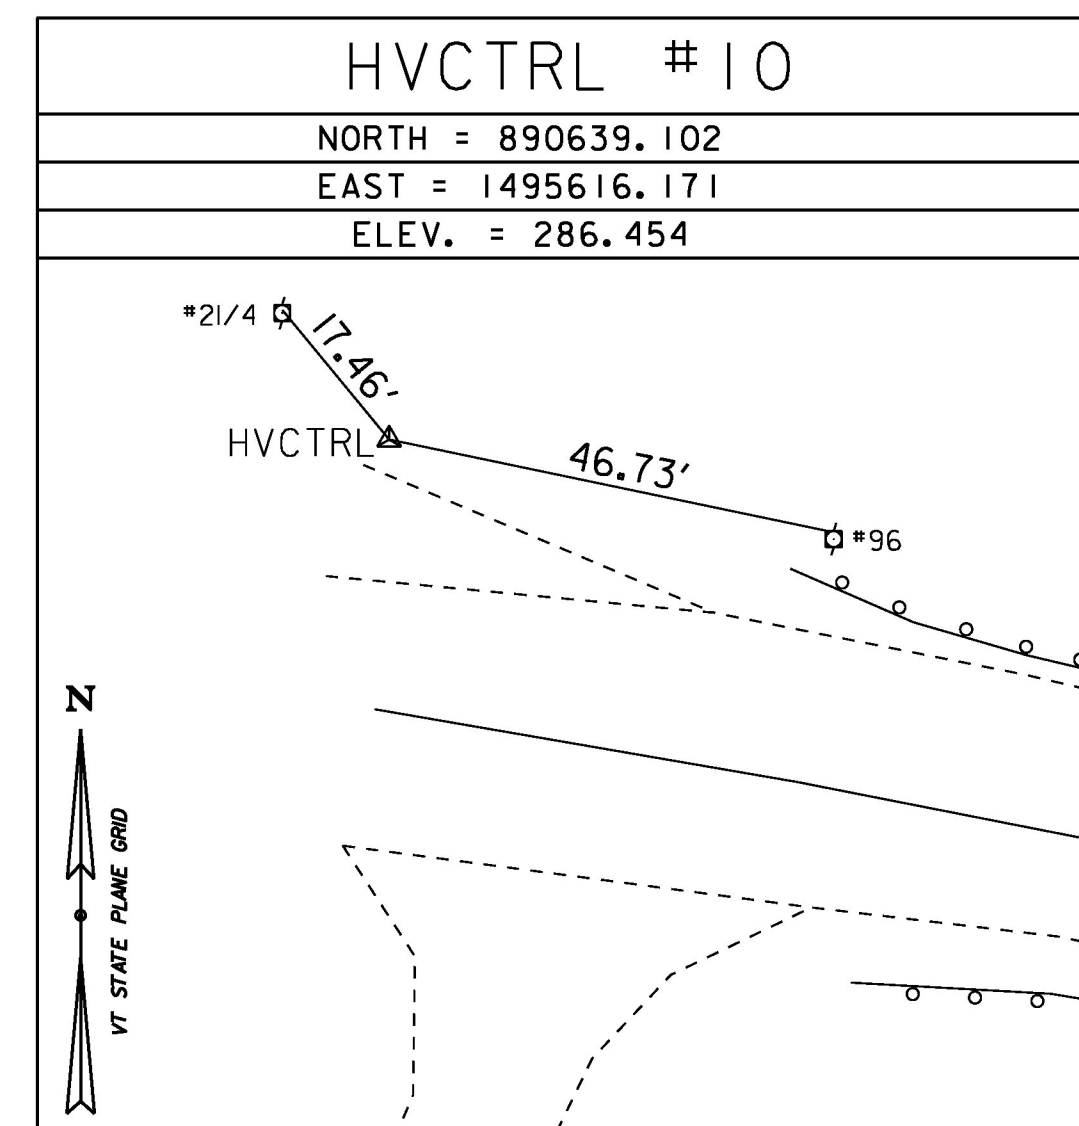


HVCTRL #10  
 NORTH = 890639.102  
 EAST = 1495616.171  
 ELEV. = 286.454

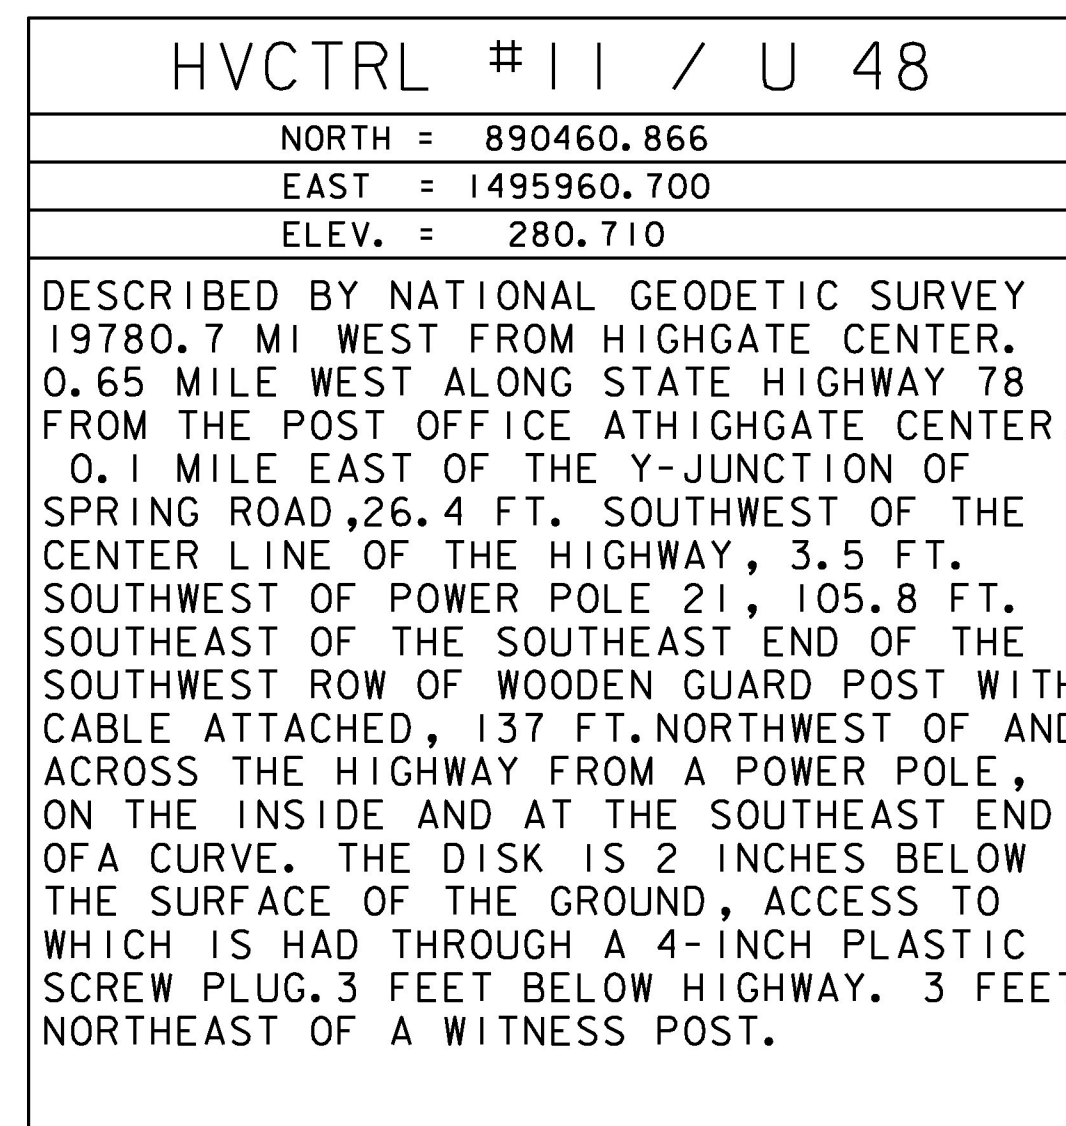


HVCTRL #11 / U 48  
 NORTH = 890460.866  
 EAST = 1495960.700  
 ELEV. = 280.710


DESCRIBED BY NATIONAL GEODETIC SURVEY 1978. 0.7 MI WEST FROM HIGHGATE CENTER. 0.65 MILE WEST ALONG STATE HIGHWAY 78 FROM THE POST OFFICE AT HIGHGATE CENTER, 0.1 MILE EAST OF THE Y-JUNCTION OF SPRING ROAD, 26.4 FT. SOUTHWEST OF THE CENTER LINE OF THE HIGHWAY, 3.5 FT. SOUTHWEST OF POWER POLE 21, 105.8 FT. SOUTHEAST OF THE SOUTHWEST END OF THE SOUTHWEST ROW OF WOODEN GUARD POST WITH CABLE ATTACHED, 137 FT. NORTHWEST OF AND ACROSS THE HIGHWAY FROM A POWER POLE, ON THE INSIDE AND AT THE SOUTHWEST END OF A CURVE. THE DISK IS 2 INCHES BELOW THE SURFACE OF THE GROUND, ACCESS TO WHICH IS HAD THROUGH A 4-INCH PLASTIC SCREW PLUG. 3 FEET BELOW HIGHWAY. 3 FEET NORTHEAST OF A WITNESS POST.

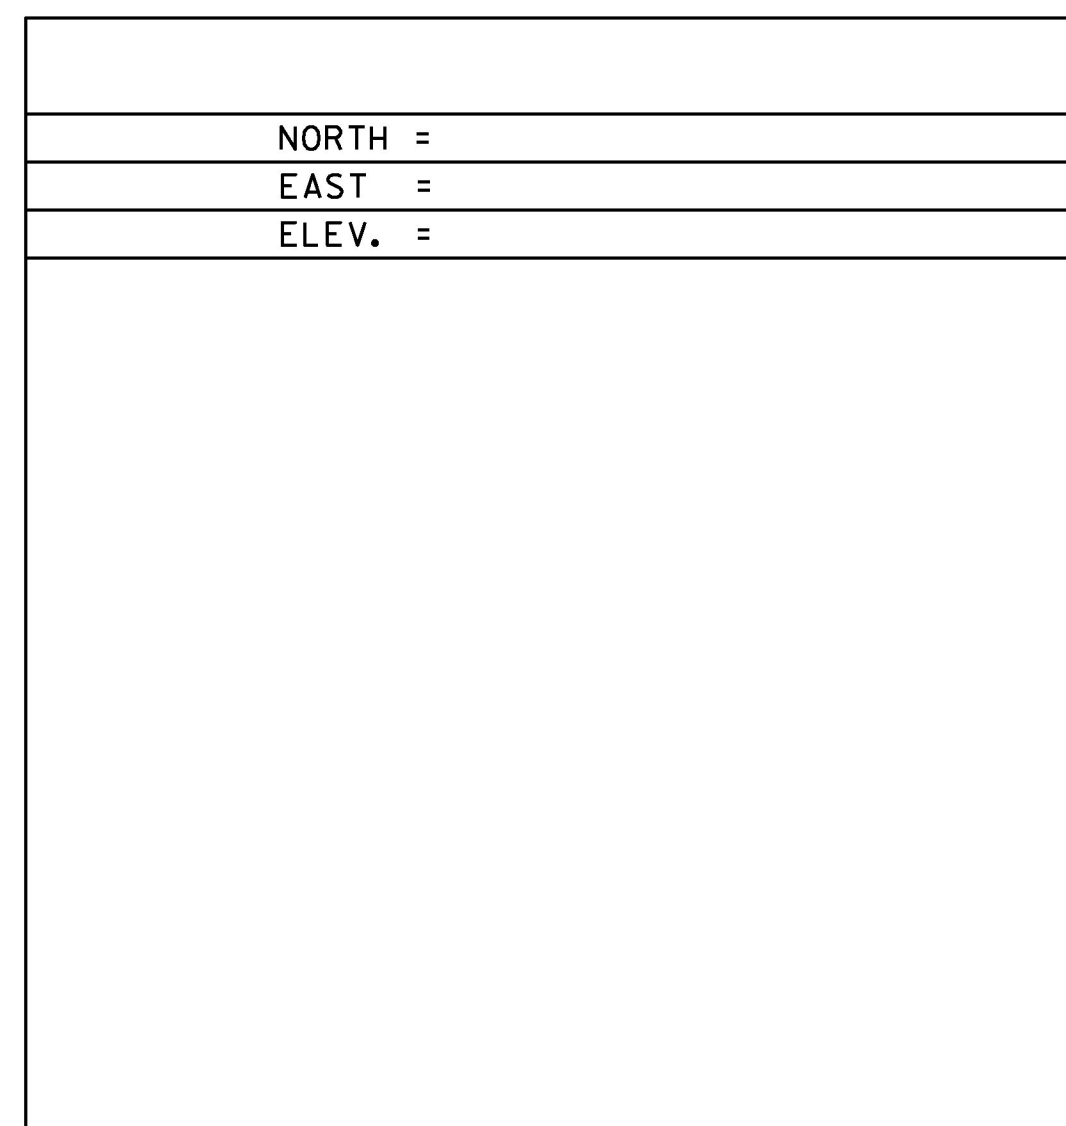

NORTH =  
 EAST =  
 ELEV. =

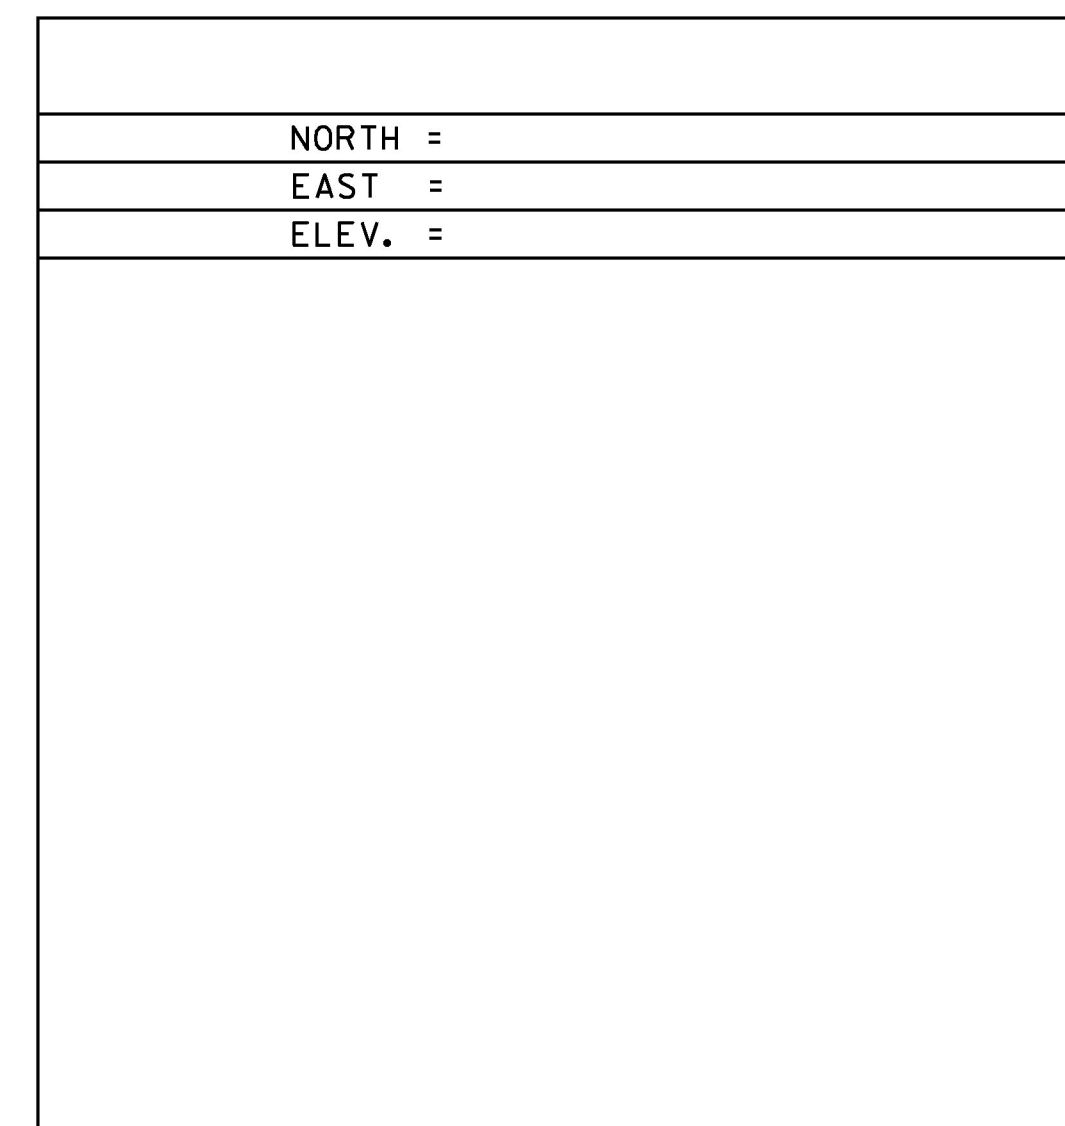


NORTH =  
 EAST =  
 ELEV. =

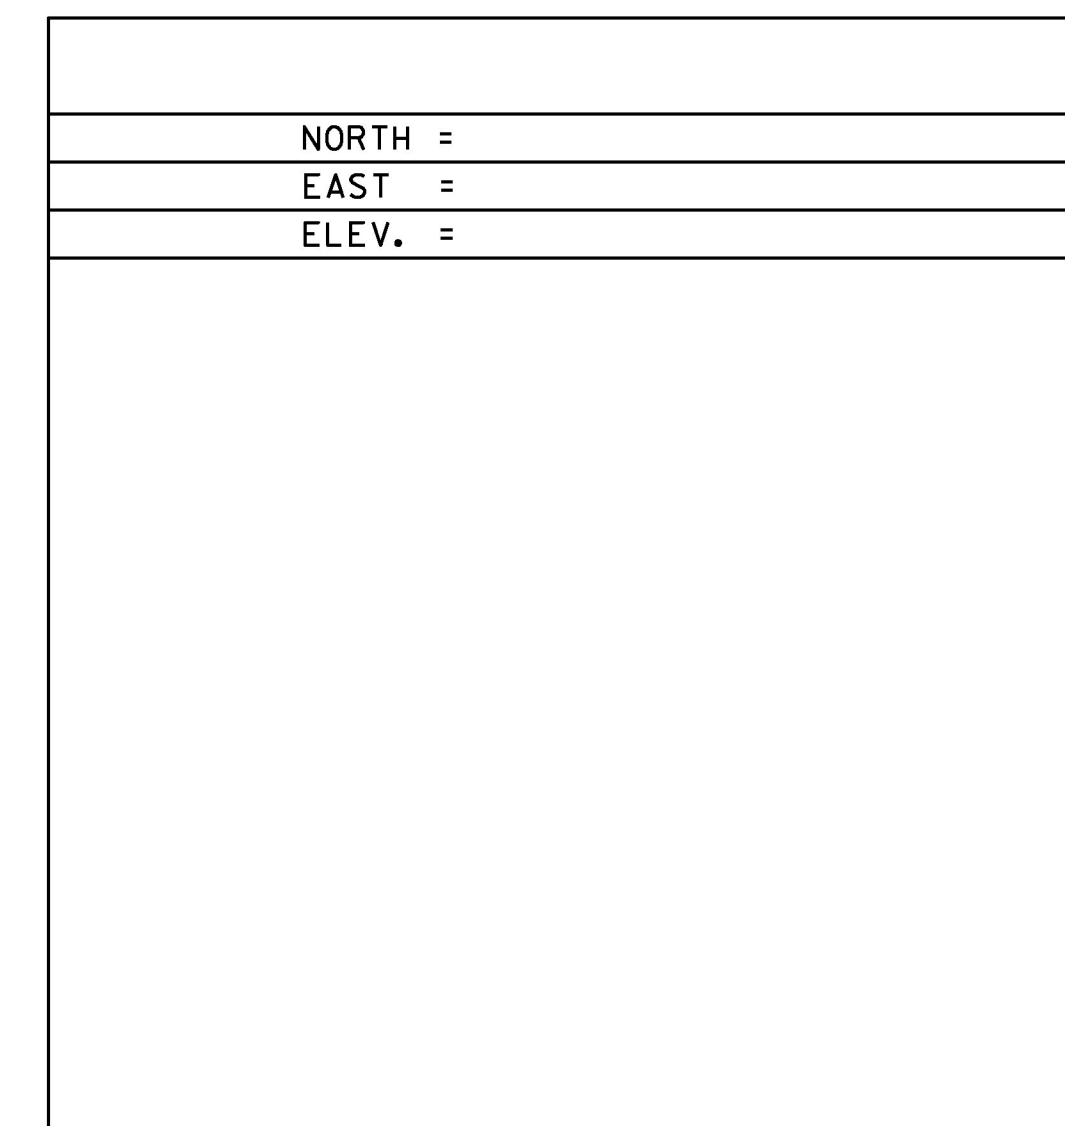


NORTH =  
 EAST =  
 ELEV. =


ALIGNMENT TIES

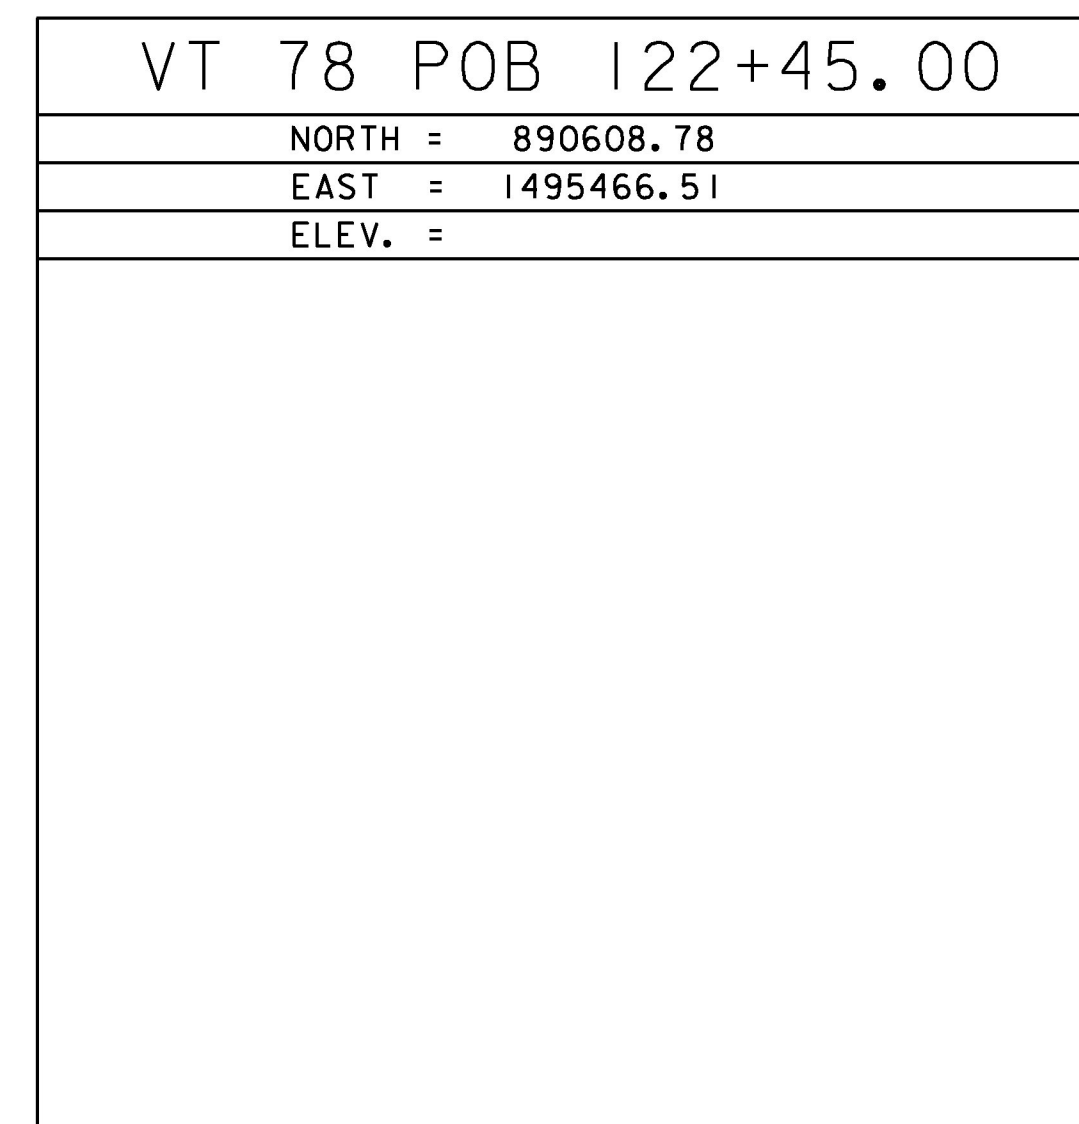


VT 78 POB 122+45.00  
 NORTH = 890608.78  
 EAST = 1495466.51  
 ELEV. =

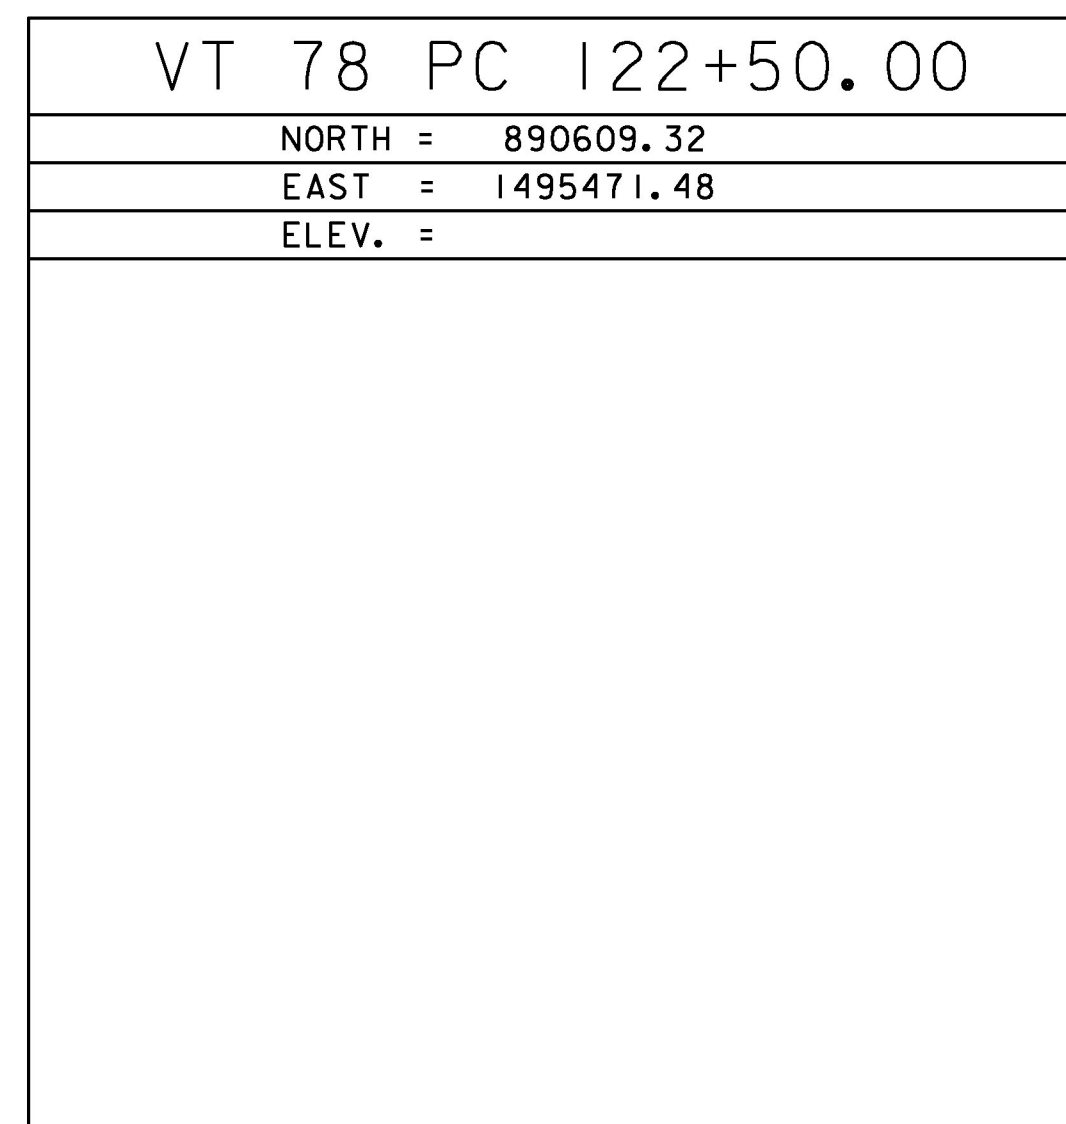


VT 78 PC 122+50.00  
 NORTH = 890609.32  
 EAST = 1495471.48  
 ELEV. =

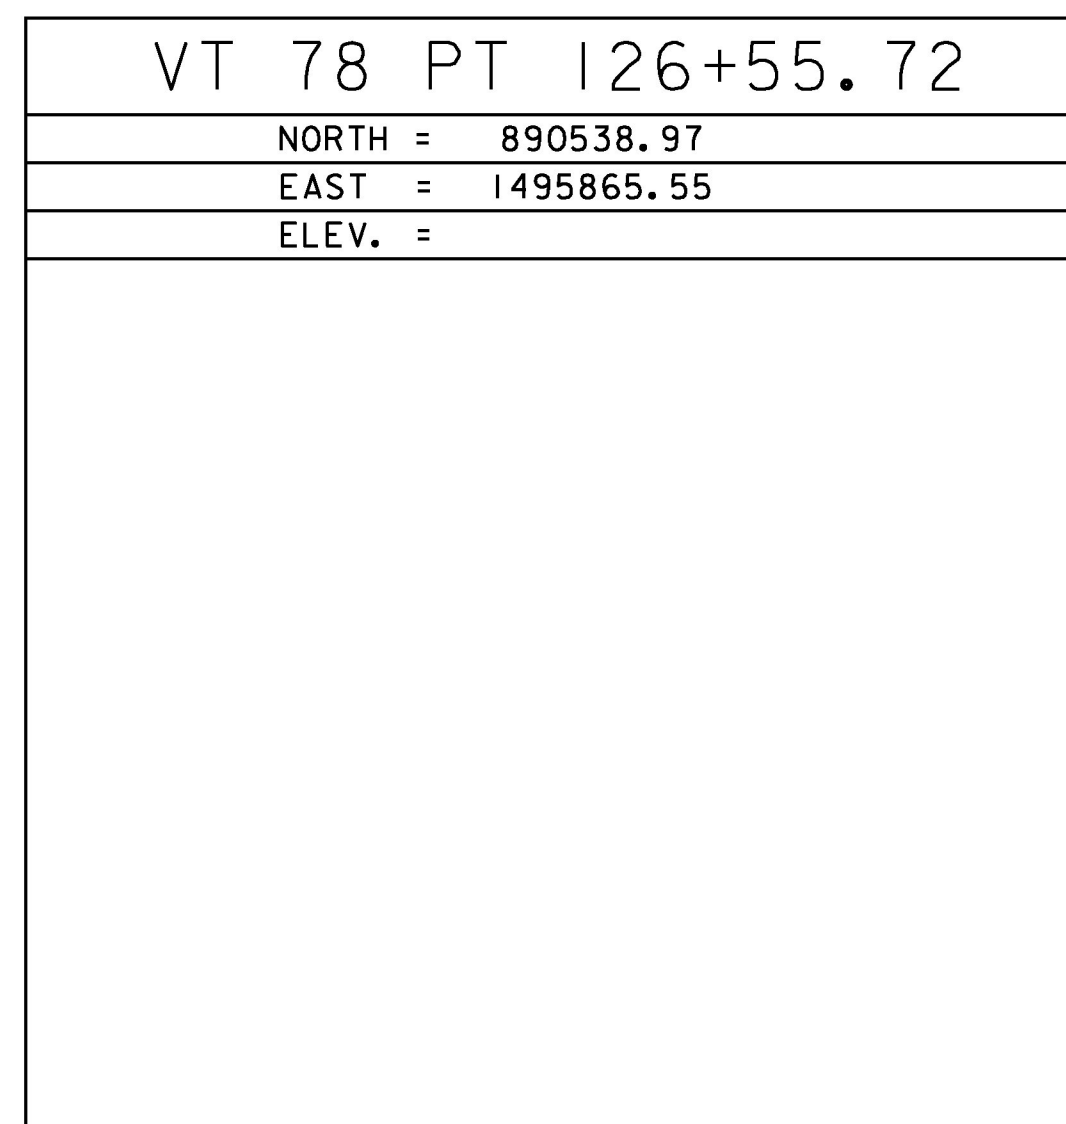

VT 78 PT 126+55.72  
 NORTH = 890538.97  
 EAST = 1495865.55  
 ELEV. =

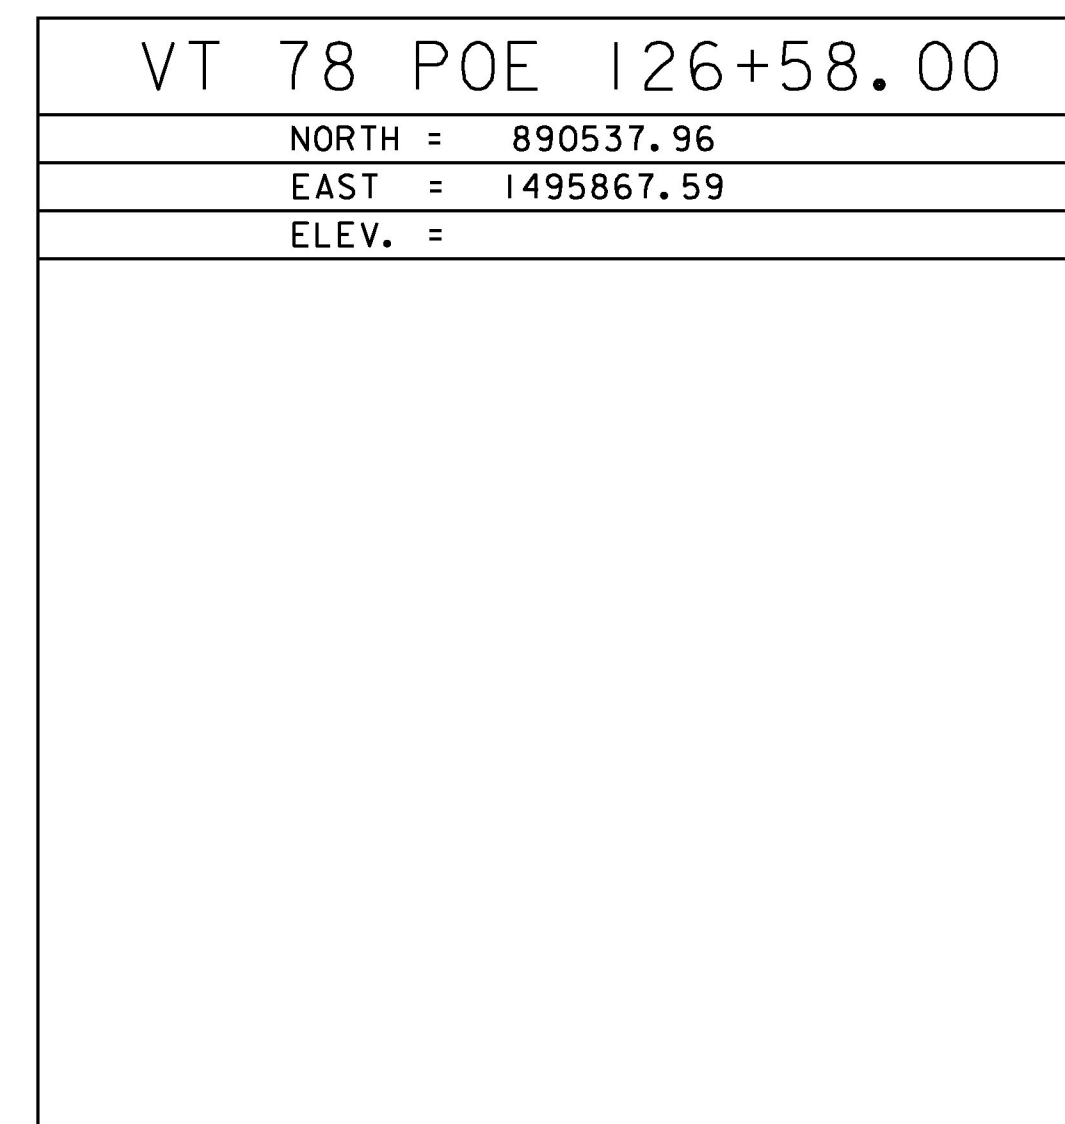

VT 78 POE 126+58.00  
 NORTH = 890537.96  
 EAST = 1495867.59  
 ELEV. =

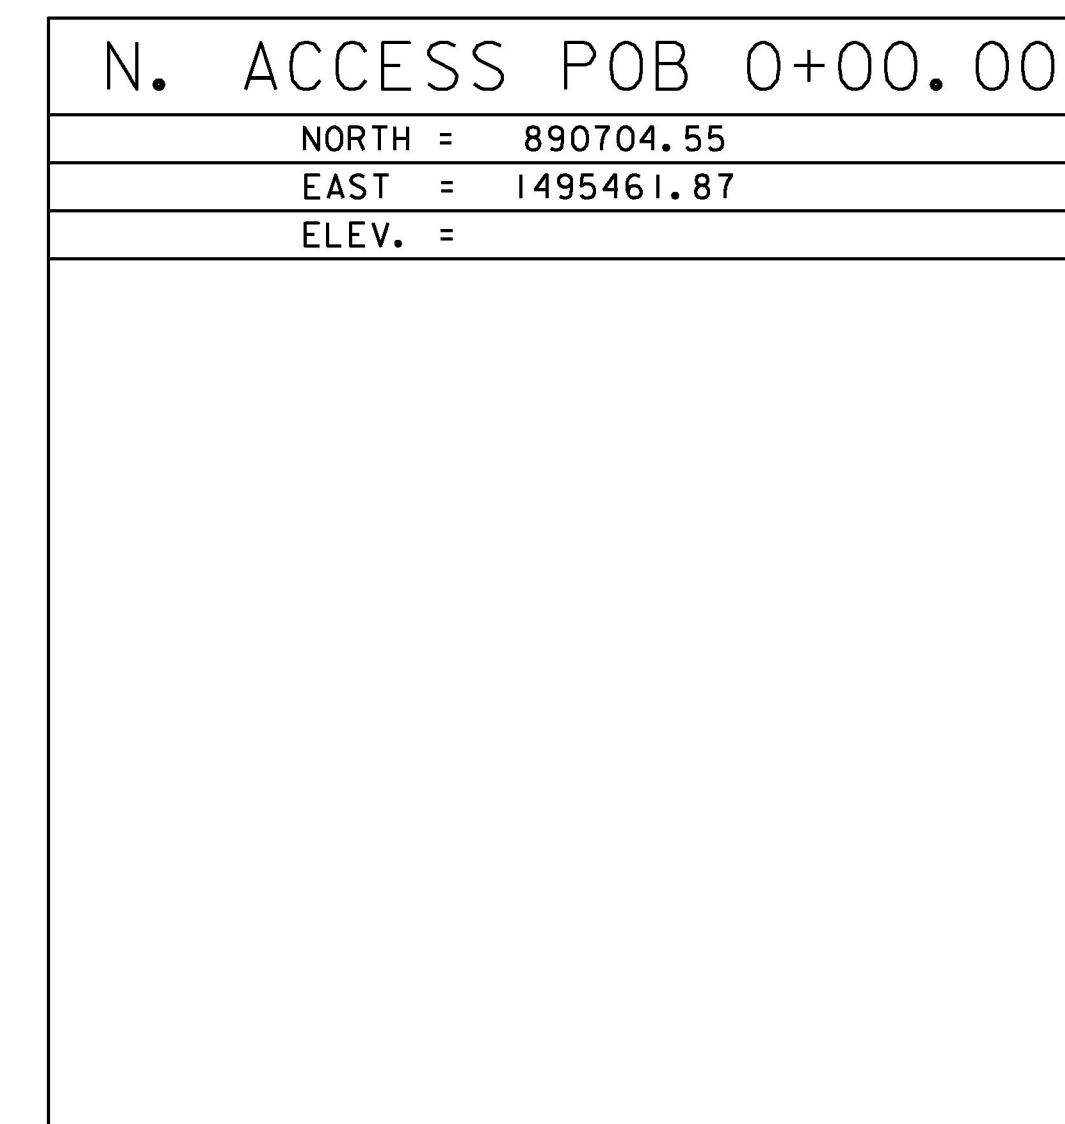

N. ACCESS POB 0+00.00  
 NORTH = 890704.55  
 EAST = 1495461.87  
 ELEV. =

DATUM	
VERTICAL	NAVD 88
HORIZONTAL	NAD 83(2011)
ADJUSTMENT	COMPASS

PROJECT NAME: HIGHGATE	
PROJECT NUMBER: STP SCRPI(2)	
FILE NAME: X13CI34TI.DGN	PLOT DATE: 14-OCT-2016
PROJECT LEADER: B. MARTIN	DRAWN BY: C. CYR
DESIGNED BY: A. KEMPTON	CHECKED BY: P. BEYOR
TIE SHEET 1	SHEET 8 OF 40

ALIGNMENT TIES

N. ACCESS PC 0+04.74
NORTH = 890708.65
EAST = 1495464.25
ELEV. =

N. ACCESS PT 0+71.12
NORTH = 890735.40
EAST = 1495520.65
ELEV. = 284.42

N. ACCESS PC 2+29.86
NORTH = 890710.02
EAST = 1495677.34
ELEV. = 282.42

N. ACCESS PT 2+40.31
NORTH = 890707.46
EAST = 1495687.46
ELEV. = 282.29

N. ACCESS POE 3+46.94
NORTH = 890672.43
EAST = 1495788.17
ELEV. =

ALIGNMENT TIES

S. ACCESS POB 1+00.00
NORTH = 890564.79
EAST = 1495632.56
ELEV. =

S. ACCESS PC 1+17.03
NORTH = 890557.79
EAST = 1495648.08
ELEV. = 280.70

S. ACCESS PT 1+33.05
NORTH = 890547.71
EAST = 1495660.29
ELEV. = 274.79

S. ACCESS POE 2+42.16
NORTH = 890458.50
EAST = 1495723.10
ELEV. =

PIPE ALIGN. POB 9+03.50
NORTH = 890669.16
EAST = 1495799.78
ELEV. =

ALIGNMENT TIES

PIPE ALIGN. POE 11+34.0
NORTH = 890459.03
EAST = 1495705.05
ELEV. =

NORTH =
EAST =
ELEV. =



NORTH =
EAST =
ELEV. =

NORTH =
EAST =
ELEV. =

NORTH =
EAST =
ELEV. =

DATUM
VERTICAL <u>NAVD 88</u>
HORIZONTAL <u>NAD 83 (2011)</u>
ADJUSTMENT <u>COMPASS</u>

PROJECT NAME: HIGHGATE
PROJECT NUMBER: STP SCR(12)
FILE NAME: dl3cl34+1e.dgn
PROJECT LEADER: B. MARTIN
DESIGNED BY: A. KEMPTON
TIE SHEET 2
PLOT DATE: 14-OCT-2016
DRAWN BY: A. KEMPTON
CHECKED BY: M. GAMELIN
SHEET 9 OF 40

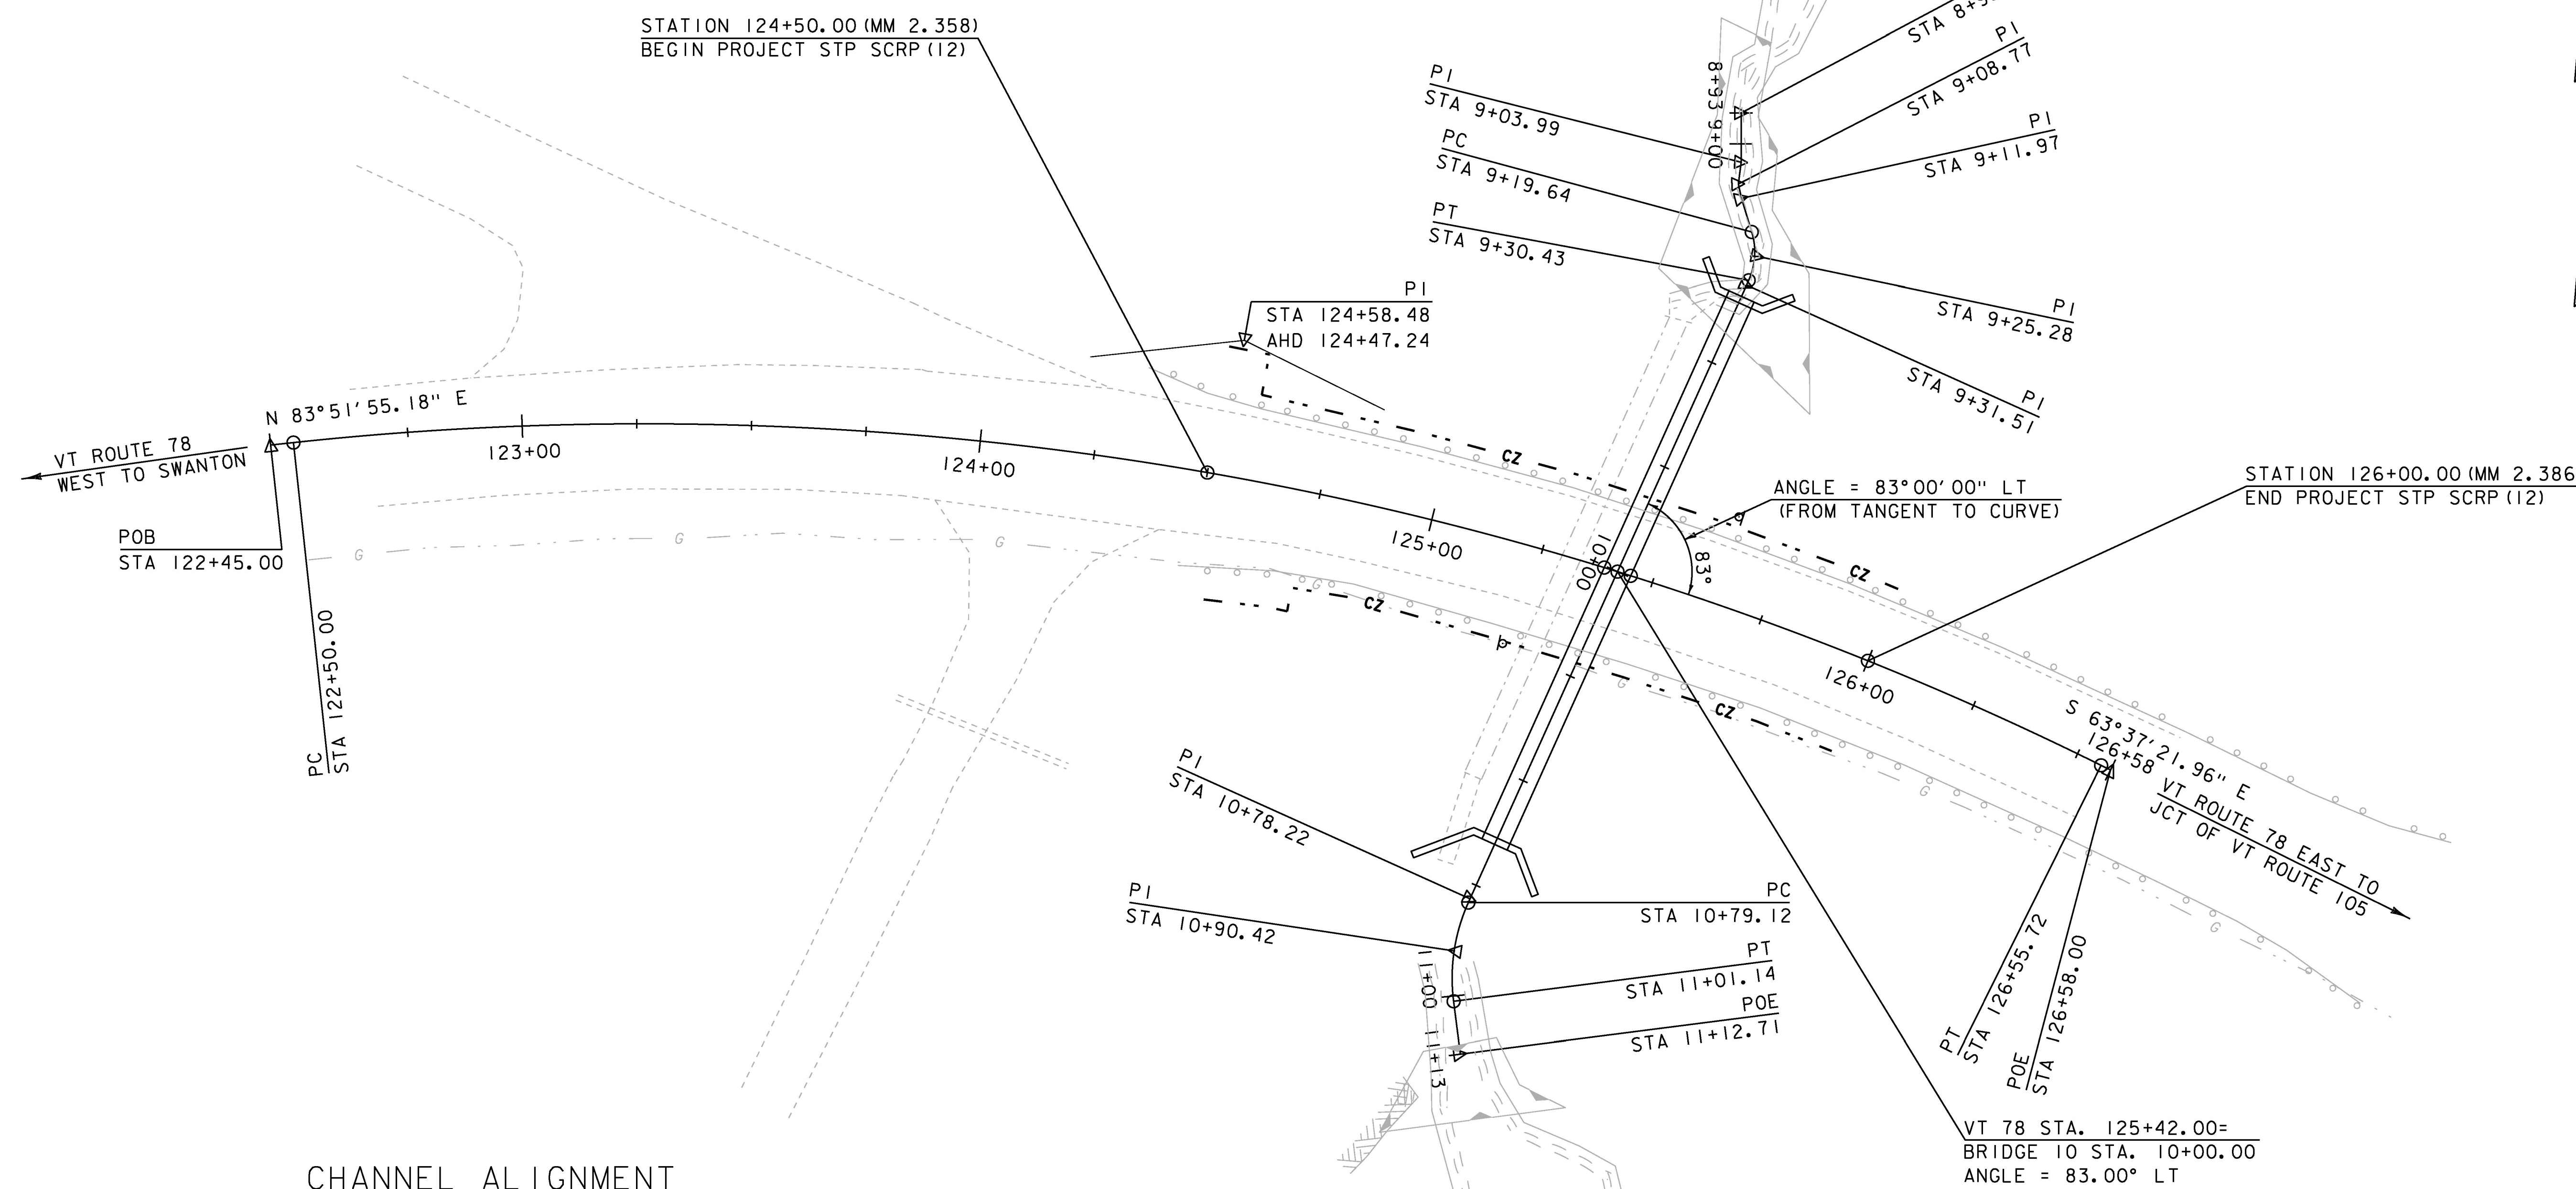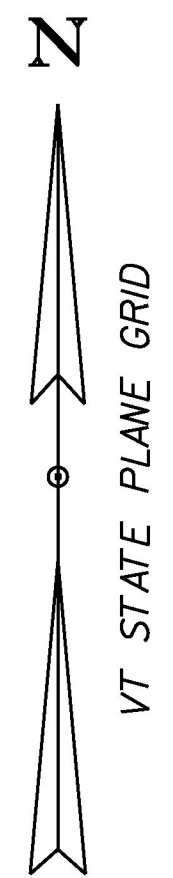

CHANNEL ALIGNMENT  
INFORMATION

	STATION	NORTHING	EASTING	BEARING
POB	8+93.26	890681.08	1495787.07	S 0°05'04.87" E
PI	9+03.99	890670.35	1495787.09	S 7°22'12.94" W
PI	9+08.77	890665.61	1495786.47	S 12°20'38.48" E
PI	9+11.97	890662.49	1495787.16	
PC	9+19.64	890655.15	1495789.39	S 16°56'49.55" E
PI	9+25.28	890649.75	1495791.04	
PT	9+30.43	890644.61	1495788.72	S 24°16'03.17" W
PI	9+31.51	890643.62	1495788.27	
PI	10+78.22	890509.88	1495727.98	S 24°16'03.17" W
PC	10+79.12	890509.06	1495727.61	S 24°16'03.17" W
PI	10+90.42	890498.76	1495722.96	
PT	11+01.14	890487.55	1495724.39	S 7°16'52.86" E
POE	11+12.71	890476.08	1495725.86	

CHANNEL ALIGNMENT



NOTE:  
THE CHANNEL ALIGNMENT WAS USED  
TO DEVELOP THE CHANNEL PROFILE  
AND CHANNEL CROSS SECTIONS.

PROJECT NAME:	HIGHGATE
PROJECT NUMBER:	STP SCRPI(2)
FILE NAME:	d:\3ci34def.dgn
PROJECT LEADER:	B. MARTIN
DESIGNED BY:	A. KEMPTON
CHANNEL ALIGNMENT SHEET	
PLOT DATE:	14-OCT-2016
DRAWN BY:	A. KEMPTON
CHECKED BY:	M. GAGELIN
SHEET	10 OF 40

VT Trans		STATE OF VERMONT AGENCY OF TRANSPORTATION MATERIALS & RESEARCH SECTION SUBSURFACE INFORMATION		BORING LOG		Boring No.: <b>B-101</b>							
		HIGHGATE STP SCR(12)		VT-78 BR-10 CULVERT MM2.37		Page No.: 1 of 1							
						Pin No.: 13C134							
						Checked By: CCB							
Boring Crew: DAIGNEAULT, HALL		Casing		Sampler		Groundwater Observations							
Date Started: 8/12/13 Date Finished: 8/12/13		Type: WB SS		I.D.: 4 in 1.5 in		Date Depth (ft) Notes							
VTSPG NAD83: N 890591.03 ft E 1495758.78 ft		Hammer Wt: N.A. 140 lb.		Hammer Fall: N.A. 30 in.		08/12/13 26.0 While drilling.							
Station: 125+38 Offset: -9.00		Hammer/Rod Type: Auto/AWJ		Rig: CME 55 TRACK		C = 1.46							
Ground Elevation: 285.44 ft													
Depth (ft)	Strata (1)	CLASSIFICATION OF MATERIALS (Description)		Run (Dip deg.)	Core Rec. % (RCD %)	Drill Rate (min/ft)	Blows/ft (N Value)	Moisture Content %	Gravel %	Sand %	Fines %	LL %	PI %
0		Asphalt Pavement, 0.0 ft - 1.0 ft											
1		A-2-4, SiSa, brn, Moist, Rec. = 1.1 ft					12-12-11-10 (23)	11.3	2.6	73.4	24.0		
2		A-4, SiSa, brn, Moist, Rec. = 1.0 ft					5-5-6-6 (11)	14.9	8.2	56.2	35.6		
10		Field Note: No Recovery					7-8-6-5 (14)						
15		A-2-4, SiSa, brn, Moist, Rec. = 1.1 ft					7-12-9-6 (21)	17.4	2.9	63.8	33.3		
20		A-2-4, Sa, brn, Moist, Rec. = 0.8 ft					8-7-9-5 (16)	16.7	6.0	77.8	16.2		
25		A-6, SiCl, gry, Moist, Rec. = 0.9 ft, Decayed Wood was within sample.					1-1-2-13 (3)	26.0	0.3	15.7	84.0	29	14
26		Visual Description: Wood, brn, Moist, Rec. = 0.5 ft, (Possible Log Mat)											
30		Field Note: No Recovery					4-7-6-4 (13)						
35		Visual Description: Broken Rock with Silt, blk, Moist, Rec. = 0.2 ft					R@9.5"						
40		38.0 ft - 43.0 ft, Laminated black, Slate, and meta-greywacke. Moderately soft to moderately hard, Slightly weathered, Poor rock, NXMDC, Drillers report numerous thin drilling breaks throughout run. May be Boulders. RMR = 30		1 (0)	34 (8)	2							
41		43.0 ft - 48.0 ft, Black, Slate, and meta-greywacke. Moderately soft to moderately hard, Slightly weathered, Poor rock, NXMDC, Drillers report numerous thin drilling breaks throughout run. May be Boulders. RMR = 30		2 (0)	36 (0)	2							
42													
43													
44													
45													
46													
47													
48													
49													
50		Hole stopped @ 48.0 ft											
55		Remarks: Hole collapsed at 36.0 ft.											
Notes:													
1. Stratification lines represent approximate boundary between material types. Transition may be gradual.													
2. N Values have not been corrected for hammer energy. C is the hammer energy correction factor.													
3. Water level readings have been made at times and under conditions stated. Fluctuations may occur due to other factors than those present at the time measurements were made.													

VT Trans		STATE OF VERMONT AGENCY OF TRANSPORTATION MATERIALS & RESEARCH SECTION SUBSURFACE INFORMATION		BORING LOG		Boring No.: <b>B-102</b>							
		HIGHGATE STP SCR(12)		VT-78 BR-10 CULVERT MM2.37		Page No.: 1 of 1							
						Pin No.: 13C134							
						Checked By: CCB							
Boring Crew: DAIGNEAULT, HALL, JUDKINS		Casing		Sampler		Groundwater Observations							
Date Started: 8/09/13 Date Finished: 8/19/13		Type: WB SS		I.D.: 4 in 1.5 in		Date Depth (ft) Notes							
VTSPG NAD83: N 890639.50 ft E 1495793.67 ft		Hammer Wt: N.A. 140 lb.		Hammer Fall: N.A. 30 in.		08/09/13 10.2 While drilling.							
Station: 125+49 Offset: -66.00		Hammer/Rod Type: Auto/AWJ		Rig: CME 55 TRACK		C = 1.46							
Ground Elevation: 259.09 ft													
Depth (ft)	Strata (1)	CLASSIFICATION OF MATERIALS (Description)		Run (Dip deg.)	Core Rec. % (RCD %)	Drill Rate (min/ft)	Blows/ft (N Value)	Moisture Content %	Gravel %	Sand %	Fines %	LL %	PI %
0		A-4, SaSi, brn, Moist, Rec. = 1.6 ft, Grass & Roots were within sample.					WH-1-WH-1 (1)	31.5	0.4	42.4	57.2		
5		A-7-6, Cl, gry, Moist, Rec. = 2.0 ft					WH-WH-WH-2 (WH)	31.3	2.9	4.1	93.0	47	26
10		A-6, SiCl, gry, Moist, Rec. = 0.9 ft					1-3-27-29 (30)	22.2	6.9	13.9	79.2	31	15
11		A-1-b, SaSiGr, gry, Moist, Rec. = 0.7 ft, Lab Note: Mostly Broken Rock with Silt.						8.1	52.6	23.7	23.7		
15		A-1-b, SaGr, gry, Moist, Rec. = 0.6 ft, Lab Note: Mostly Broken Rock with Silty Sand					R@8.5"	7.0	64.1	25.8	10.1		
17		17.5 ft - 21.5 ft, Black, Slate, Moderately soft, Slightly weathered, Poor rock, NXMDC, RMR = 30		1 (20)	93 (0)	5							
18		Top of Bedrock @ 17.5 ft											
20													
25		Remarks: Hole collapsed at 13.0 ft.											
30													
35													
40													
45													
50													
Notes:													
1. Stratification lines represent approximate boundary between material types. Transition may be gradual.													
2. N Values have not been corrected for hammer energy. C is the hammer energy correction factor.													
3. Water level readings have been made at times and under conditions stated. Fluctuations may occur due to other factors than those present at the time measurements were made.													

PROJECT NAME:	HIGHGATE
PROJECT NUMBER:	STP SCR(12)
FILE NAME:	d13ci34_frm.dgn
PROJECT LEADER:	B. MARTIN
DESIGNED BY:	A. KEMPTON
BORING SHEET I	
PLOT DATE:	14-OCT-2016
DRAWN BY:	A. KEMPTON
CHECKED BY:	M. GAMELIN
SHEET II OF 40	

VT Trans		STATE OF VERMONT AGENCY OF TRANSPORTATION MATERIALS & RESEARCH SECTION SUBSURFACE INFORMATION		BORING LOG		Boring No.: <b>B-103</b>				
				HIGHGATE STP SCR(12) VT-78 BR-10 CULVERT MM2.37		Page No.: 1 of 1				
						Pin No.: 13C134				
						Checked By: CCB				
Boring Crew: DAIGNEAULT, JUDKINS, HALL		Casing		Sampler		Groundwater Observations				
Date Started: 8/08/13 Date Finished: 8/08/13		Type: WB		SS		Date				
VTSPG NAD83: N 890523.91 ft E 1495749.11 ft		I.D.: 4 in		1.5 in		Depth (ft)				
Station: 125+31 Offset: 58.00		Hammer Wt: N.A.		140 lb.		Notes				
Ground Elevation: 250.99 ft		Hammer Fall: N.A.		30 in.						
		Hammer/Rod Type: Auto/AWJ								
		Rig: CME 55 TRACK		C = 1.46						
Depth (ft)	Strata (1)	CLASSIFICATION OF MATERIALS (Description)		Blows/ft (N Value)	Moisture Content %	Gravel %	Sand %	Fines %	LL %	PI %
		Visual Description: GrSiSa, brn, Moist, Rec. = 0.2 ft, Possible Fill. Field Note: NXDC, Cobbles		R@2.5"	10.1					
5		A-1-b, SiSaGr, gry, MTW, Rec. = 0.7 ft, Broken Rock was within sample. Lab Note, NXDC, Cobbles		16-9-9-9 (18)	10.5	39.7	38.8	21.5		
10		A-1-b, SiSaGr, gry, MTW, Rec. = 1.2 ft, Broken Rock was within sample.		8-19-19-20 (38)	7.7	41.8	36.9	21.3		
15		Field Note: NXDC, Cobbles A-2-4, SaGrSi, gry, Moist, Rec. = 0.9 ft, A small amount of Clay was noticeable. Broken Rock was within sample. Field Note: NXDC, Cleaned out casing.		39-36-R@1.0" (R)	8.2	33.2	25.1	41.7		
20		A-4, CiSi, gry, Moist, Rec. = 1.2 ft, Broken Rock was within sample. Hole stopped @ 21.3 ft		R@8.5"	11.1	15.6	18.0	66.4	22	7
Notes:										
1. Stratification lines represent approximate boundary between material types. Transition may be gradual.										
2. N Values have not been corrected for hammer energy. C is the hammer energy correction factor.										
3. Water level readings have been made at times and under conditions stated. Fluctuations may occur due to other factors than those present at the time measurements were made.										

VT Trans		STATE OF VERMONT AGENCY OF TRANSPORTATION MATERIALS & RESEARCH SECTION SUBSURFACE INFORMATION		BORING LOG		Boring No.: <b>B-104</b>		
				HIGHGATE STP SCR(12) VT-78 BR-10 CULVERT MM2.37		Page No.: 1 of 1		
						Pin No.: 13C134		
						Checked By: CCB		
Boring Crew: DAIGNEAULT, HALL		Casing		Sampler		Groundwater Observations		
Date Started: 8/12/13 Date Finished: 8/12/13		Type: WB		N.A.		Date		
VTSPG NAD83: N 890573.83 ft E 1495753.91 ft		I.D.: 4 in				Depth (ft)		
Station: 125+37 Offset: 12.30		Hammer Wt: N.A.		N.A.		Notes		
Ground Elevation: 283.54 ft		Hammer Fall: N.A.		N.A.				
		Hammer/Rod Type:						
		Rig: CME 55 TRACK		C =				
Depth (ft)	Strata (1)	CLASSIFICATION OF MATERIALS (Description)		Blows/ft (N Value)	Moisture Content %	Gravel %	Sand %	Fines %
		0.0 ft - 18.0 ft, Brown sandy water return. Easy drilling. A few to no cobbles.						
20		18.0 ft - 27.0 ft, Easy drilling. Brown sand & gray silt in area. Gray sandy silt in water return.						
30		27.0 ft - 32.0 ft, Slow advance of drill. Many spikes in water pressure. Drilling got difficult at 27.0 feet. Most likely Wood was plugging the casing. A lot of Wood in water return.						
40		40.0 ft - 46.0 ft, Extremely difficult drilling. Advanced at a very slow pace. Most likely solid rock. Steady rise water pressure.						
50		Hole stopped @ 46.0 ft In Possible Bedrock.						
Remarks:								
1. Boring advanced to determine bedrock depth.								
2. Visual description of soil by drilling personnel.								
3. Hole collapsed at 36.0 ft.								
Notes:								
1. Stratification lines represent approximate boundary between material types. Transition may be gradual.								
2. N Values have not been corrected for hammer energy. C is the hammer energy correction factor.								
3. Water level readings have been made at times and under conditions stated. Fluctuations may occur due to other factors than those present at the time measurements were made.								

PROJECT NAME: HIGHGATE	PLOT DATE: 14-OCT-2016
PROJECT NUMBER: STP SCR(12)	DRAWN BY: A. KEMPTON
FILE NAME: d13ci34_frm.dgn	CHECKED BY: M. GAMELIN
DESIGNED BY: A. KEMPTON	SHEET 12 OF 40
BORING SHEET 2	

# QUANTITY SHEET 1

SUMMARY OF ESTIMATED QUANTITIES										TOTALS		DESCRIPTIONS				DETAILED SUMMARY OF QUANTITIES			
						ROADWAY	LANDSCAPING	EROSION CONTROL	BRIDGE #10	FULL C.E. ITEMS	GRAND TOTAL	FINAL	UNIT	ITEMS	ITEM NUMBER	ROUND	QUANTITIES	UNIT	ITEMS
						1					1		LS	CLEARING AND GRUBBING, INCLUDING INDIVIDUAL TREES AND STUMPS	201.10	-			
						75					75		CY	COMMON EXCAVATION	203.15	9.8			
						5					5		CY	SOLID ROCK EXCAVATION	203.16	2.5			
									220		220		CY	UNCLASSIFIED CHANNEL EXCAVATION	203.27	5.1			
						70					70		CY	GRANULAR BORROW	203.32	9.3			
						1					1		CY	TRENCH EXCAVATION OF EARTH, EXPLORATORY (N.A.B.I.)	204.22	EST			
									210		210		CY	STRUCTURE EXCAVATION	204.25	4			
									190		190		CY	GRANULAR BACKFILL FOR STRUCTURES	204.30	3.3			
									3		3		GAL	WATER REPELLENT, SILANE	514.10	0.4			
									1		1		LS	PRECAST CONCRETE STRUCTURE (NORTH WALL)	540.10	-			
									1		1		LS	PRECAST CONCRETE STRUCTURE (SOUTH WALL)	540.10	-			
						70					70		CY	CONTROLLED DENSITY (FLOWABLE) FILL	541.45	4.8			
						20					20		HR	ALL PURPOSE EXCAVATOR RENTAL, TYPE I	608.25	EST			
						40					40		HR	TRUCK RENTAL	608.37	EST			
						20					20		HR	LOADER RENTAL, TYPE I	608.40	EST			
								390			390		CY	STONE FILL, TYPE II	613.11	5			
									220		220		CY	STONE FILL, TYPE IV	613.13	4			
						800					800		HR	FLAGGERS	630.15	EST			
										1	1		LS	FIELD OFFICE, ENGINEERS	631.10	-			
										1	1		LS	TESTING EQUIPMENT, CONCRETE	631.16	-			
										3000	3000		DL	FIELD OFFICE TELEPHONE (N.A.B.I.)	631.26	-			
						1					1		LS	MOBILIZATION/DEMOBILIZATION	635.11	-			
						1					1		LS	TRAFFIC CONTROL	641.10	-			
						2					2		EACH	PORTABLE CHANGEABLE MESSAGE SIGN	641.15	-			
									25		25		SY	GEOTEXTILE FOR ROADBED SEPARATOR	649.11	3.7			
								65			65		SY	GEOTEXTILE FOR SILT FENCE, WOVEN WIRE REINFORCED	649.515	1			
								30			30		LB	SEED	651.15	4			
								210			210		LB	FERTILIZER	651.18	2.3			
								0.9			0.9		TON	AGRICULTURAL LIMESTONE	651.20	0.1			
								0.2			0.2		TON	HAY MULCH	651.25	0.03			
								250			250		SY	GRUBBING MATERIAL (6")	651.40	9			
								1			1		LS	EPSC PLAN	652.10	-			
								10			10		HR	MONITORING EPSC PLAN	652.20	EST			
								1			1		LU	MAINTENANCE OF EPSC PLAN (N.A.B.I.)	652.30	-			
								1650			1650		SY	TEMPORARY EROSION MATTING	653.20	39			
								36			36		CY	VEHICLE TRACKING PAD	653.35	0.2			
								625			625		LF	BARRIER FENCE	653.50	2			
								490			490		LF	PROJECT DEMARCATION FENCE	653.55	8			
								16			16		EACH	EVERGREEN TREES (PICEA GLAUCA)(5')(B&B)	656.20	-			
								17			17		MGAL	LANDSCAPE WATERING	656.65	0.4			

PROJECT NAME: HIGHGATE  
 PROJECT NUMBER: STP SCRPI(2)  
 FILE NAME: d13ci34_frm.dgn PLOT DATE: 14-OCT-2016  
 PROJECT LEADER: B. MARTIN DRAWN BY: A. KEMPTON  
 DESIGNED BY: A. KEMPTON CHECKED BY: M. GAMELIN  
 QUANTITY SHEET 1 SHEET 13 OF 40

# QUANTITY SHEET 2

SUMMARY OF ESTIMATED QUANTITIES										TOTALS		DESCRIPTIONS				DETAILED SUMMARY OF QUANTITIES			
						ROADWAY	LANDSCAPING	EROSION CONTROL	BRIDGE #10	FULL C.E. ITEMS	GRAND TOTAL	FINAL	UNIT	ITEMS	ITEM NUMBER	ROUND	QUANTITIES	UNIT	ITEMS
							81				81		CY	LANDSCAPE BACKFILL, TRUCK MEASUREMENT	656.80	1			
						0.84					0.84		SF	TRAFFIC SIGNS, TYPE A	675.20	-			
						25					25		LF	SQUARE TUBE SIGN POST AND ANCHOR	675.341	1			
									8		8		HR	SPECIAL PROVISION (TRENCHLESS PIPE OBSTRUCTION REMOVAL)	900.630	EST			
									131		131		LF	SPECIAL PROVISION (TRENCHLESS PIPE WITH CEMENT MORTAR LINING) (72" DIAMETER)	900.640	-			
									1		1		LS	SPECIAL PROVISION (TEMPORARY ACCESS ROAD AND STAGING AREAS, CULVERT)(NORTH ACCESS)	900.645	-			
									1		1		LS	SPECIAL PROVISION (TEMPORARY ACCESS ROAD AND STAGING AREAS, CULVERT)(SOUTH ACCESS)	900.645	-			
									1		1		LS	SPECIAL PROVISION (TEMPORARY RELOCATION OF STREAM)	900.645	-			

PROJECT NAME:	HIGHGATE	PLOT DATE:	14-OCT-2016
PROJECT NUMBER:	STP_SCRP(12)	DRAWN BY:	A. KEMPTON
FILE NAME:	d13ci34_frm.dgn	CHECKED BY:	M. GAMELIN
DESIGNED BY:	A. KEMPTON	QUANTITY SHEET 2	SHEET 14 OF 40





TRAFFIC SIGNS, TYPE A (BRIDGE NUMBER PLAQUE)  
 STA. 125+22.0 RT  
 STA. 125+63.0 LT  
 SQUARE TUBE SIGN POST AND ANCHOR  
 STA. 125+22.0 RT  
 STA. 125+63.0 LT

PRECAST CONCRETE STRUCTURE (NORTH WALL)  
 STA. 125+39.8 LT - 125+59.8 LT  
 PRECAST CONCRETE STRUCTURE (SOUTH WALL)  
 STA. 125+14.4 RT - 125+46.8 RT

SPECIAL PROVISION (TRENCHLESS PIPE WITH CEMENT MORTAR LINING) (72" DIAMETER)  
 STA. 125+33.30 RT - 125+49.38 LT

GROUND SURFACE SHALL BE TILLED  
 TO A DEPTH OF 18" FOR NEW TREES  
 IN A CONTINUOUS BED, AS SHOWN

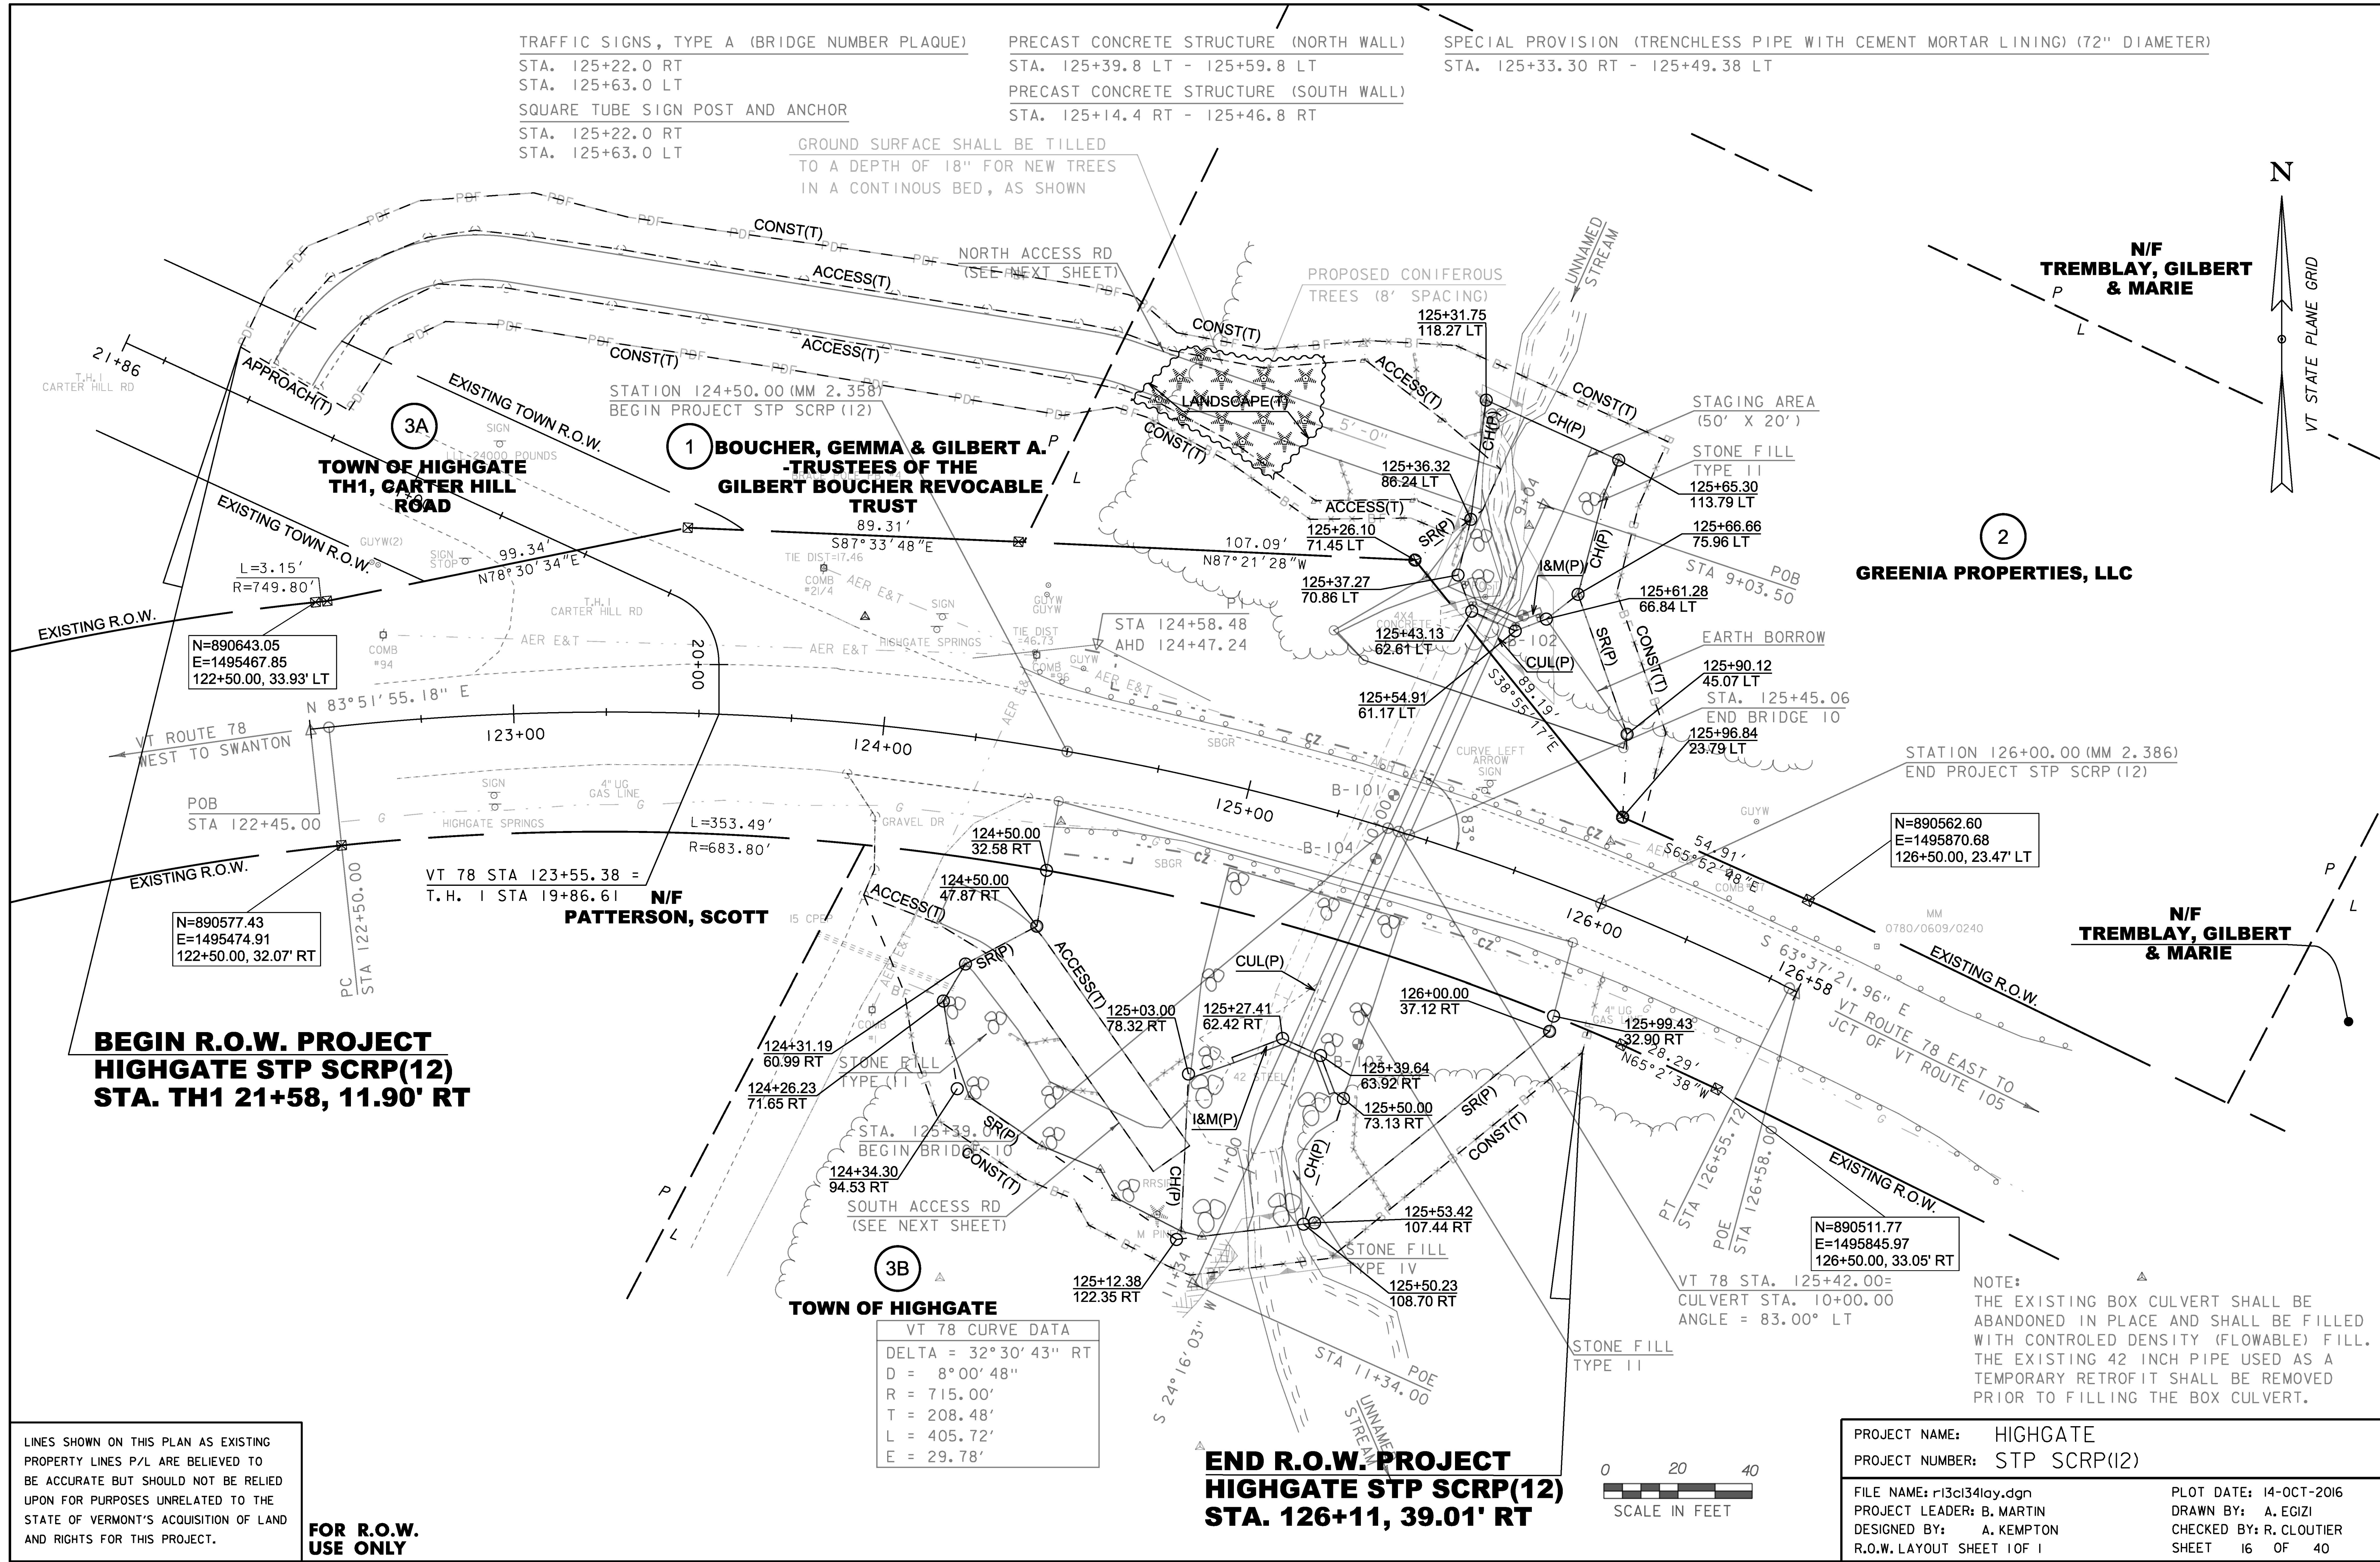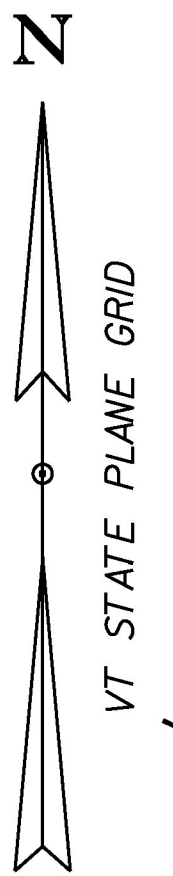

N=890643.05  
 E=1495467.85  
 122+50.00, 33.93' LT

N=890577.43  
 E=1495474.91  
 122+50.00, 32.07' RT

N=890562.60  
 E=1495870.68  
 126+50.00, 23.47' LT

N=890511.77  
 E=1495845.97  
 126+50.00, 33.05' RT

**VT 78 CURVE DATA**

DELTA =	32° 30' 43" RT
D =	8° 00' 48"
R =	715.00'
T =	208.48'
L =	405.72'
E =	29.78'

LINES SHOWN ON THIS PLAN AS EXISTING  
 PROPERTY LINES P/L ARE BELIEVED TO  
 BE ACCURATE BUT SHOULD NOT BE RELIED  
 UPON FOR PURPOSES UNRELATED TO THE  
 STATE OF VERMONT'S ACQUISITION OF LAND  
 AND RIGHTS FOR THIS PROJECT.

**FOR R.O.W.  
 USE ONLY**

NOTE:  
 THE EXISTING BOX CULVERT SHALL BE  
 ABANDONED IN PLACE AND SHALL BE FILLED  
 WITH CONTROLLED DENSITY (FLOWABLE) FILL.  
 THE EXISTING 42 INCH PIPE USED AS A  
 TEMPORARY RETROFIT SHALL BE REMOVED  
 PRIOR TO FILLING THE BOX CULVERT.

PROJECT NAME:	HIGHGATE	PLOT DATE:	14-OCT-2016
PROJECT NUMBER:	STP SCR(12)	DRAWN BY:	A. EGIZI
FILE NAME:	r13ci34lay.dgn	DESIGNED BY:	A. KEMPTON
PROJECT LEADER:	B. MARTIN	CHECKED BY:	R. CLOUTIER
R.O.W. LAYOUT SHEET 1 OF 1		SHEET	16 OF 40



**BEGIN R.O.W. PROJECT  
 HIGHGATE STP SCR(12)  
 STA. TH1 21+58, 11.90' RT**

**END R.O.W. PROJECT  
 HIGHGATE STP SCR(12)  
 STA. 126+11, 39.01' RT**

TRAFFIC SIGNS, TYPE A (BRIDGE NUMBER PLAQUE)  
 STA. 125+22.0 RT  
 STA. 125+63.0 LT  
 SQUARE TUBE SIGN POST AND ANCHOR  
 STA. 125+22.0 RT  
 STA. 125+63.0 LT

PRECAST CONCRETE STRUCTURE (NORTH WALL)  
 STA. 125+39.8 LT - 125+59.8 LT  
 PRECAST CONCRETE STRUCTURE (SOUTH WALL)  
 STA. 125+14.4 RT - 125+46.8 RT

SPECIAL PROVISION (TRENCHLESS PIPE WITH CEMENT MORTAR LINING) (72" DIAMETER)  
 STA. 125+33.30 RT - 125+49.38 LT

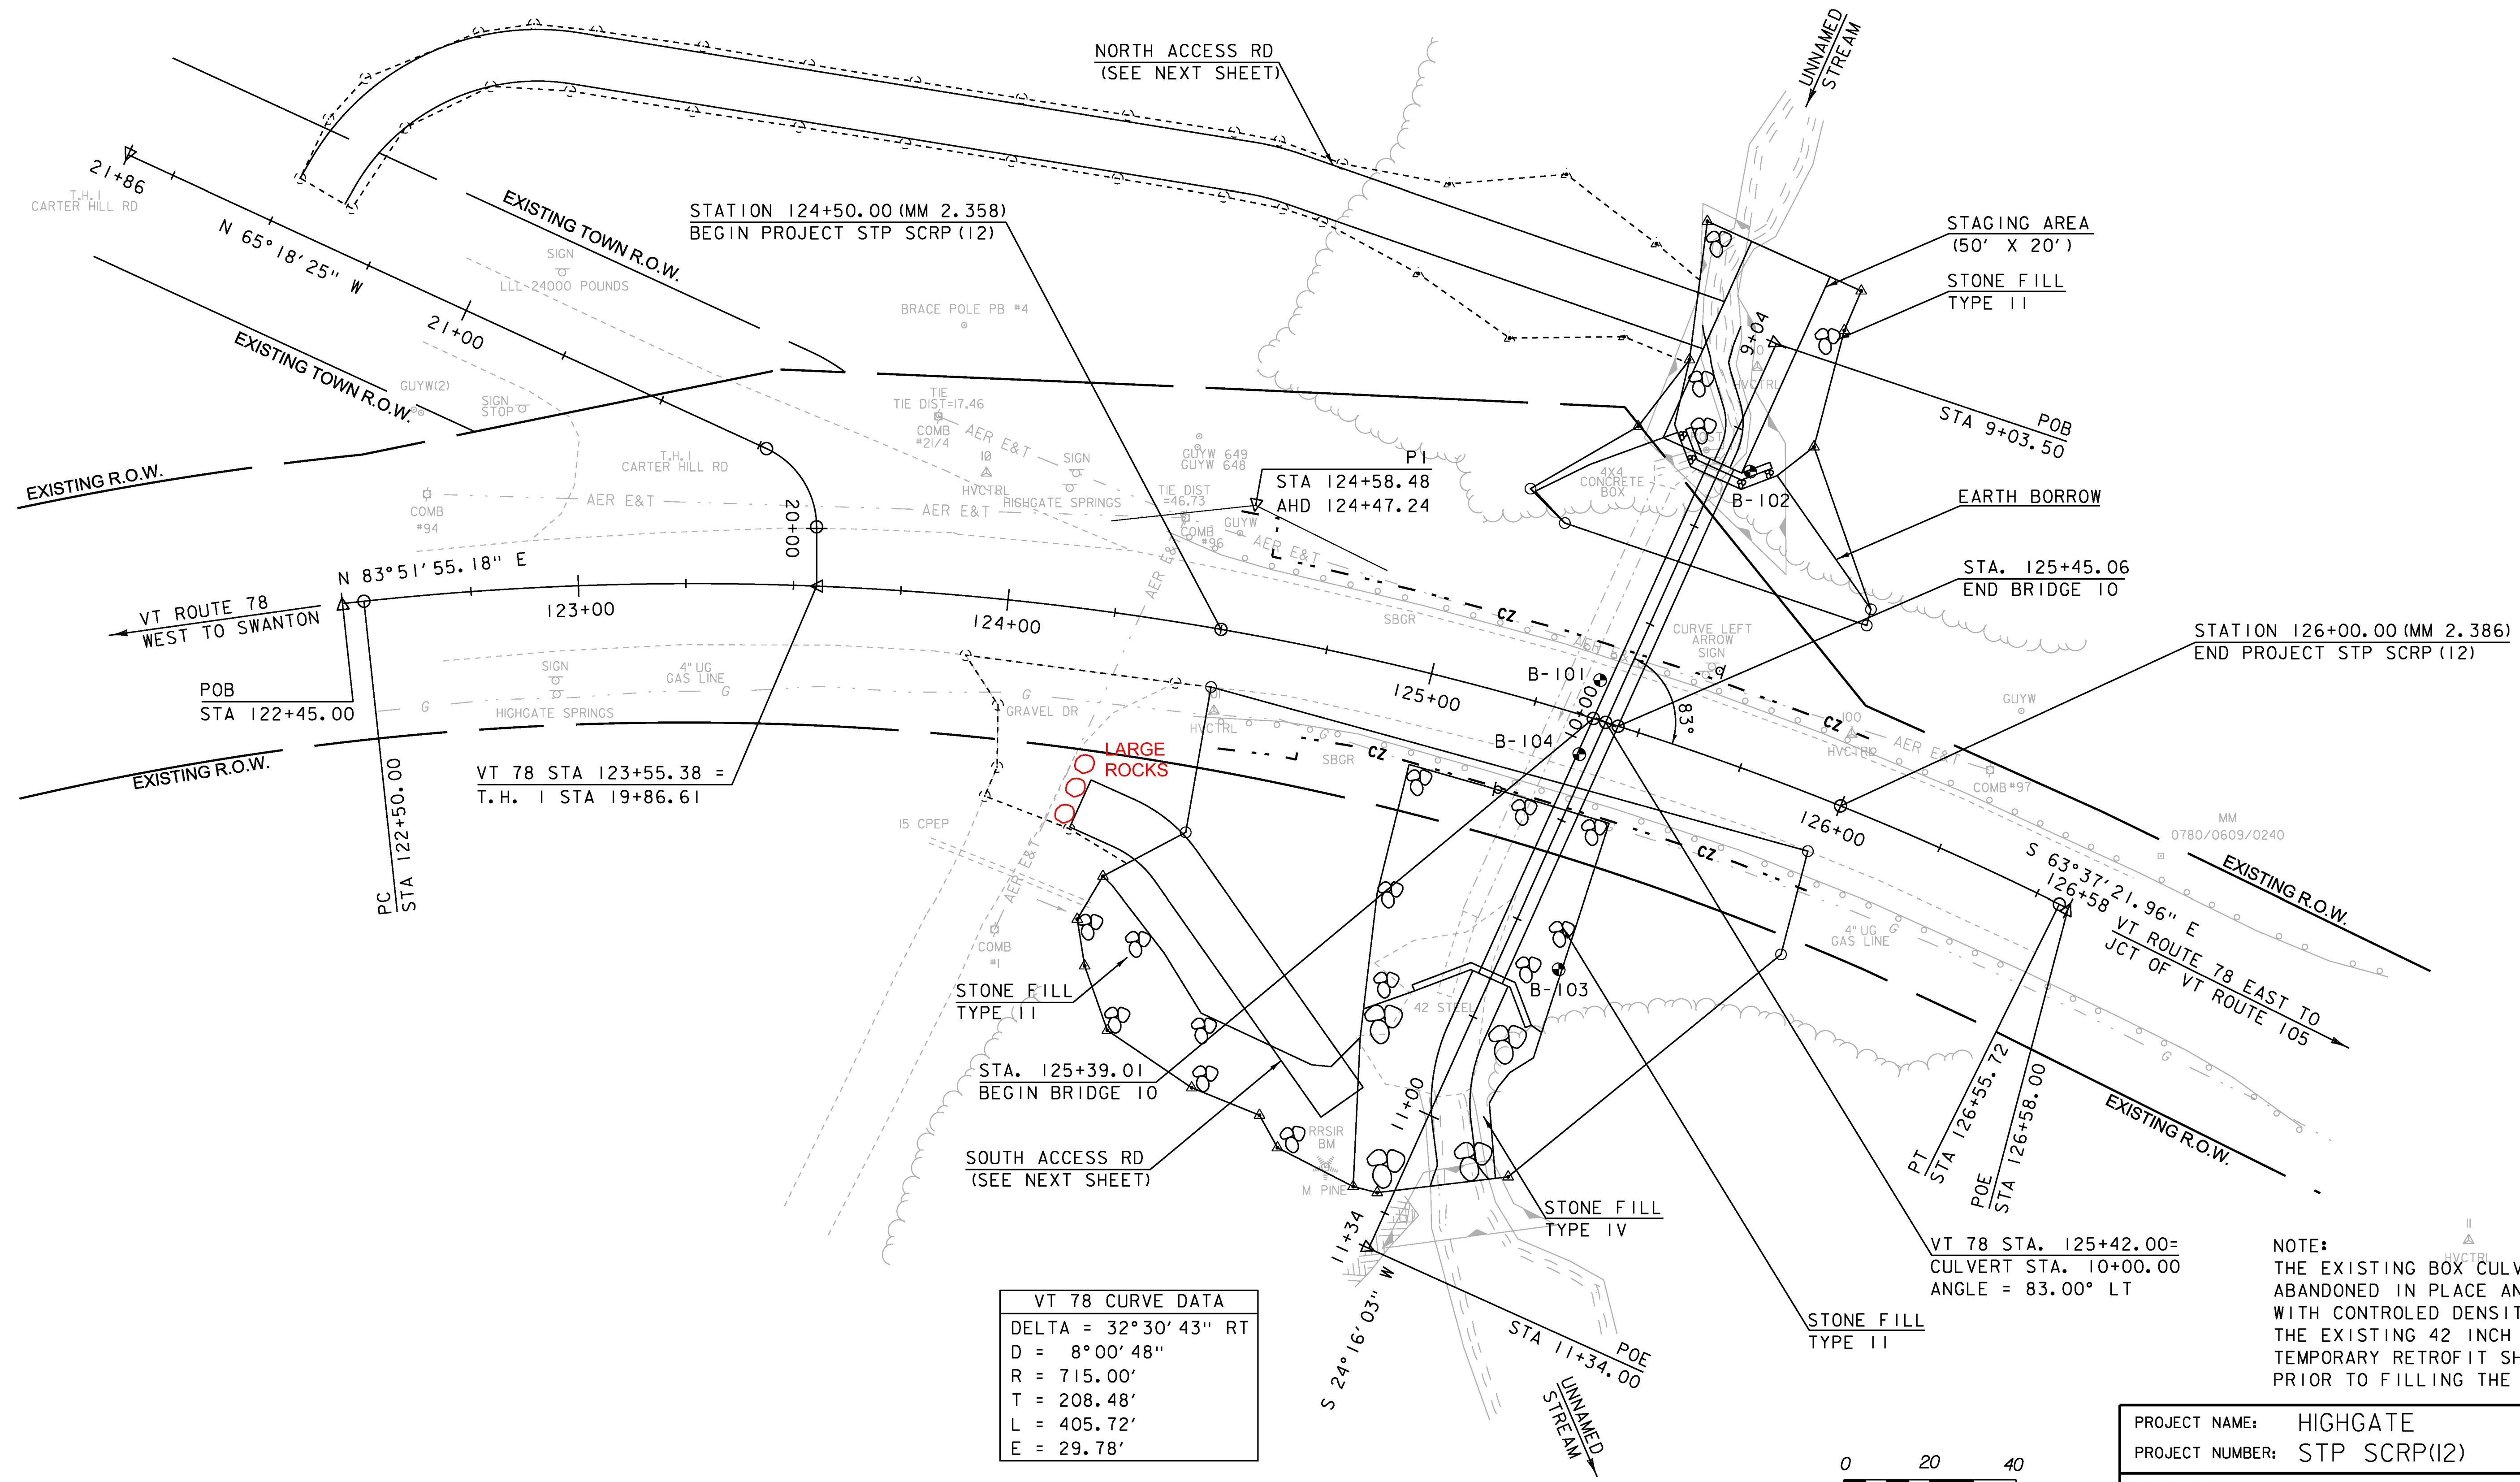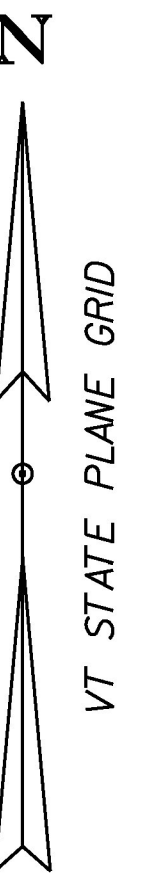

VT 78 STA 123+55.38 =  
 T.H. I STA 19+86.61

VT 78 CURVE DATA	
DELTA	= 32° 30' 43" RT
D	= 8° 00' 48"
R	= 715.00'
T	= 208.48'
L	= 405.72'
E	= 29.78'



NOTE:  
 THE EXISTING BOX CULVERT SHALL BE ABANDONED IN PLACE AND SHALL BE FILLED WITH CONTROLLED DENSITY (FLOWABLE) FILL. THE EXISTING 42 INCH PIPE USED AS A TEMPORARY RETROFIT SHALL BE REMOVED PRIOR TO FILLING THE BOX CULVERT.



PROJECT NAME:	HIGHGATE
PROJECT NUMBER:	STP SCRPI(2)
FILE NAME:	d13ci34bdr.dgn
PROJECT LEADER:	B. MARTIN
DESIGNED BY:	A. KEMPTON
PLAN SHEET	
PLOT DATE:	14-OCT-2016
DRAWN BY:	A. KEMPTON
CHECKED BY:	M. GAMELIN
SHEET	17 OF 40

SPECIAL PROVISION (TEMPORARY ACCESS ROAD AND STAGING AREAS, CULVERT) (NORTH ACCESS)  
 T.H.I STA. 21+48 RT - MAINLINE STA. 125+39 LT  
 SPECIAL PROVISION (TEMPORARY ACCESS ROAD AND STAGING AREAS, CULVERT) (SOUTH ACCESS)  
 STA. 124+21 RT - 125+08 RT


NORTH ACCESS ROAD CURVE 1	
DELTA =	69°09'00"
D =	104°10'27"
R =	55.00'
T =	37.91'
L =	66.38'
E =	11.80'

NORTH ACCESS ROAD CURVE 2	
DELTA =	9°58'33"
D =	95°29'35"
R =	60.00'
T =	5.24'
L =	10.45'
E =	0.23'


SOUTH ACCESS ROAD CURVE DATA	
DELTA =	30°35'35"
D =	190°59'09"
R =	30.00'
T =	8.21'
L =	16.02'
E =	1.10'

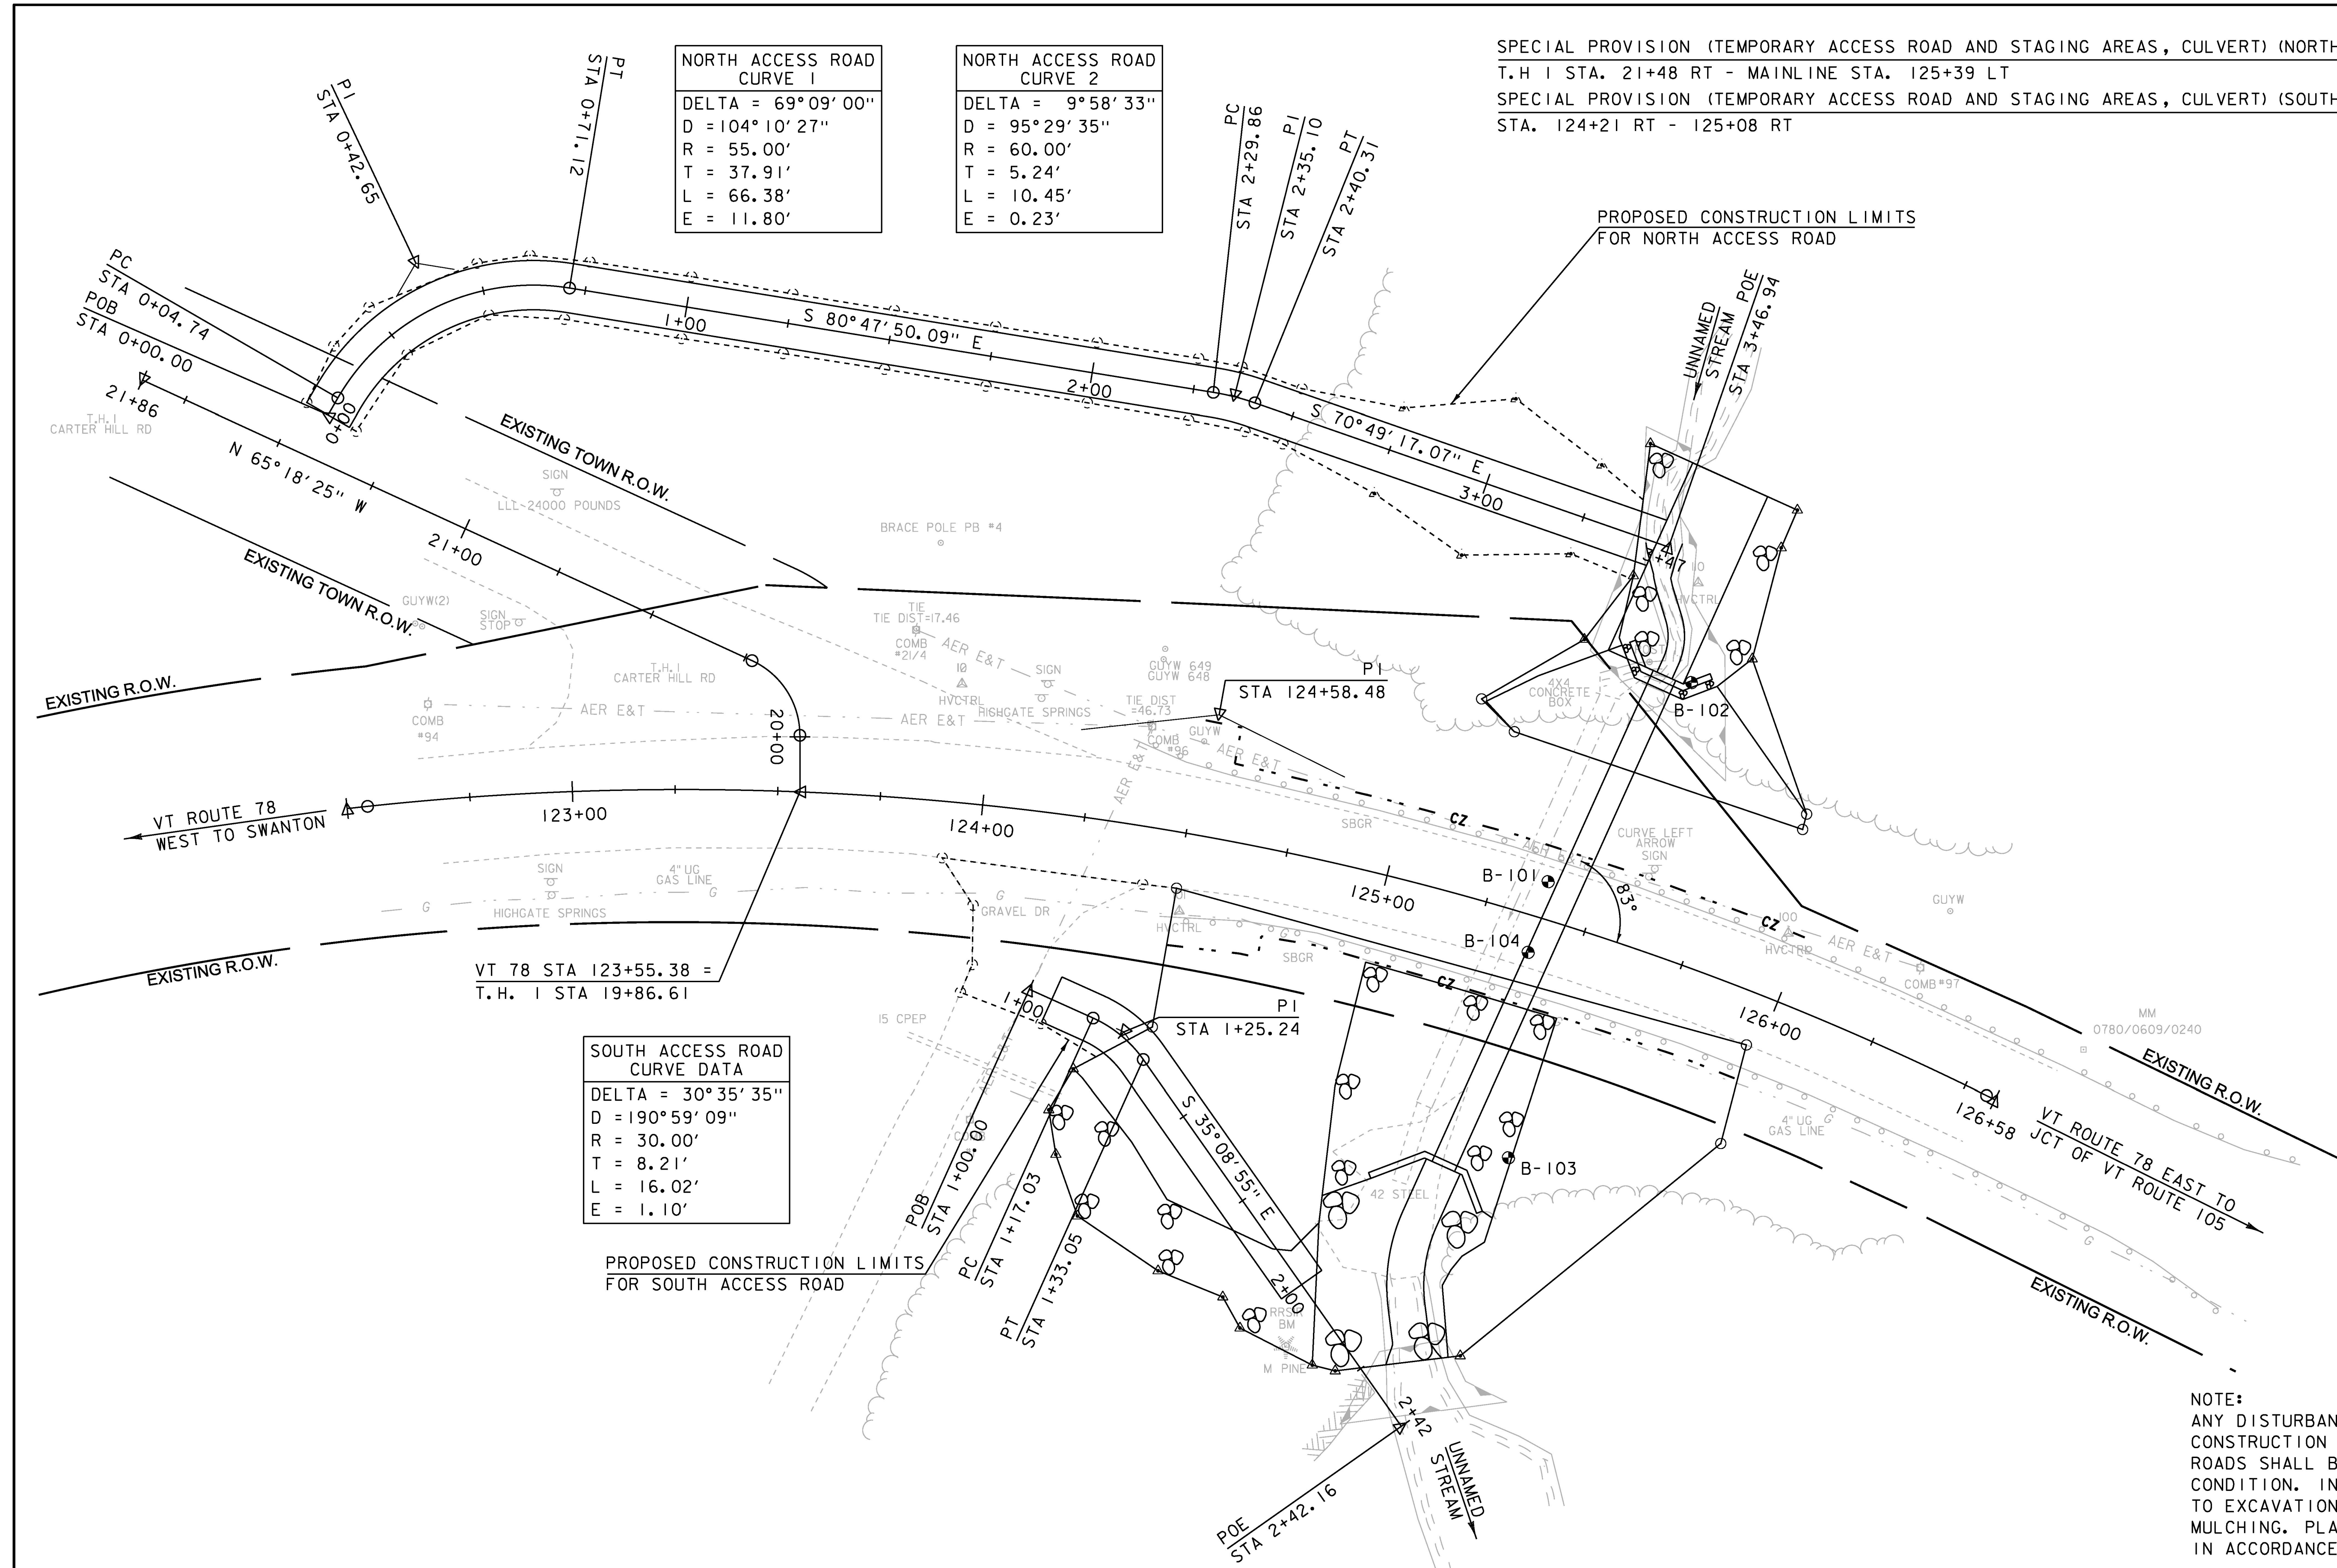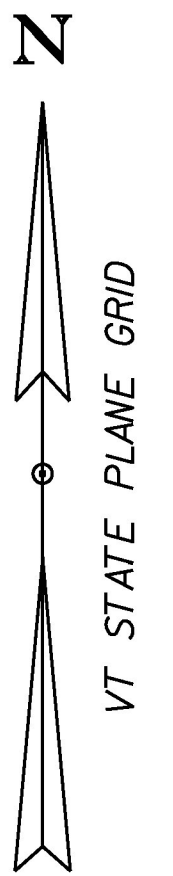


NOTE:  
 ANY DISTURBANCE ASSOCIATED WITH THE CONSTRUCTION OR USE OF THE ACCESS ROADS SHALL BE RESTORED TO THE ORIGINAL CONDITION. INCLUDING, BUT NOT LIMITED TO EXCAVATION, GRADING, SEEDING AND MULCHING. PLANTINGS SHALL BE PLACED IN ACCORDANCE WITH THE LANDSCAPE PLAN.

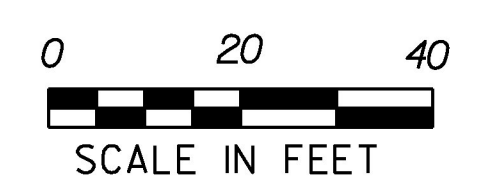

PROJECT NAME:	HIGHGATE
PROJECT NUMBER:	STP SCRPI(2)
FILE NAME:	d13ci34bdr.dgn
PROJECT LEADER:	B. MARTIN
DESIGNED BY:	A. KEMPTON
ACCESS ROAD PLAN SHEET	
PLOT DATE:	14-OCT-2016
DRAWN BY:	A. KEMPTON
CHECKED BY:	M. GAMELIN
SHEET	18 OF 40

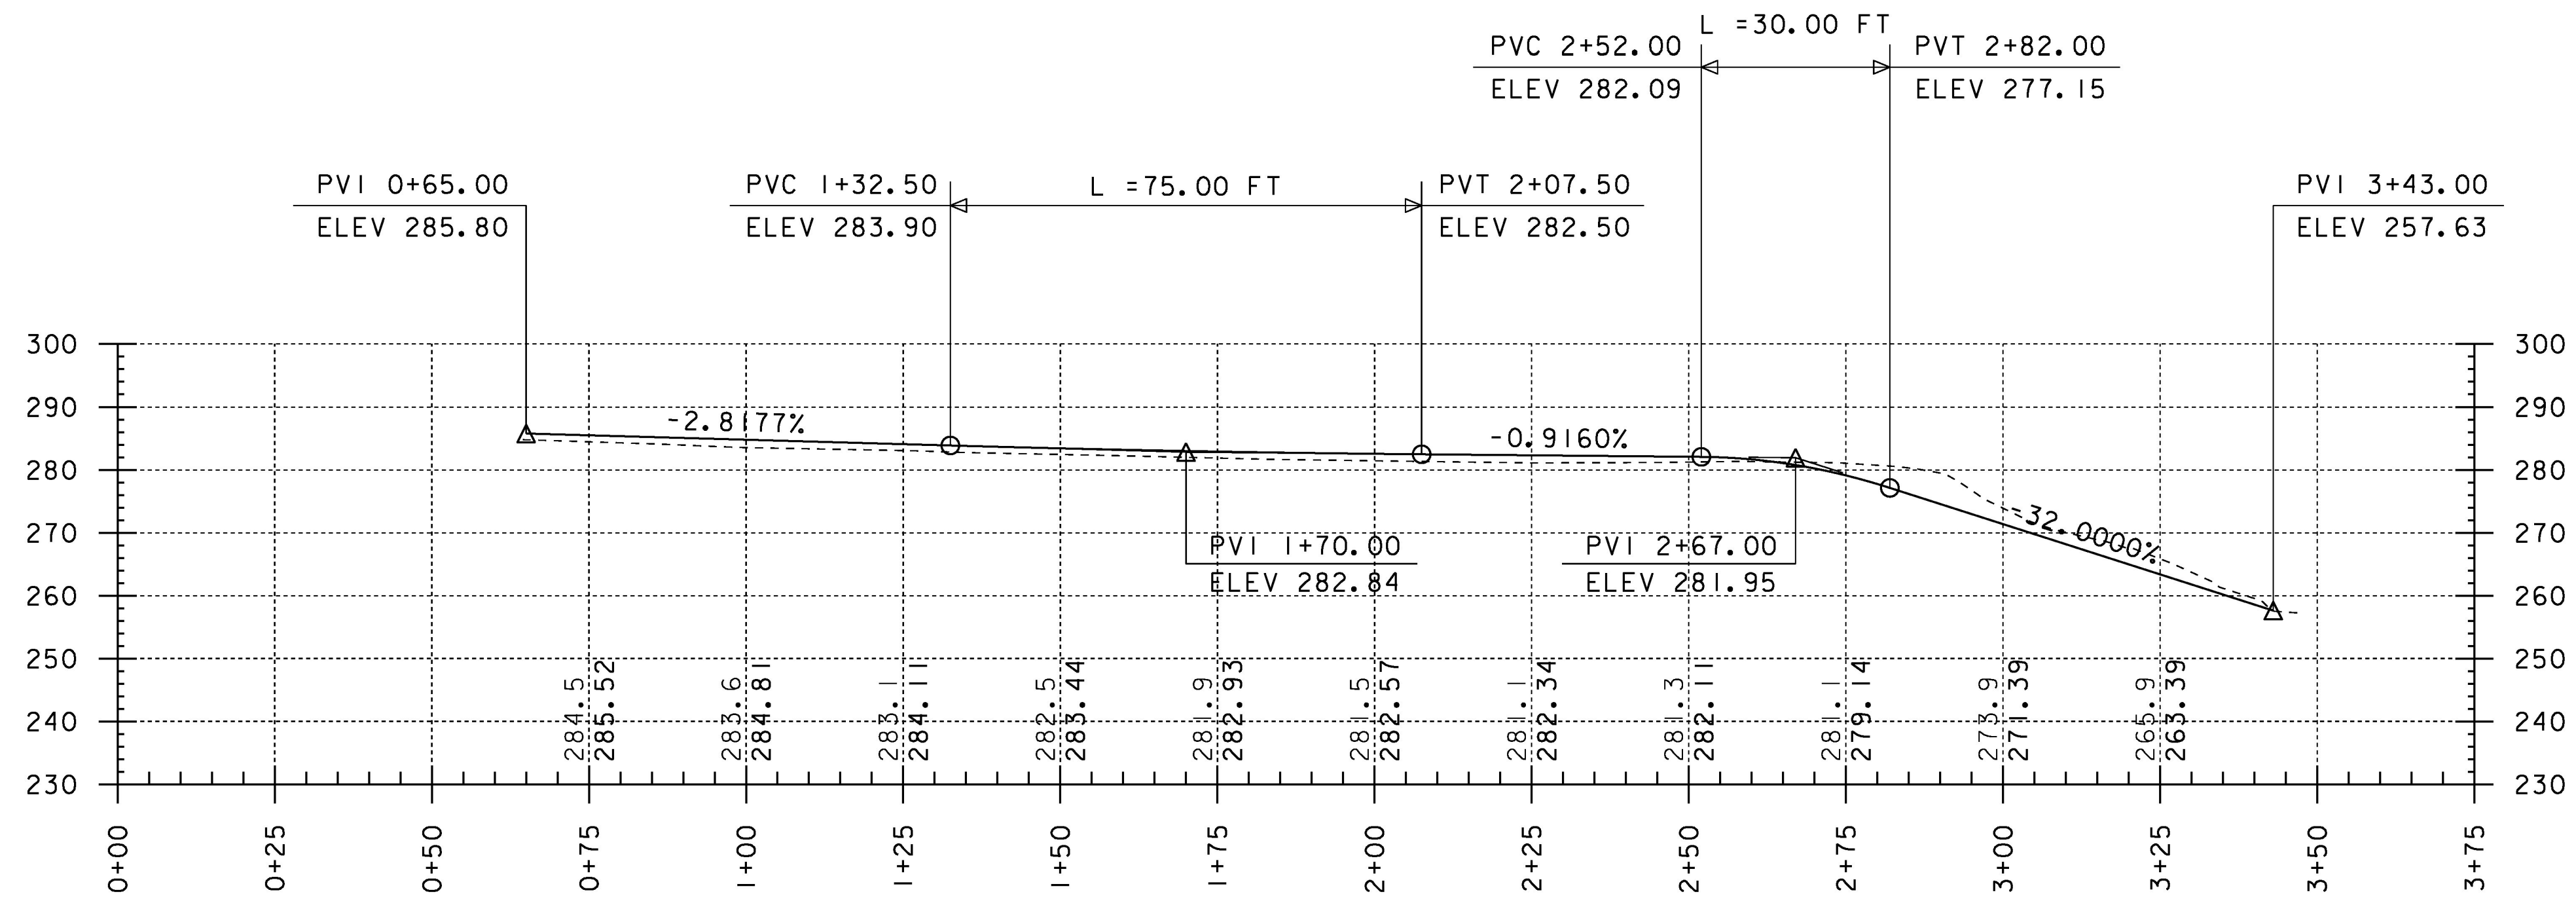

NORTH ACCESS ROAD PROFILE

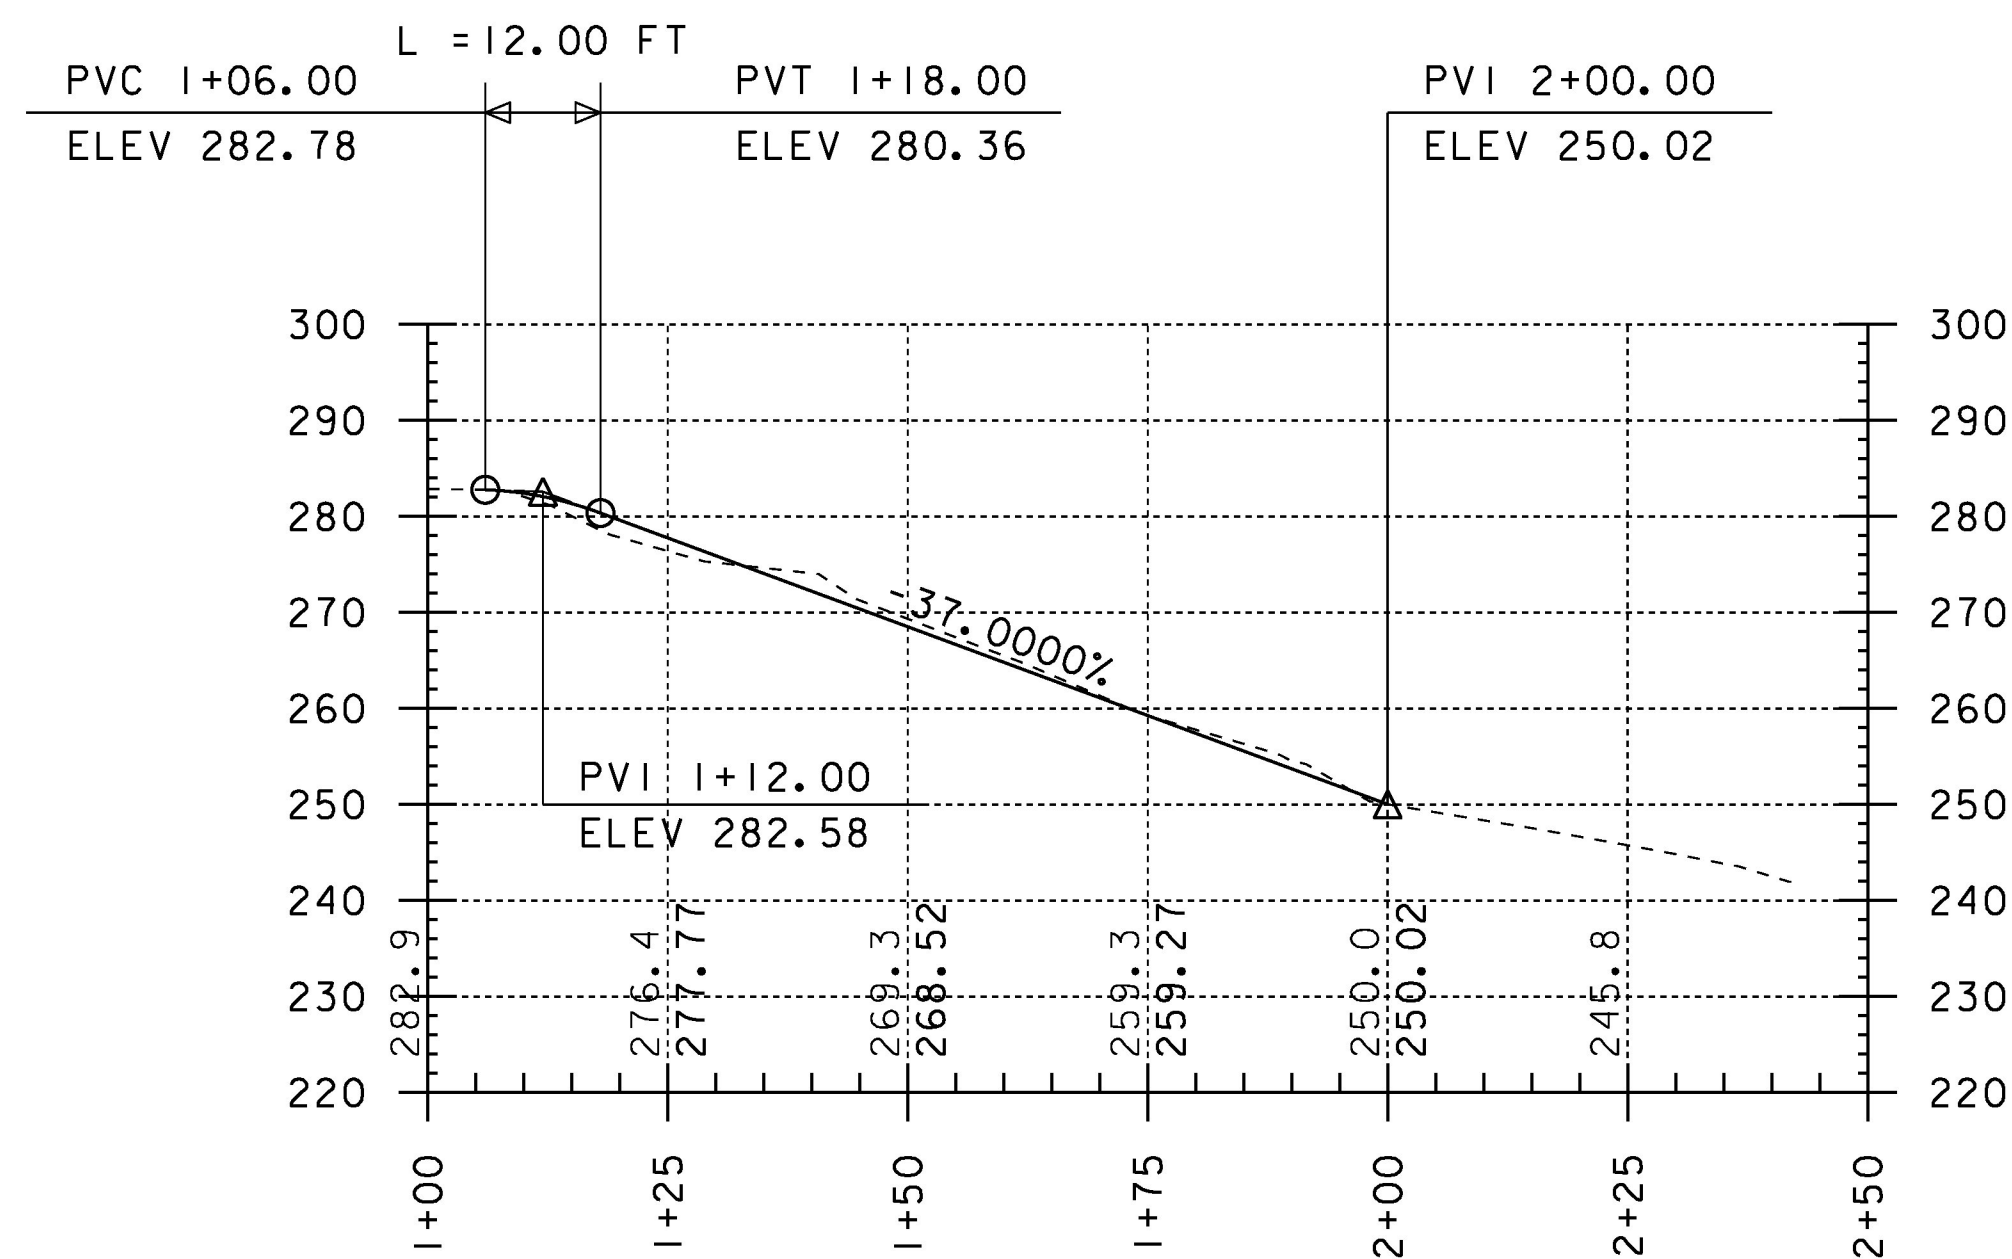

SOUTH ACCESS ROAD PROFILE


ELEVATIONS SHOWN TO THE NEAREST TENTH OF A FOOT ARE FOR EXISTING GROUND ALONG THE CENTERLINE.  
 ELEVATIONS SHOWN TO THE NEAREST HUNDREDTH OF A FOOT ARE FOR PROPOSED FINISHED GRADE ALONG THE CENTERLINE.

PROJECT NAME:	HIGHGATE
PROJECT NUMBER:	STP SCR(12)
FILE NAME:	d13ci34pro.dgn
PROJECT LEADER:	B. MARTIN
DESIGNED BY:	A. KEMPTON
ACCESS ROAD PROFILE SHEET	
PLOT DATE:	14-OCT-2016
DRAWN BY:	A. KEMPTON
CHECKED BY:	M. GAMELIN
SHEET	19 OF 40


SCALE IN FEET

EVERGREEN TREE (PICEA GLAUCA) (5') (B&B)  
 124+57 - 124+92 LT - 16 PG


QTY	KEY	BOTANICAL NAME	COMMON NAME	HEIGHT
16	PG	PICEA GLAUCA	WHITE SPRUCE	5 FT

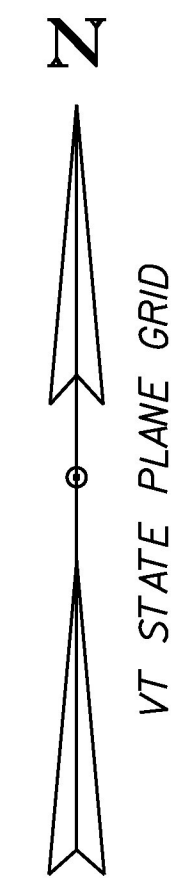

GROUND SURFACE SHALL BE TILLED TO A DEPTH OF 18" FOR NEW TREES IN A CONTINUOUS BED, AS SHOWN

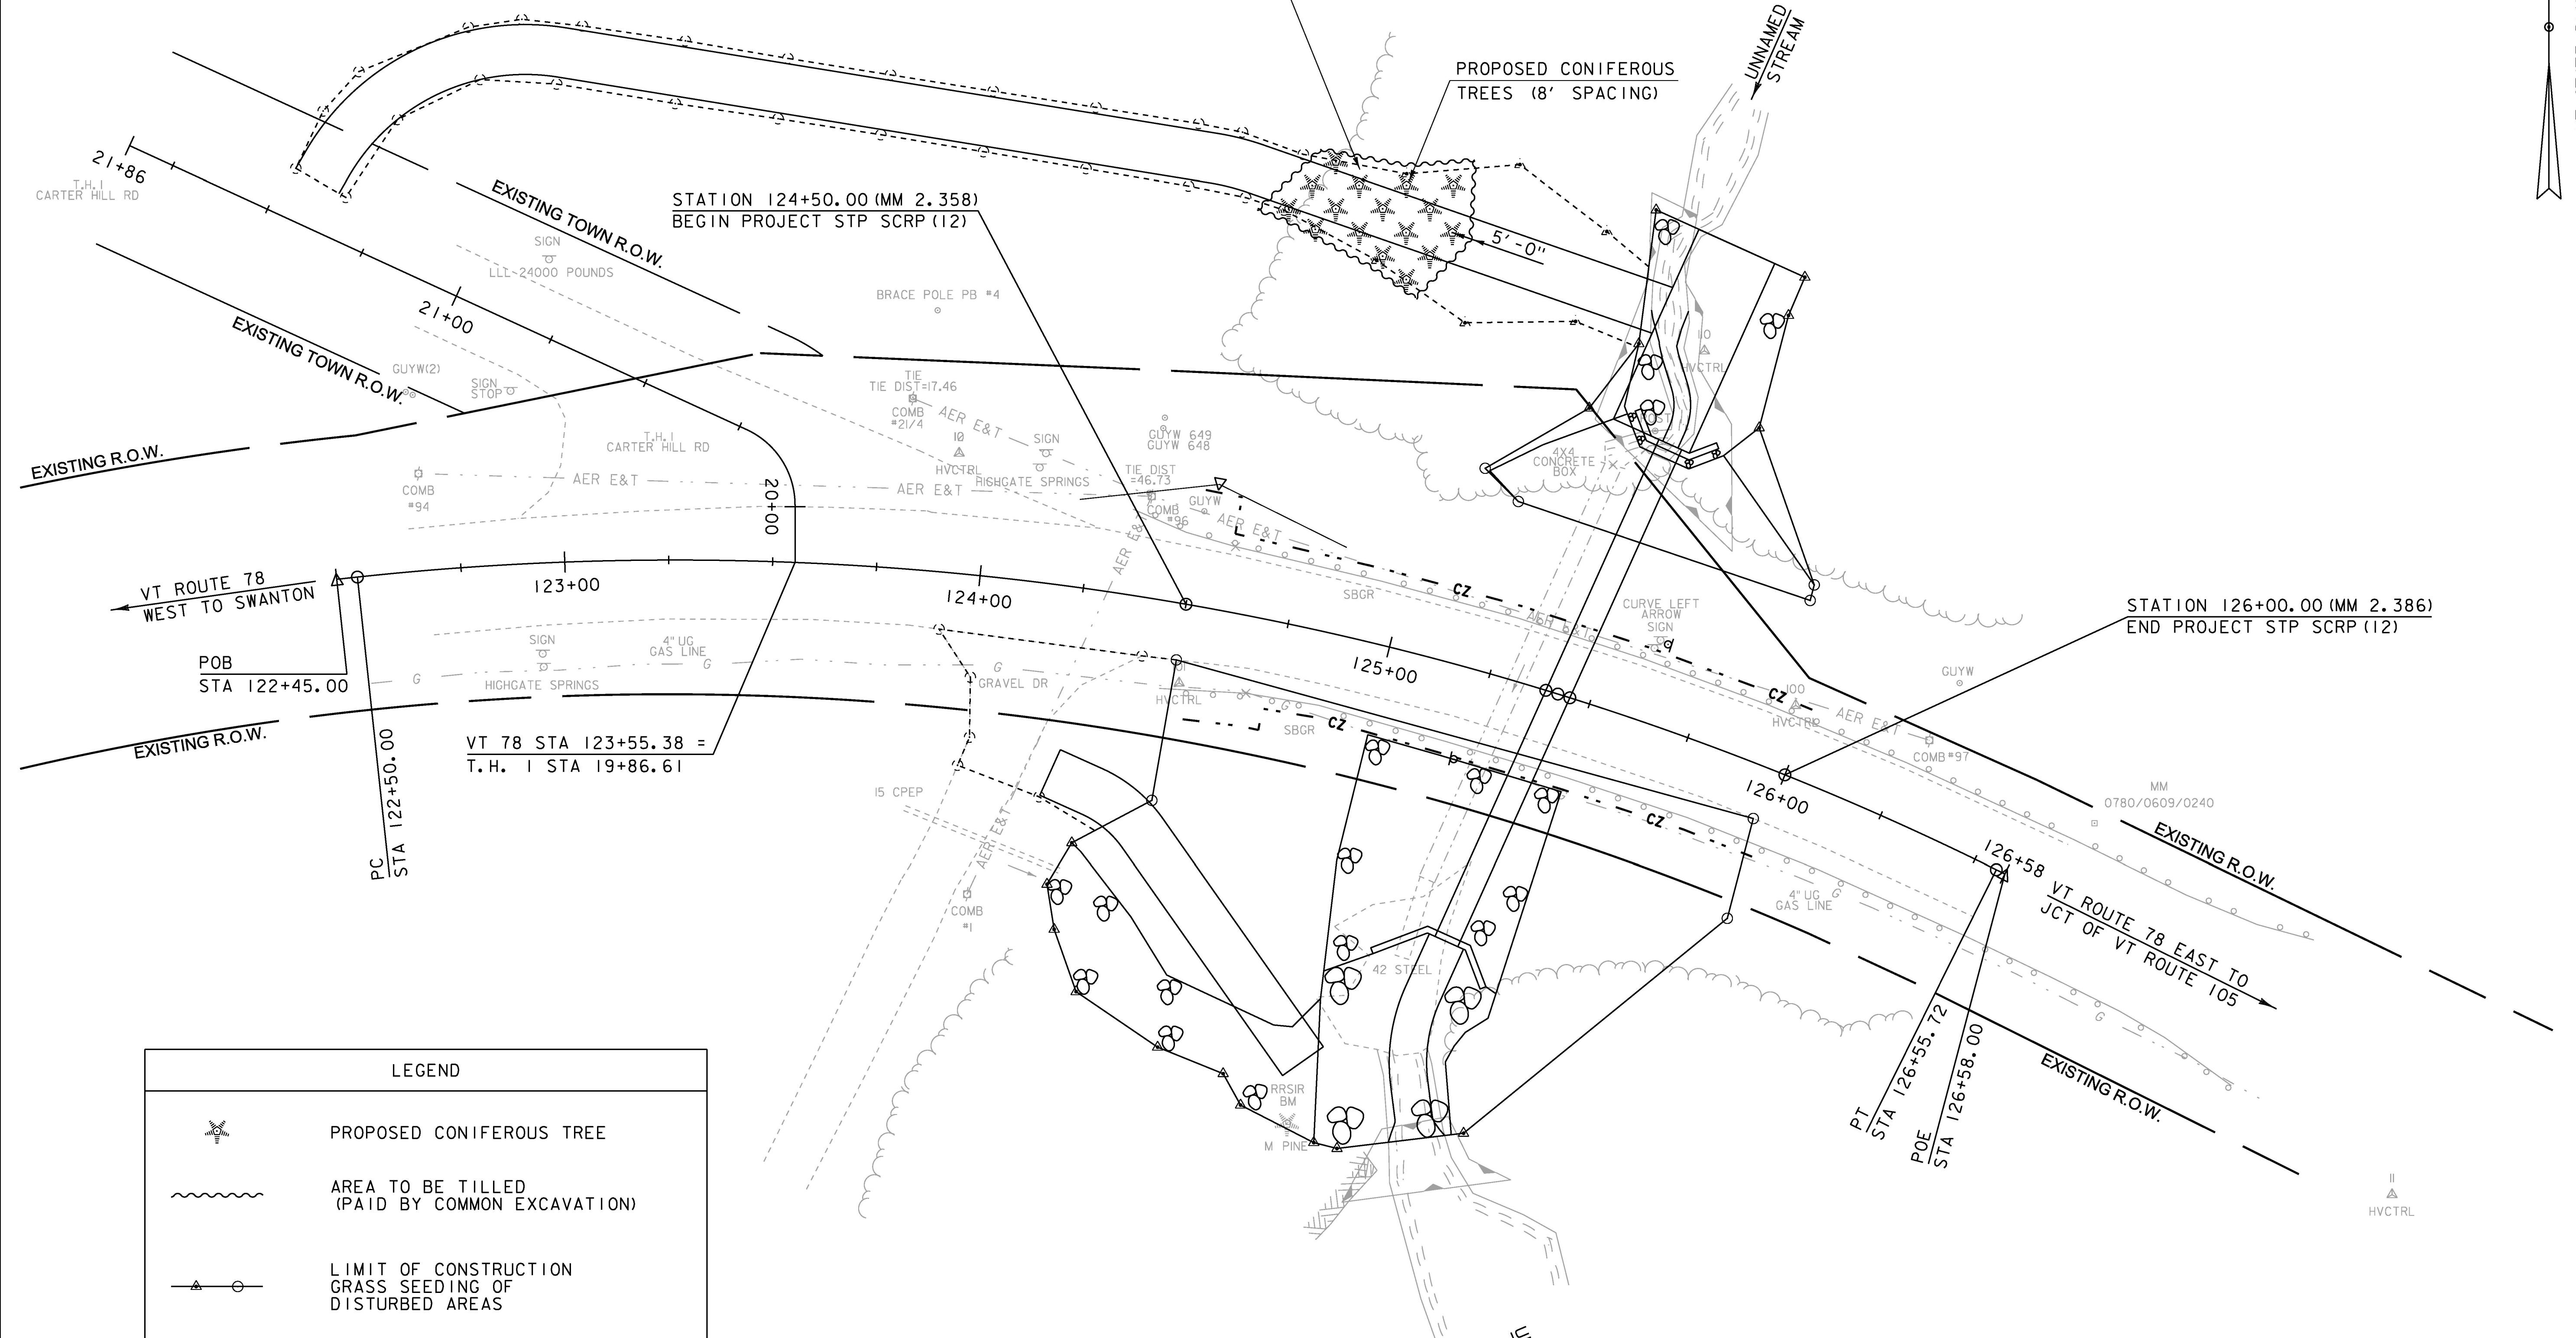

LEGEND	
	PROPOSED CONIFEROUS TREE
	AREA TO BE TILLED (PAID BY COMMON EXCAVATION)
	LIMIT OF CONSTRUCTION GRASS SEEDING OF DISTURBED AREAS
	TEMPORARY LIMIT OF CONSTRUCTION GRASS SEEDING OF DISTURBED AREAS

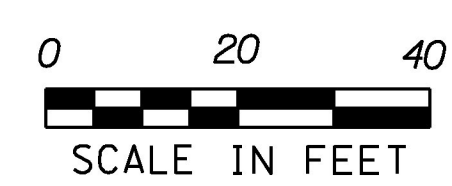

PROJECT NAME:	HIGHGATE	PLOT DATE:	14-OCT-2016
PROJECT NUMBER:	STP SCRPI(2)	DRAWN BY:	A. AGRAWAL
FILE NAME:	d\3ci34landscape.dgn	CHECKED BY:	A. KEMPTON
PROJECT LEADER:	B. MARTIN	LANDSCAPE PLAN SHEET	SHEET 20 OF 40

## **EPSC PLAN NARRATIVE**

### **1.1 PROJECT DESCRIPTION**

THIS PROJECT INVOLVES THE TRENCHLESS INSTALLATION OF A NEW 72" CULVERT (BRIDGE #10) WITH NEW HEADWALLS AND WINGWALLS. THE EXISTING BOX CULVERT WILL BE ABANDONED IN PLACE AND FILLED WITH FLOWABLE FILL. THIS PROJECT WILL ALSO INCLUDE SLOPE AND CHANNEL STABILIZATION. BRIDGE #10 IS LOCATED IN THE TOWN OF HIGHGATE, ON VT ROUTE 78, APPROXIMATELY AT THE INTERSECTION OF VT ROUTE 78, CARTER HILL ROAD (TH 1). THE LENGTH OF THE CULVERT WILL BE INCREASED TO 131 FEET.

NOTE: AREA OF DISTURBANCE ONLY INCLUDES LIMITS OF EARTH DISTURBANCE WITHIN THE PROJECT AREA AS SHOWN ON THE ATTACHED EPSC PLAN.

TOTAL AREA OF DISTURBANCE AS SHOWN ON THE ATTACHED EPSC PLAN IS APPROXIMATELY 0.78 ACRES.

IT IS ANTICIPATED THAT THIS PROJECT WILL LAST ONE CONSTRUCTION SEASON.

### **1.2 SITE INVENTORY**

#### **1.2.1 TOPOGRAPHY**

THE TOPOGRAPHY OF THE PROJECT AREA IS RELATIVELY FLAT WITH A SMALL RAVINE CREATED BY THE UNNAMED STREAM, WHICH BRIDGE #10 CARRIES UNDER VT ROUTE 78. THERE IS A WELL ESTABLISHED VEGETATIVE BUFFER ALONG THE STREAM, HOWEVER, THE SOUTH SIDE SLOPE OF VT ROUTE 78 IN THE PROJECT AREA IS UNSTABLE.

#### **1.2.2 DRAINAGE, WATERWAYS, BODIES OF WATER, AND PROXIMITY TO NATURAL OR MAN-MADE WATER FEATURES**

THE UNNAMED STREAM IS THE ONLY WATER SOURCE ON THE PROJECT SITE. THE STREAM CROSSING IS APPROXIMATELY 0.6 MILES UPSTREAM FROM THE MISSISSQUOI RIVER, WHERE THE STREAM OUTLETS. THE STREAM BED CONSISTS OF GRAVEL, COBBLES AND BOULDERS. THE TRIBUTARY AREA AT THE CULVERT CROSSING IS APPROXIMATELY 0.34 SQUARE MILES.

#### **1.2.3 VEGETATION**

THE VEGETATION IN THE PROJECT AREA CONSISTS PRIMARILY OF CONIFEROUS TREES AND UNDERGROWTH. THE IMPACT TO VEGETATION WILL BE LIMITED TO THAT WHICH IS DIRECTLY AFFECTED BY INSTALLATION OF THE NEW CULVERT, INCLUDING ACCESS ROADS. UPON PROJECT COMPLETION, THE CHANNEL WILL BE ARMORED WITH STONE FILL TYPE II AT THE INLET AND TYPE IV AT THE OUTLET AS SPECIFIED ON THE PLANS. DISTURBED VEGETATION WILL BE REESTABLISHED WITH STANDARD SEED AND MULCH PRACTICES.

#### **1.2.4 SOILS**

ALL SOIL DATA CAME FROM THE U.S. DEPARTMENT OF AGRICULTURE SOIL CONSERVATION SERVICE FOR THE COUNTY OF FRANKLIN, VERMONT. THE SOIL ON THE PROJECT SITE IS RAYNHAM SILT LOAM, 3% TO 8% SLOPES, "K FACTOR" = 0.49. THE SOIL IS POTENTIALLY HIGHLY ERODIBLE.

**NOTE:** K-VALUES GENERALLY INDICATE THE FOLLOWING:

0.0-0.23 = LOW EROSION POTENTIAL

0.24-0.36 = MODERATE EROSION POTENTIAL

0.37 AND HIGHER = HIGH EROSION POTENTIAL

#### **1.2.5 SENSITIVE RESOURCE AREAS**

CRITICAL HABITATS: NO

HISTORICAL OR ARCHEOLOGICAL AREAS: NO

PRIME AGRICULTURAL LAND: NO

THREATENED AND ENDANGERED SPECIES: NORTHERN LONG-EARED BAT

WATER RESOURCE: UNNAMED STREAM

WETLANDS: YES - THERE ARE SMALL WOODED WETLANDS NEAR THE INLET AND OUTLET OF THE PROPOSED CULVERT

### **1.3 RISK EVALUATION**

THIS PROJECT DOES NOT FALL UNDER THE JURISDICTION OF GENERAL PERMIT 3-9020 FOR STORMWATER RUNOFF FROM CONSTRUCTION SITES. SHOULD CHANGES PRIOR TO OR DURING CONSTRUCTION RESULT IN ONE OR MORE ACRES OF EARTH DISTURBANCE OR SHOULD THE PROJECT BECOME PART OF A LARGER PLAN OF DEVELOPMENT, THE CONTRACTOR WILL BE RESPONSIBLE FOR ANY ADDITIONAL PERMITTING.

### **1.4 EROSION PREVENTION AND SEDIMENT CONTROL**

THE EROSION CONTROL PLANS ARE MEANT AS A GUIDELINE FOR PREVENTING EROSION AND CONTROLLING SEDIMENT TRANSPORT. THE PRINCIPLES OUTLINED IN THIS NARRATIVE CONSIST OF APPLYING MEASURES THROUGHOUT CONSTRUCTION OF THE PROJECT IN ORDER TO MINIMIZE SEDIMENT TRANSPORT TO THE RECEIVING WATERS. THE MEASURES INCLUDE STABILIZATION AND STRUCTURAL PRACTICES, STORM WATER CONTROLS AND OTHER POLLUTION PREVENTION PRACTICES. THEY HAVE BEEN PROPOSED BY THE DESIGNER AS A BASIS FOR PROTECTING RESOURCES AND WILL NEED TO BE BUILT UPON BASED ON THE SPECIFIC MEANS AND METHODS OF THE CONTRACTOR. REFER TO THE LOW RISK SITE HANDBOOK AND APPROPRIATE DETAIL SHEETS FOR SPECIFIC GUIDANCE AND CONSTRUCTION DETAILING.

ALL MEASURES SHALL BE REGULARLY MAINTAINED AND SHALL BE CHECKED FOR SEDIMENT BUILD-UP. SEDIMENT SHALL BE DISPOSED OF AT AN APPROVED SITE WHERE IT WILL NOT BE SUBJECT TO EROSION.

#### **1.4.1 MARK SITE BOUNDARIES**

SITE BOUNDARIES AND AREAS CONSTRUCTION EQUIPMENT CAN ACCESS SHALL BE DELINEATED.

PROJECT DEMARCATION FENCING (PDF) SHALL BE USED TO PHYSICALLY MARK SITE BOUNDARIES. BARRIER FENCE SHALL BE USED INSTEAD OF PROJECT DEMARCATION FENCE WITHIN 100 FEET OF A WATER RESOURCE (STREAM, BROOK, LAKE, POND, WETLAND, ETC).

#### **1.4.2 LIMIT DISTURBANCE AREA**

PREVENTING INITIAL SOIL EROSION BY MINIMIZING THE EXPOSED AREA IS MUCH MORE EFFECTIVE THAN TREATING ERODED SEDIMENT. EARTH DISTURBANCE CAN BE MINIMIZED THROUGH CONSTRUCTION PHASING BY ONLY OPENING UP EARTH AS NECESSARY. THIS CAN LIMIT THE AREA THAT WILL BE DISTURBED AND EXPOSED TO EROSION. EMPLOY TEMPORARY CONSTRUCTION STABILIZATION PRACTICES IN INCREMENTAL STAGES AS PHASES CHANGE. FOR PROJECTS WHICH FALL UNDER THE CONSTRUCTION GENERAL PERMIT, ONLY THE ACREAGE LISTED ON THE PERMIT AUTHORIZATION MAY BE EXPOSED AT ANY GIVEN TIME.

MAINTAINING VEGETATED BUFFERS ALONG STREAM BANKS, WETLANDS OR OTHER SENSITIVE AREAS IS A CRUCIAL EROSION AND SEDIMENT CONTROL MEASURE THAT SHOULD BE ESTABLISHED WHEREVER POSSIBLE.

#### **1.4.3 SITE ENTRANCE/EXIT STABILIZATION**

TRACKING OF SEDIMENT ONTO PUBLIC HIGHWAYS SHALL BE MINIMIZED TO REDUCE THE POTENTIAL FOR RUNOFF ENTERING RECEIVING WATERS. INSTALLATION SHALL COINCIDE WITH THE CONTRACTORS PROGRESS SCHEDULE.

STABILIZED CONSTRUCTION ENTRANCES SHALL BE INSTALLED AS PROPOSED ON THE EPSC PLAN AND ANYWHERE EQUIPMENT WILL BE GOING FROM AREAS OF EXPOSED SOILS TO PAVED SURFACES. THERE SHALL BE TWO STABILIZED CONSTRUCTION ENTRANCES EMPLOYED, ONE AT THE BEGINNING OF EACH ACCESS ROAD.

#### **1.4.4 INSTALL SEDIMENT BARRIERS**

SEDIMENT BARRIERS SHALL BE UTILIZED TO INTERCEPT RUNOFF AND ALLOW SUSPENDED SEDIMENT TO SETTLE OUT. THEY SHALL BE INSTALLED PRIOR TO ANY UP SLOPE WORK.

WOVEN WIRE REINFORCED SILT FENCE WILL BE INSTALLED AS PROPOSED ON THE EPSC PLAN. WOVEN WIRE REINFORCED SILT FENCE SHALL BE USED INSTEAD OF SILT FENCE WITHIN 100 FEET UPSLOPE OF RECEIVING WATERS.

#### **1.4.5 DIVERT UPLAND RUNOFF**

DIVERSIONARY MEASURES SHALL BE USED TO INTERCEPT RUNOFF FROM ABOVE THE CONSTRUCTION AND DIRECT IT AROUND THE DISTURBED AREA SO THAT CLEAN WATER DOES NOT BECOME MUDDIED WHILE TRAVELING OVER EXPOSED SOILS ON THE CONSTRUCTION SITE.

DIVERSION MEASURES ARE NOT ANTICIPATED ON THIS PROJECT.

#### **1.4.6 SLOW DOWN CHANNELIZED RUNOFF**

CHECK STRUCTURES SHALL BE UTILIZED TO REDUCE THE VELOCITY, AND THUS THE EROSION POTENTIAL, OF CONCENTRATED FLOW IN CHANNELS.

THERE ARE NO AREAS OF CHANNELIZED FLOW ANTICIPATED ON THE PROJECT, ASIDE FROM THE STREAM ITSELF, THEREFORE, THE USE OF CHECK DAMS IS NOT ANTICIPATED.

#### **1.4.7 CONSTRUCT PERMANENT CONTROLS**

PERMANENT STORMWATER TREATMENT DEVICES SHALL BE INSTALLED AS SHOWN ON THE PLANS AND IN ACCORDANCE WITH PERMIT CONDITIONS.

#### **1.4.8 STABILIZE EXPOSED SOILS DURING CONSTRUCTION**

ALL AREAS OF DISTURBANCE MUST HAVE TEMPORARY STABILIZATION IN PLACE WITHIN 48 HOURS OF DISTURBANCE, EXCEPT WHERE FURTHER CONSTRUCTION ACTIVITIES ARE ANTICIPATED TO OCCUR WITHIN 48 HOURS.

SURFACE ROUGHENING OF ALL EXPOSED SLOPES, COMBINED WITH TEMPORARY MULCHING, SHALL BE UTILIZED ON A REGULAR BASIS. BIODEGRADABLE EROSION CONTROL MATTING OR AN EQUIVALENT SHALL BE USED TO STABILIZE ALL SLOPES STEEPER THAN 1:3.

THE FORECAST OF RAINFALL EVENTS SHALL TRIGGER IMMEDIATE PROTECTION OF EXPOSED SOILS.

#### **1.4.9 WINTER STABILIZATION**

VARIOUS MEASURES SPECIFIC TO WINTER MAY BE NECESSARY SHOULD THE PROJECT EXTEND INTO WINTER (OCTOBER 15 THROUGH APRIL 15). REFER TO THE LOW RISK SITE HANDBOOK FOR GUIDANCE.

WINTER CONSTRUCTION ACTIVITIES ARE NOT ANTICIPATED TO OCCUR, THEREFORE, THIS PRINCIPAL MAY NOT BE NECESSARY.

#### **1.4.10 STABILIZE SOIL AT FINAL GRADE**

EXPOSED SOIL MUST BE STABILIZED WITHIN 48 HOURS OF REACHING FINAL GRADE.

SEED, MULCH, FERTILIZER AND LIME SHALL BE USED TO ESTABLISH PERMANENT VEGETATION. FOR SLOPES STEEPER THAN 1:3, TEMPORARY EROSION CONTROL MATTING OR AN EQUIVALENT SHALL BE USED INSTEAD OF MULCH. SEEDING FORMULAS CAN BE SEEN ON THE DETAIL SHEETS FOLLOWING THIS SHEET.

#### **1.4.11 DE-WATERING ACTIVITIES**

DISCHARGE FROM DEWATERING ACTIVITIES THAT FLOWS OFF OF THE CONSTRUCTION SITE MUST NOT CAUSE OR CONTRIBUTE TO A VIOLATION OF THE VERMONT WATER QUALITY STANDARDS.

MAINTAINING THE EXISTING FLOW IN THE STREAM IS ANTICIPATED (IT MAY BE DIVERTED), THEREFORE THIS PRINCIPAL MAY NOT BE NECESSARY.

#### **1.4.12 INSPECT YOUR SITE**

INSPECT THE PROJECT SITE BASED ON SPECIAL PROVISION REQUIREMENTS OR CONSTRUCTION GENERAL PERMIT AUTHORIZATION STIPULATIONS.

### **1.5 SEQUENCE AND STAGING**

THIS SECTION WILL BE DEVELOPED BY THE CONTRACTOR USING THE GUIDANCE OUTLINED IN THE VTRANS EPSC PLAN CONTRACTOR CHECKLIST.

#### **1.5.1 OFF-SITE ACTIVITIES**

IN ADDITION TO THE CONTRACTOR CHECKLIST ANY ACTIVITIES OUTSIDE THE CONSTRUCTION LIMITS SHALL FOLLOW SUBSECTION 105.25- 105.29 OF THE STANDARD SPECIFICATIONS FOR CONSTRUCTION.

PROJECT NAME:	HIGHGATE
PROJECT NUMBER:	STP_SCRP(12)
FILE NAME: dl3cl34_frm.dgn	PLOT DATE: 14-OCT-2016
PROJECT LEADER: B. MARTIN	DRAWN BY: A. KEMPTON
DESIGNED BY: A. KEMPTON	CHECKED BY: W. FARLEY
EPSC NARRATIVE SHEET	SHEET 21 OF 40

VAOT LOW GROW/FINE FESCUE MIX						
WEIGHT	LBS/AC		NAME	LATIN NAME	GERM	PURITY
	BROADCAST	HYDROSEED				
38%	57	95	CREeping RED FESCUE	FESTUCA RUBRA VAR. RUBRA	90%	98%
29%	43.5	72.5	HARD FESCUE	FESTUCA LONGIFOLIA	85%	95%
15%	22.5	37.5	CHEWINGS FESCUE	FESTUCA RUBRA VAR. COMMUTATA	87%	95%
15%	22.5	37.5	ANNUAL RYEGRASS	LOLIUM MULTIFLORUM	90%	95%
3%	4.5	7.5	INERTS			
100%	150	250				


VAOT RURAL AREA MIX						
WEIGHT	LBS/AC		NAME	LATIN NAME	GERM	PURITY
	BROADCAST	HYDROSEED				
37.5%	22.5	45	CREeping RED FESCUE	FESTUCA RUBRA VAR. RUBRA	85%	98%
37.5%	22.5	45	TALL FESCUE	FESTUCA ARUNDINACEA	90%	95%
5.0%	3	6	RED TOP	AGROSTIS GIGANTEA	90%	95%
15.0%	9	18	WHITE FIELD CLOVER	TRIFOLIUM REPENS	85%	98%
5.0%	3	6	ANNUAL RYE GRASS	LOLIUM MULTIFLORUM	85%	95%
100%	60	120				

GENERAL AMENDMENT GUIDANCE		
FERTILIZER	LIME	
10/20/10	AG LIME	PELLITIZED
500 LBS/AC	2 TONS/AC	1 TONS/AC

**CONSTRUCTION GUIDANCE**

1. SEED MIX: THE CONTRACTOR SHALL COORDINATE WITH THE RESIDENT ENGINEER ON WHICH SEED MIX TO USE.
2. SEED MIX: USE AS INDICATED IN THE PLANS AND/OR FOR ALL ESTABLISHED UPLAND (NON WETLAND) AREAS DISTURBED BY THE CONTRACTOR.
3. ALL SEED MIXTURES: SHALL NOT HAVE A WEED CONTENT EXCEEDING 0.40% BY WEIGHT AND SHALL BE FREE OF ALL NOXIOUS SEED.
4. FERTILIZER AND LIMESTONE: SHALL FOLLOW RATES SHOWN ON PLAN OR AS DIRECTED BY THE ENGINEER.
5. HAY MULCH: TO BE PLACED ON EARTH SLOPES AT THE RATE OF 2 TONS/ACRE, ACHIEVE 90% GROUND COVER OR AS DIRECTED BY THE ENGINEER.
6. HYDROSEEDING: ALTHOUGH GUIDANCE IS GIVEN ABOVE THE SITE CONDITIONS AND THE TYPE OF HYDROSEED PROPOSED FOR USE WILL ULTIMATELY DICTATE THE AMOUNTS AND TYPES OF SOIL AMENDMENTS TO BE APPLIED.
7. TURF ESTABLISHMENT: PLACING SEED, FERTILIZER, LIME AND MULCH PRIOR TO SEPTEMBER 15 AND AFTER APRIL 15 CAN BETTER ENSURE A VIGOROUS GROWTH OF GRASS.

ADAPTED FROM VTRANS TECHNICAL LANDSCAPE MANUAL FOR ROADWAYS AND TRANSPORTATION FACILITIES	<b>TURF ESTABLISHMENT</b>
THIS WORK SHALL BE PERFORMED IN ACCORDANCE WITH SECTION 651 FOR SEED (PAY ITEM 651.15)	REVISIONS JANUARY 12, 2015 WHF

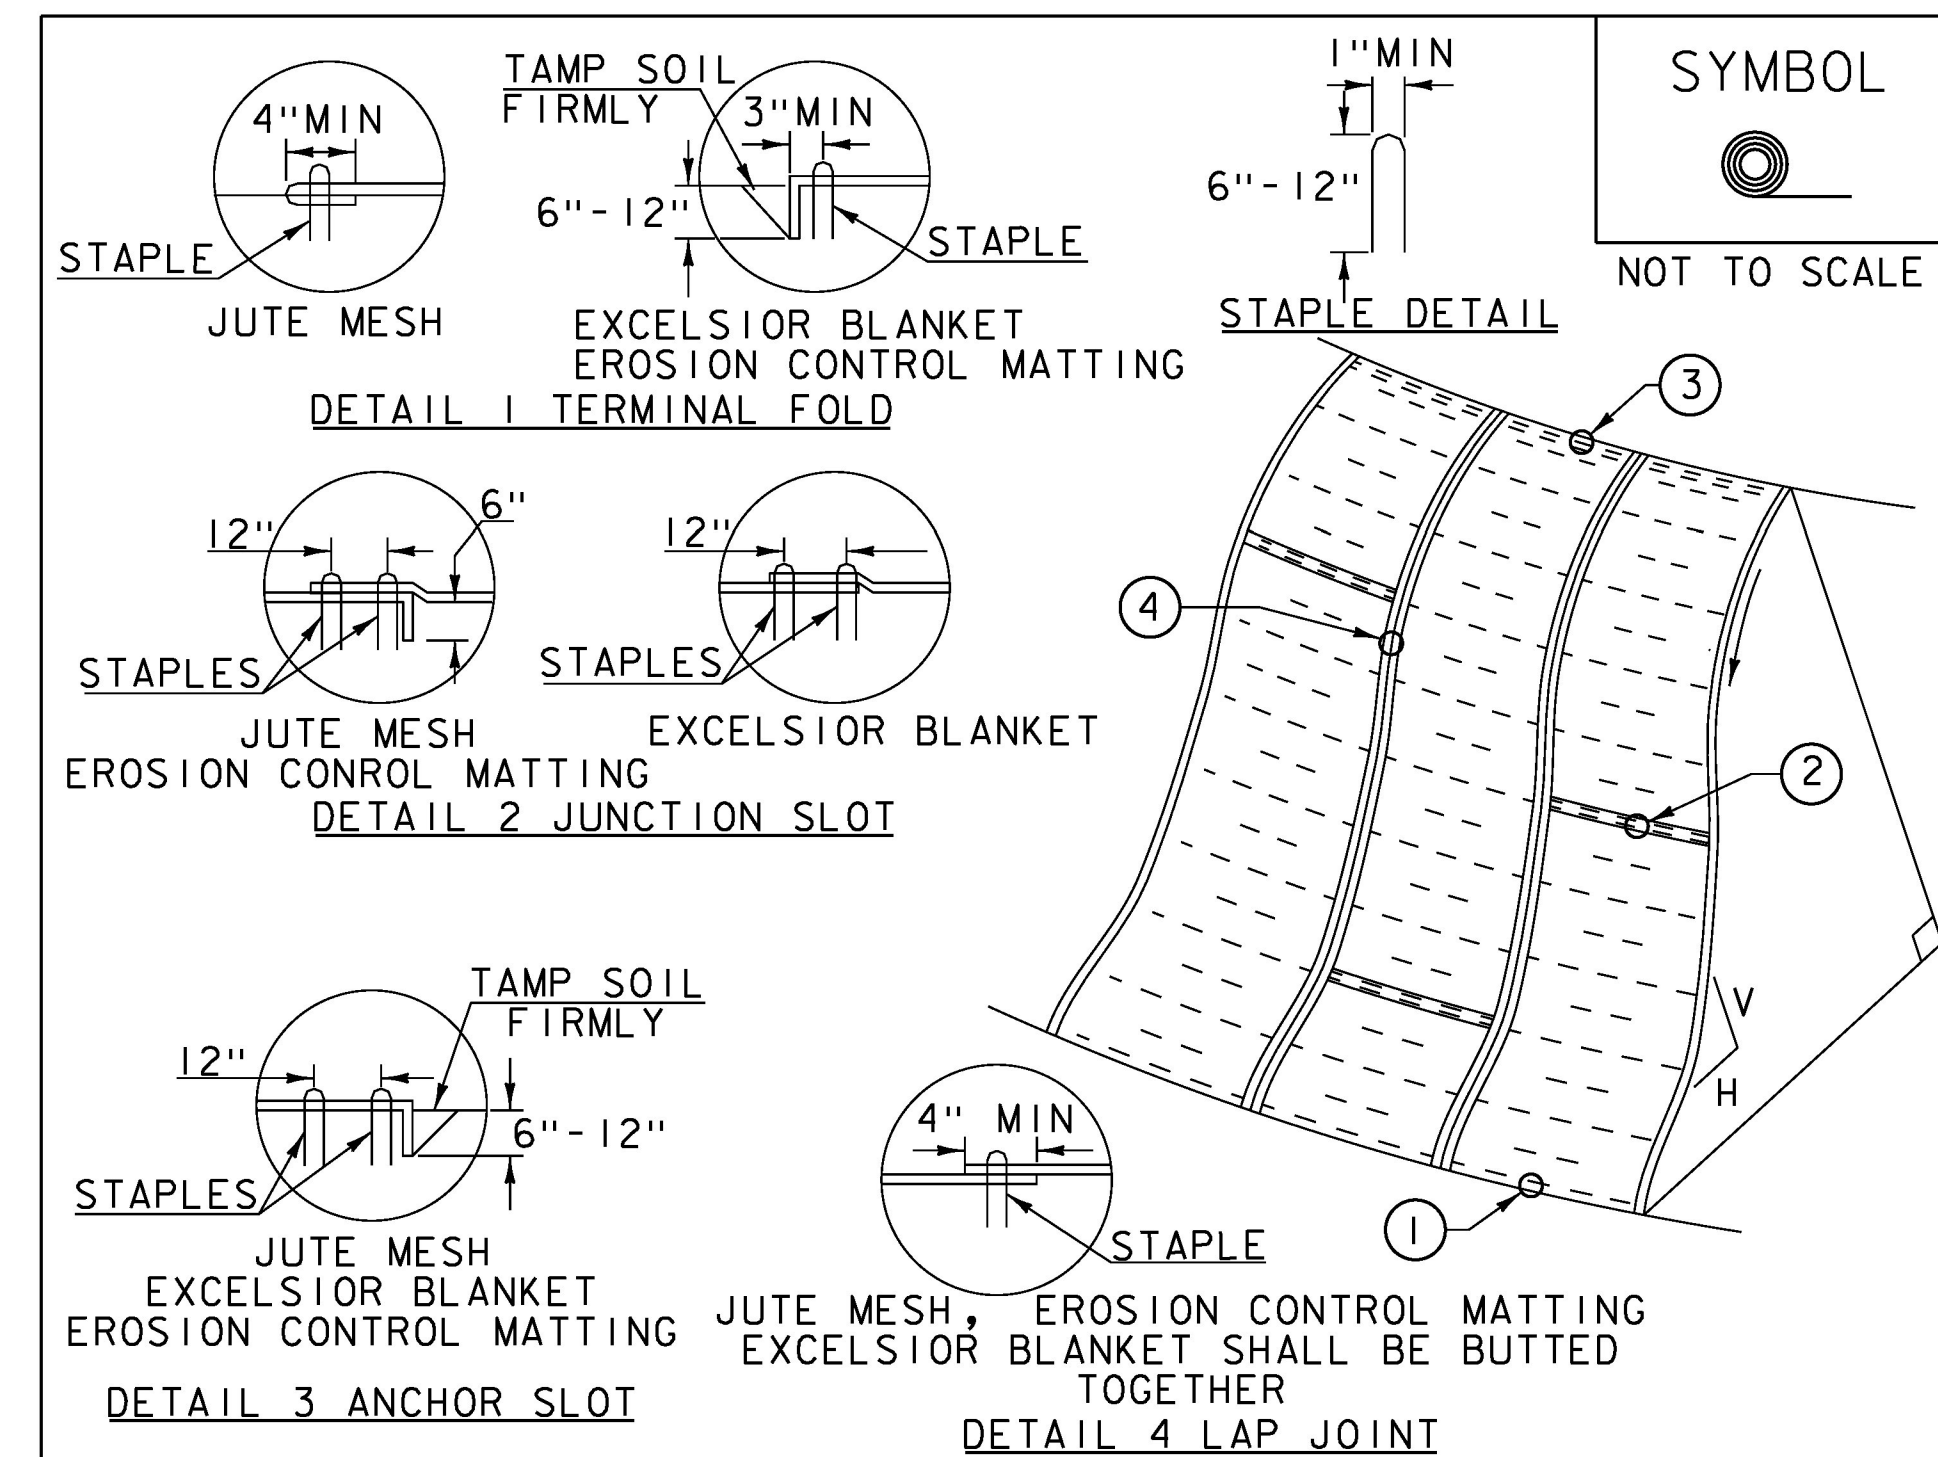


- CONSTRUCTION SPECIFICATIONS**
1. APPLY TO SLOPES GREATER THAN 3H:1V OR WHERE NECESSARY TO AID IN ESTABLISHING VEGETATION.
  2. APPLY FERTILIZER, LIME SEED PRIOR TO PLACING MATTING.
  3. STAPLES ARE TO BE PLACED ALTERNATELY, IN COLUMNS APPROXIMATELY 2' APART AND IN ROWS APPROXIMATELY 3' APART. APPROXIMATELY 175 STAPLES ARE REQUIRED PER 4' X 225' ROLL OF MATERIAL AND 125 STAPLES ARE REQUIRED PER 4' X 150' ROLL OF MATERIAL.
  4. DISTURBED AREAS SHALL BE SMOOTHLY GRADED. EROSION CONTROL MATERIAL SHALL BE PLACED LOOSELY OVER GROUND SURFACE. DO NOT STRETCH.
  5. ALL TERMINAL ENDS AND TRANSVERSE LAPS SHALL BE STAPLED AT APPROXIMATELY 12" INTERVALS.

ADAPTED FROM DETAILS PROVIDED BY: NEW YORK STATE DEC  
ORIGINALLY DEVELOPED BY USDA-NRCS  
VERMONT DEPARTMENT OF ENVIRONMENTAL CONSERVATION

**ROLLED EROSION CONTROL PRODUCT (RECP) SIDE SLOPE**

NOTES: REFER TO "THE VERMONT STANDARDS & SPECIFICATIONS FOR EROSION PREVENTION & SEDIMENT CONTROL -2006-" FROM THE VT AGENCY OF NATURAL RESOURCES FOR ADDITIONAL GUIDANCE. THIS WORK SHALL BE PERFORMED IN ACCORDANCE WITH SECTION 653 AND AS SHOWN IN THE PLANS FOR TEMPORARY EROSION MATTING (PAY ITEM 653.20) OR PERMANENT EROSION MATTING (PAY ITEM 653.21).	REVISIONS APRIL 16, 2007 JMF JANUARY 13, 2009 WHF
------------------------------------------------------------------------------------------------------------------------------------------------------------------------------------------------------------------------------------------------------------------------------------------------------------------------------------------------------------------------	---------------------------------------------------------

PROJECT NAME: HIGHGATE	PLOT DATE: 14-OCT-2016
PROJECT NUMBER: STP SCRPI(2)	DRAWN BY: A. KEMPTON
FILE NAME: d13ci34_frm.dgn	CHECKED BY: W. FARLEY
DESIGNED BY: A. KEMPTON	SHEET 22 OF 40
EPSC DETAIL SHEET 1	

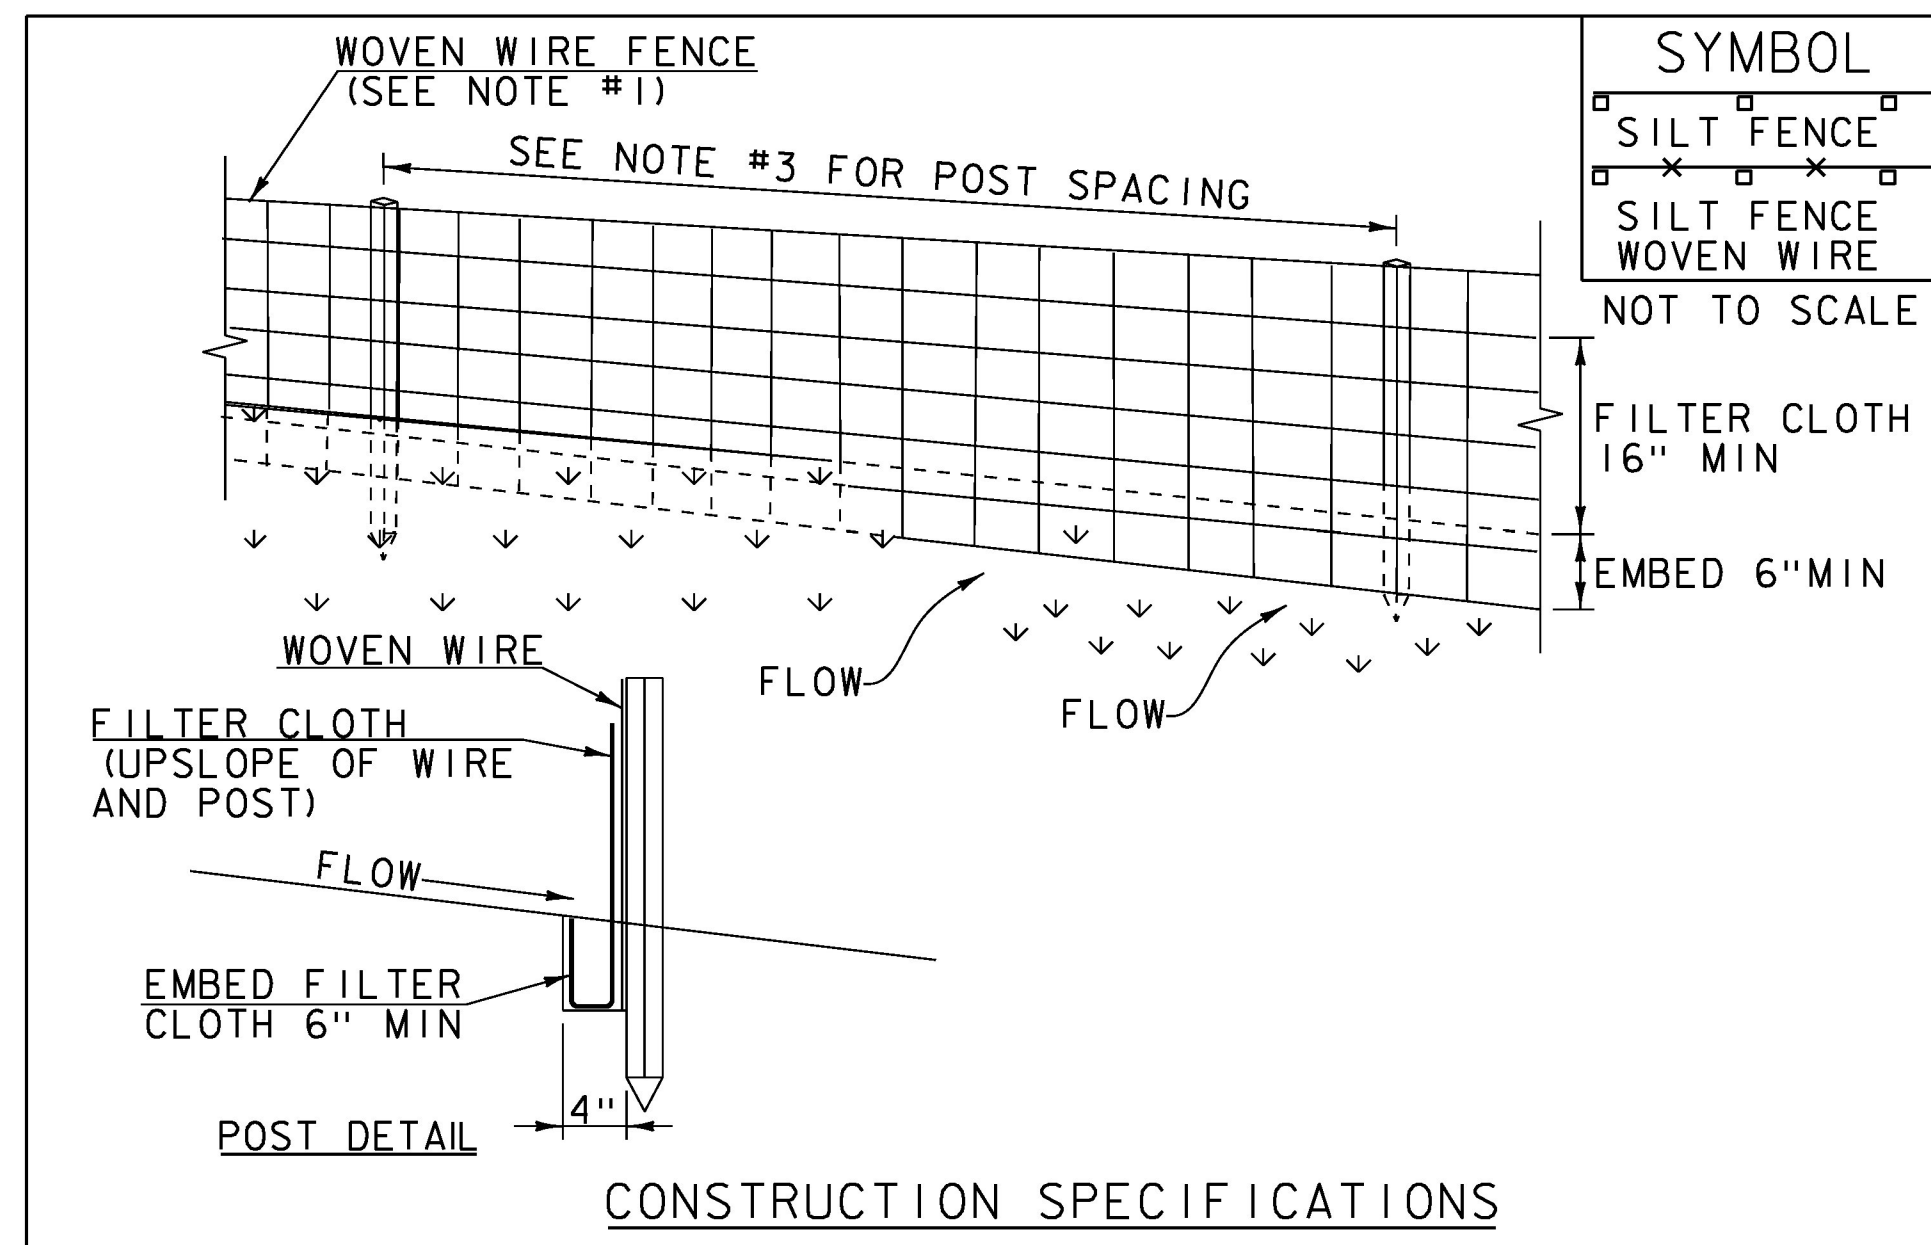

SYMBOL	
[Symbol]	SILT FENCE
[Symbol]	SILT FENCE WOVEN WIRE

- CONSTRUCTION SPECIFICATIONS**
- WOVEN WIRE REINFORCED FENCE IS REQUIRED WITHIN 100' UPSLOPE OF RECEIVING WATERS WHEN THE PROJECT FALLS UNDER A CONSTRUCTION STORMWATER PERMIT. WOVEN WIRE SHALL BE A MIN. 14 GAUGE WITH A 6" MAX. MESH OPENING.
  - FILTER CLOTH SHALL BE EITHER FILTER X, MIRAFL100X, STABILINKA T140N OR APPROVED EQUIVALENT.
  - POST SPACING FOR WIRE-BACKED FENCE SHALL BE 10' MAXIMUM. FOR FILTER-CLOTH FENCE, WHEN ELONGATION IS >50%, POST SPACING SHALL NOT EXCEED 4' AND WHEN ELONGATION IS <50%, POST SPACING SHALL NOT EXCEED 6'.
  - WOVEN WIRE FENCE IS TO BE FASTENED SECURELY TO FENCE POSTS WITH WIRE TIES. FILTER CLOTH IS TO BE FASTENED SECURELY TO WOVEN WIRE FENCE WITH TIES SPACED EVERY 24" AT TOP AND MID SECTION.
  - WHEN TWO SECTIONS OF FILTER CLOTH ADJOIN EACH OTHER THEY SHALL BE OVER-LAPPED BY 6" AND FOLDED.
  - MAINTENANCE SHALL BE PERFORMED AS NEEDED AND MATERIAL REMOVED WHEN SEDIMENT REACHES HALF OF FABRIC HEIGHT.


ADAPTED FROM DETAILS PROVIDED BY: NEW YORK STATE DEC  
ORIGINALLY DEVELOPED BY USDA-NRCS  
VERMONT DEPARTMENT OF ENVIRONMENTAL CONSERVATION

**SILT FENCE**

NOTES:  
REFER TO "THE VERMONT STANDARDS & SPECIFICATIONS FOR EROSION PREVENTION & SEDIMENT CONTROL -2006-" FROM THE VT AGENCY OF NATURAL RESOURCES FOR ADDITIONAL GUIDANCE.

THIS WORK SHALL BE PERFORMED IN ACCORDANCE WITH SECTION 649 AND AS SHOWN IN THE PLANS FOR GEOTEXTILE FOR SILT FENCE (PAY ITEM 649.5) OR GEOTEXTILE FOR SILT FENCE, WOVEN WIRE REINFORCED (PAY ITEM 649.515).

REVISIONS	
MARCH 21, 2008	WHF
DECEMBER 11, 2008	WHF
JANUARY 13, 2009	WHF

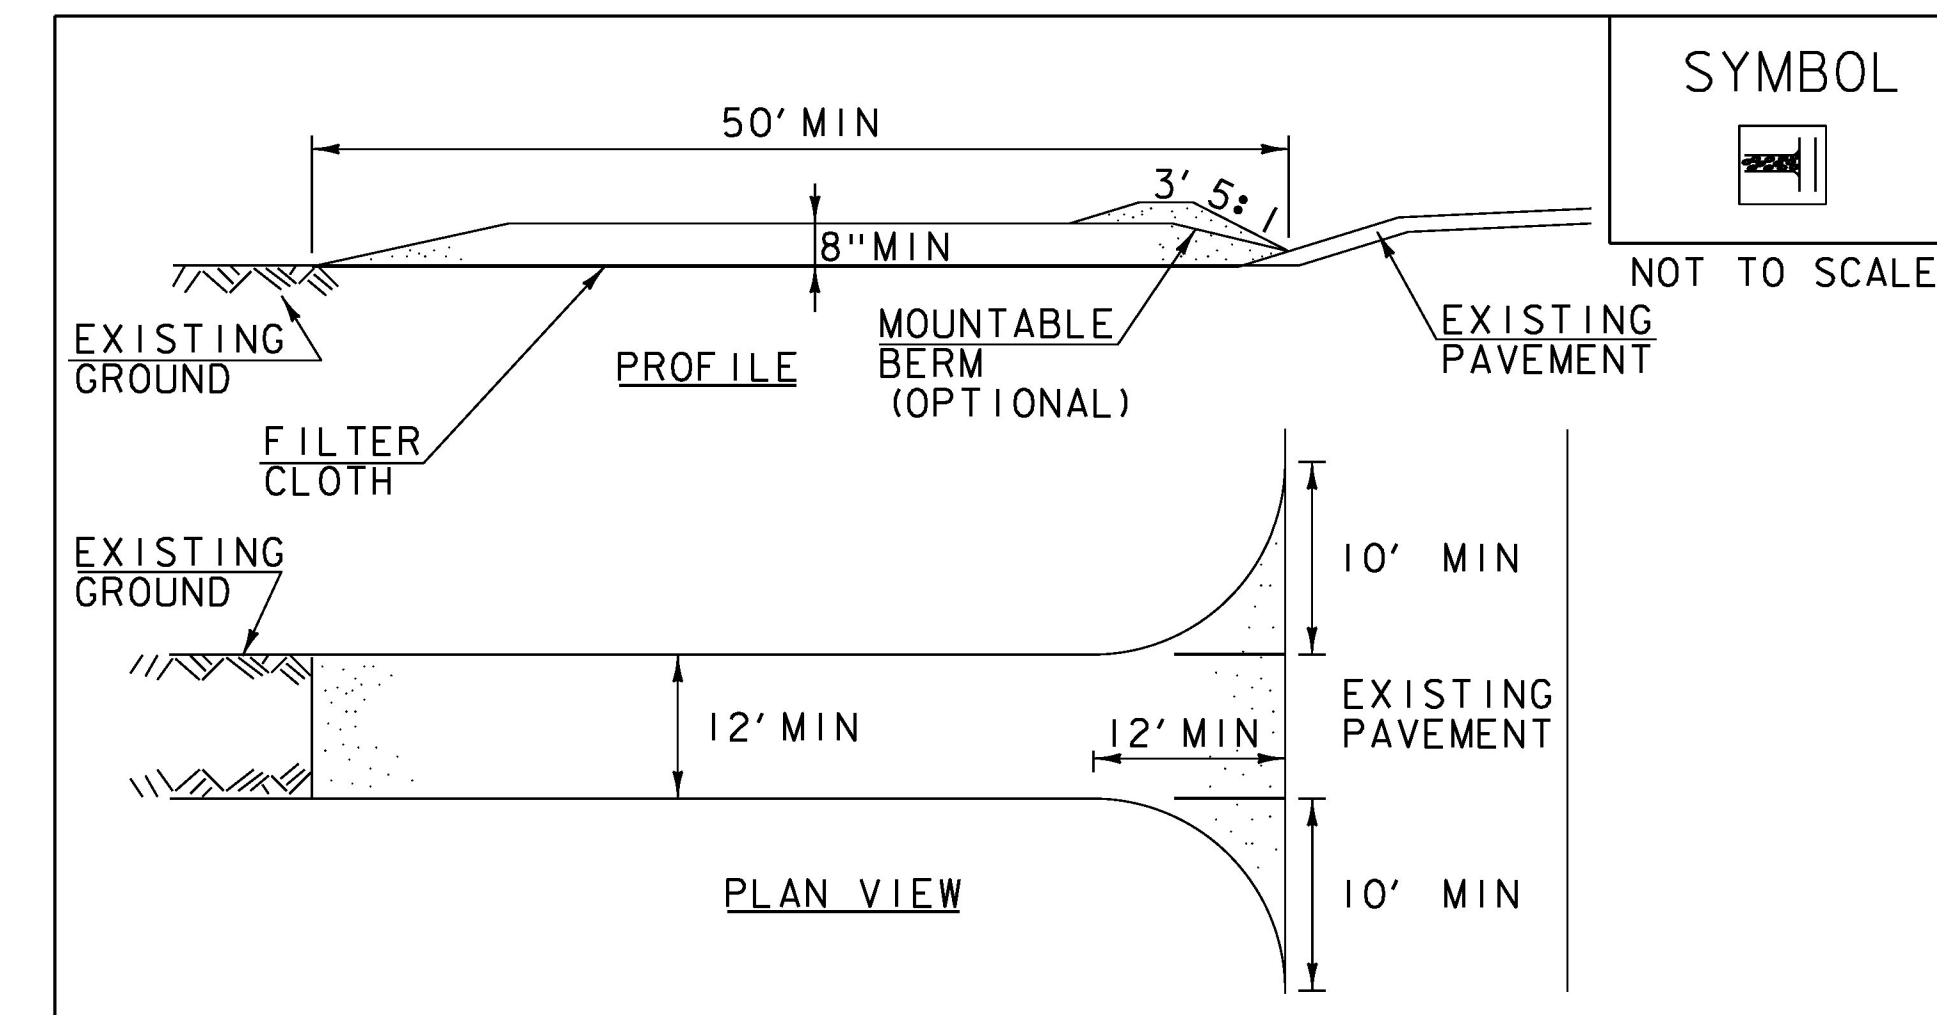

SYMBOL	
[Symbol]	STABILIZED CONSTRUCTION ENTRANCE

- CONSTRUCTION SPECIFICATIONS**
- STONE SIZE- USE 1-4" STONE, RECLAIMED OR RECYCLED CONCRETE EQUIVALENT.
  - LENGTH- NOT LESS THAN 50' (EXCEPT ON A SINGLE RESIDENCE LOT WHERE A 30' MINIMUM LENGTH APPLIES).
  - THICKNESS- NOT LESS THAN 8".
  - WIDTH- 12' MINIMUM, BUT NOT LESS THAN THE FULL WIDTH AT POINTS WHERE INGRESS OR EGRESS OCCURS. 24' IF SINGLE ENTRANCE TO SITE.
  - GEOTEXTILE MUST BE PLACED OVER THE ENTIRE AREA PRIOR TO PLACING STONE.
  - SURFACE WATER- ALL SURFACE WATER FLOWING OR DIVERTED TOWARD CONSTRUCTION ENTRANCES SHALL BE PIPED BENEATH THE ENTRANCE. IF PIPING IS IMPRACTICAL, A MOUNTABLE BERM WITH 5:1 SLOPES WILL BE PERMITTED.
  - MAINTENANCE- THE ENTRANCE SHALL BE MAINTAINED IN A CONDITION WHICH WILL PREVENT TRACKING OR FLOWING OF SEDIMENT ONTO PUBLIC RIGHTS-OF-WAY, ALL SEDIMENT SPILLED, DROPPED, WASHED OR TRACKED ONTO PUBLIC RIGHTS-OF-WAY MUST BE REMOVED IMMEDIATELY.
  - WHEN WASHING IS REQUIRED, IT SHALL BE DONE ON AN AREA STABILIZED WITH STONE AND WHICH DRAINS INTO AN APPROVED SEDIMENT TRAPPING DEVICE.
  - PERIODIC INSPECTION AND NEEDED MAINTENANCE SHALL BE PROVIDED ACCORDING TO PERMIT REQUIREMENTS.

ADAPTED FROM DETAILS PROVIDED BY: NEW YORK STATE DEC  
ORIGINALLY DEVELOPED BY USDA-NRCS  
VERMONT DEPARTMENT OF ENVIRONMENTAL CONSERVATION

**STABILIZED CONSTRUCTION ENTRANCE**

NOTES:  
REFER TO "THE VERMONT STANDARDS & SPECIFICATIONS FOR EROSION PREVENTION & SEDIMENT CONTROL -2006-" FROM THE VT AGENCY OF NATURAL RESOURCES FOR ADDITIONAL GUIDANCE.

THIS WORK SHALL BE PERFORMED IN ACCORDANCE WITH SECTION 653 FOR VEHICLE TRACKING PAD (PAY ITEM 653.35) OR AS SPECIFIED IN THE CONTRACT.

REVISIONS	
MARCH 24, 2008	WHF
JANUARY 13, 2009	WHF



PROJECT NAME: HIGHGATE  
PROJECT NUMBER: STP SCRP(12)  
FILE NAME: d13ci34_frm.dgn PLOT DATE: 14-OCT-2016  
PROJECT LEADER: B. MARTIN DRAWN BY: A. KEMPTON  
DESIGNED BY: A. KEMPTON CHECKED BY: W. FARLEY  
EPSC DETAIL SHEET 2 SHEET 23 OF 40

**VEHICLE TRACKING PAD**  
 T.H. 1 STA 21+45.5 RT  
 STA 124+12.4 RT

**PROJECT DEMARCATION FENCE**  
 N. ACCESS RD STA 0+00.0 - 2+37.2 LT  
 N. ACCESS RD STA 0+00.0 - 2+37.2 RT


**BARRIER FENCE**  
 N. ACCESS RD STA 2+37.2 LT - MAINLINE STA 126+03.3 LT  
 N. ACCESS RD STA 2+37.2 RT - N. ACCESS RD STA 3+38.7 RT  
 STA 124+16.7 - 126+07.7 RT

**GEOTEXTILE FOR SILT FENCE, WOVEN WIRE REINFORCED**  
 STA 124+47.8 - 124+62.1 RT  
 STA 124+62.3 - 124+77.3 RT  
 STA 124+92.1 - 125+02.8 RT  
 STA 125+02.2 - 125+06.4 LT  
 STA 125+12.7 - 125+14.2 LT  
 STA 125+28.9 - 125+29.6 LT  
 STA 125+35.1 - 125+35.8 LT  
 STA 125+53.5 - 125+74.3 RT

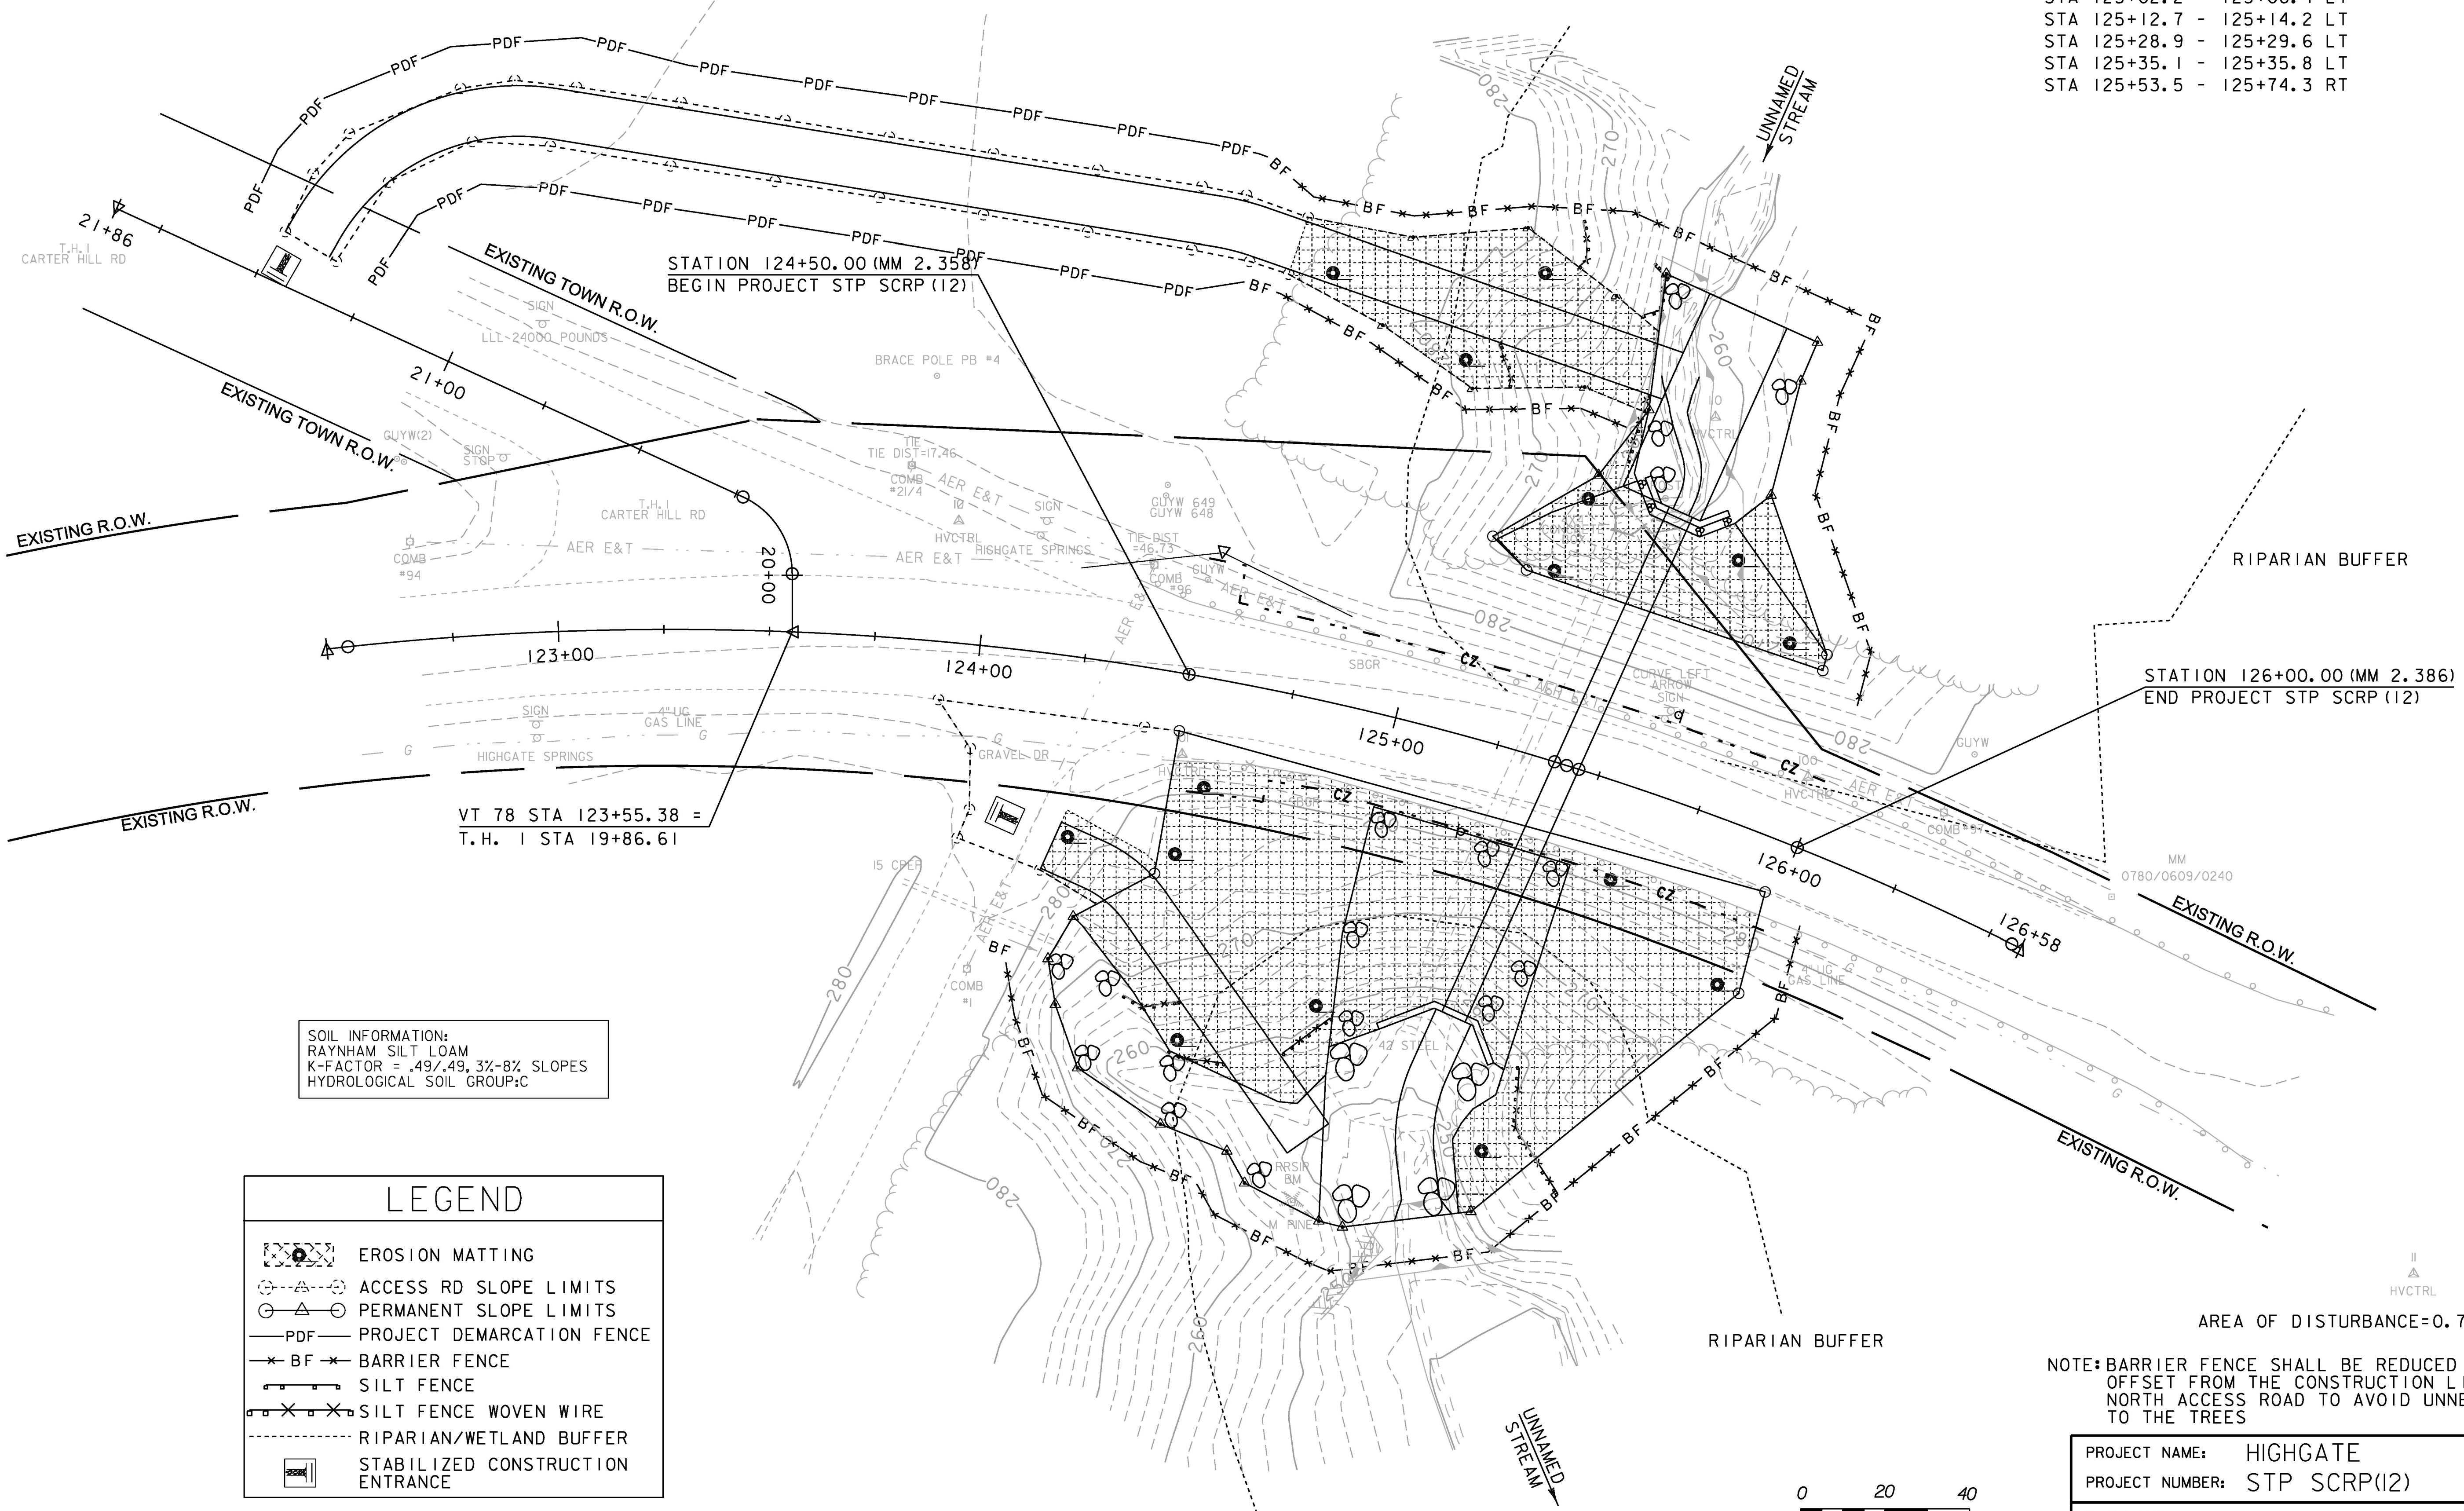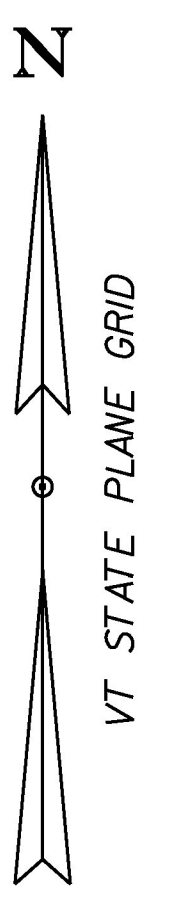

SOIL INFORMATION:  
 RAYNHAM SILT LOAM  
 K-FACTOR = .49/.49, 3%-8% SLOPES  
 HYDROLOGICAL SOIL GROUP:C


LEGEND	
	EROSION MATTING
	ACCESS RD SLOPE LIMITS
	PERMANENT SLOPE LIMITS
	PROJECT DEMARCATION FENCE
	BARRIER FENCE
	SILT FENCE
	SILT FENCE WOVEN WIRE
	RIPARIAN/WETLAND BUFFER
	STABILIZED CONSTRUCTION ENTRANCE

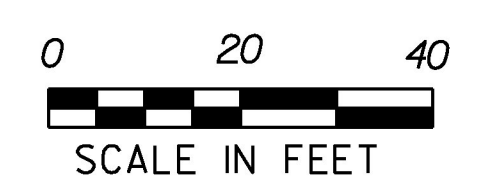


NOTE: BARRIER FENCE SHALL BE REDUCED TO A FIVE FOOT OFFSET FROM THE CONSTRUCTION LIMIT ON THE NORTH ACCESS ROAD TO AVOID UNNECESSARY IMPACTS TO THE TREES

PROJECT NAME: HIGHGATE	PLOT DATE: 14-OCT-2016
PROJECT NUMBER: STP SCRPI(2)	DRAWN BY: A. KEMPTON
FILE NAME: d13ci34ero.dgn	DESIGNED BY: A. KEMPTON
EPSC PLAN SHEET	CHECKED BY: M. GAMELIN
	SHEET 24 OF 40

AREA OF DISTURBANCE=0.782 ACRES

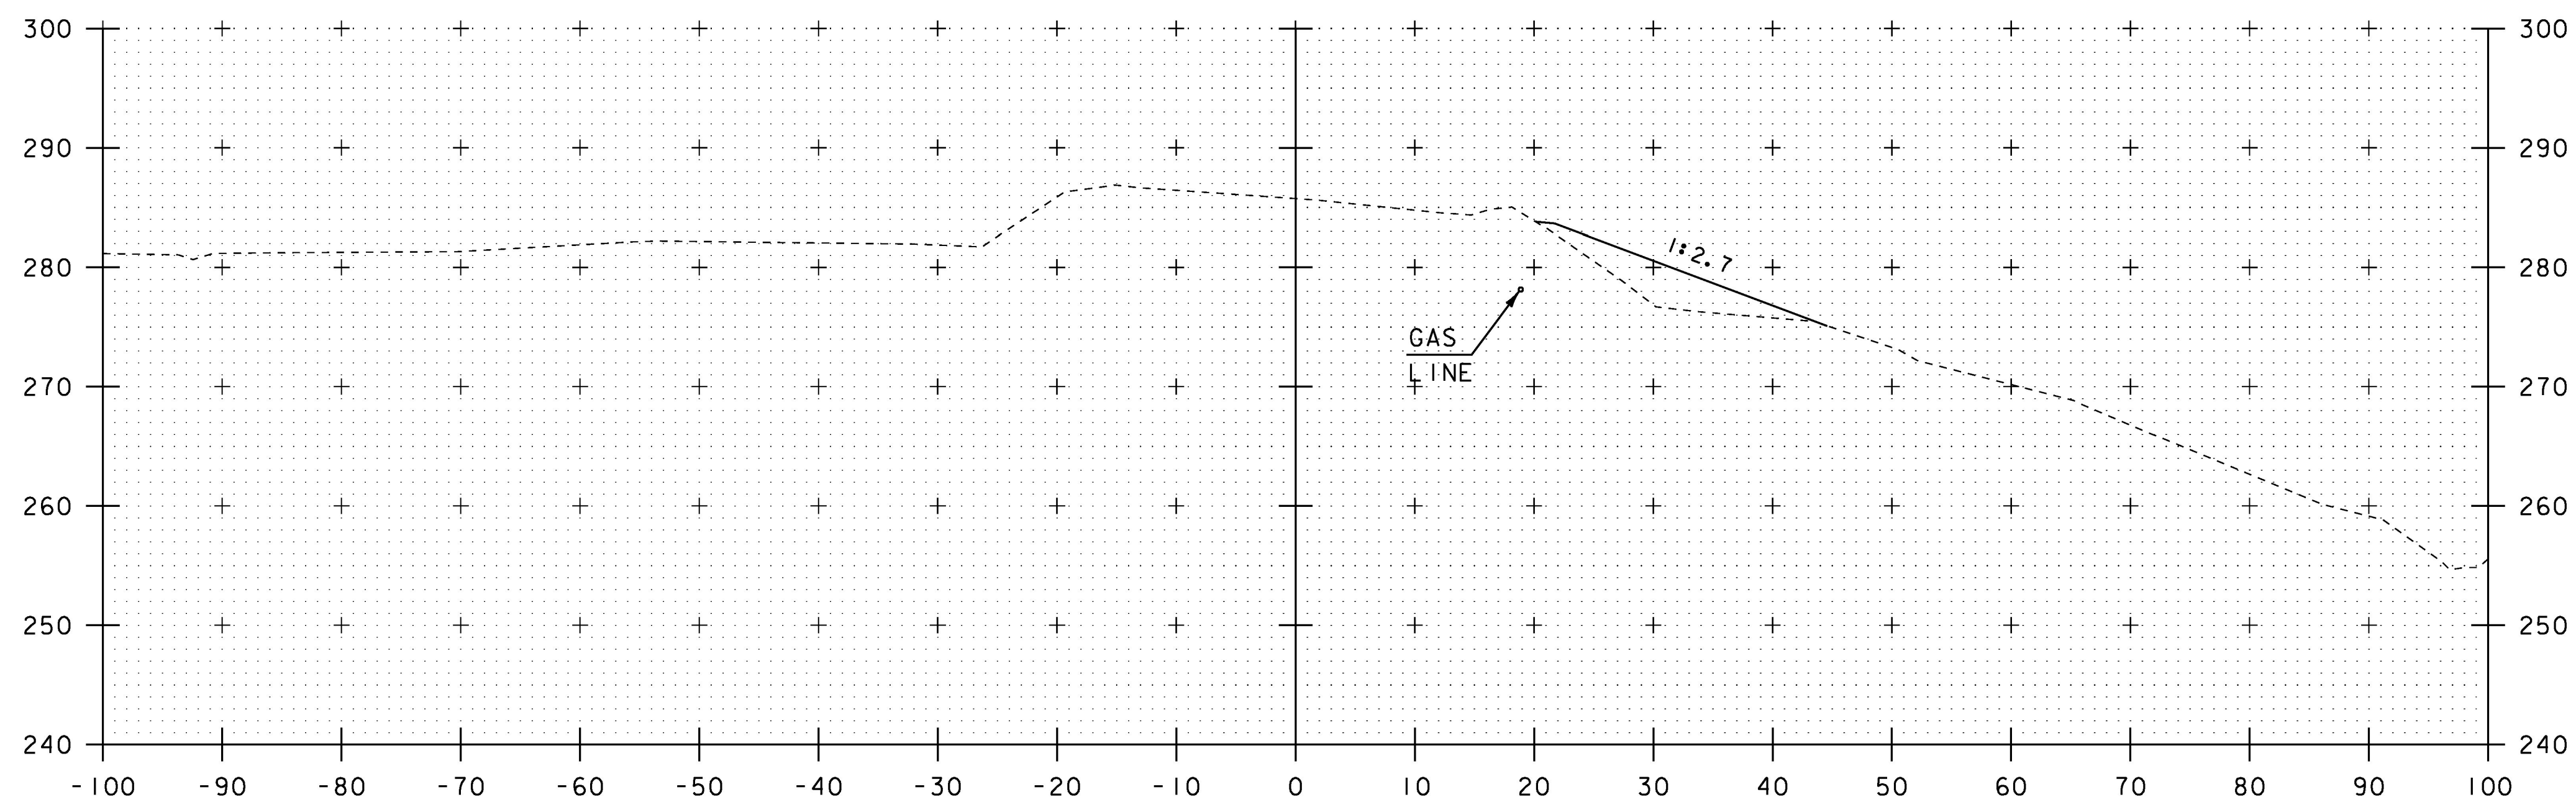

124+75

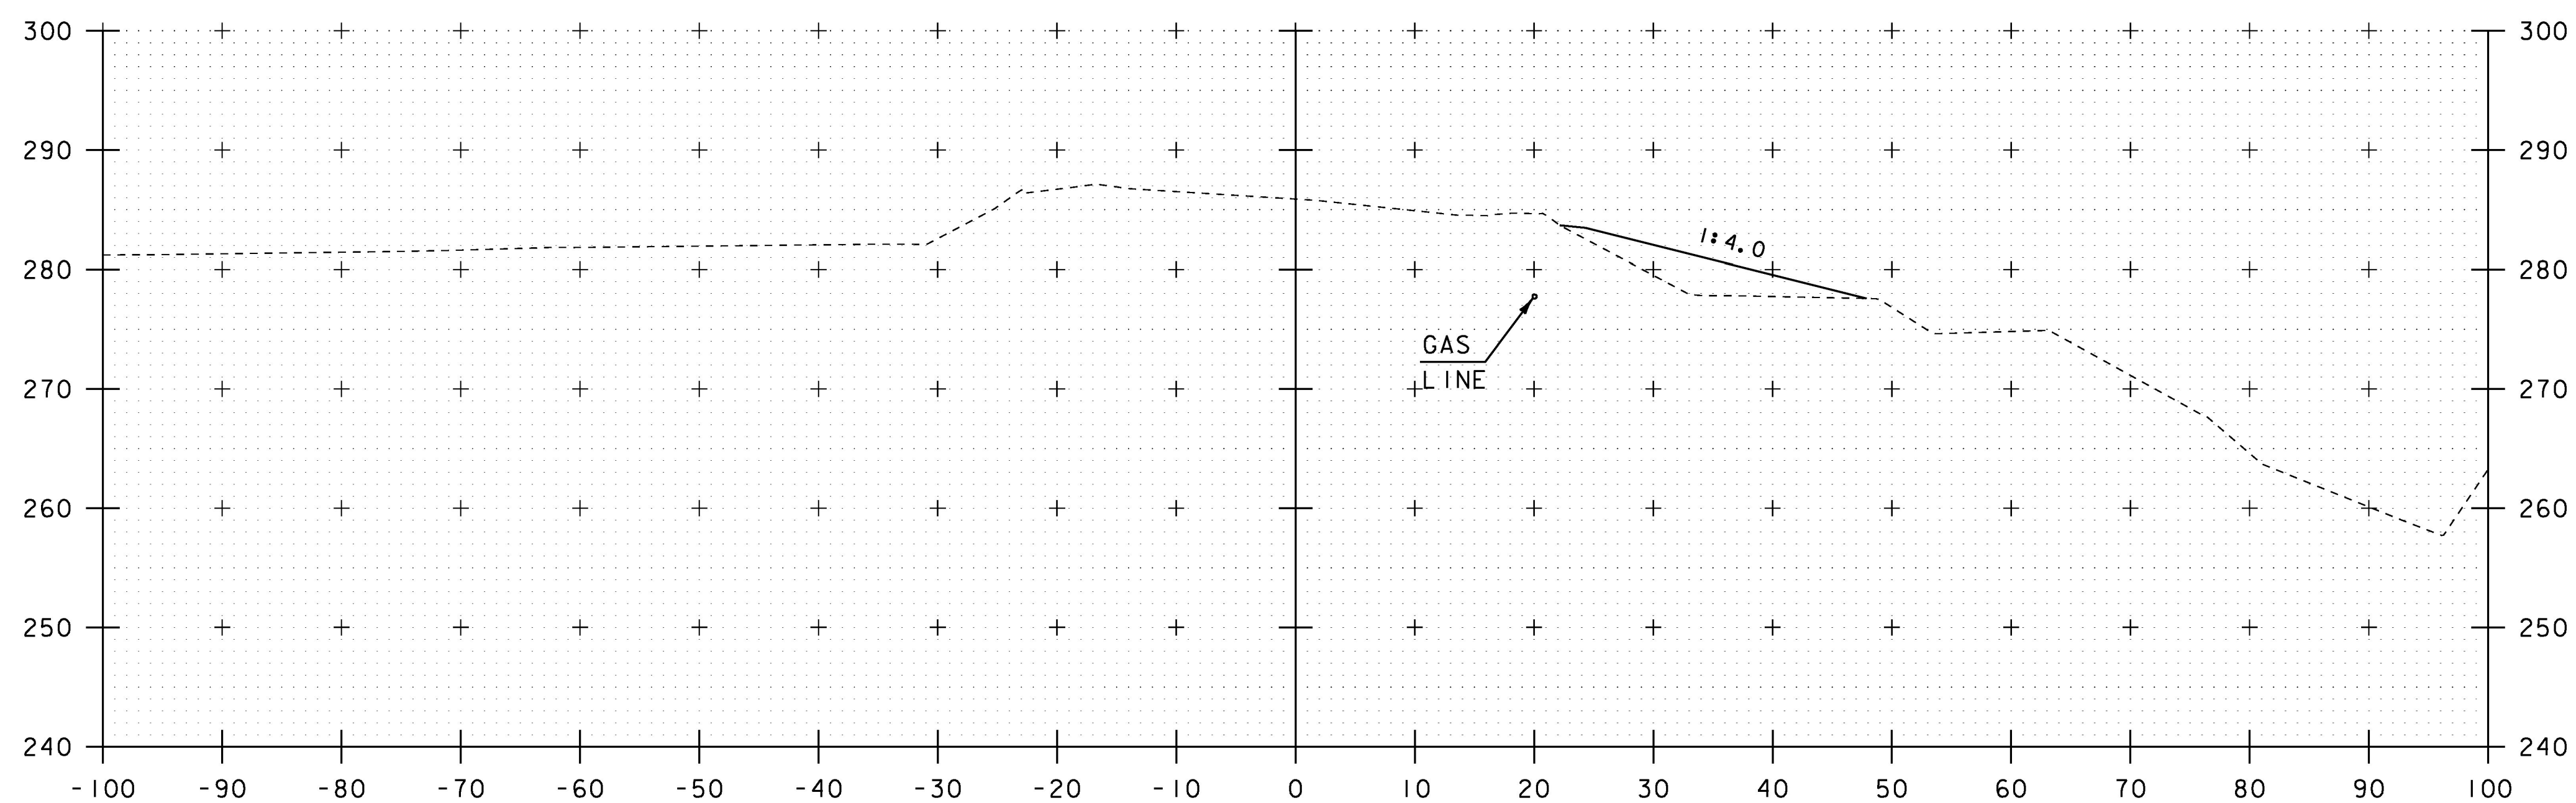


124+50  
BEGIN PROJECT


SCALE IN FEET

PROJECT NAME:	HIGHGATE	PLOT DATE:	14-OCT-2016
PROJECT NUMBER:	STP SCRPI(2)	DRAWN BY:	A. KEMPTON
FILE NAME:	d13ci34xs.dgn	CHECKED BY:	M. GAMELIN
PROJECT LEADER:	B. MARTIN	SHEET	25 OF 40
DESIGNED BY:	A. KEMPTON		
VT 78 CROSS SECTION SHEET I			

STA. 124+50 TO STA. 124+75

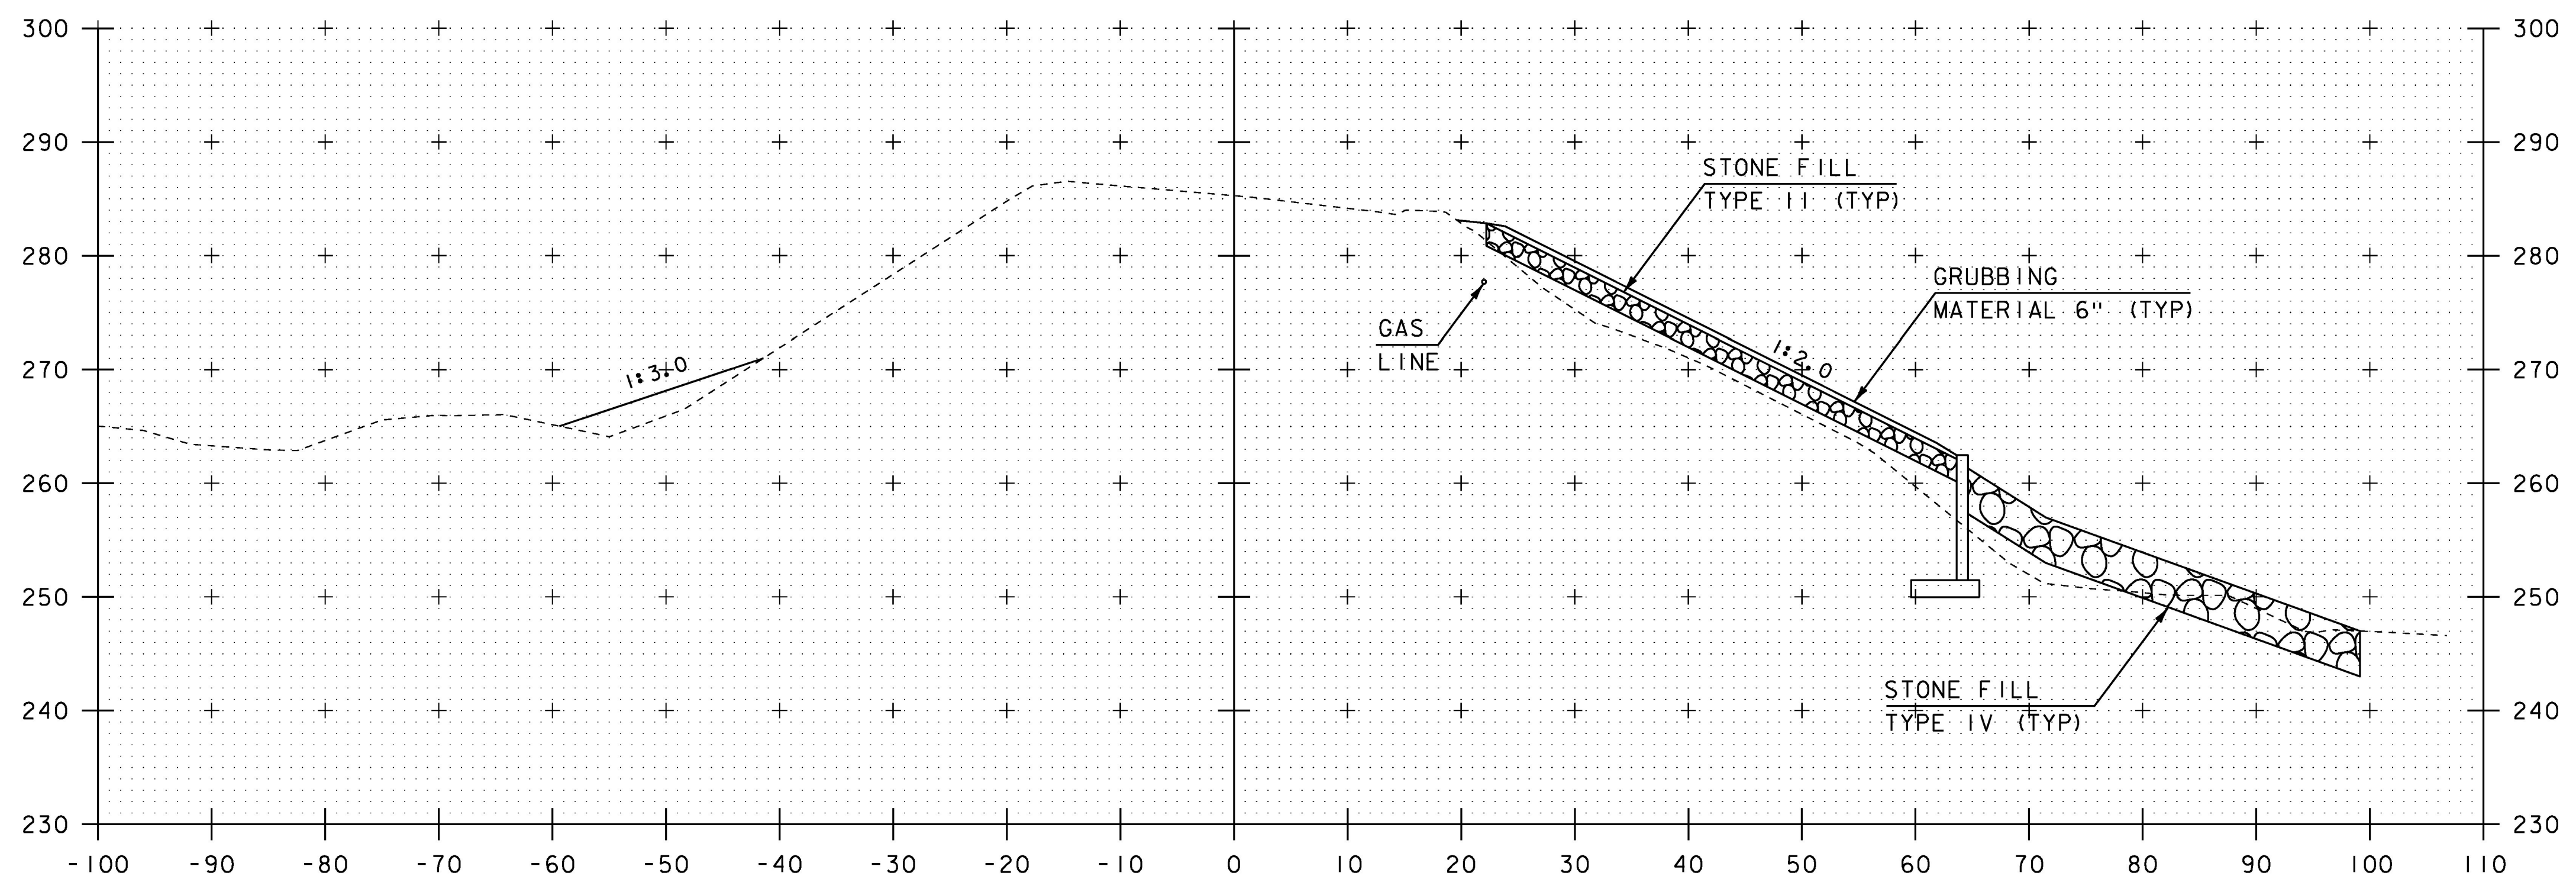

125+25

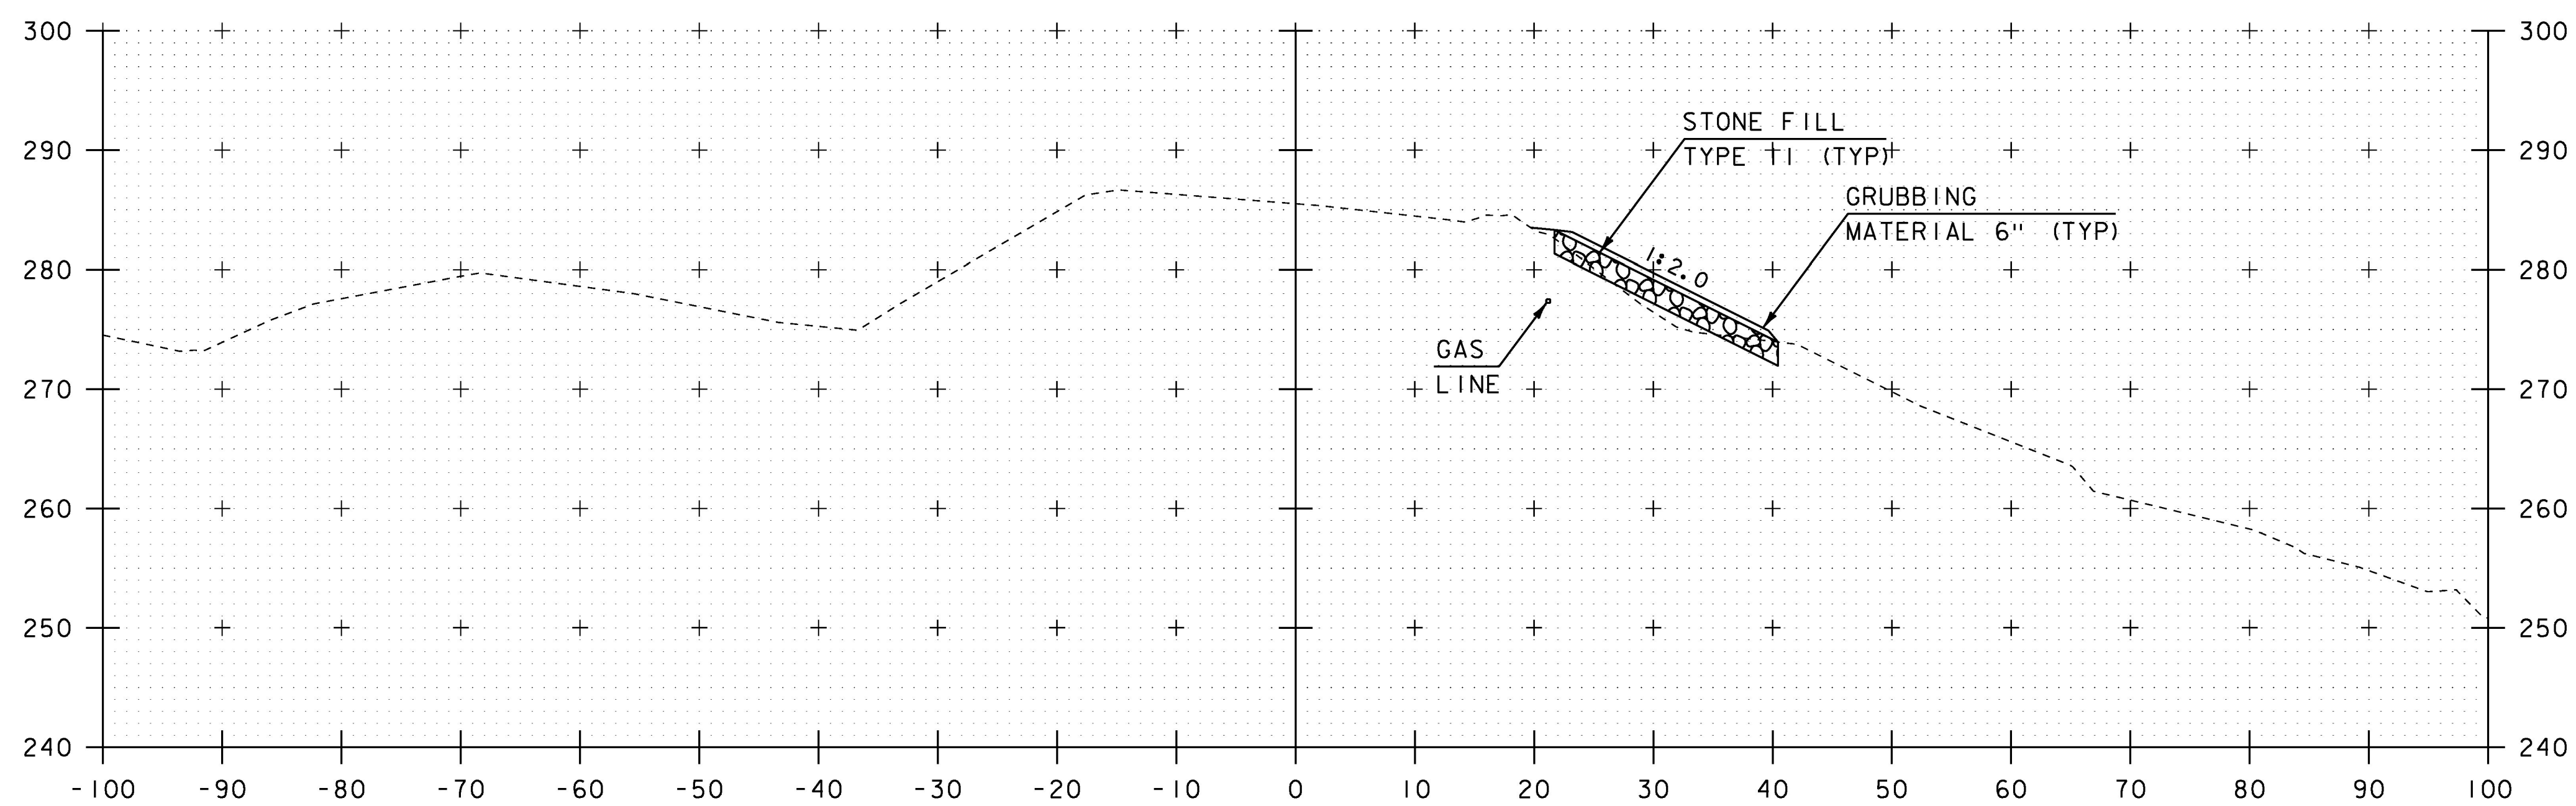

125+00


SCALE IN FEET

PROJECT NAME: HIGHGATE  
PROJECT NUMBER: STP SCRP(12)


FILE NAME: d13cl34xs.dgn  
PROJECT LEADER: B. MARTIN  
DESIGNED BY: A. KEMPTON  
VT 78 CROSS SECTION SHEET 2

PLOT DATE: 14-OCT-2016  
DRAWN BY: A. KEMPTON  
CHECKED BY: M. GAMELIN  
SHEET 26 OF 40

STA. 125+00 TO STA. 125+25

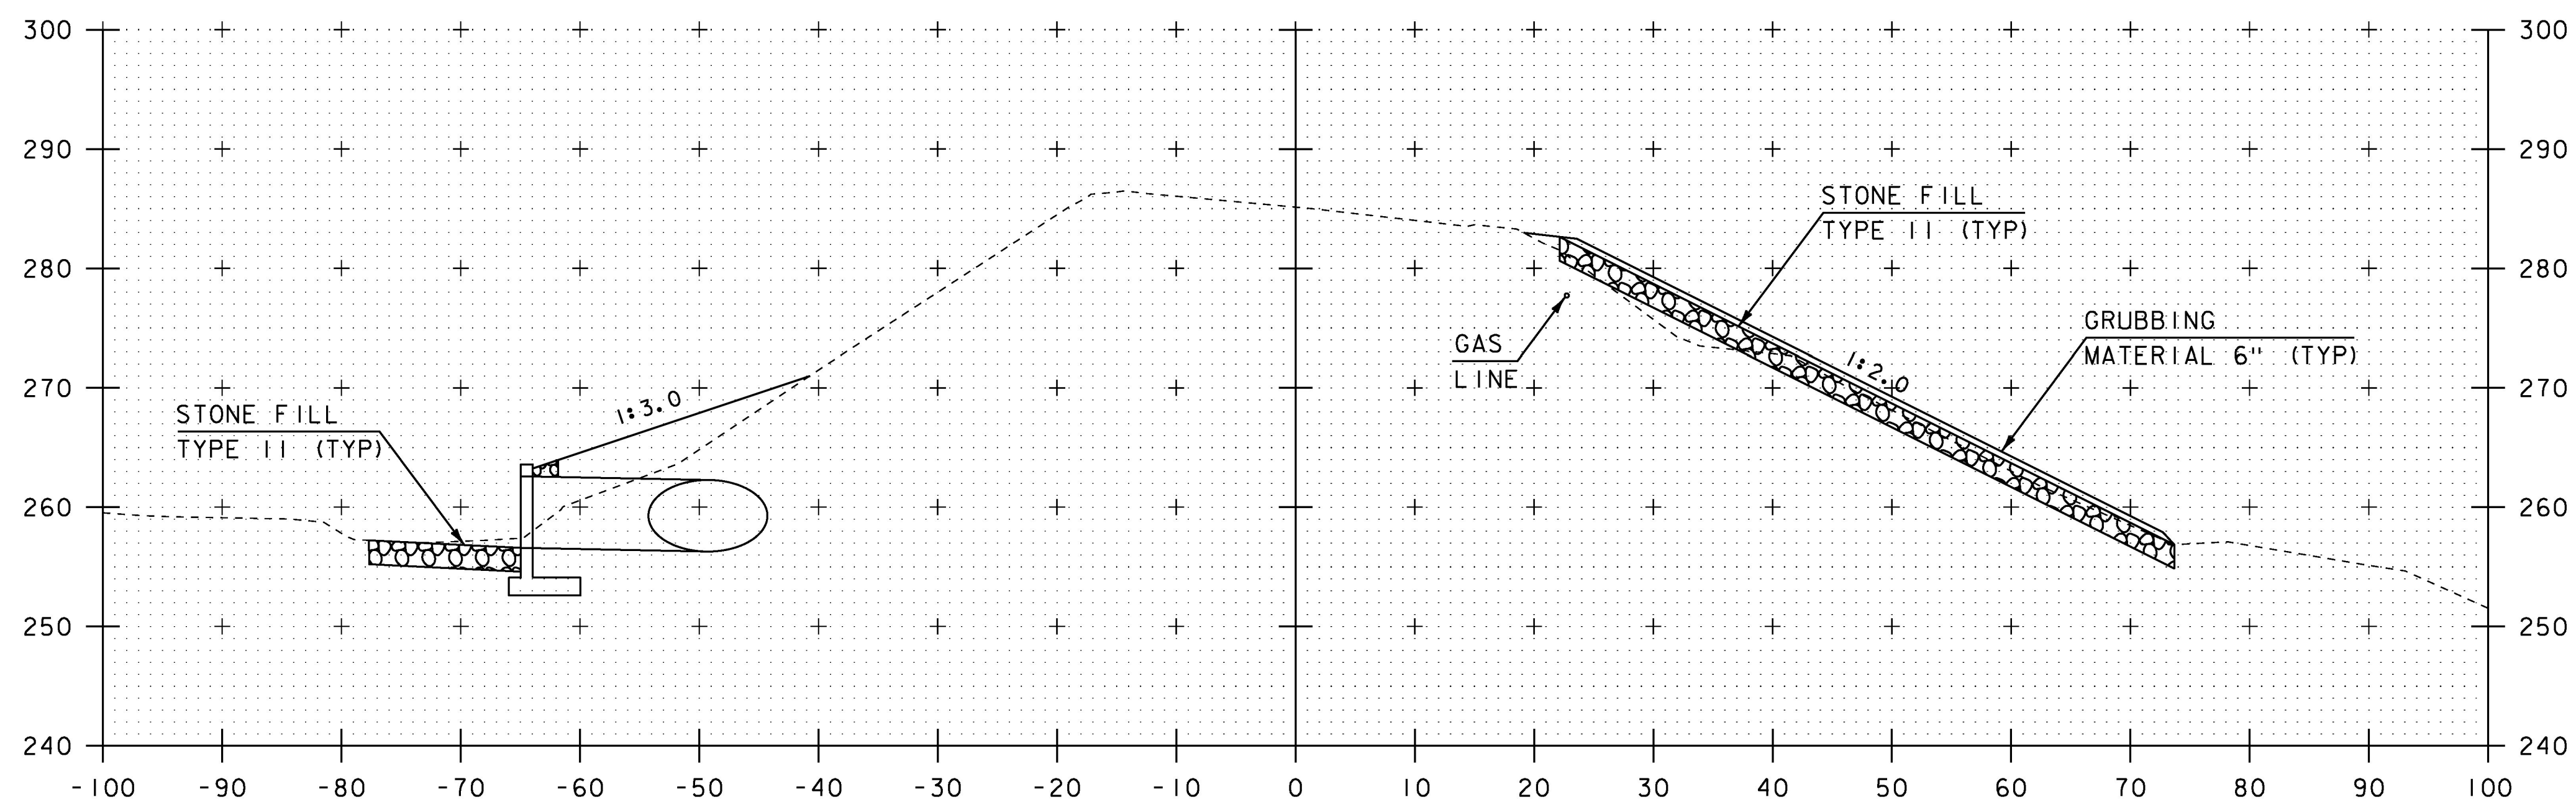

125+50

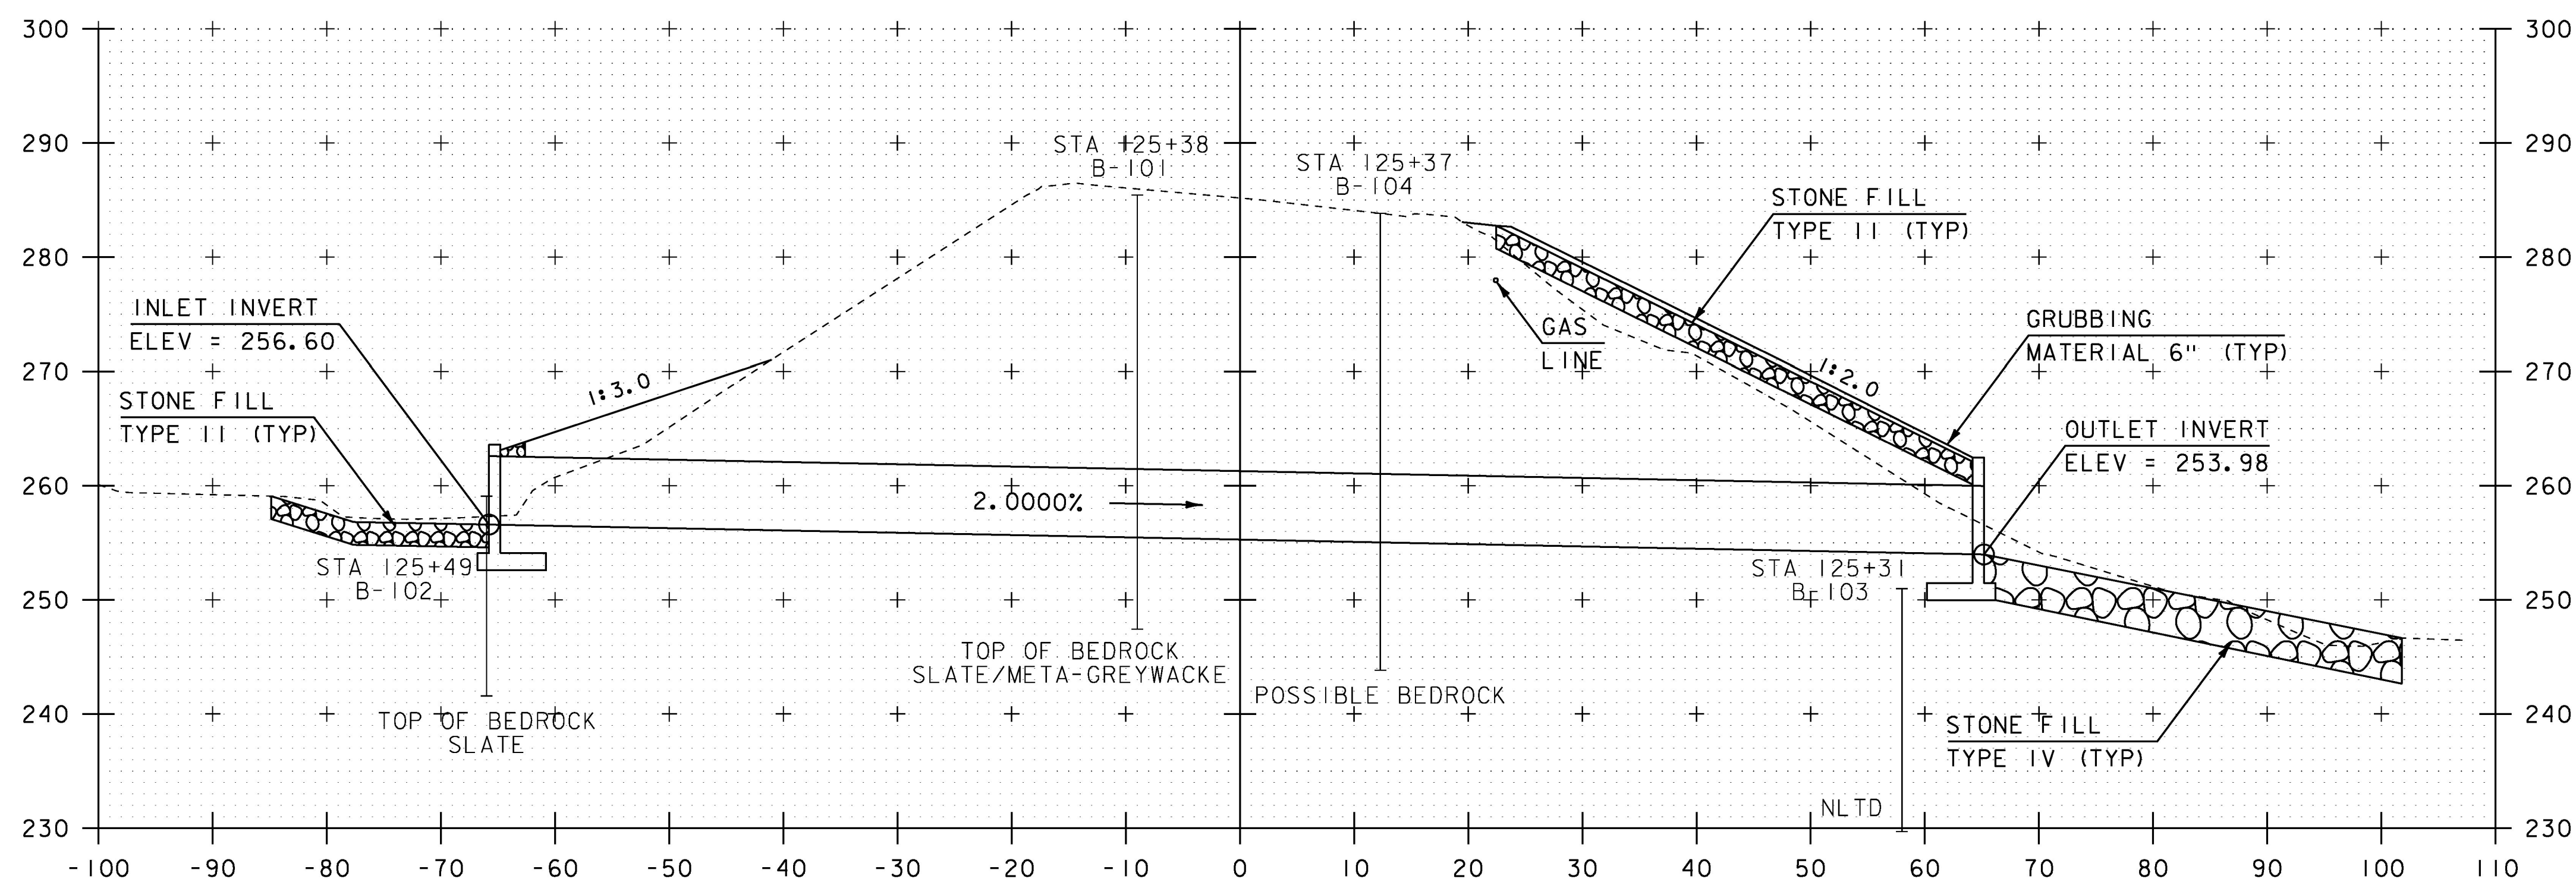


- NOTES:
- BORING LOCATIONS HAVE BEEN PROJECTED ON TO THE CROSS SECTION FROM THE STATION INDICATED ON THE BORING LOGS.
  - BORING LOCATIONS AND STRATA ELEVATIONS ARE APPROXIMATE.

125+42.00  
 SKEWED 83°00'00" LT  
 (BR 10)


SCALE IN FEET

STA. 125+42 TO STA. 125+50

PROJECT NAME:	HIGHGATE
PROJECT NUMBER:	STP SCRPI(2)
FILE NAME:	d13ci34xs.dgn
PROJECT LEADER:	B. MARTIN
DESIGNED BY:	A. KEMPTON
VT 78 CROSS SECTION SHEET 3	
PLOT DATE:	14-OCT-2016
DRAWN BY:	A. KEMPTON
CHECKED BY:	M. GAMELIN
SHEET	27 OF 40

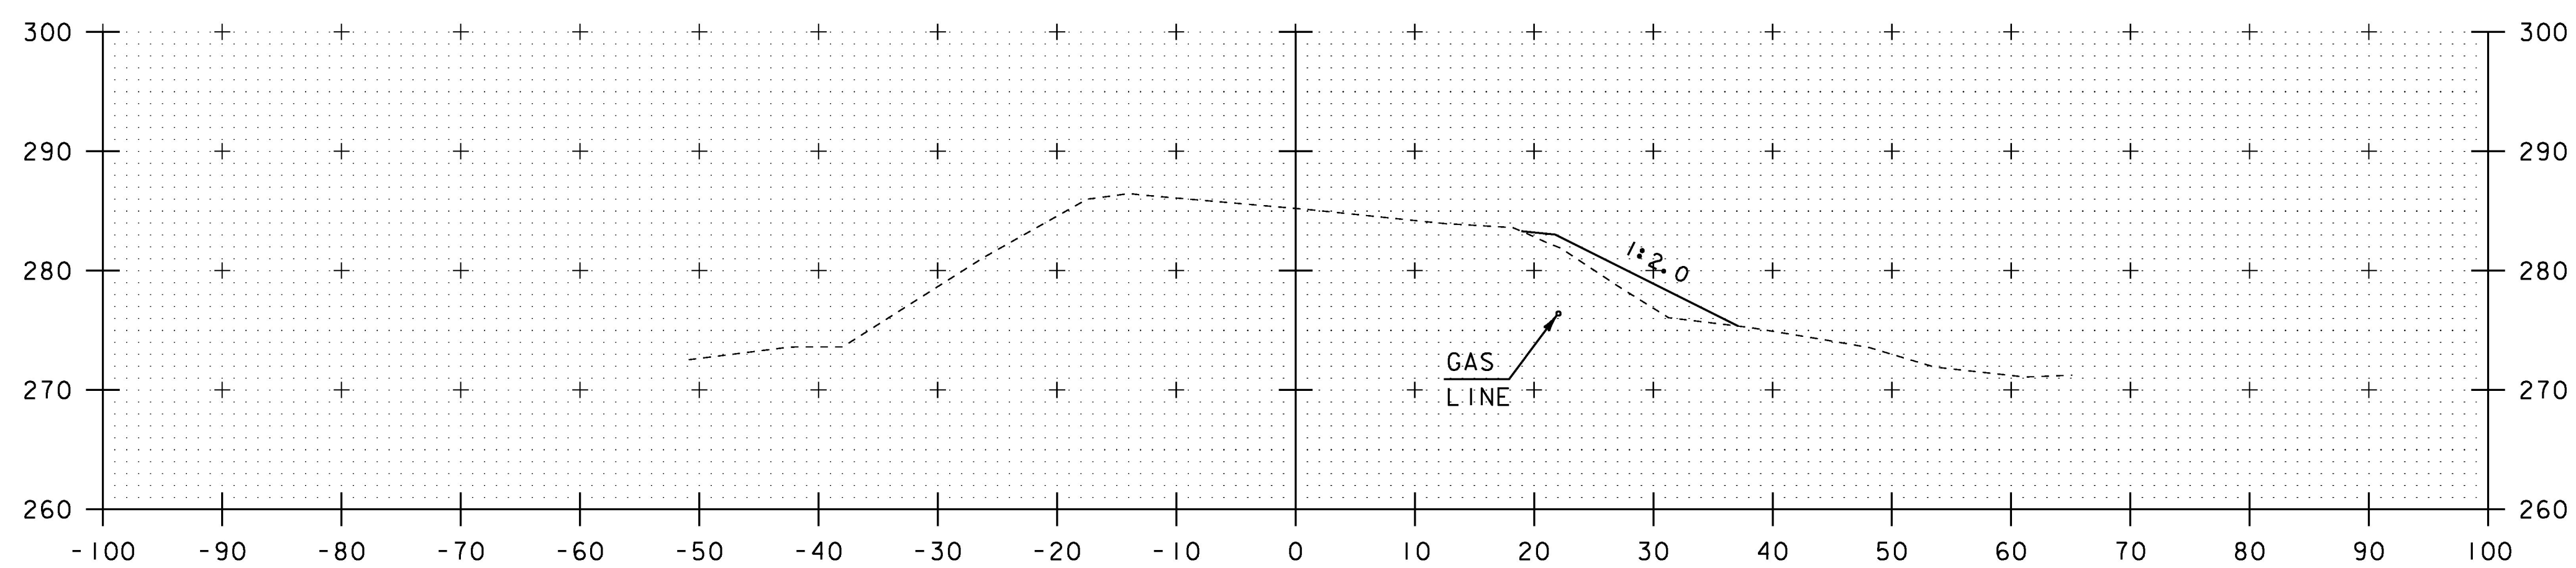

126+00  
END PROJECT

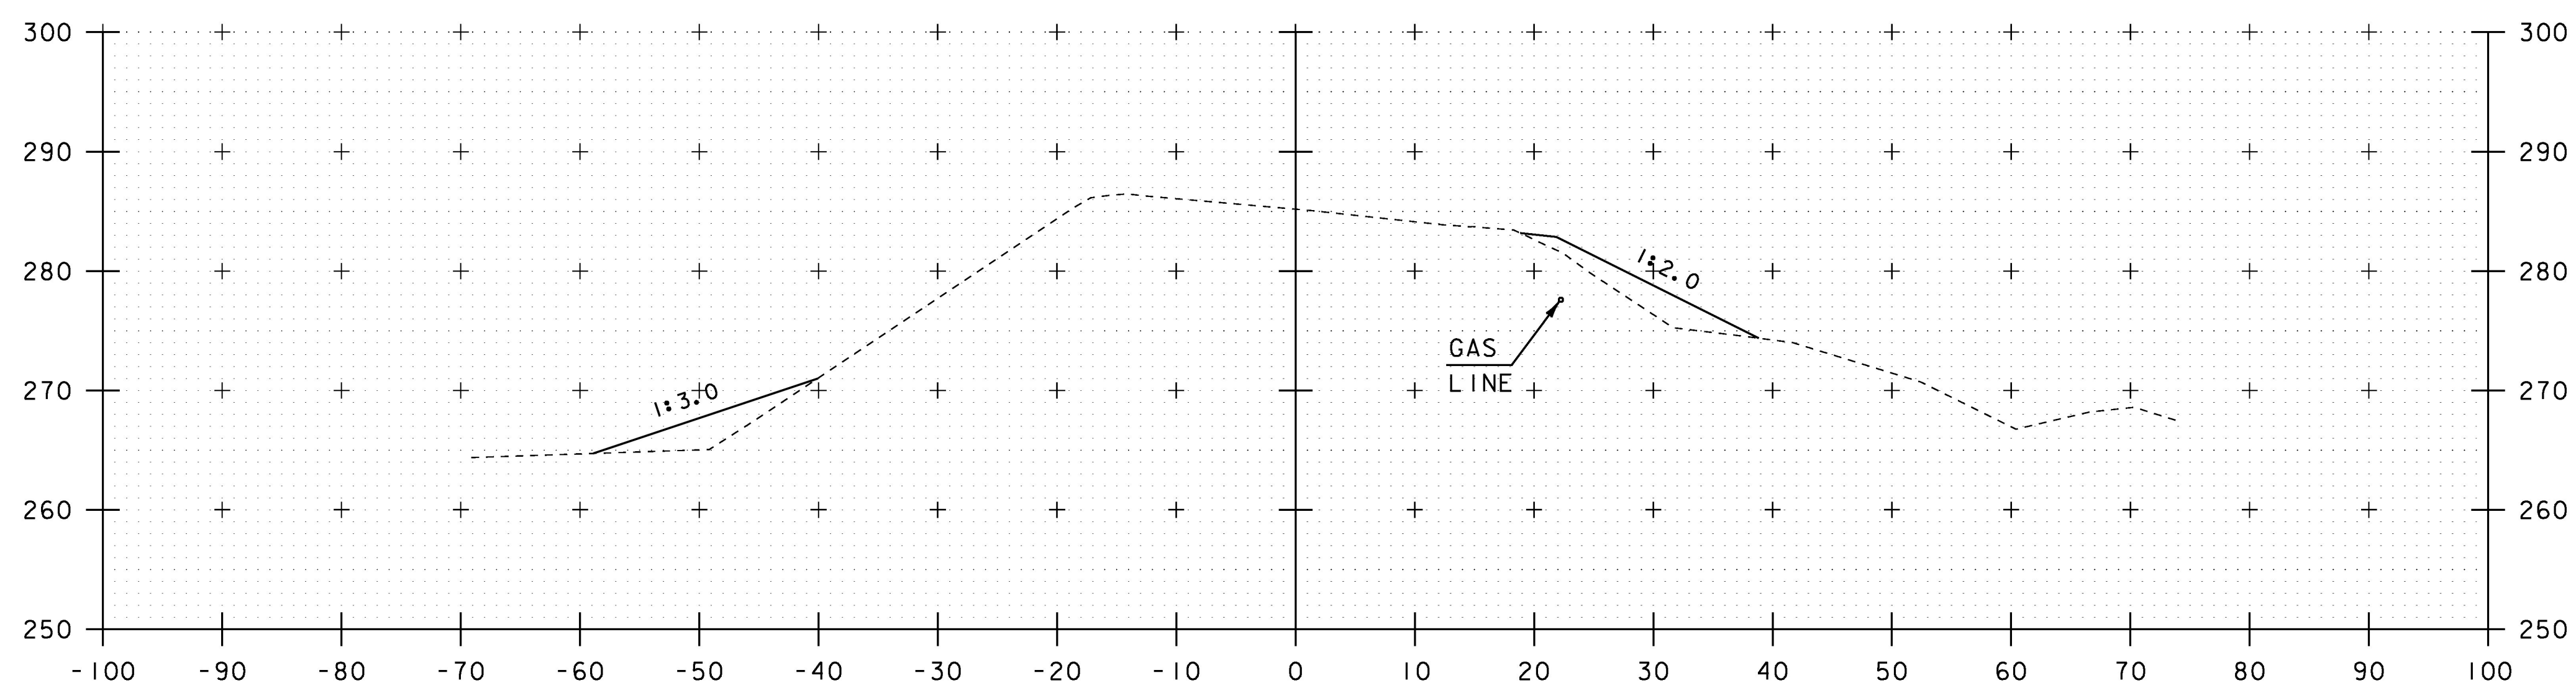


125+75


SCALE IN FEET

STA. 125+75 TO STA. 126+00


PROJECT NAME:	HIGHGATE	PLOT DATE:	14-OCT-2016
PROJECT NUMBER:	STP_SCRP(12)	DRAWN BY:	A. KEMPTON
FILE NAME:	d13cl34xs.dgn	CHECKED BY:	M. GAMELIN
PROJECT LEADER:	B. MARTIN		
DESIGNED BY:	A. KEMPTON		
VT 78 CROSS SECTION SHEET 4		SHEET	28 OF 40

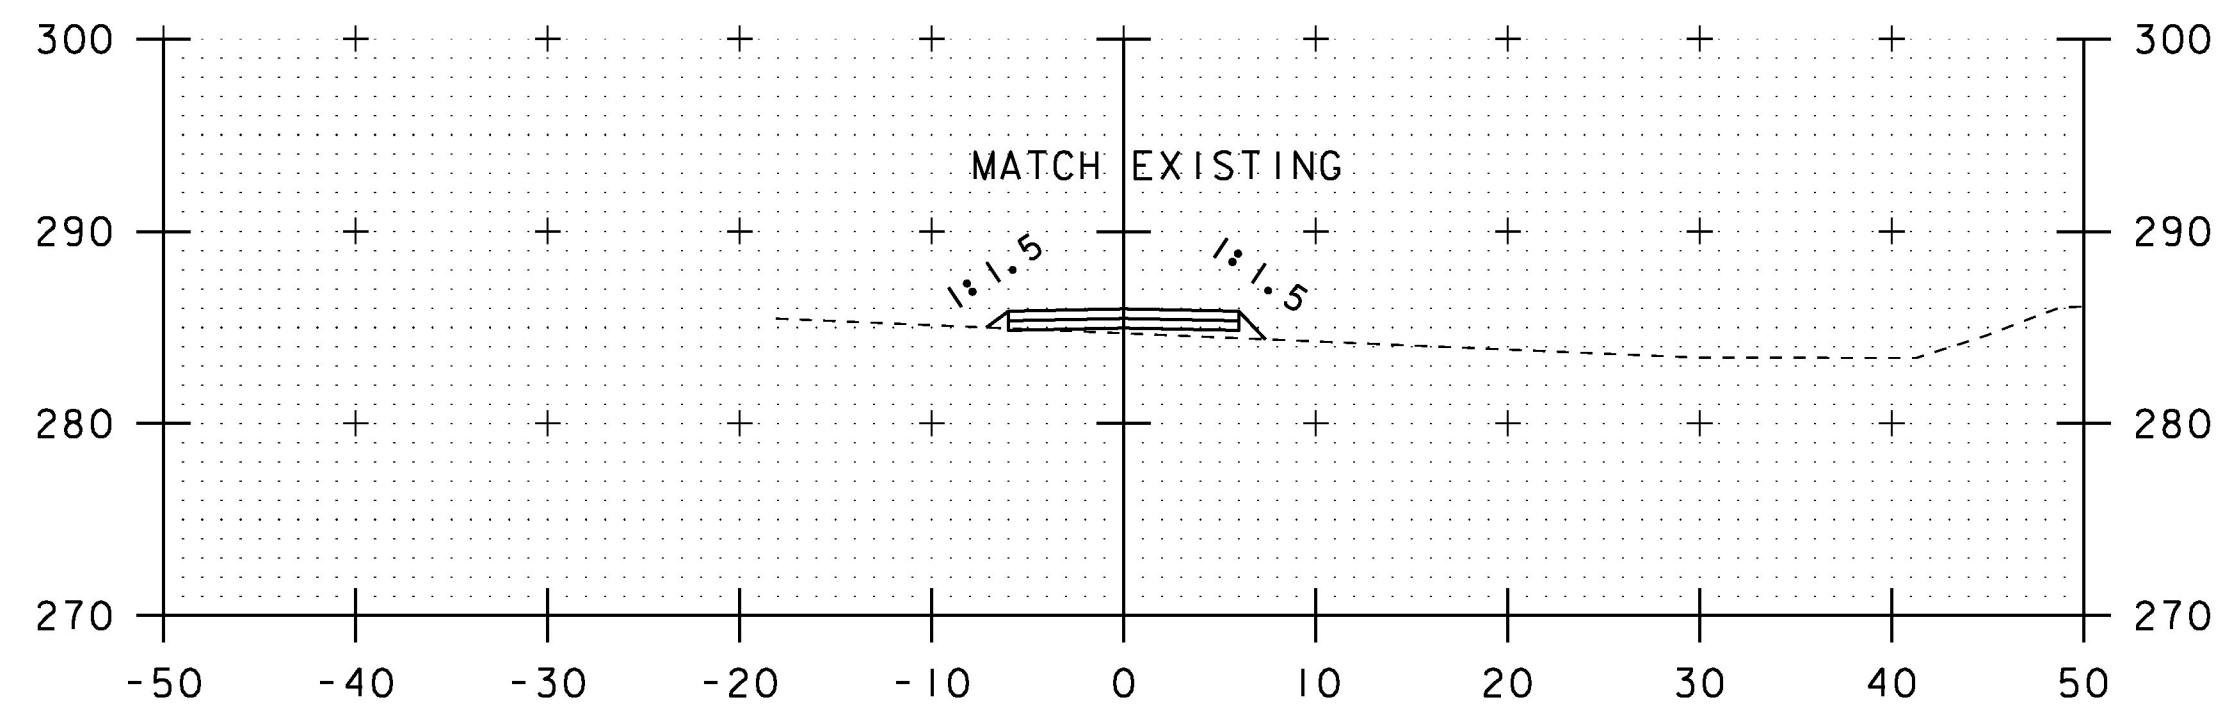


0+50

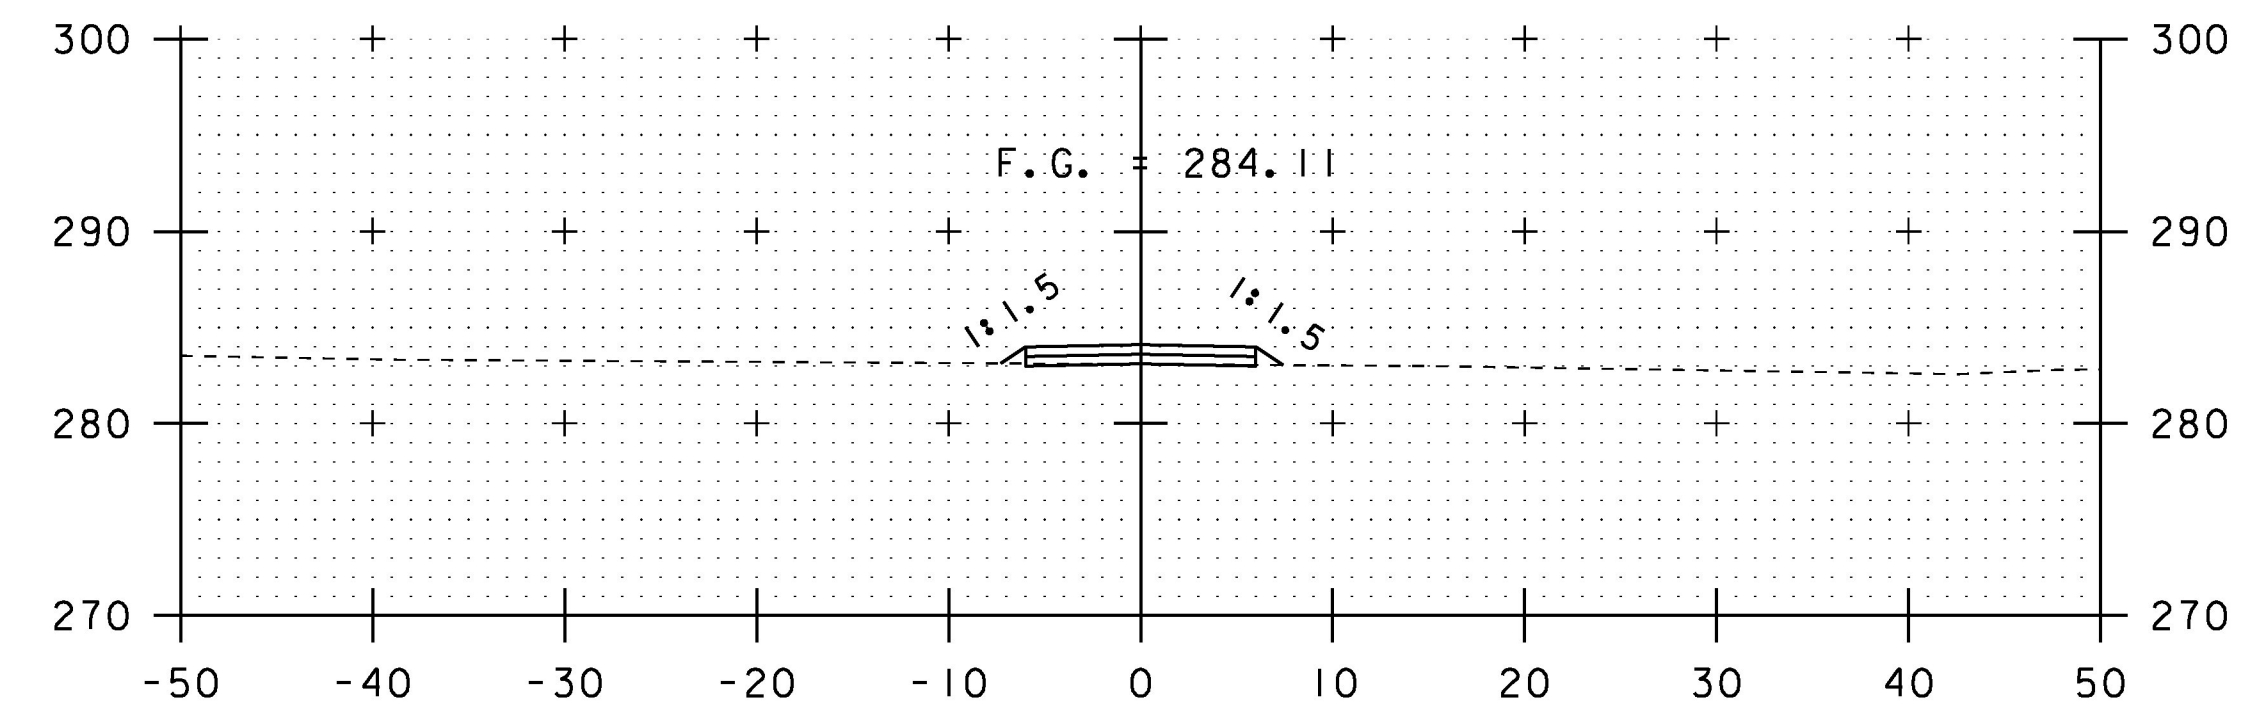


1+25

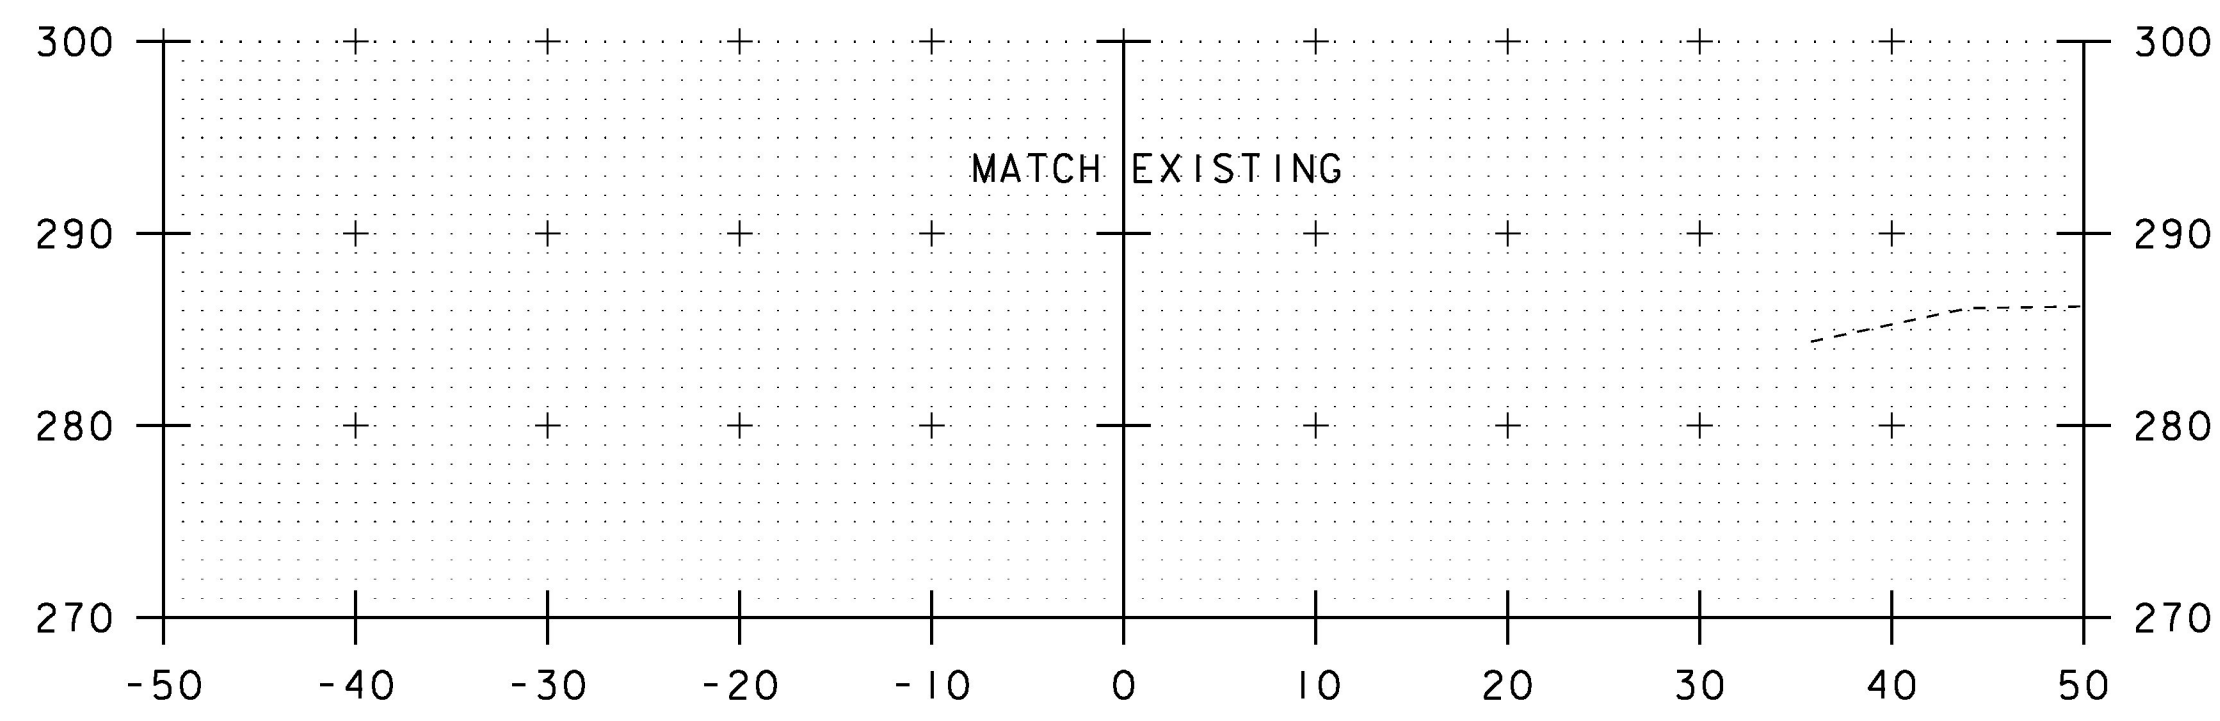


0+25

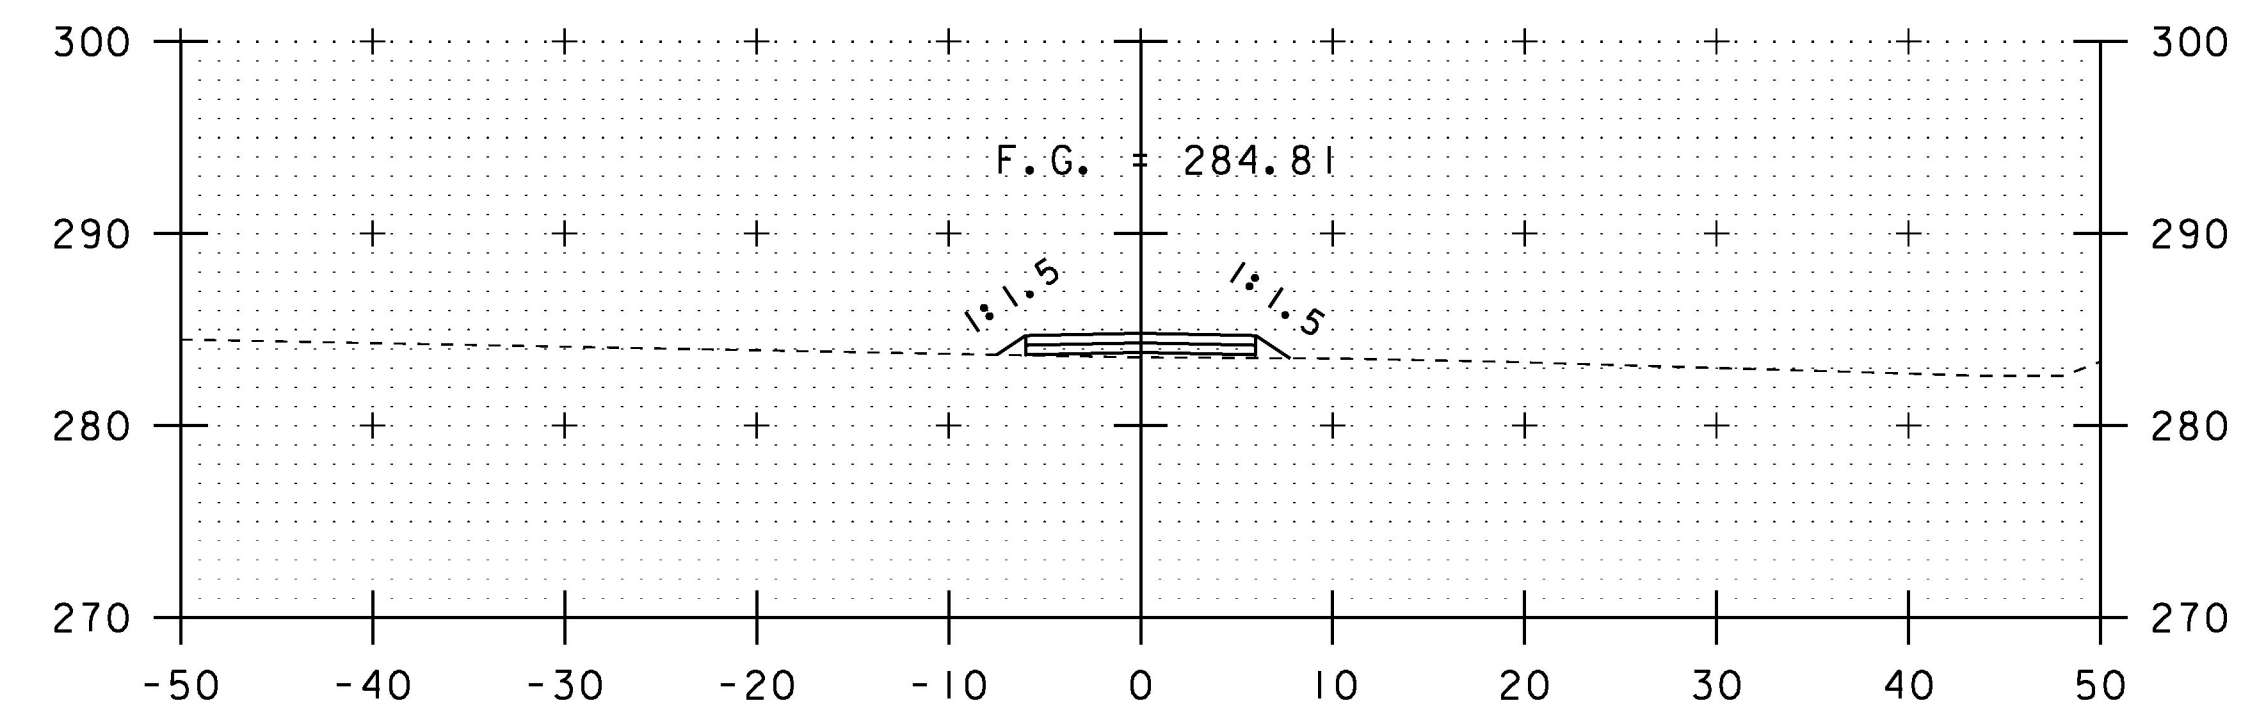

1+00

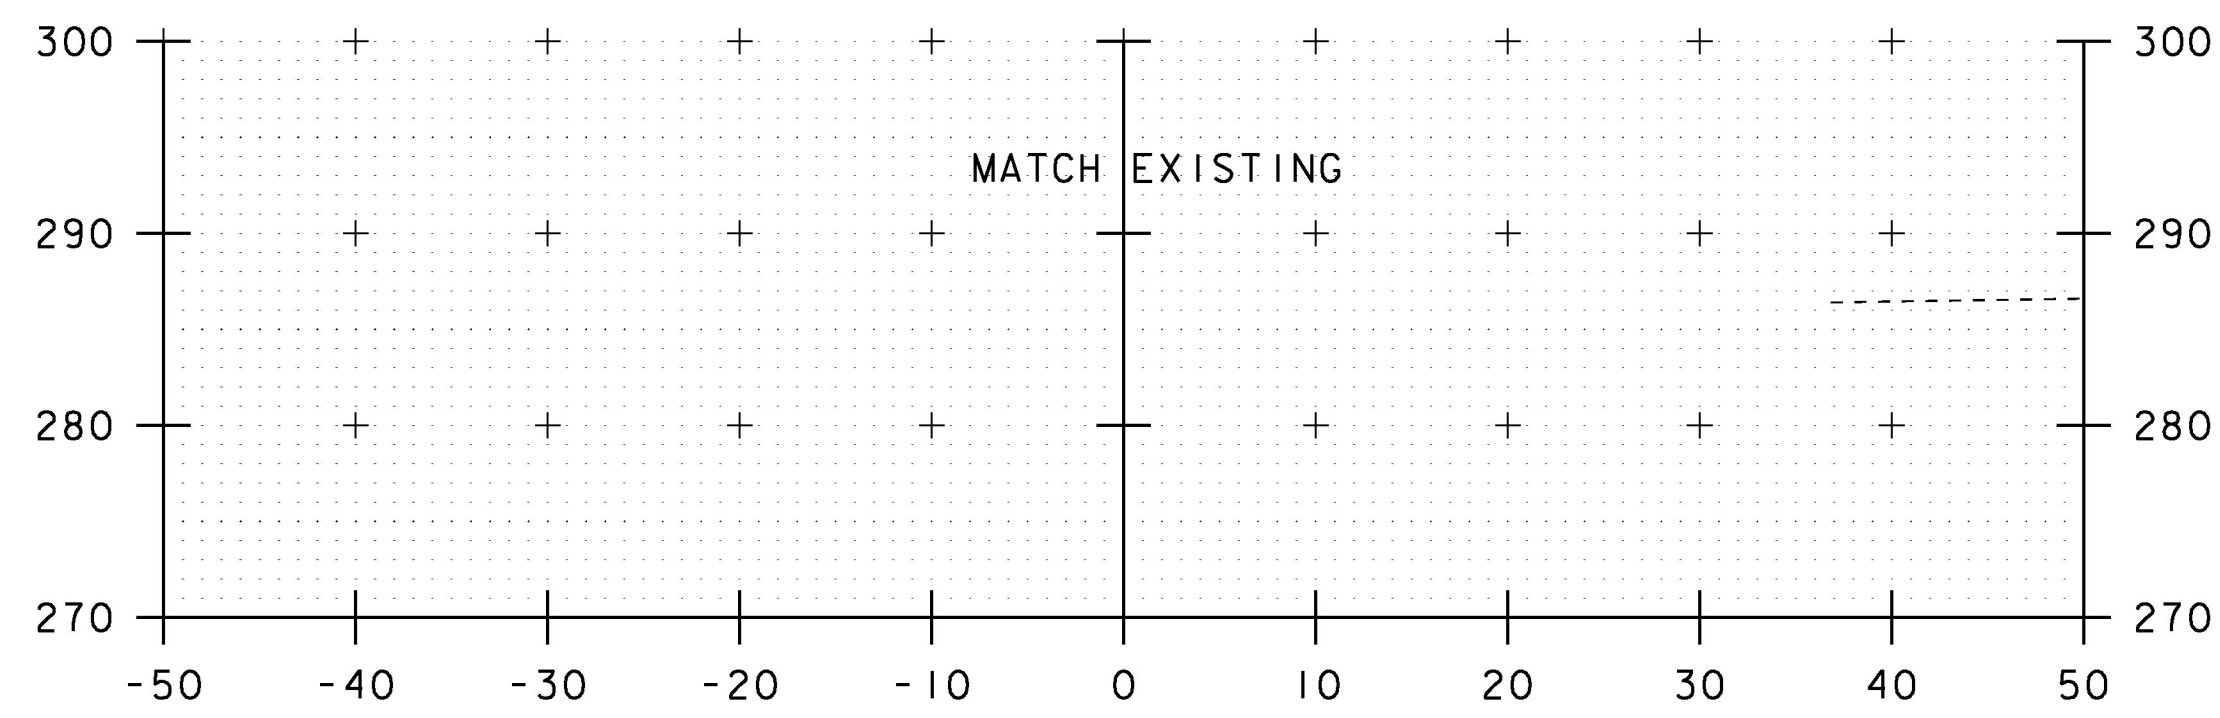

0+00  
BEGIN ACCESS ROAD

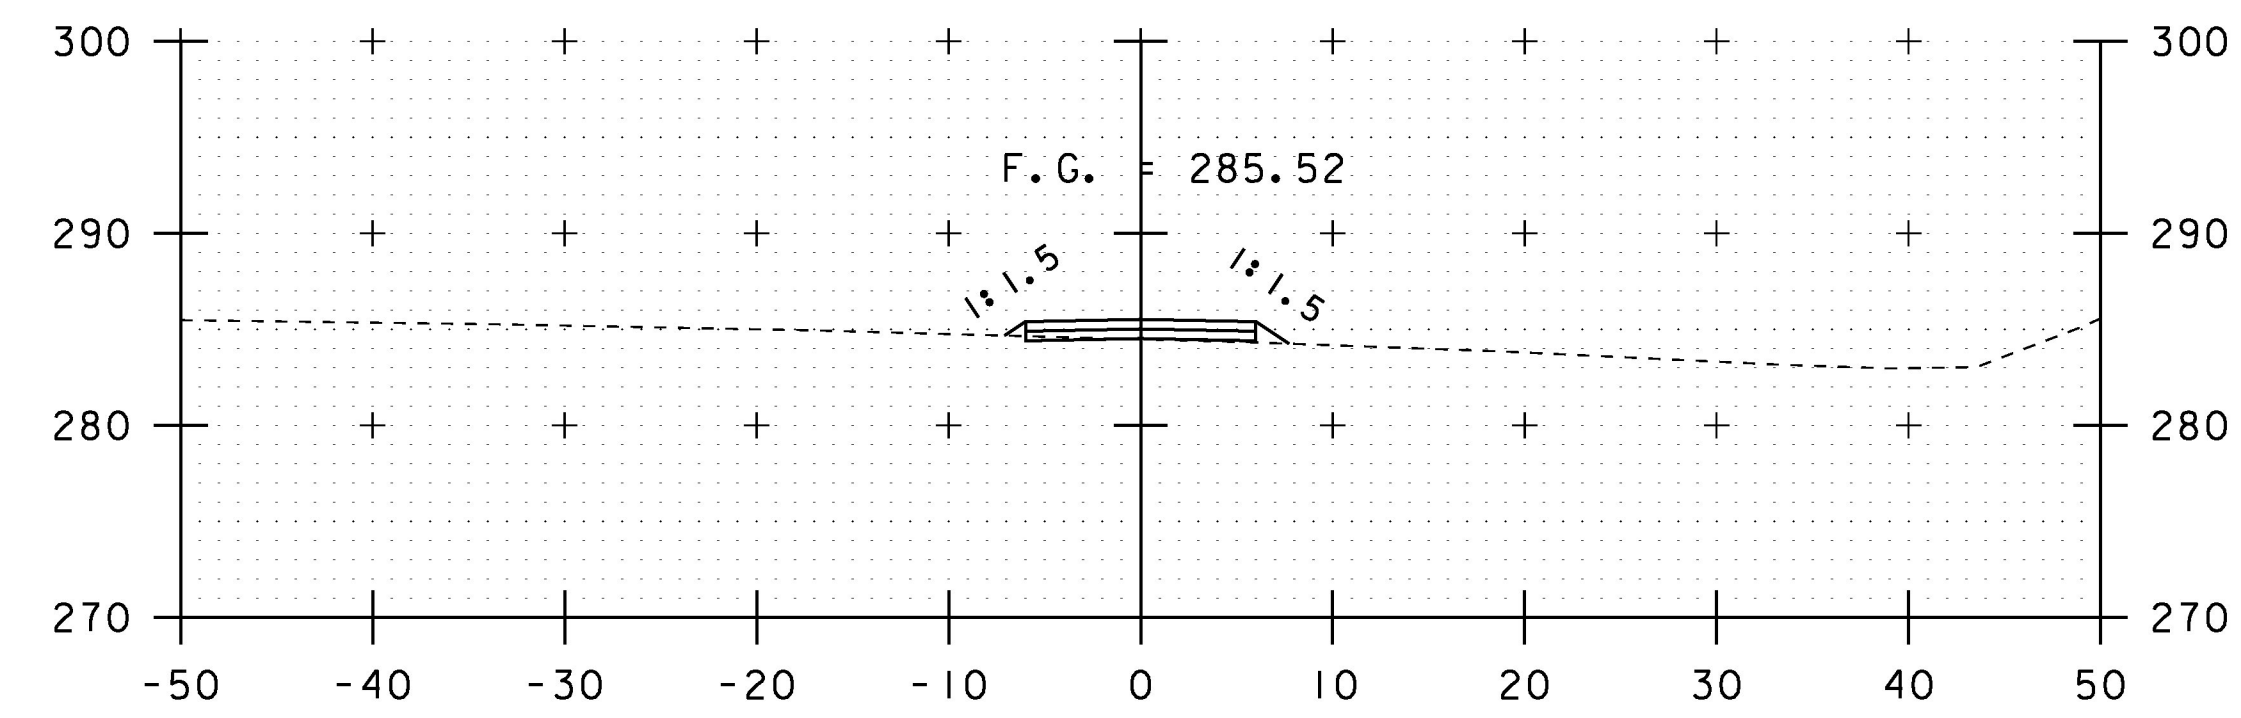


0+75


SCALE IN FEET

PROJECT NAME:	HIGHGATE
PROJECT NUMBER:	STP SCRPI(2)
FILE NAME:	d13ci34xs.dgn
PROJECT LEADER:	B. MARTIN
DESIGNED BY:	A. KEMPTON
NORTH ACCESS RD CROSS SECTION SHEET 1	SHEET 29 OF 40
PLOT DATE:	14-OCT-2016
DRAWN BY:	A. KEMPTON
CHECKED BY:	M. GAMELIN


STA. 0+00 TO STA. 1+25

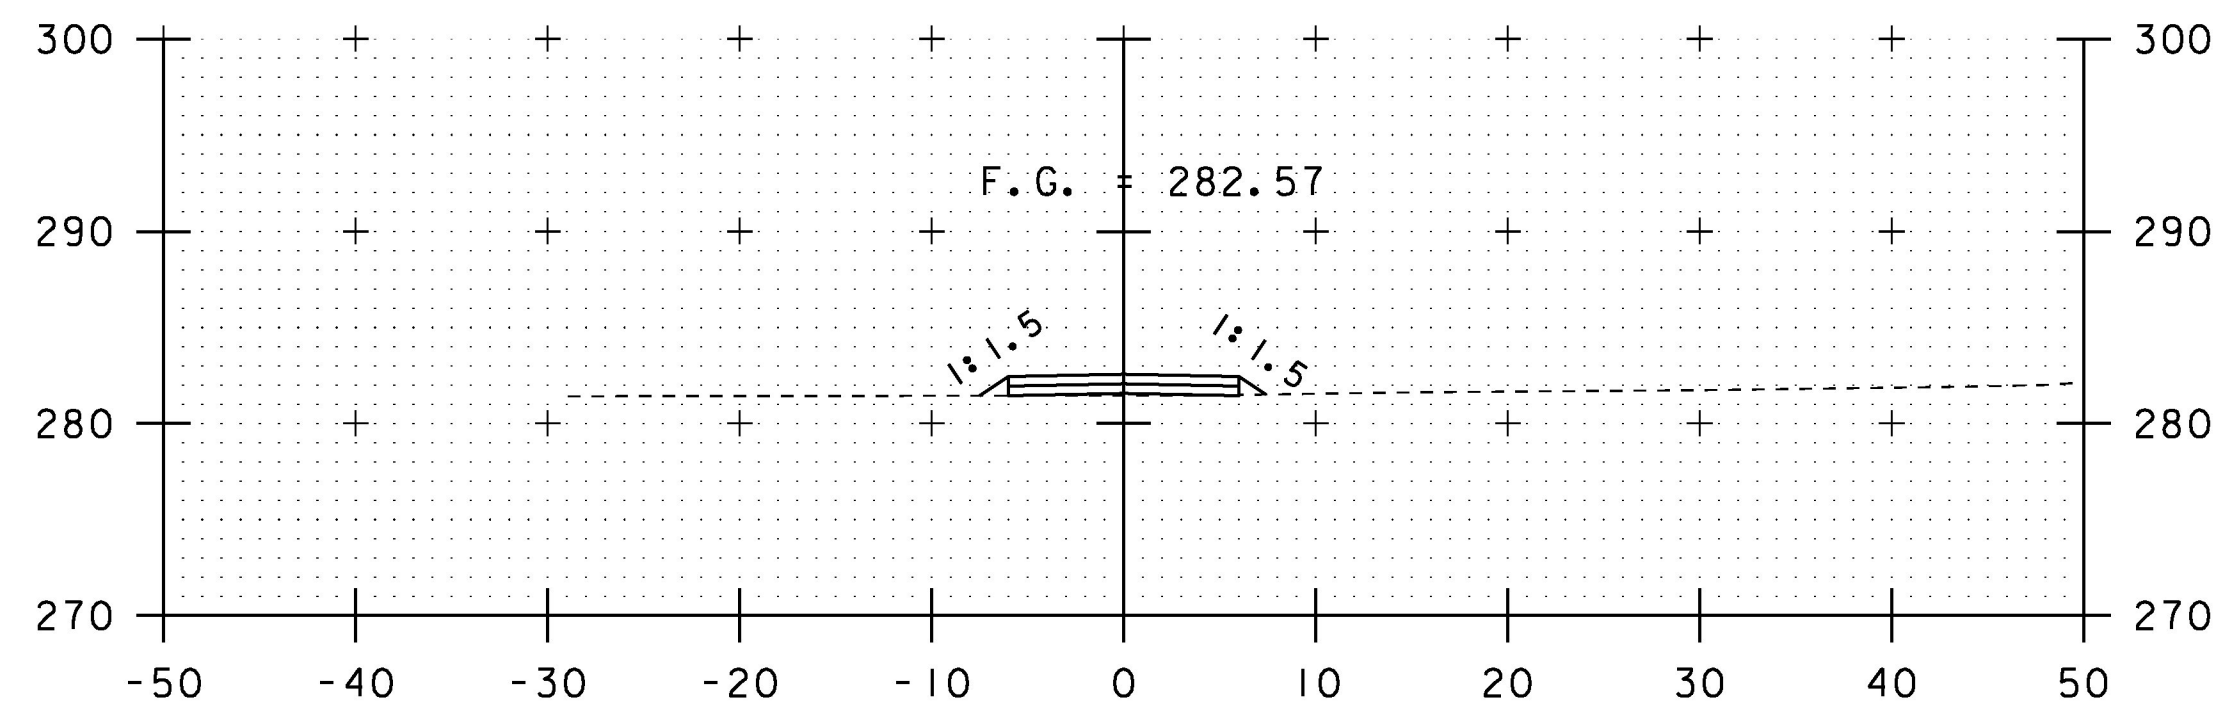


2+00

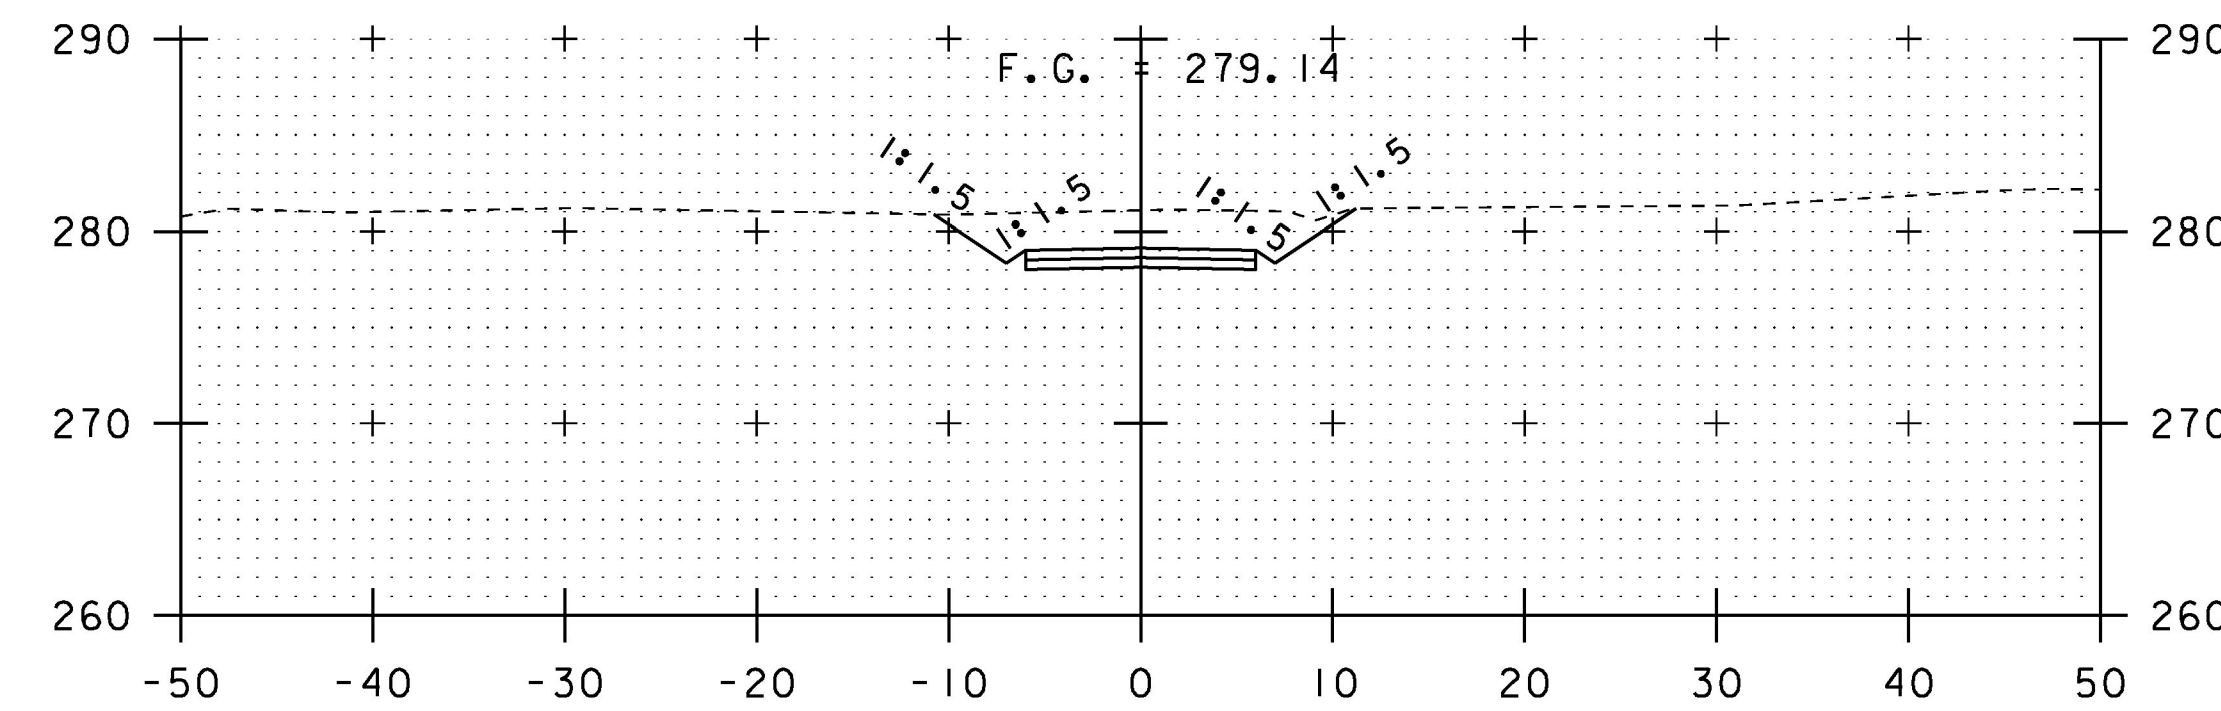


2+75

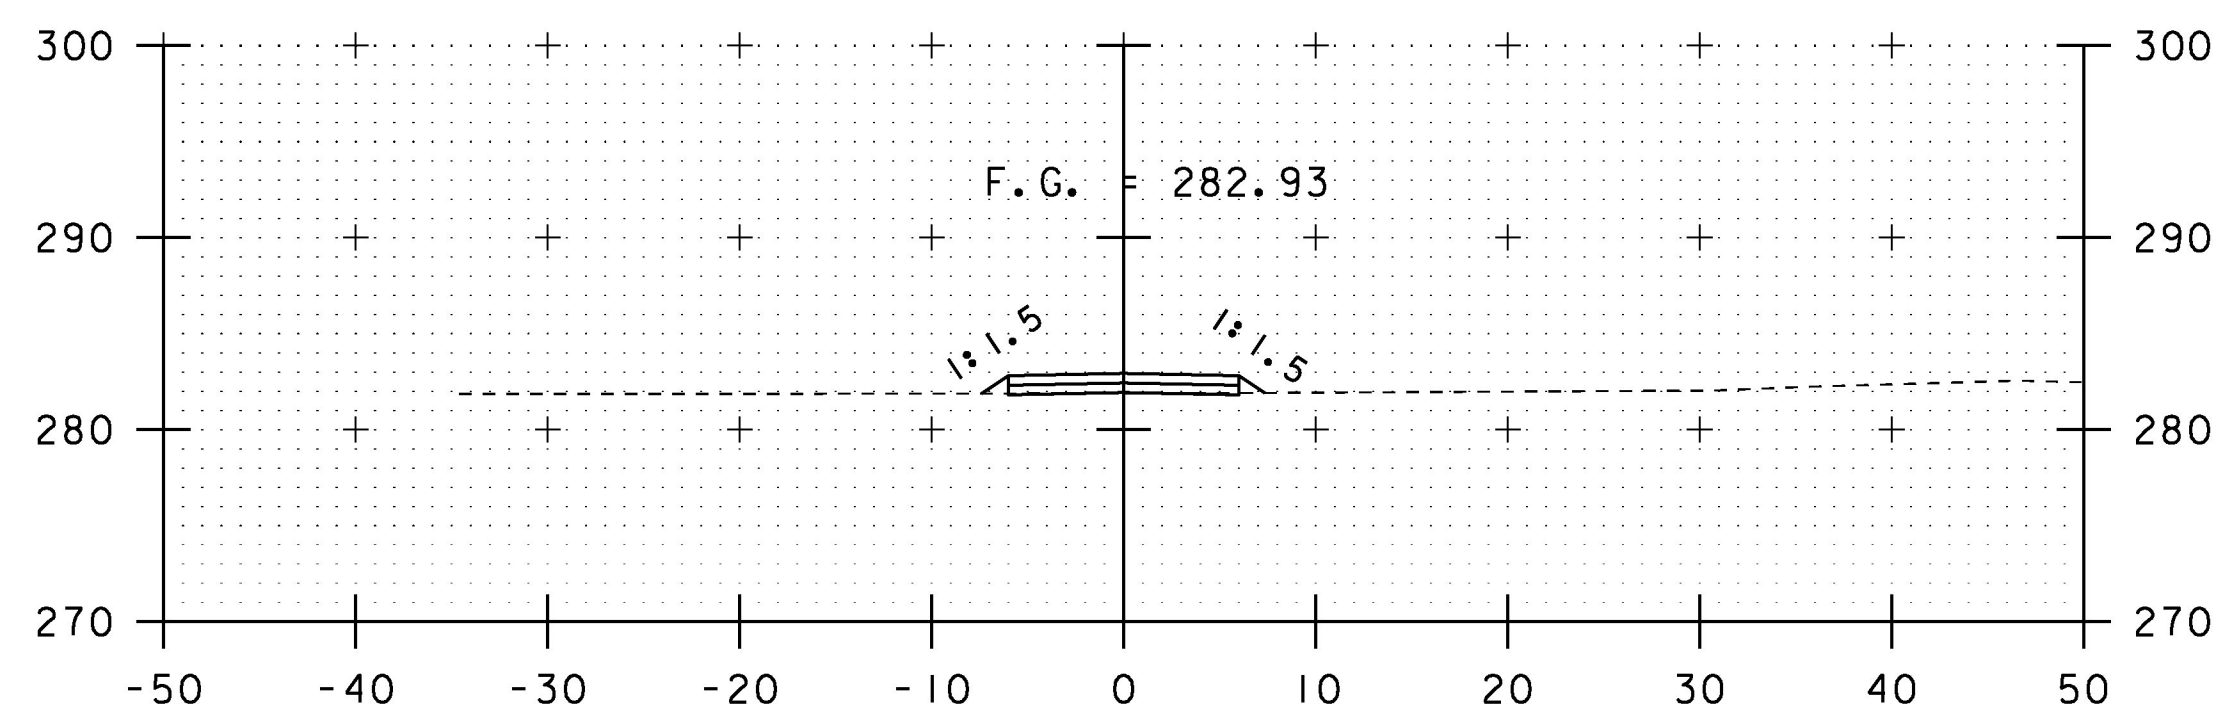


1+75

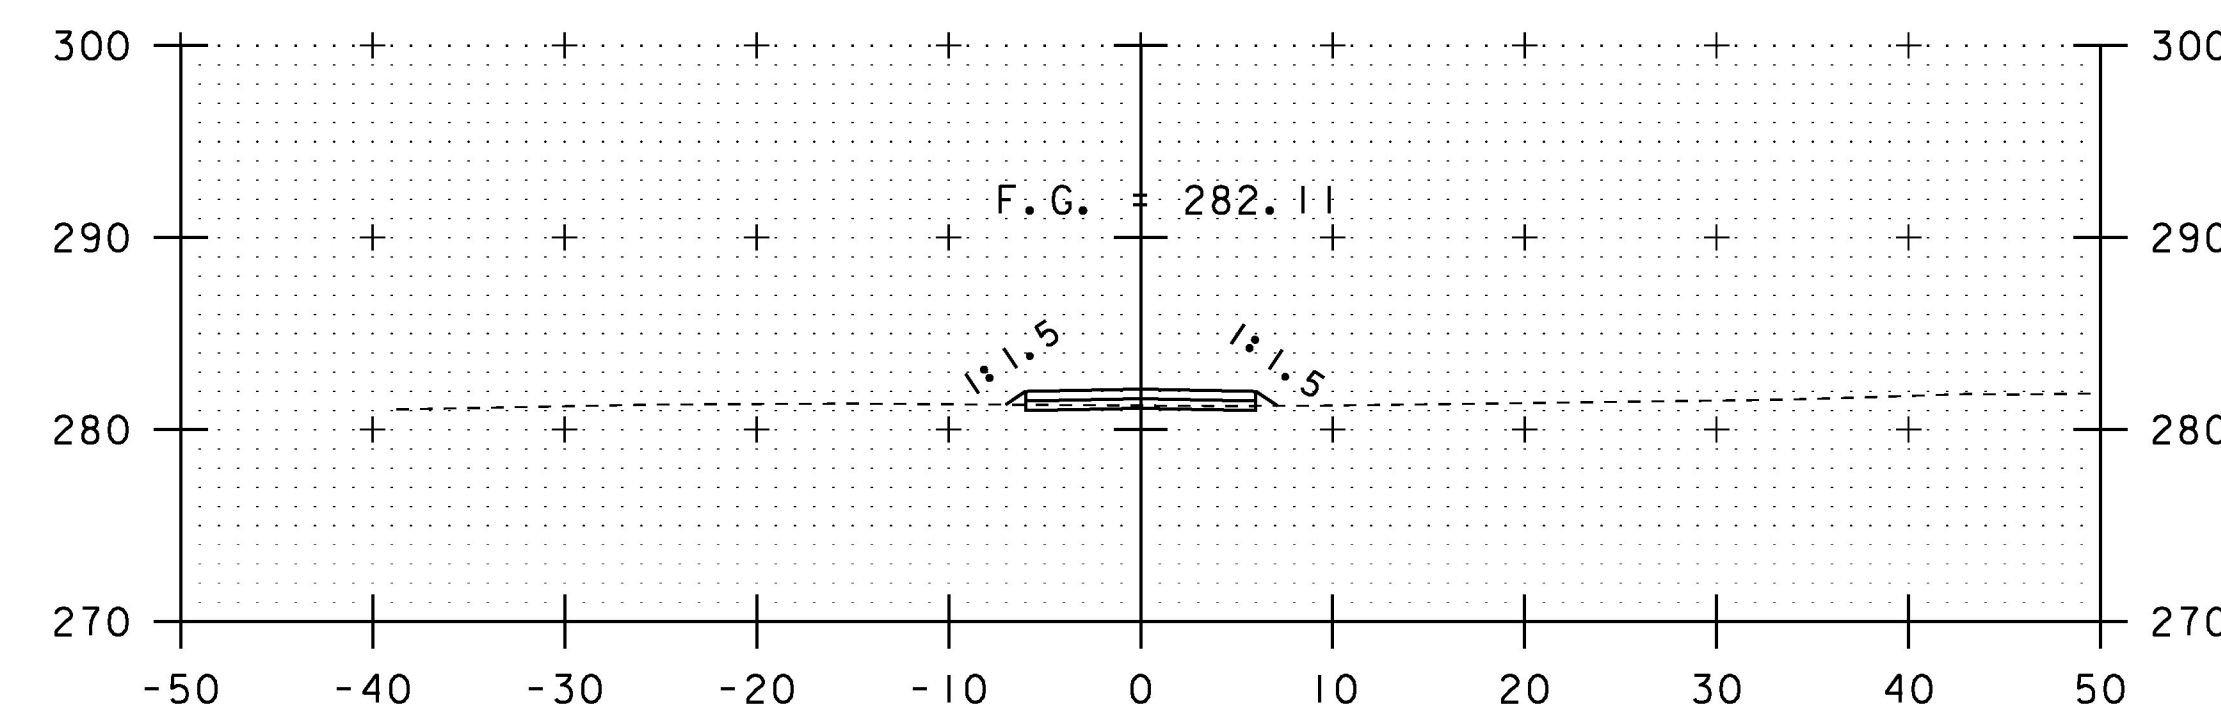

2+50

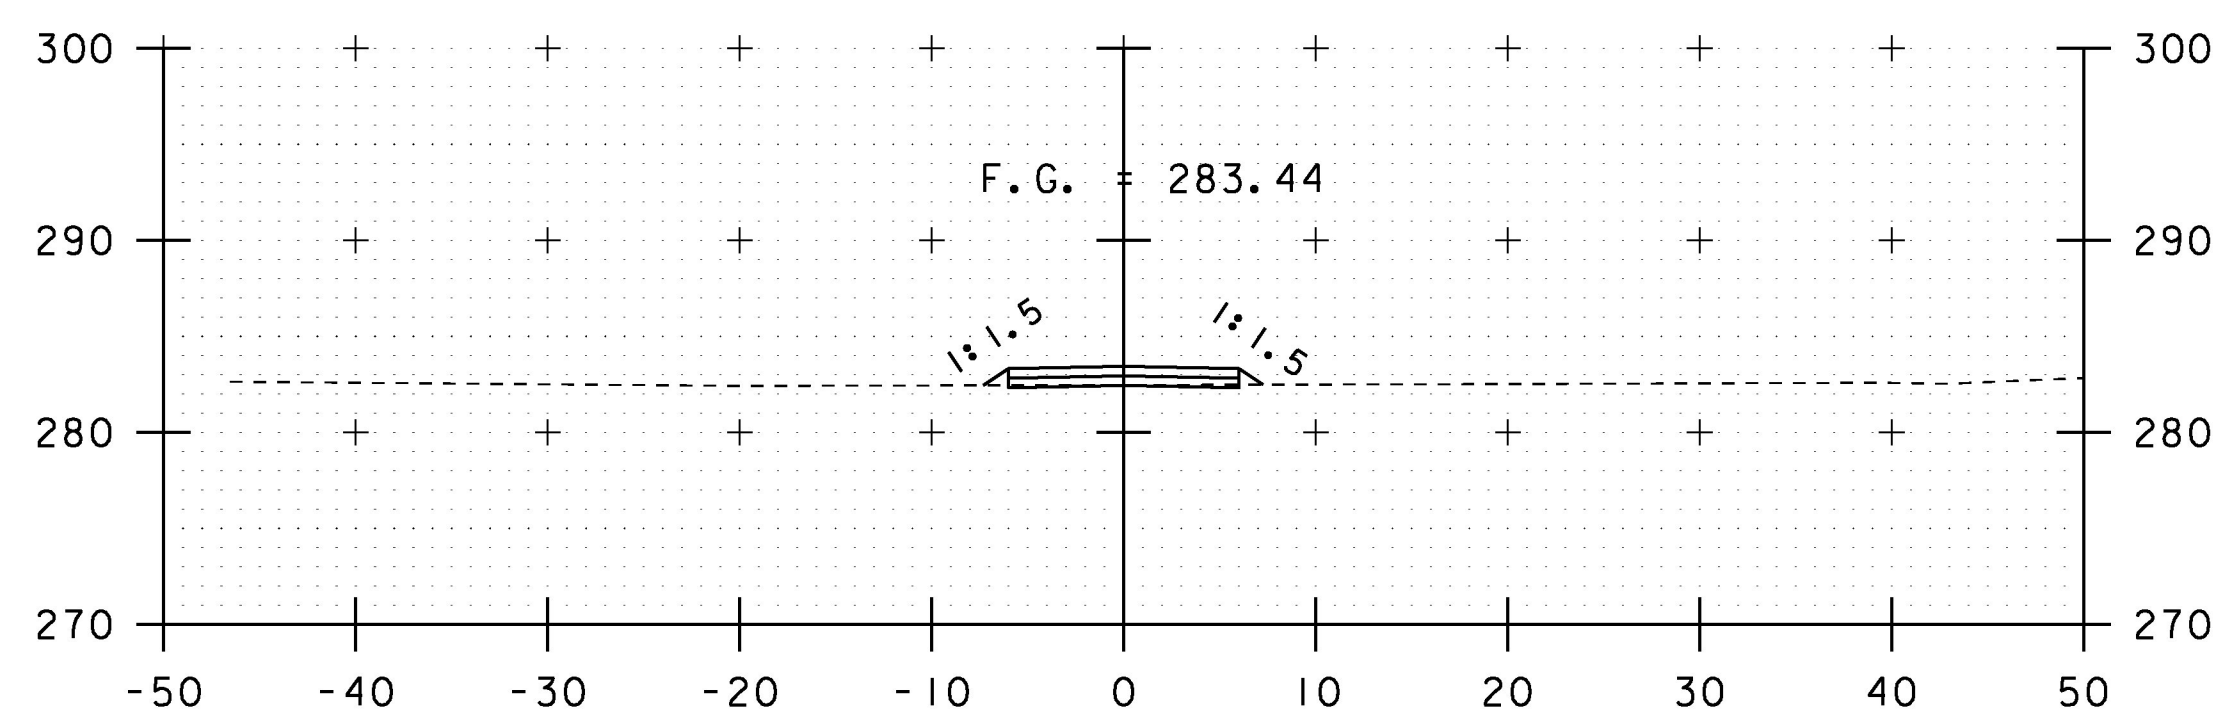

1+50

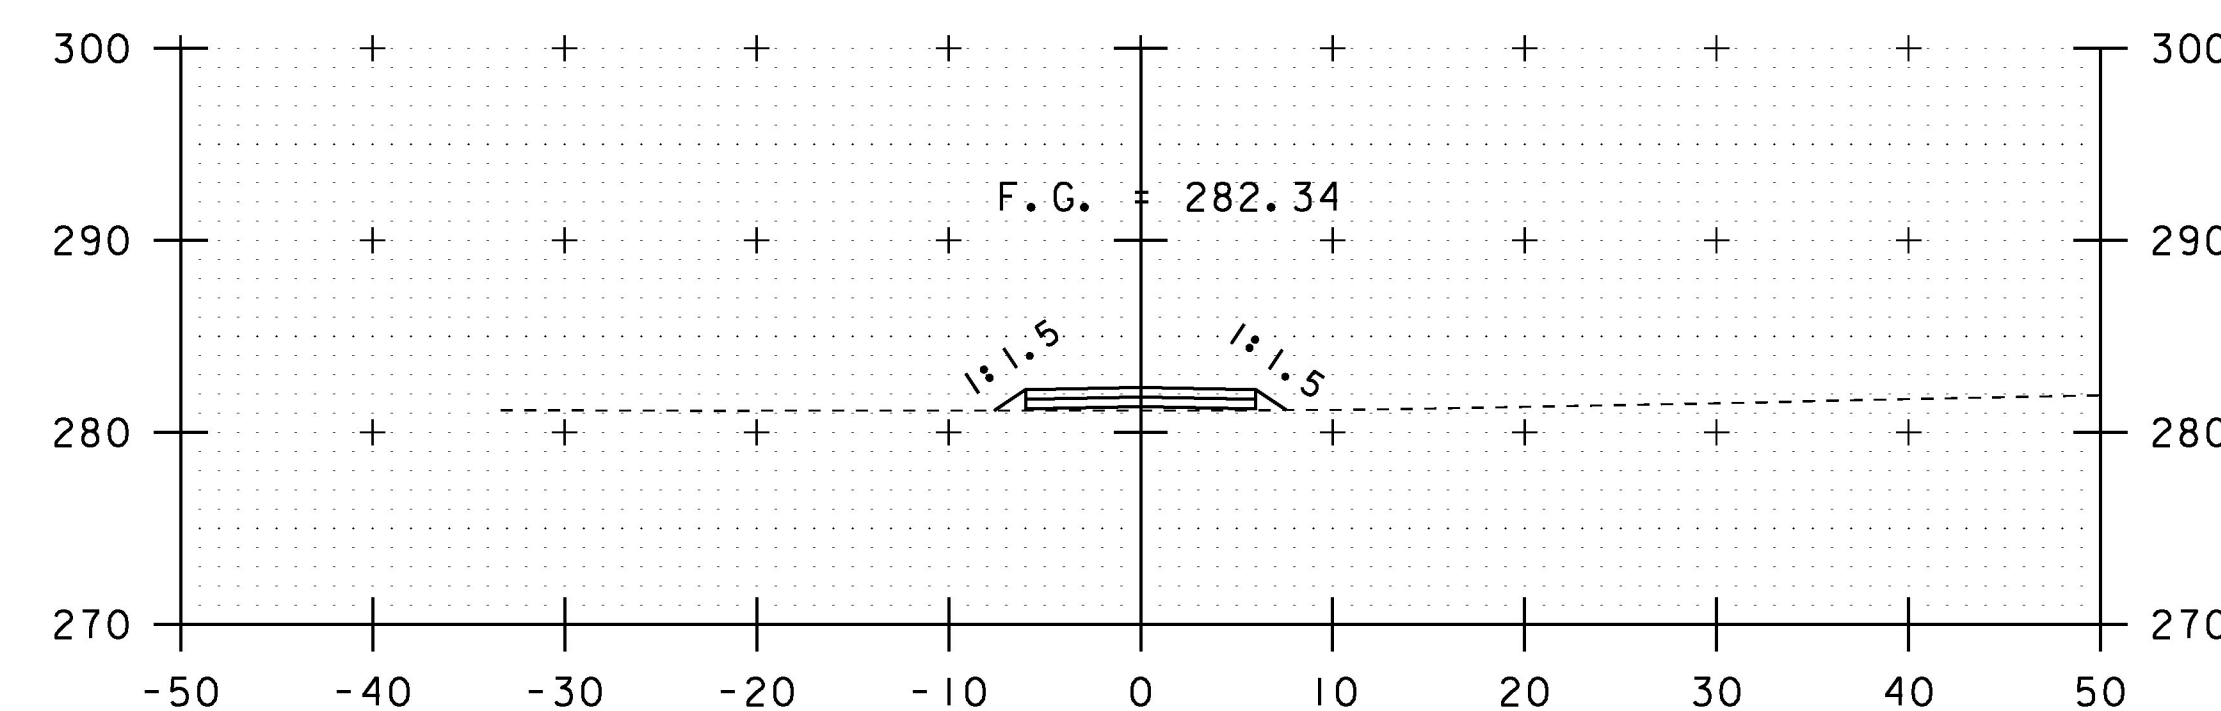


2+25


SCALE IN FEET

PROJECT NAME:	HIGHGATE
PROJECT NUMBER:	STP SCR(12)
FILE NAME:	d13ci34xs.dgn
PROJECT LEADER:	B. MARTIN
DESIGNED BY:	A. KEMPTON
NORTH ACCESS RD CROSS SECTION SHEET 2	SHEET 30 OF 40
PLOT DATE:	14-OCT-2016
DRAWN BY:	A. KEMPTON
CHECKED BY:	M. GAMELIN


STA. 1+50 TO STA. 2+75

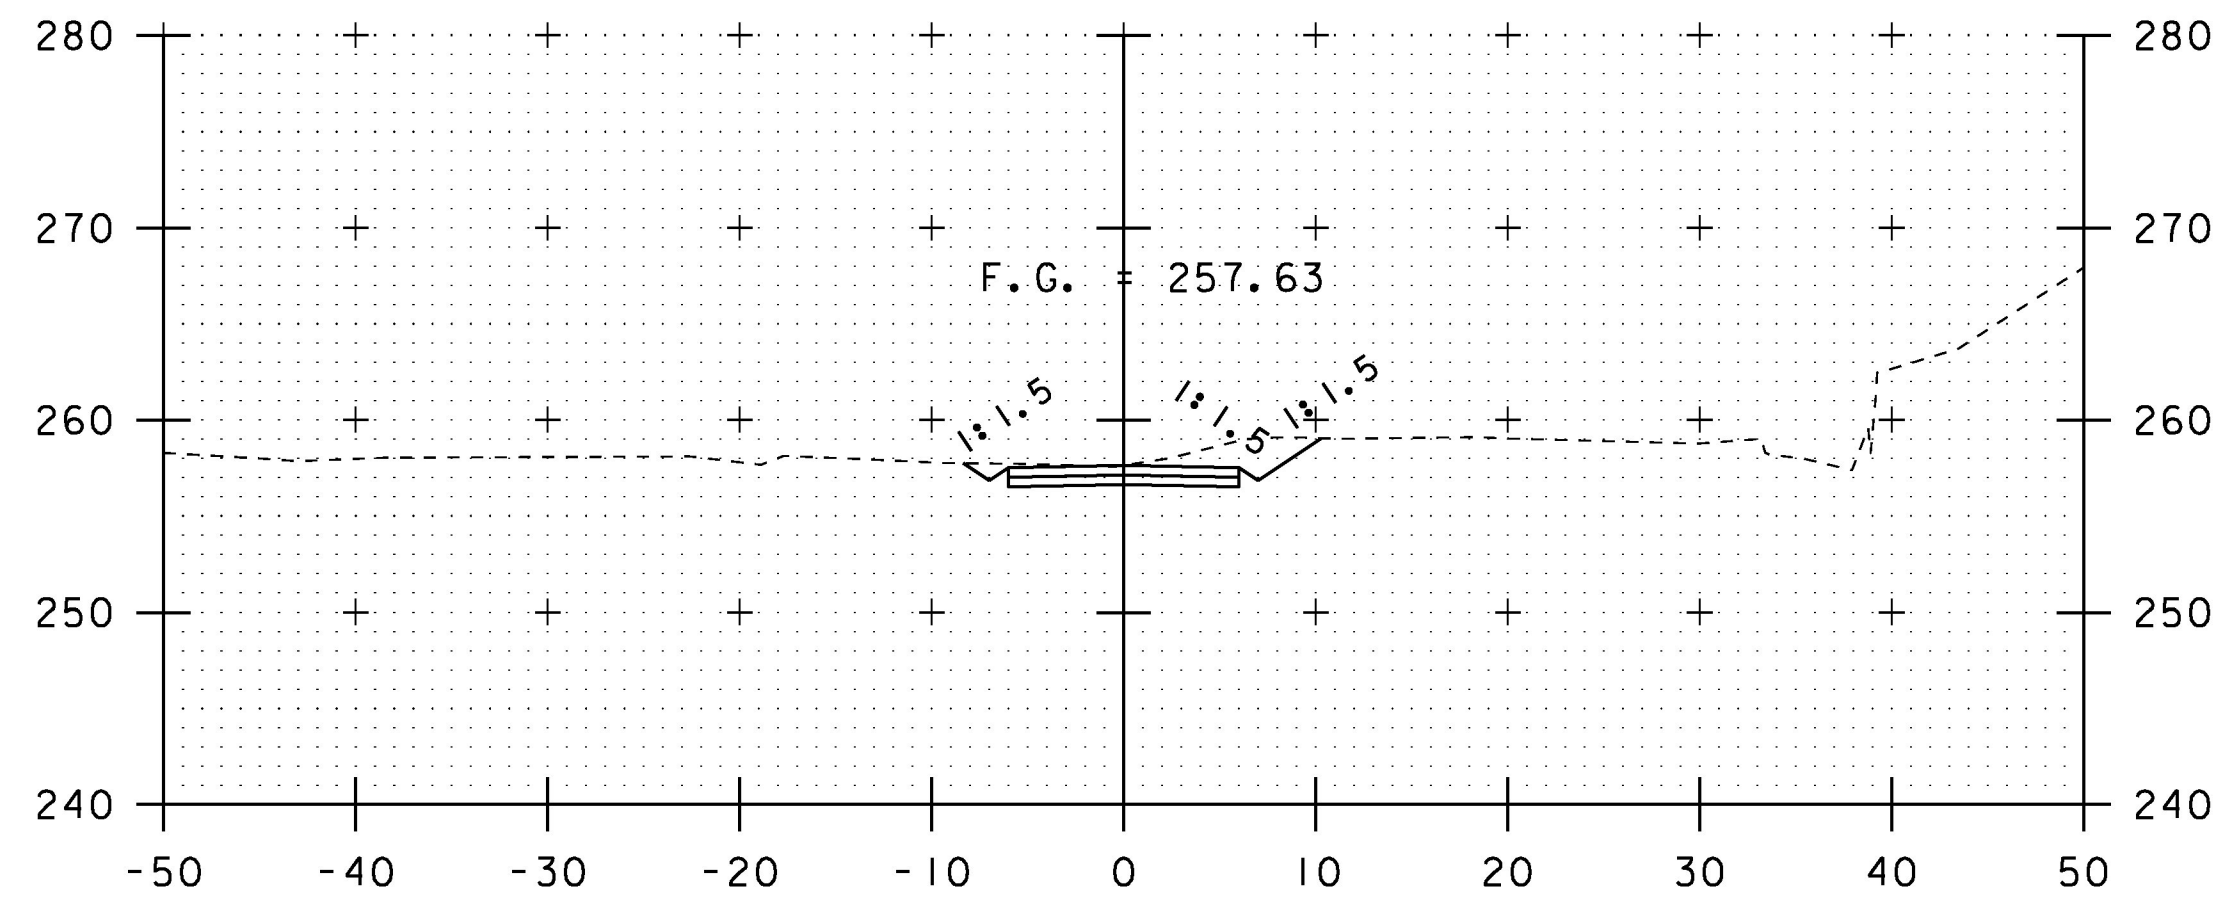

3+43  
END ACCESS ROAD

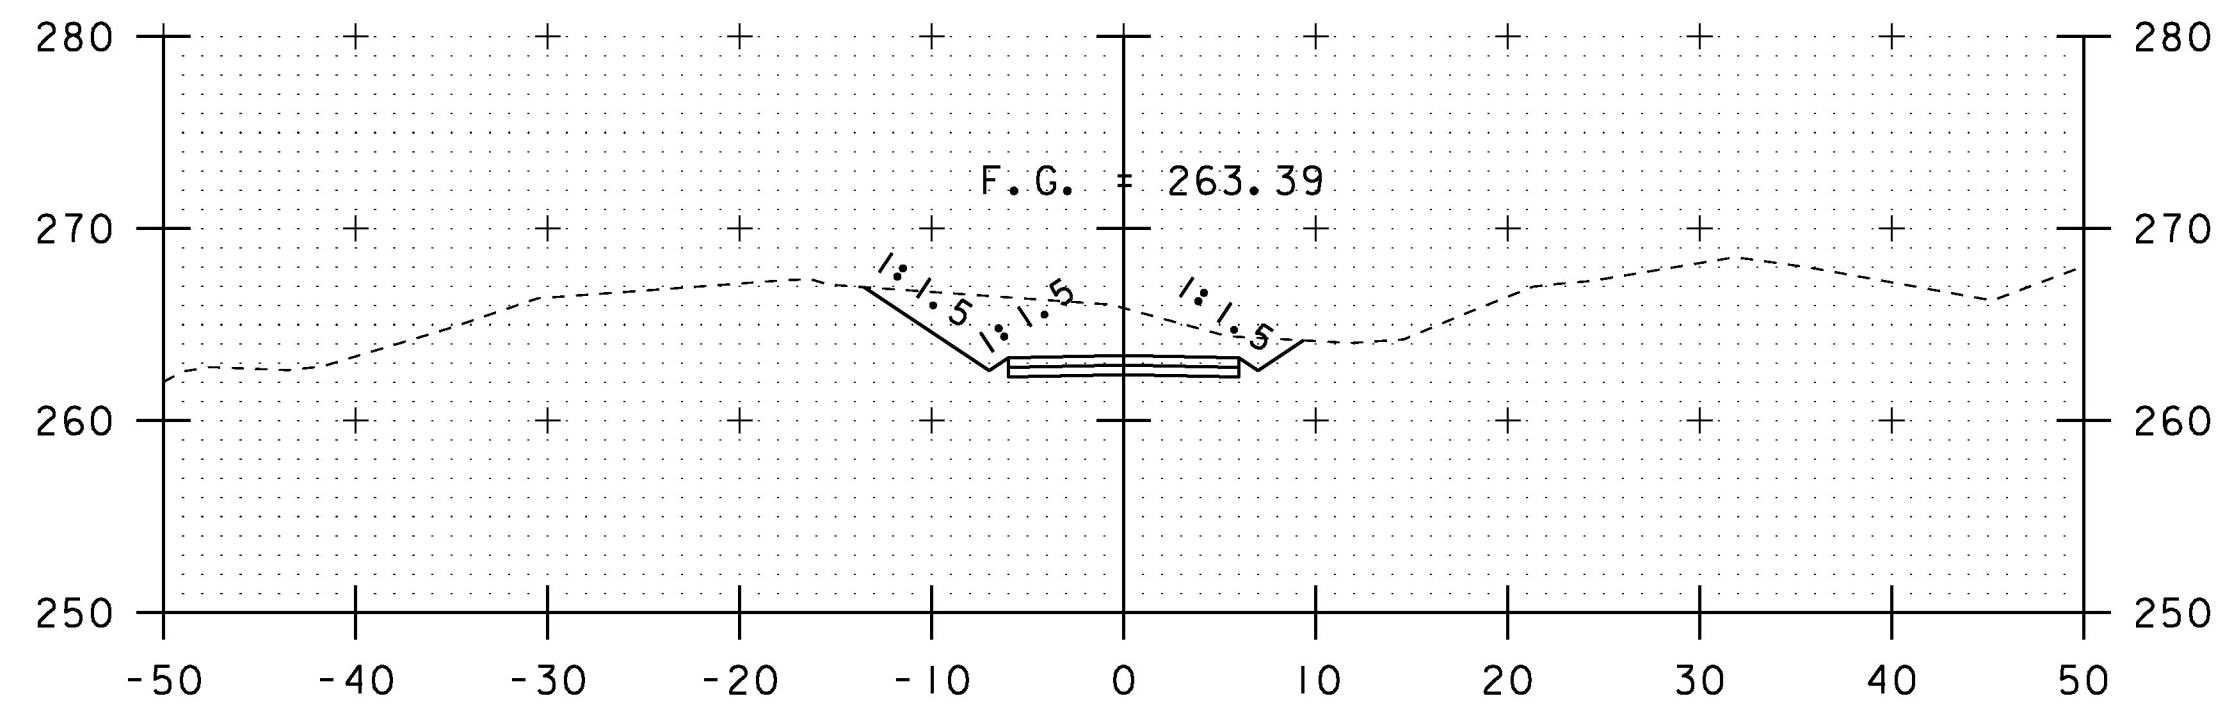

3+25

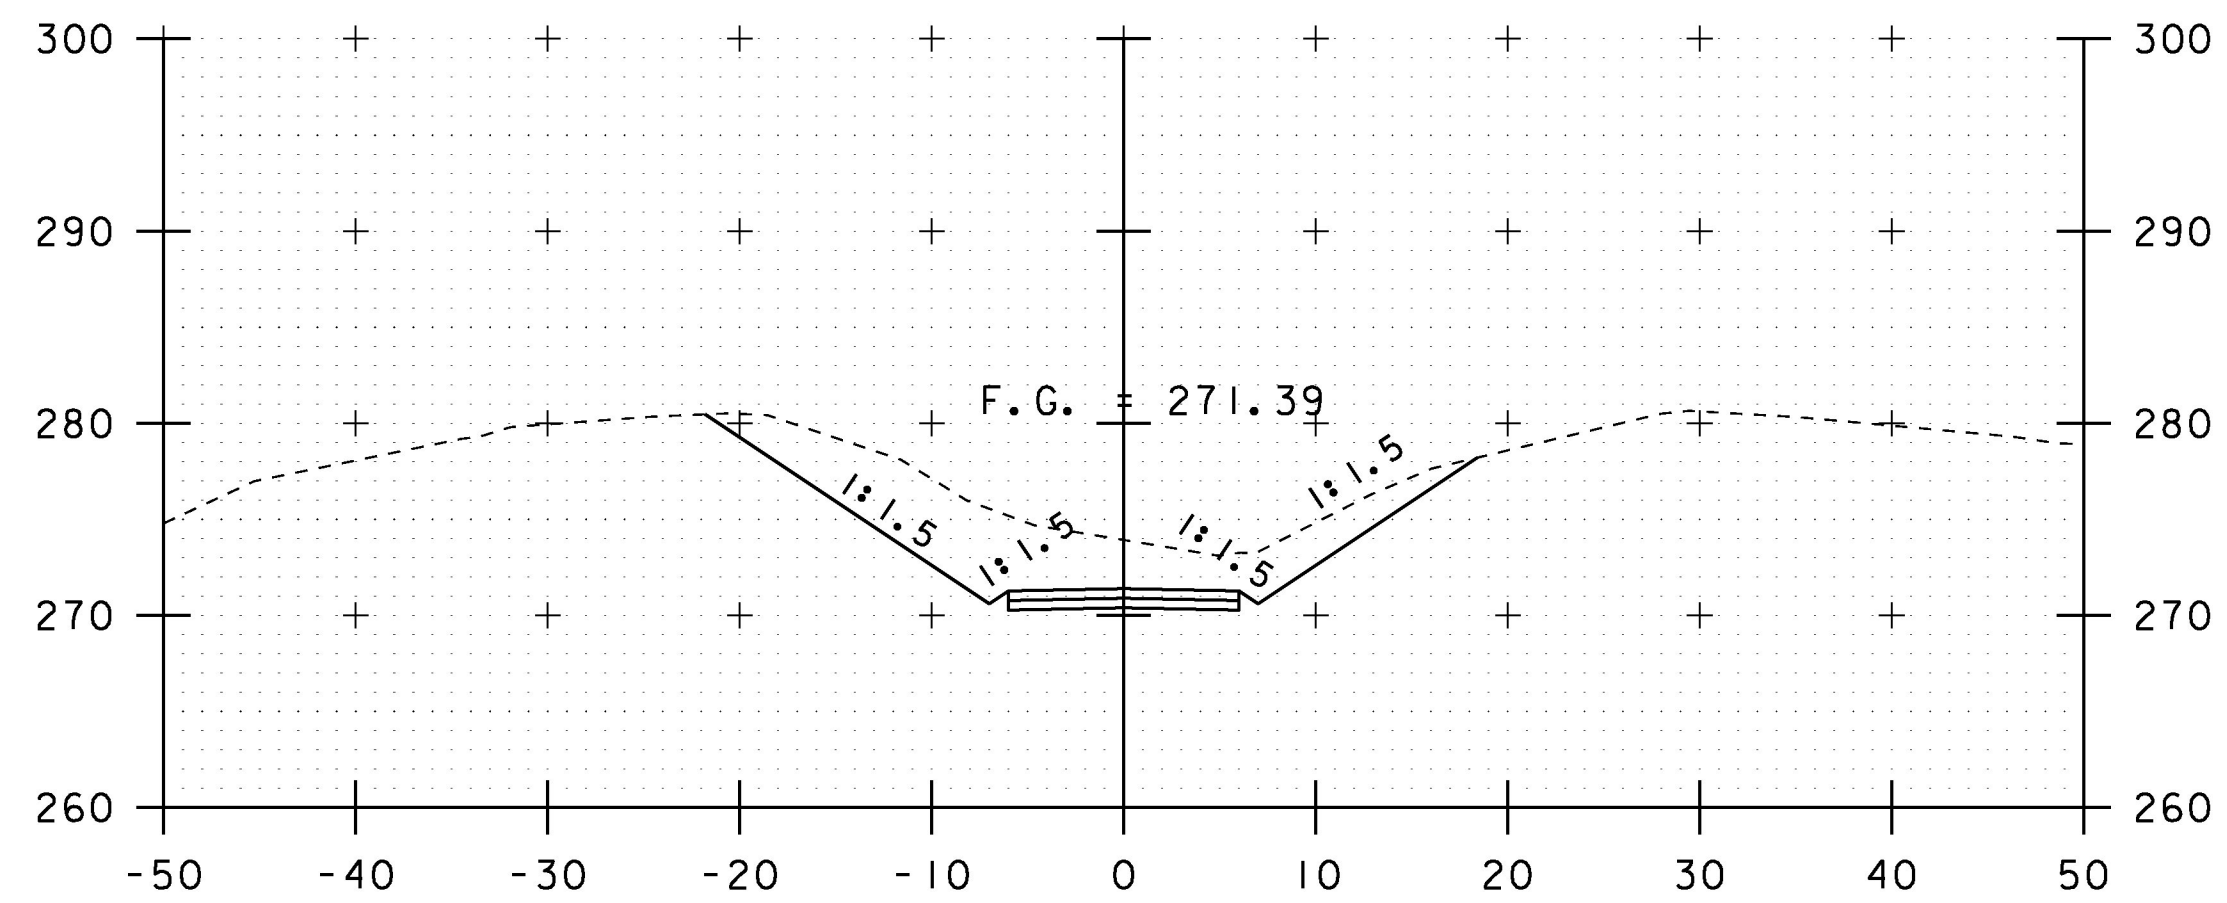


3+00


SCALE IN FEET

PROJECT NAME:	HIGHGATE
PROJECT NUMBER:	STP_SCRP(12)
FILE NAME:	d13ci34xs.dgn
PROJECT LEADER:	B. MARTIN
DESIGNED BY:	A. KEMPTON
NORTH ACCESS RD CROSS SECTION SHEET 3	SHEET 31 OF 40
PLOT DATE:	14-OCT-2016
DRAWN BY:	A. KEMPTON
CHECKED BY:	M. GAMELIN


STA. 3+00 TO STA. 3+43

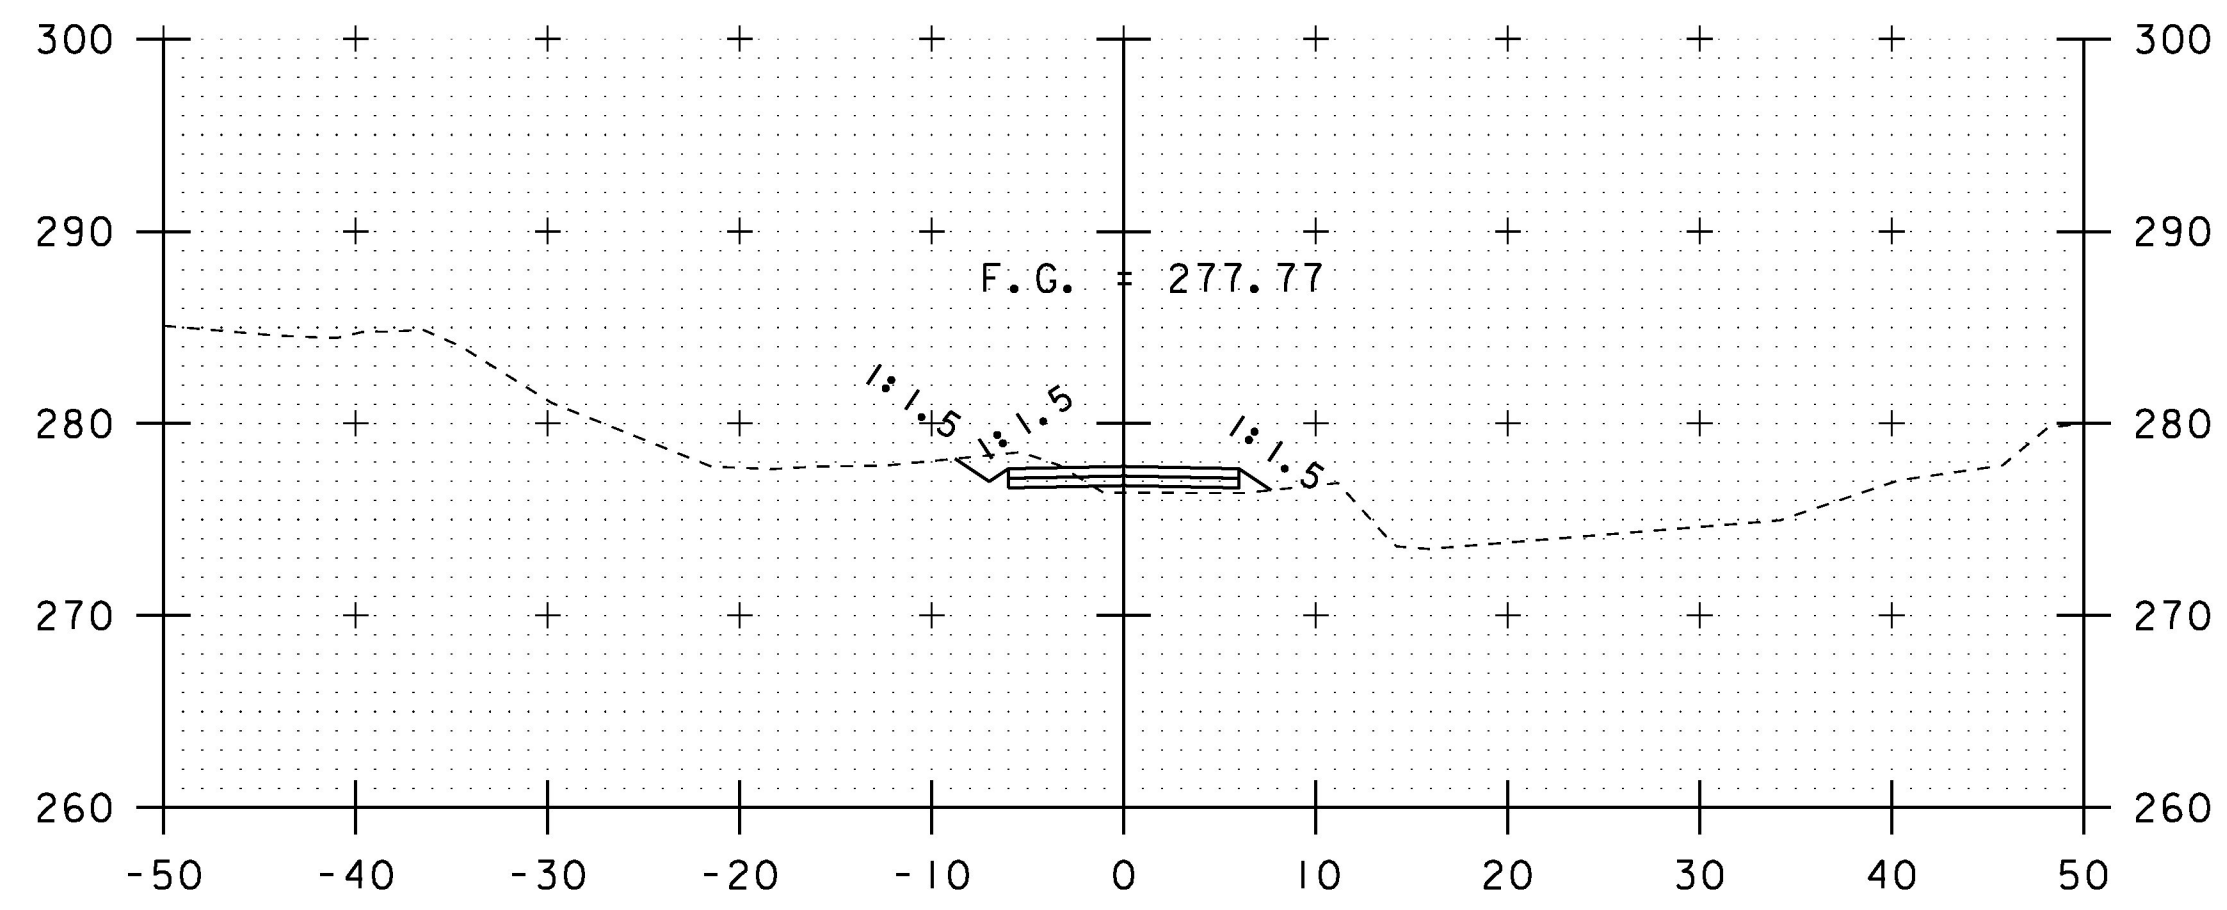


I+25

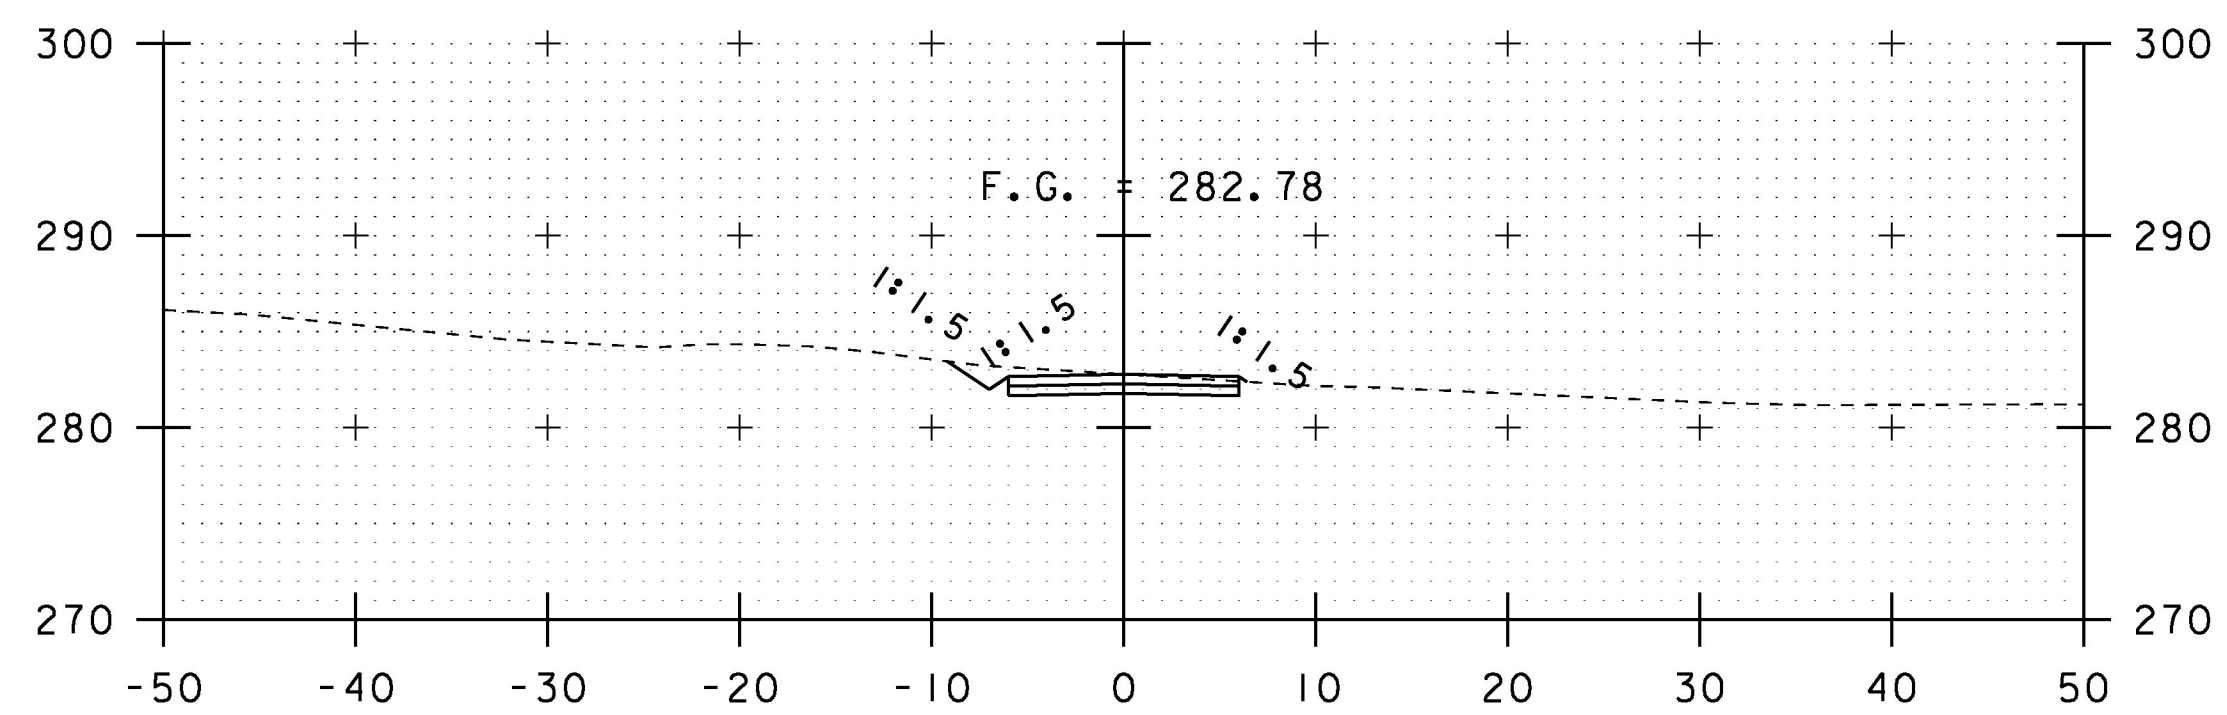


I+06  
BEGIN ACCESS ROAD

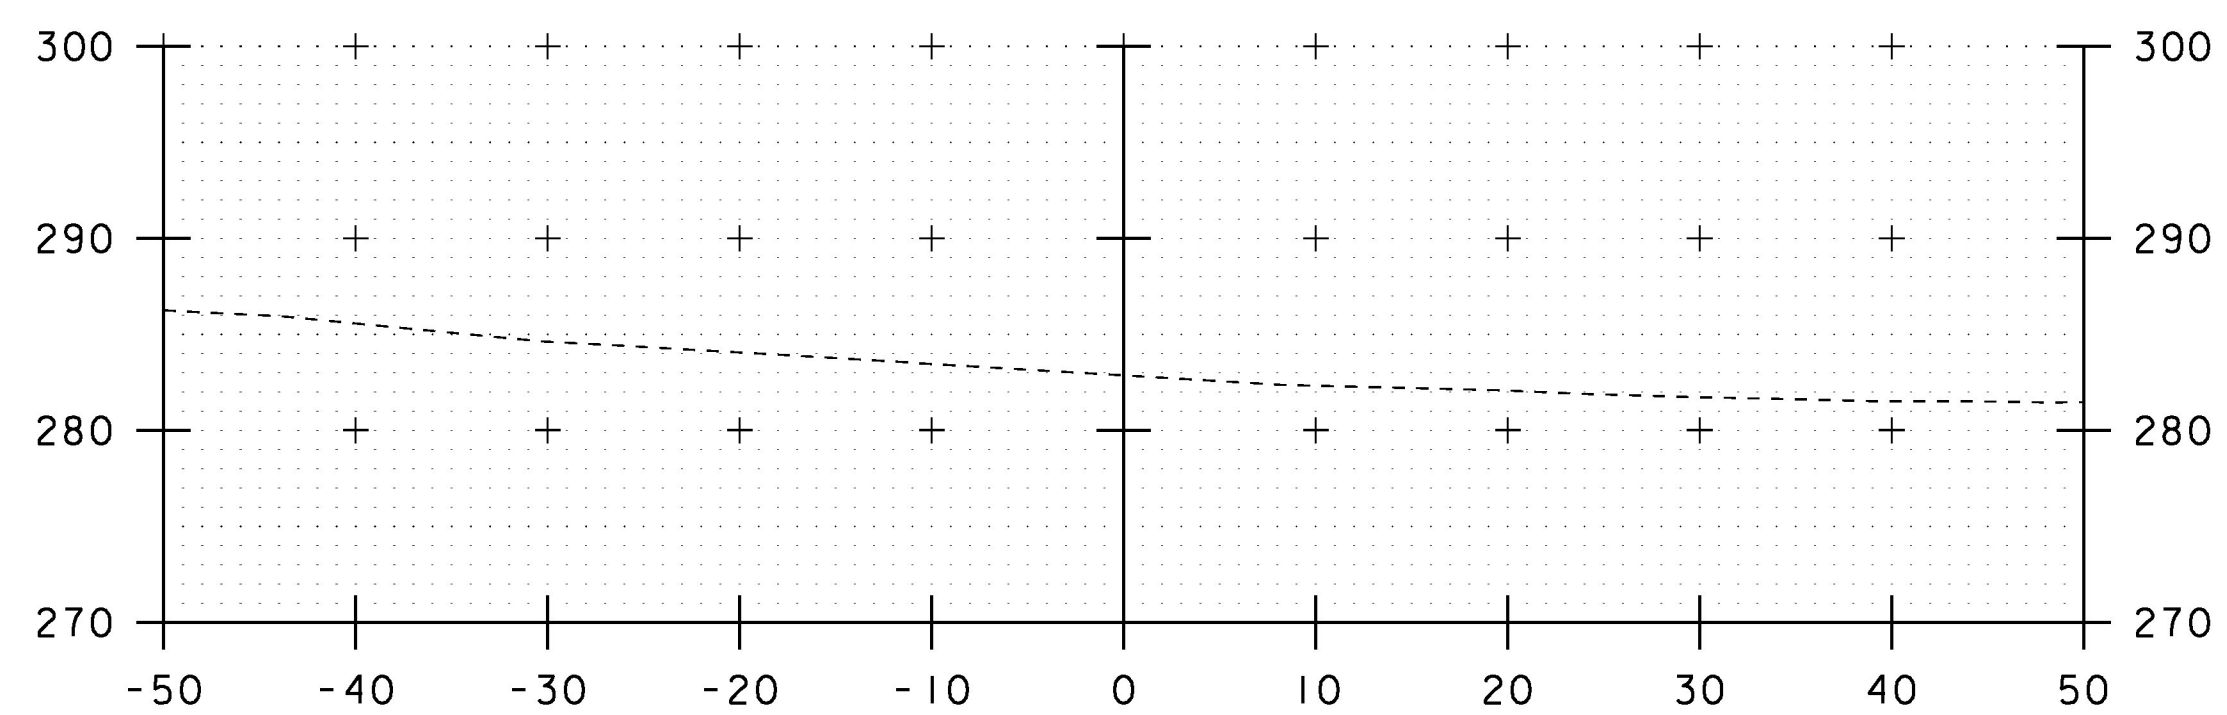

I+00

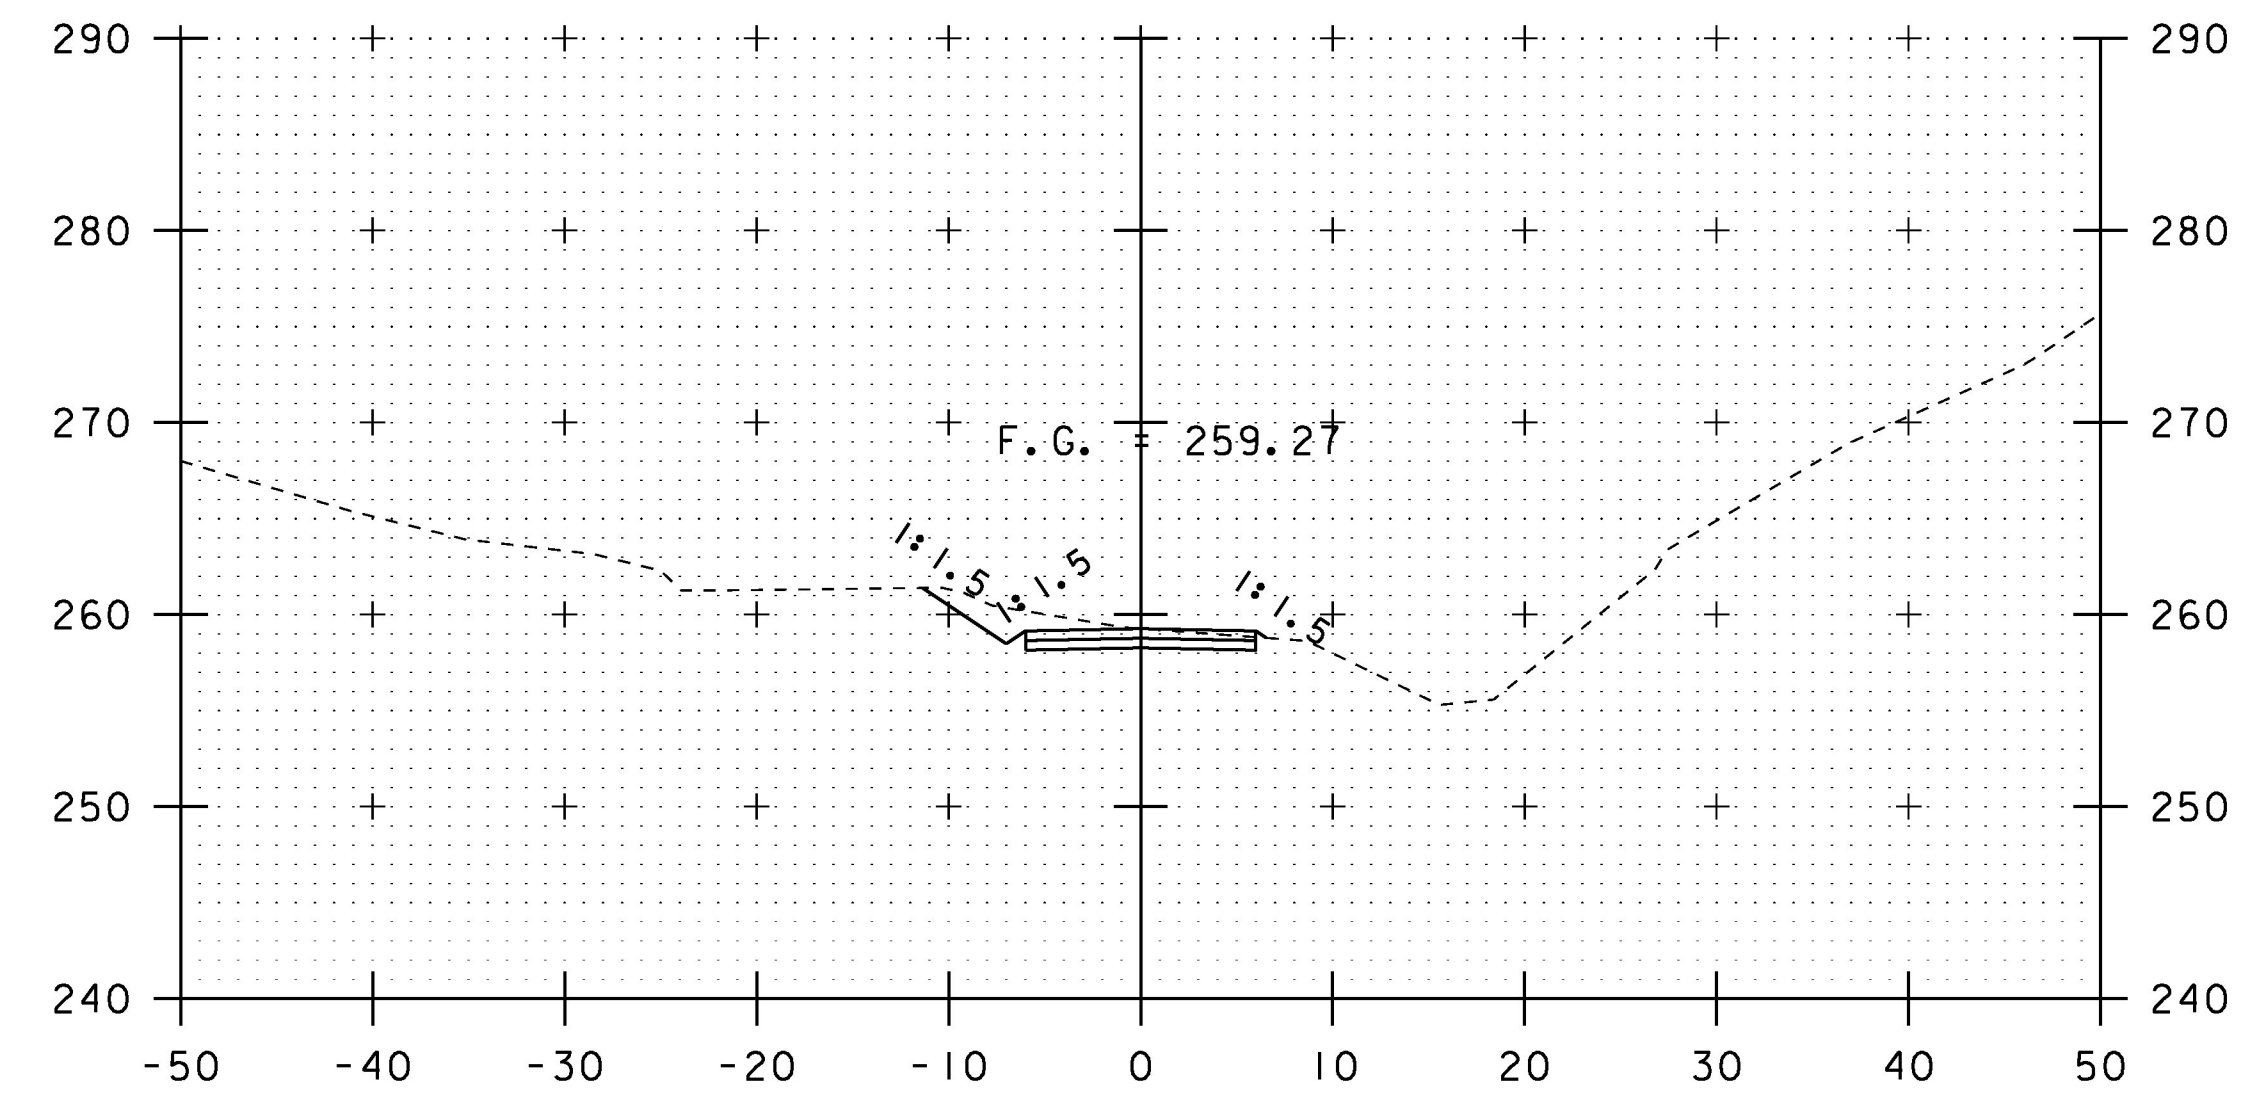

I+75

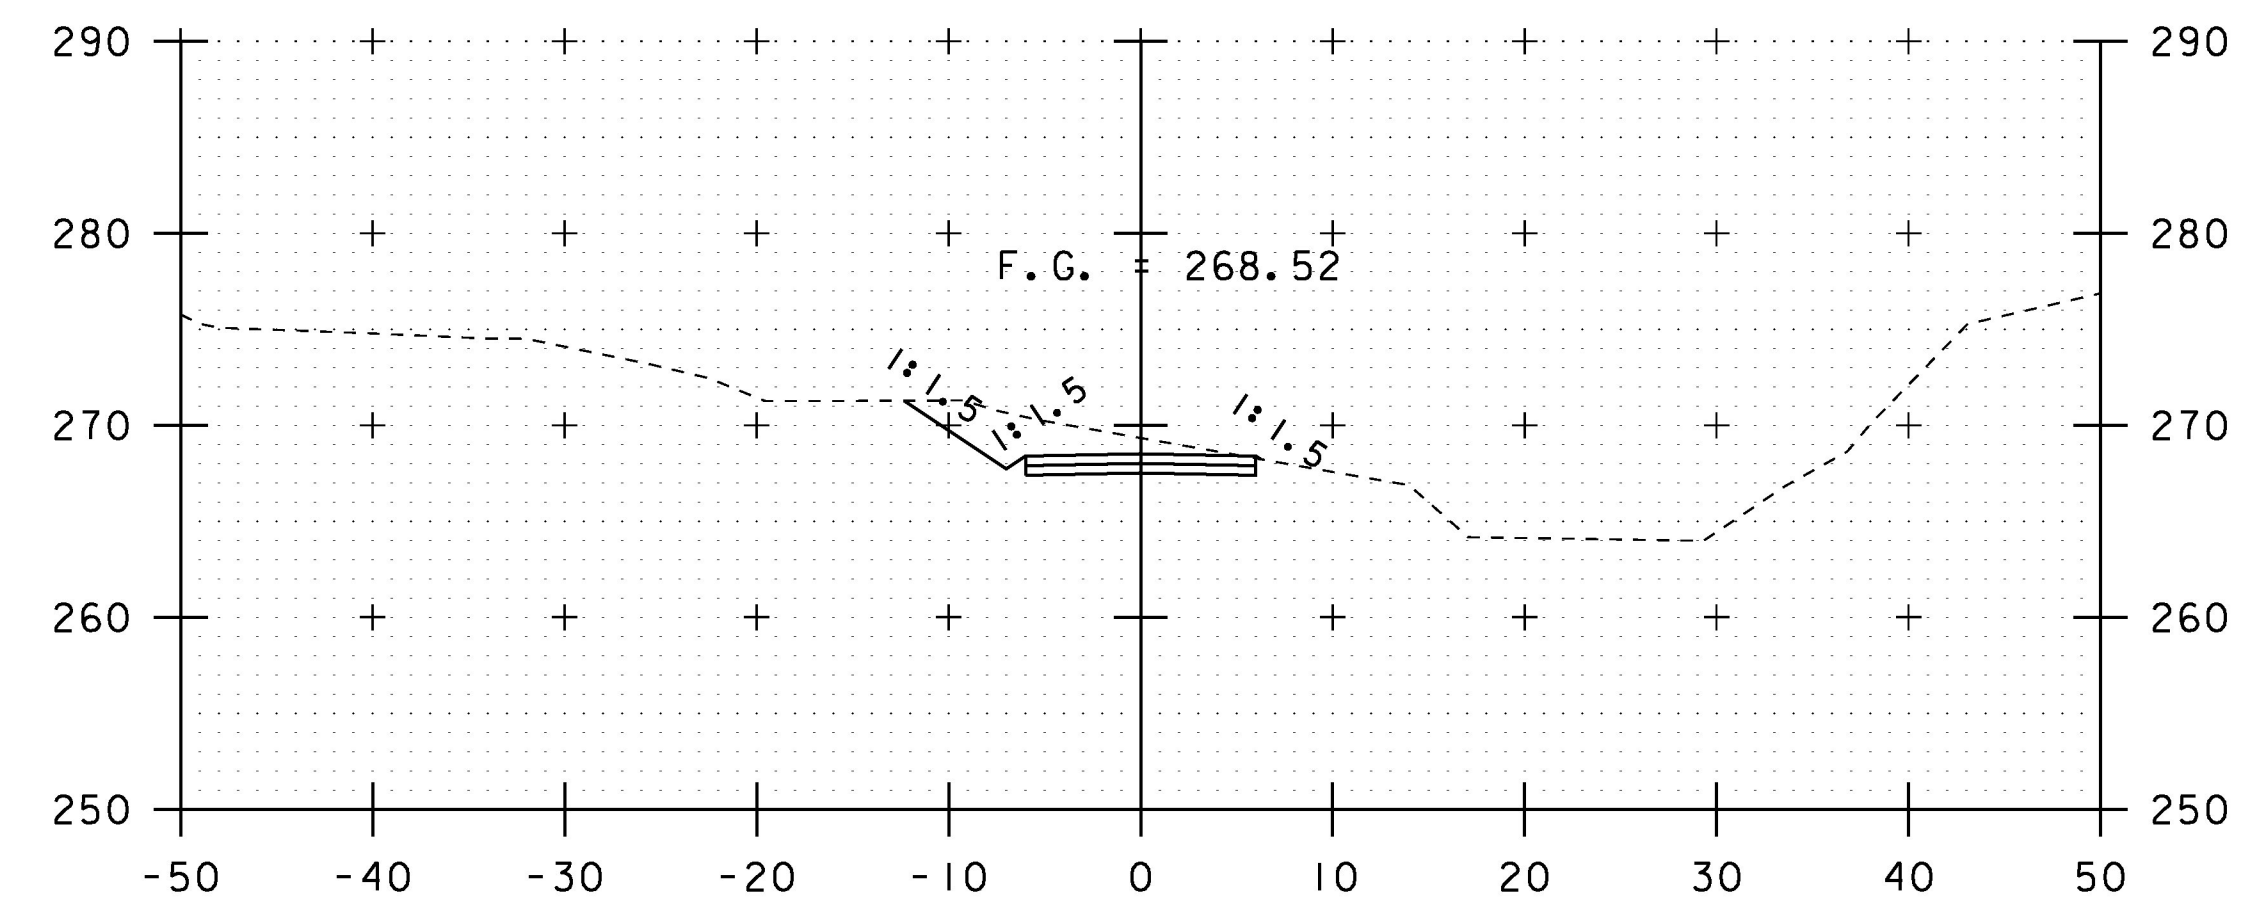


I+50


SCALE IN FEET

STA. I+00 TO STA. I+75


PROJECT NAME:	HIGHGATE	PLOT DATE:	14-OCT-2016
PROJECT NUMBER:	STP SCRP(12)	DRAWN BY:	A. KEMPTON
FILE NAME:	d13ci34xs.dgn	CHECKED BY:	M. GAMELIN
PROJECT LEADER:	B. MARTIN		
DESIGNED BY:	A. KEMPTON		
SOUTH ACCESS RD CROSS SECTION SHEET I		SHEET 32 OF 40	

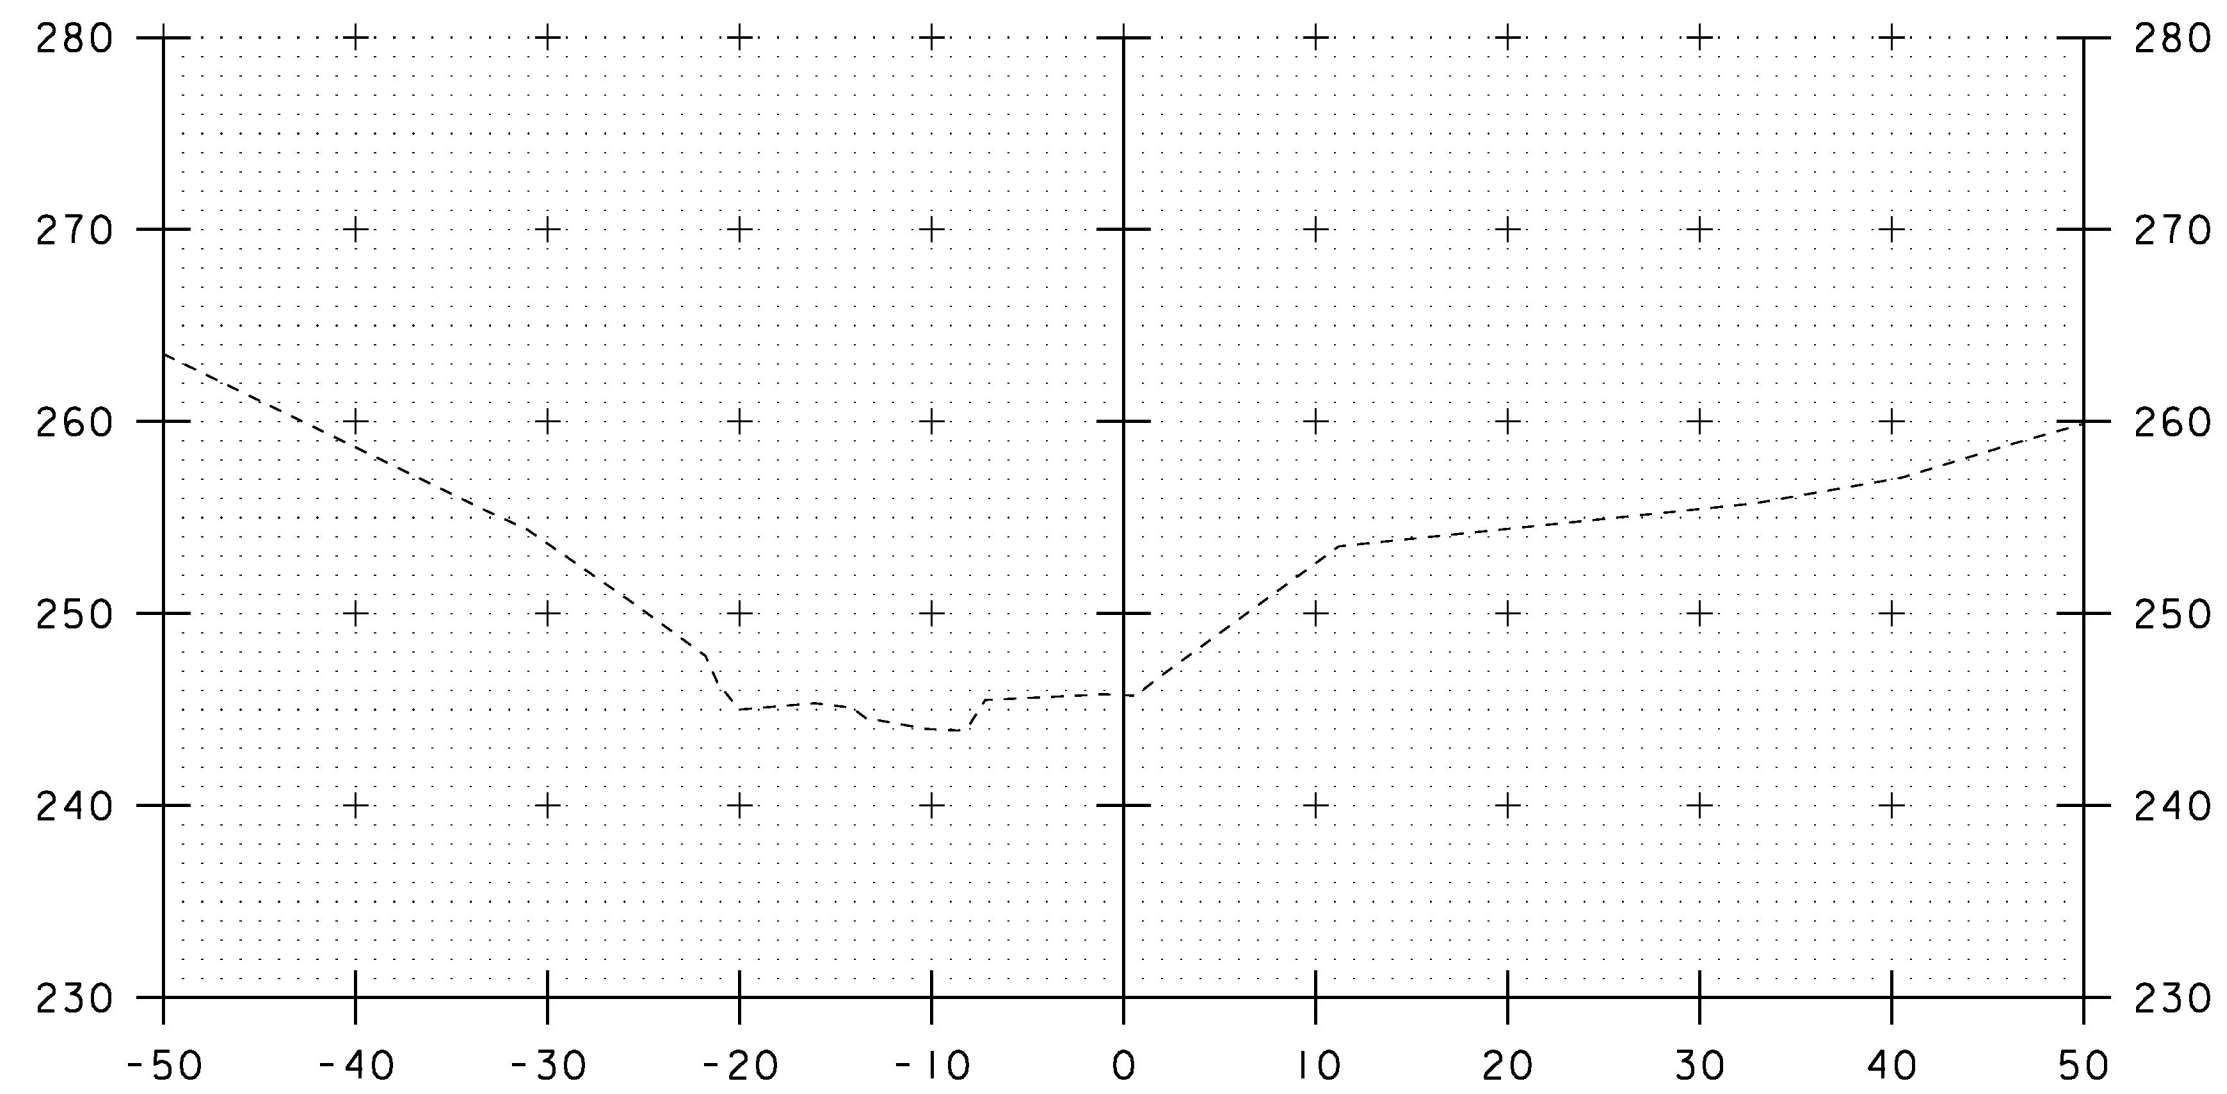

2+25

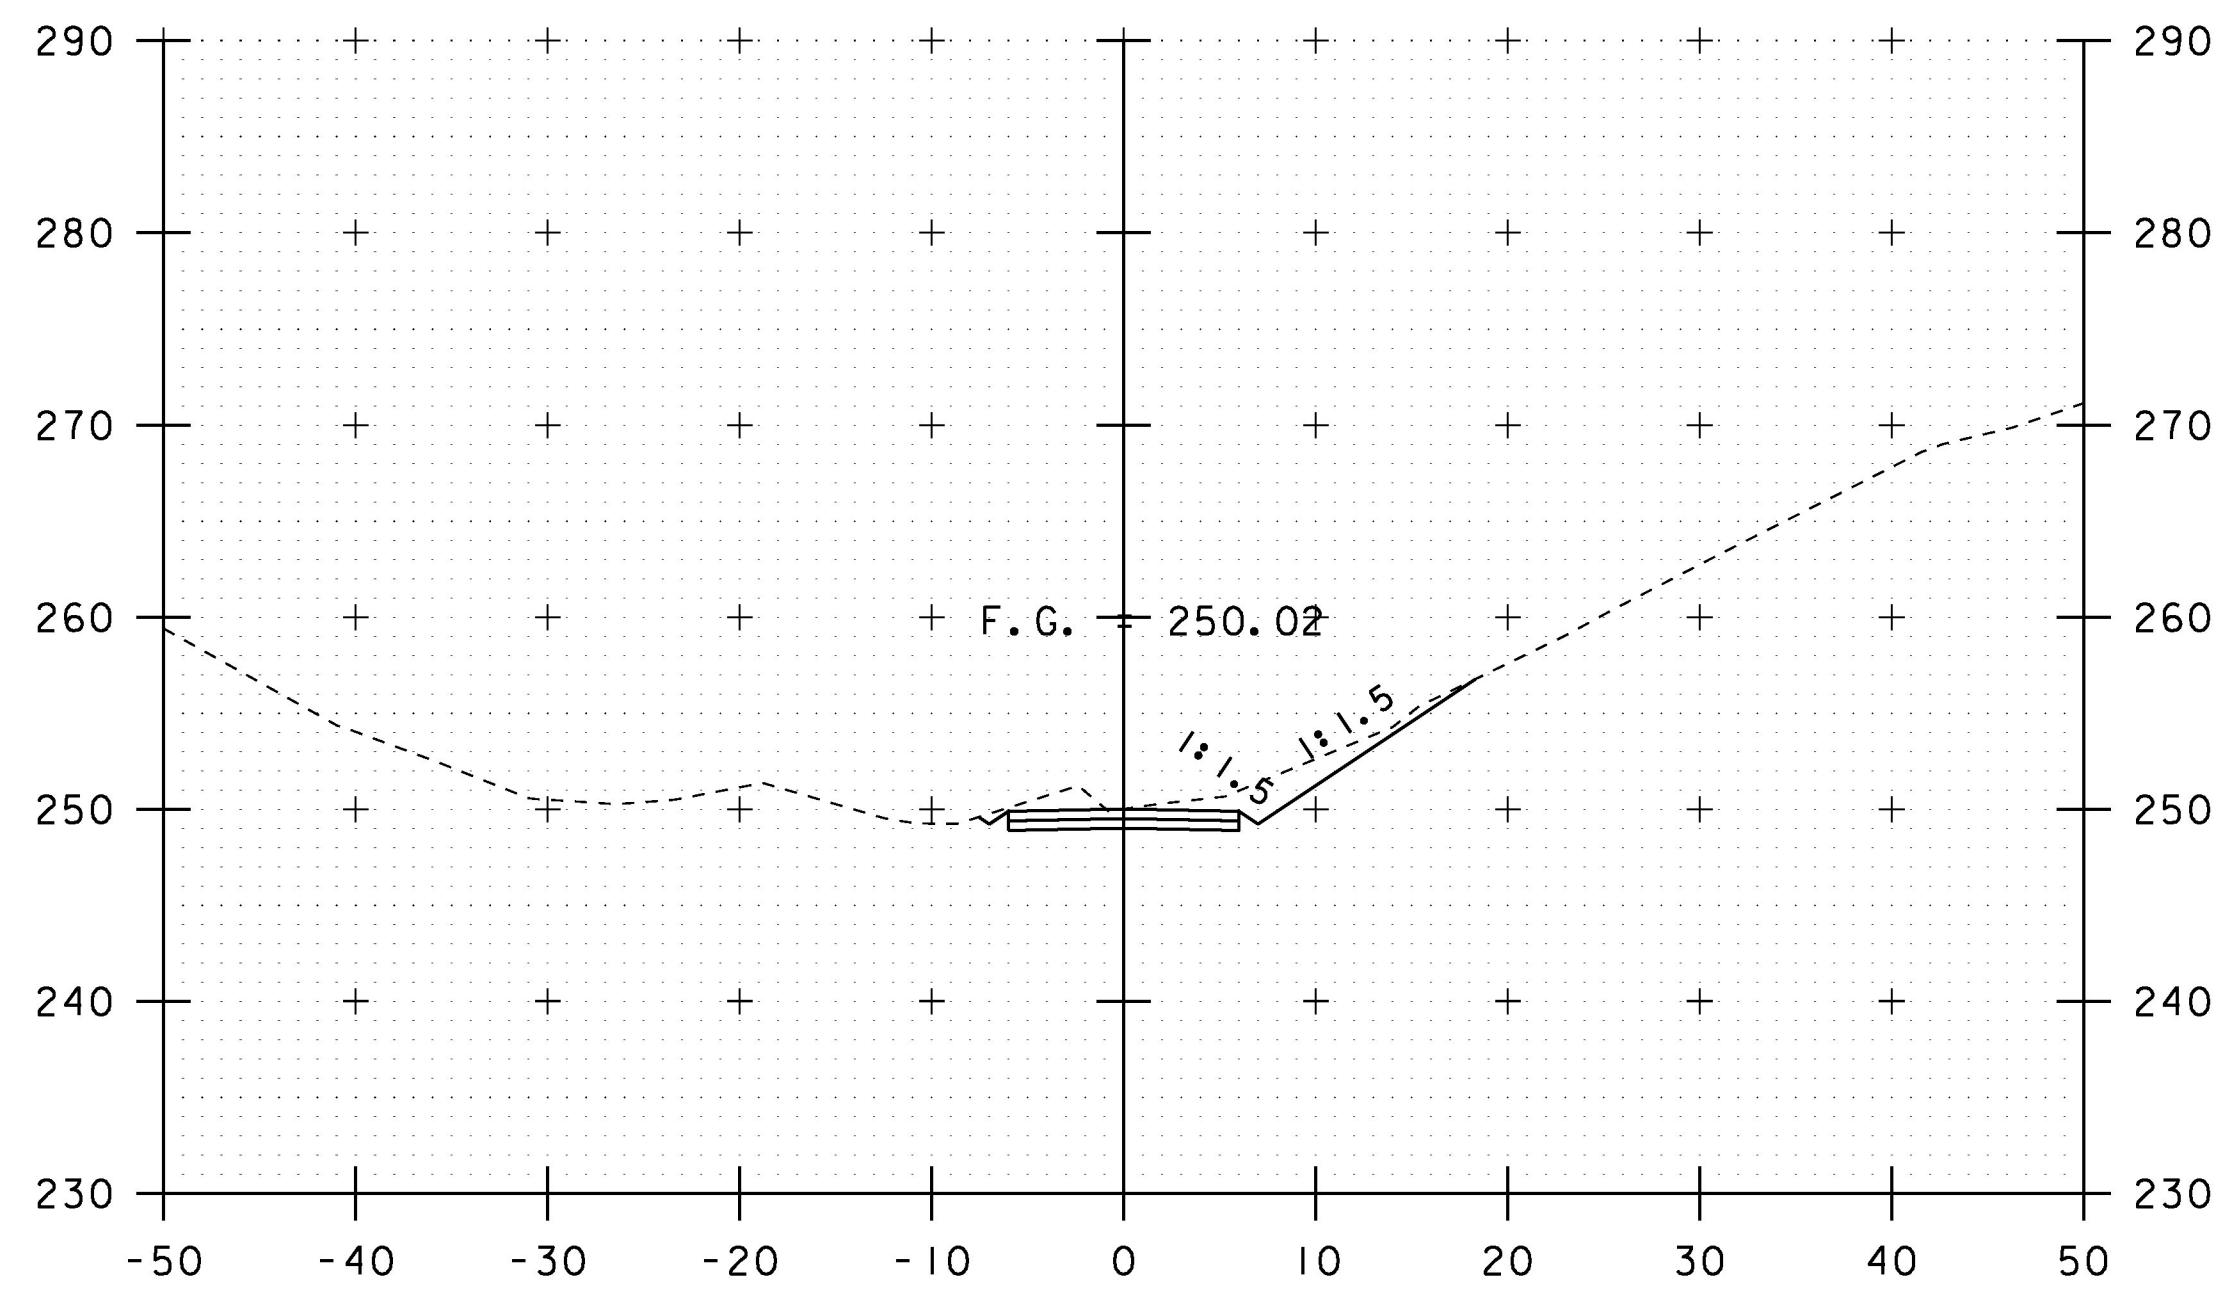

2+00  
END ACCESS ROAD

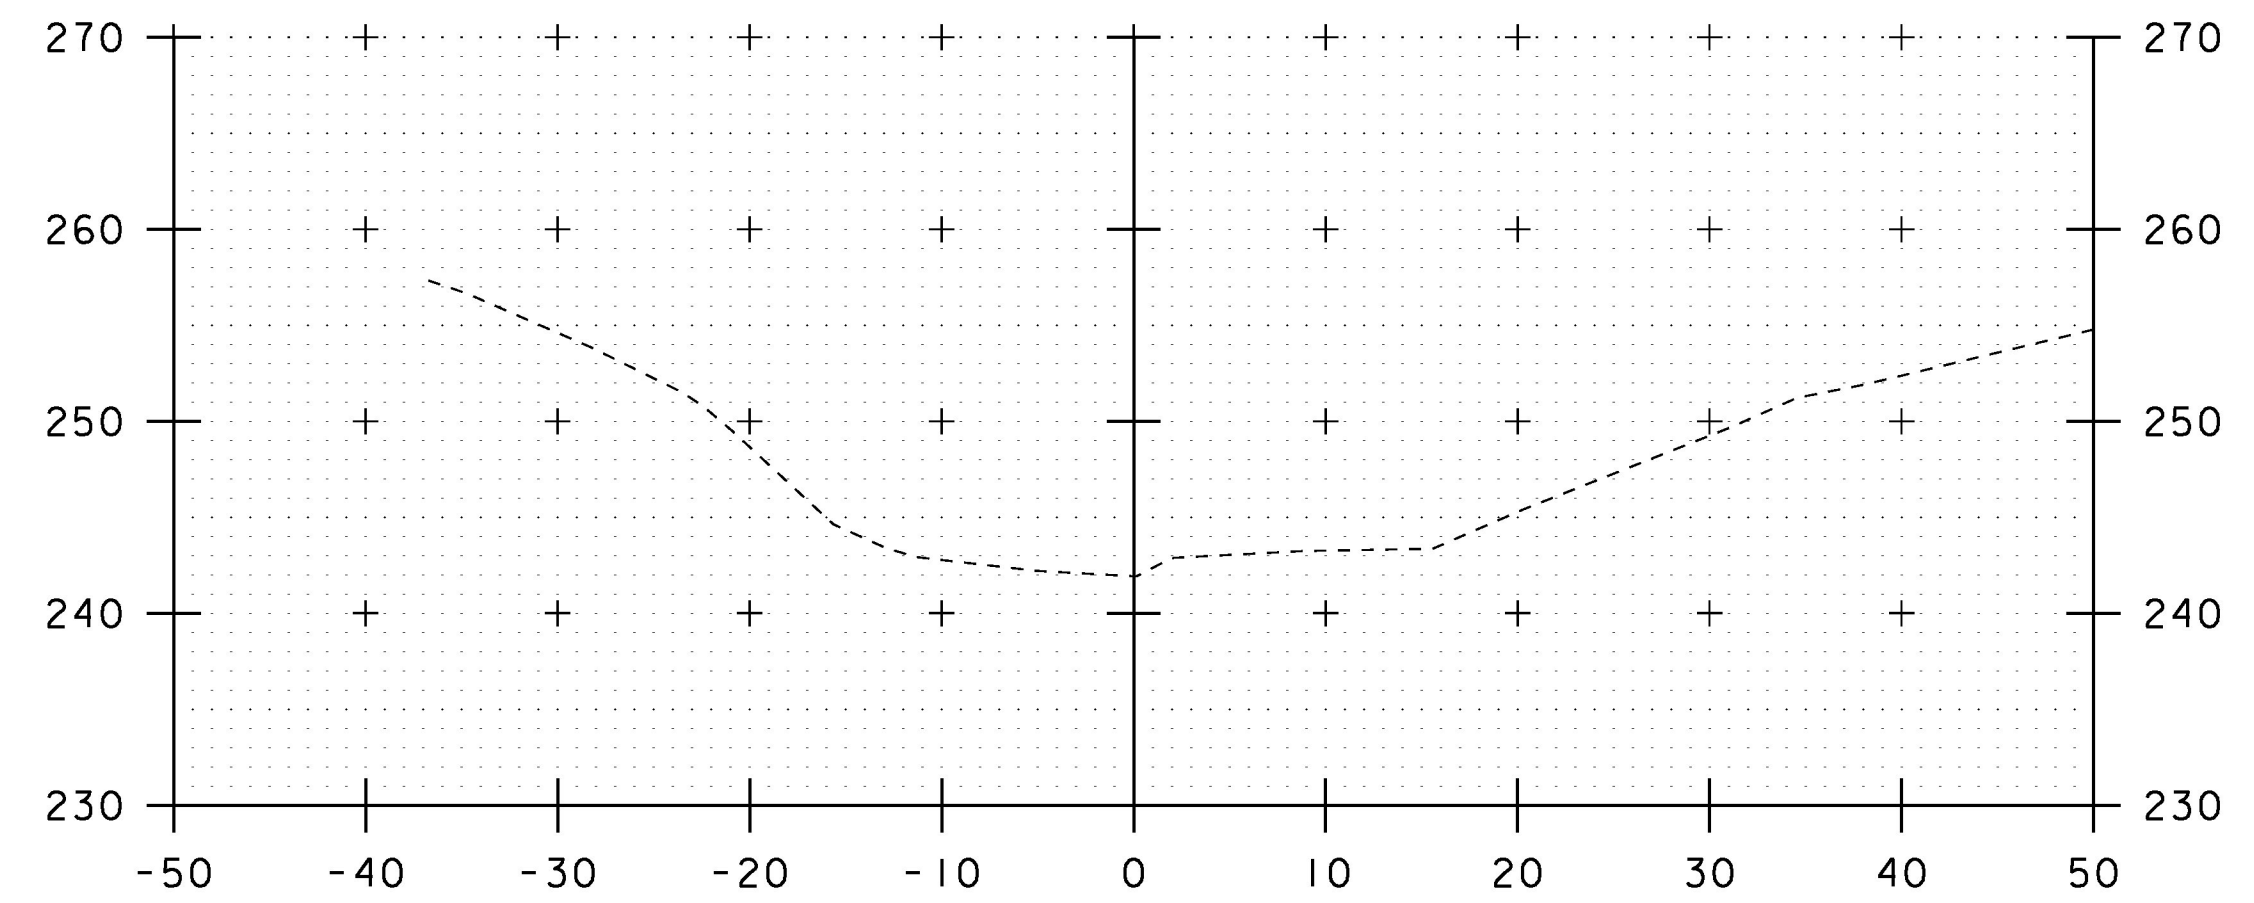


2+42


STA. 2+00 TO STA. 2+42

SCALE IN FEET


PROJECT NAME:	HIGHGATE
PROJECT NUMBER:	STP SCRPI(2)
FILE NAME:	d13ci34xs.dgn
PROJECT LEADER:	B. MARTIN
DESIGNED BY:	A. KEMPTON
SOUTH ACCESS RD CROSS SECTION SHEET 2	SHEET 33 OF 40
PLOT DATE:	14-OCT-2016
DRAWN BY:	A. KEMPTON
CHECKED BY:	M. GAMELIN

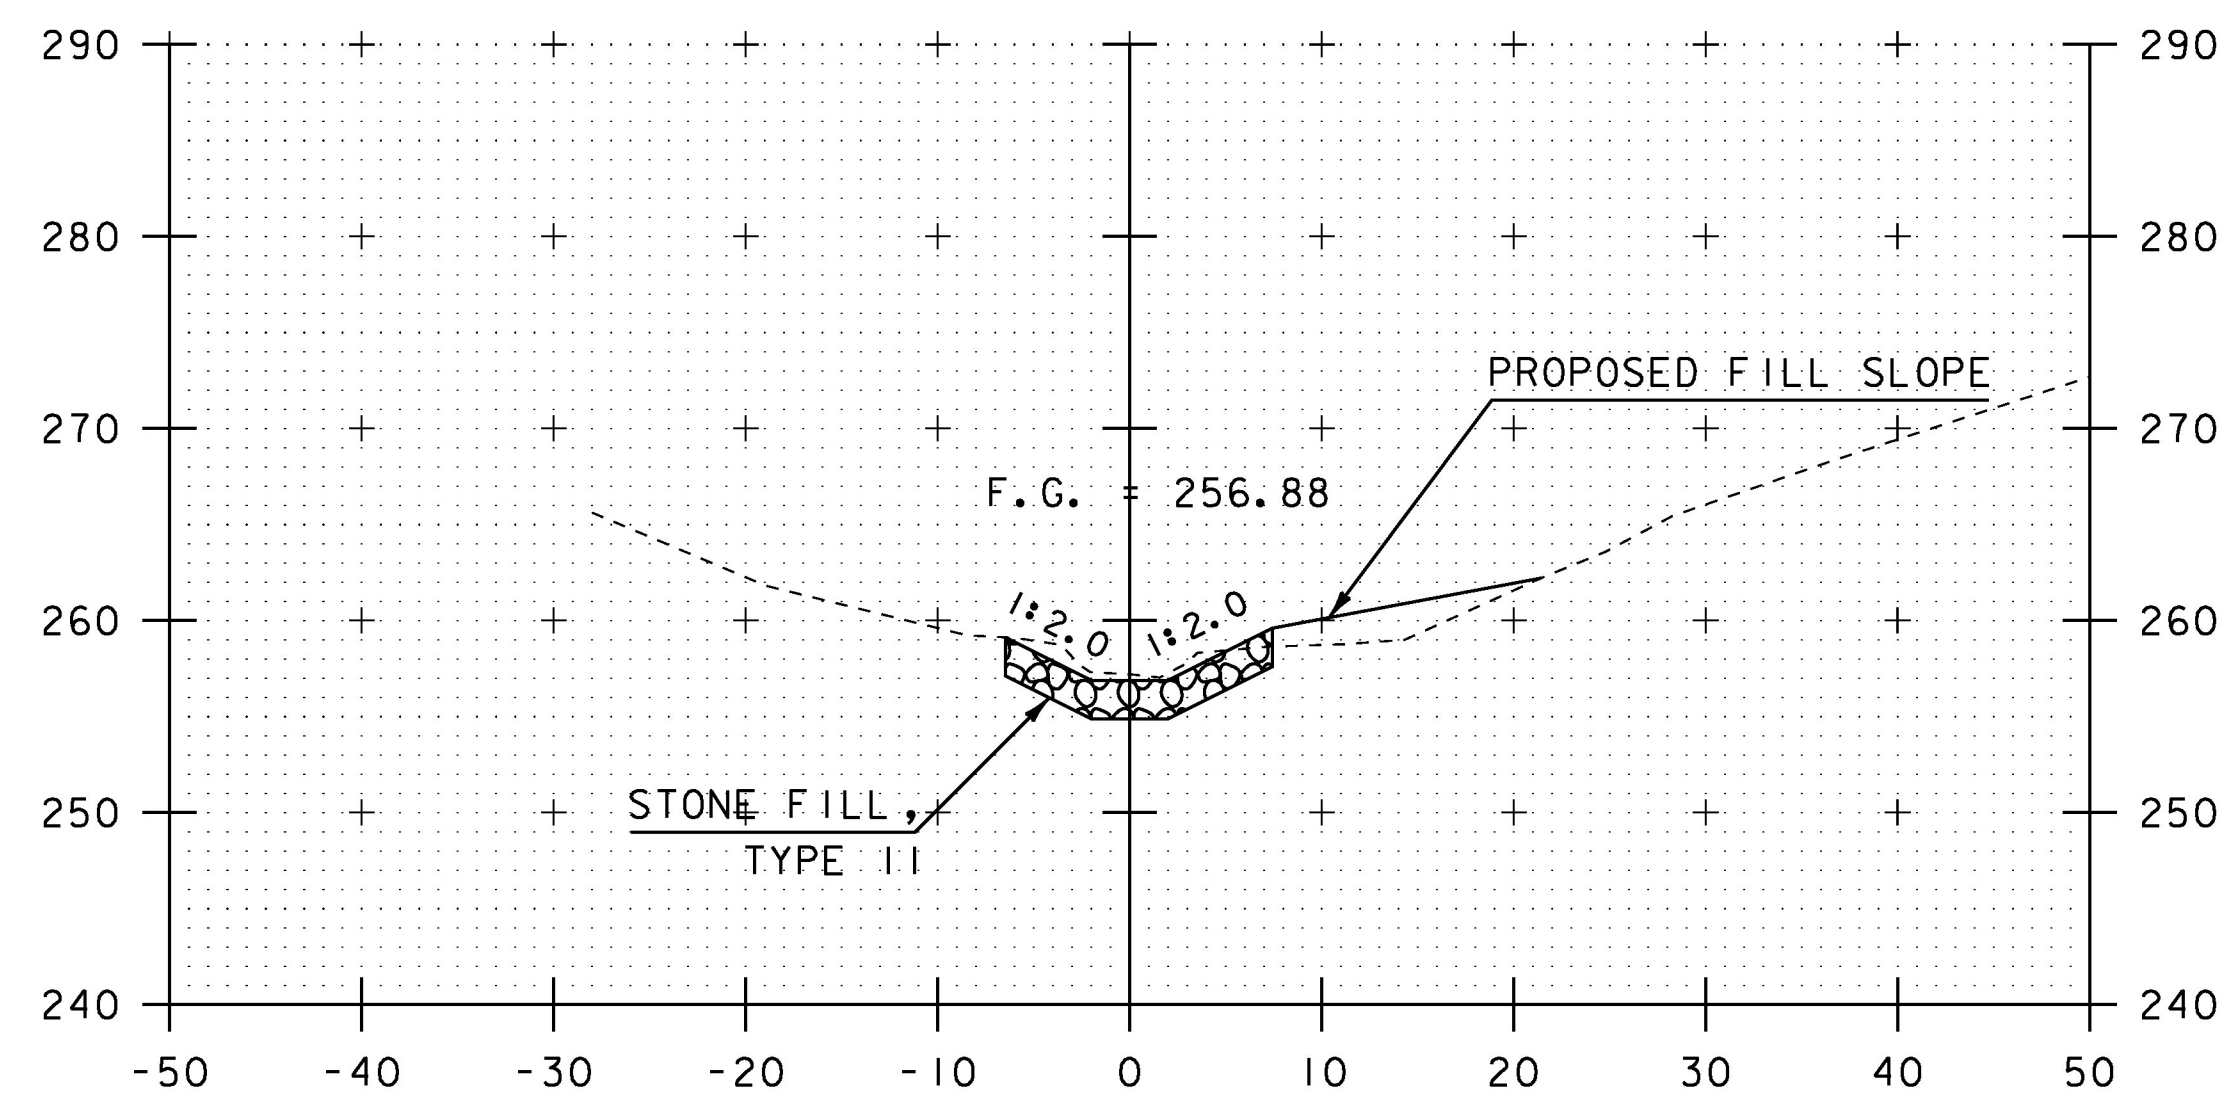


9+20

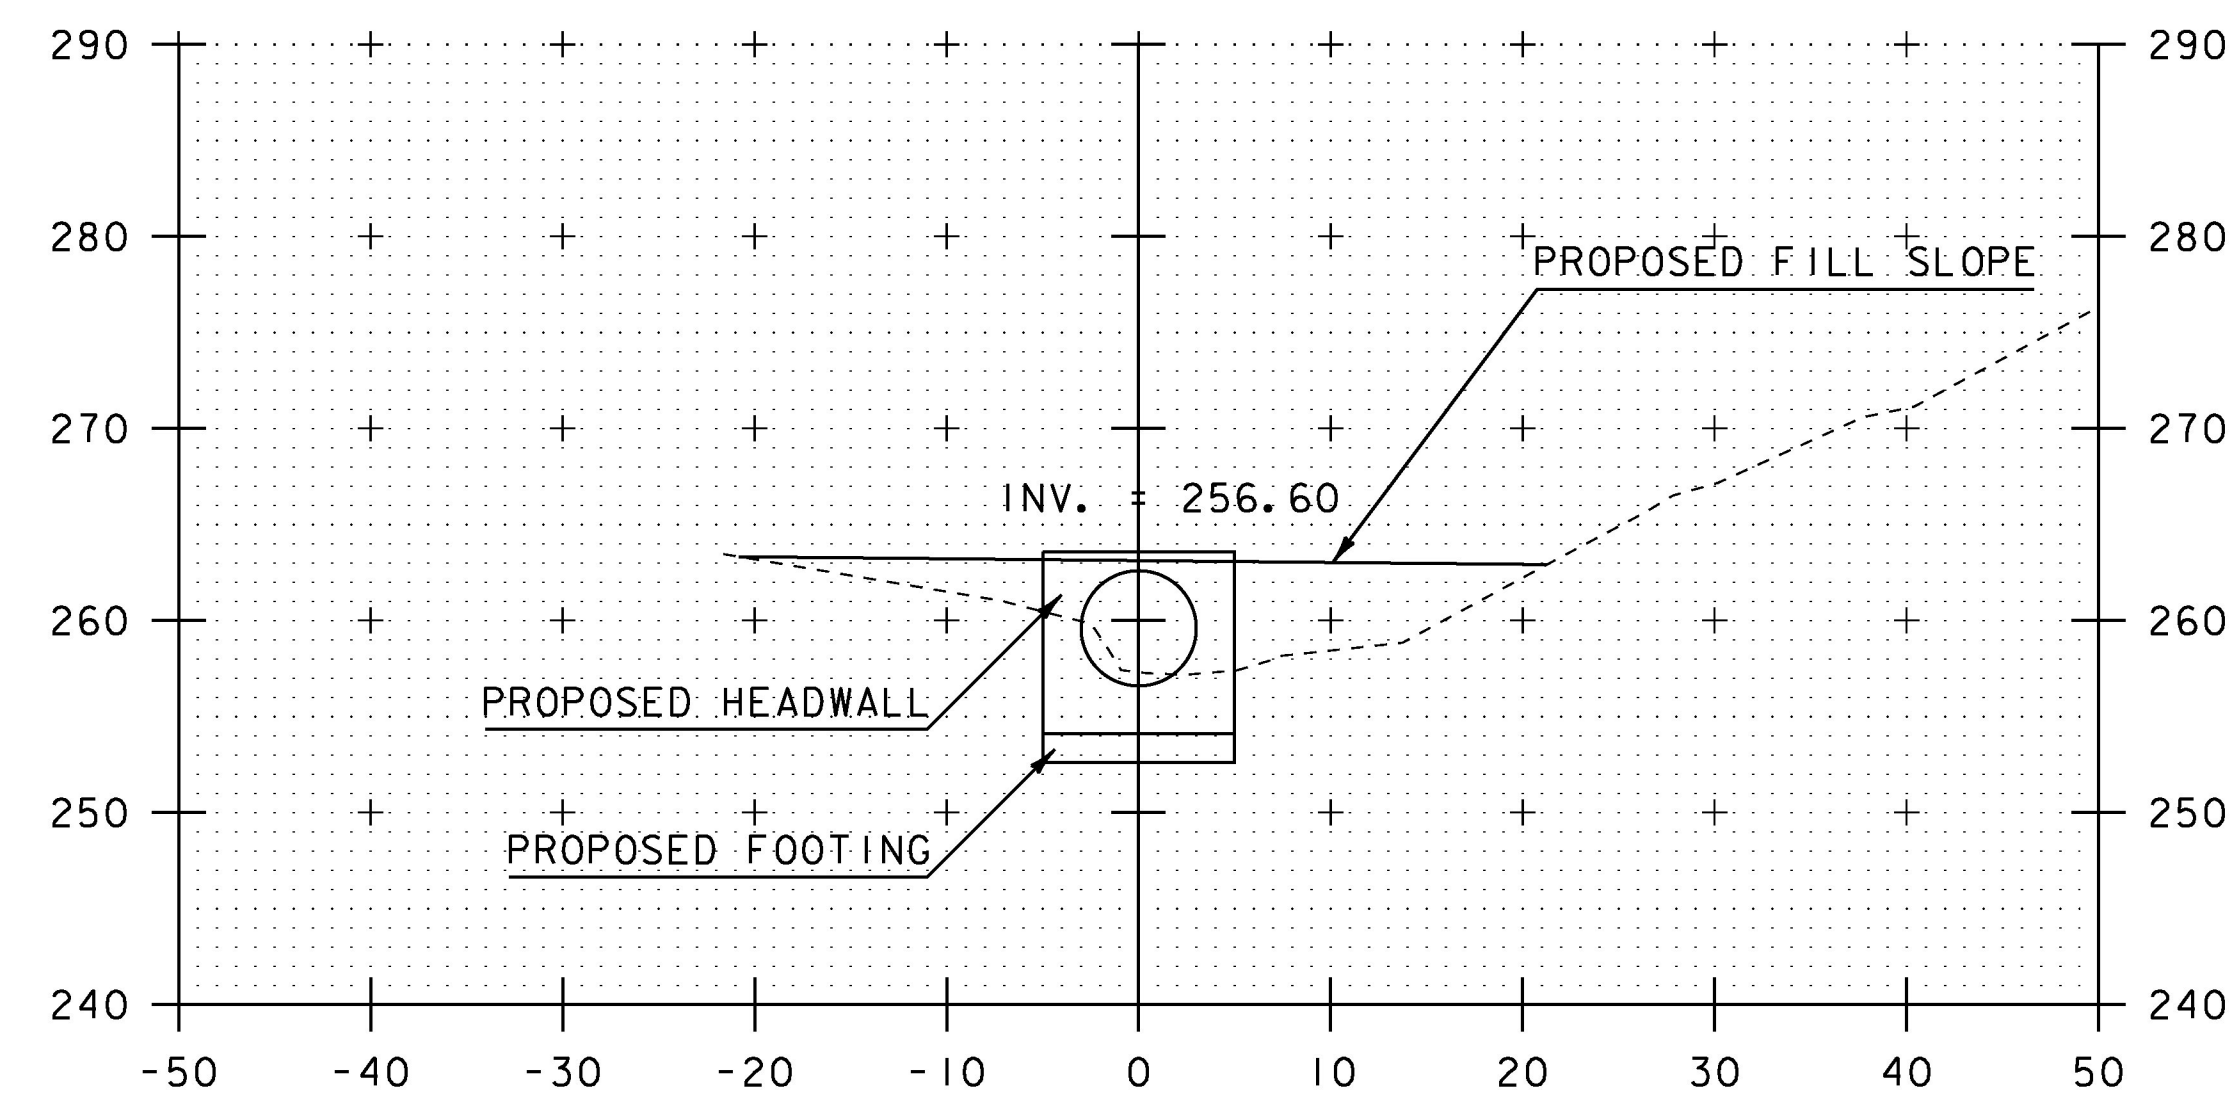

9+34.21  
BEGIN CULVERT  
(BR 10)

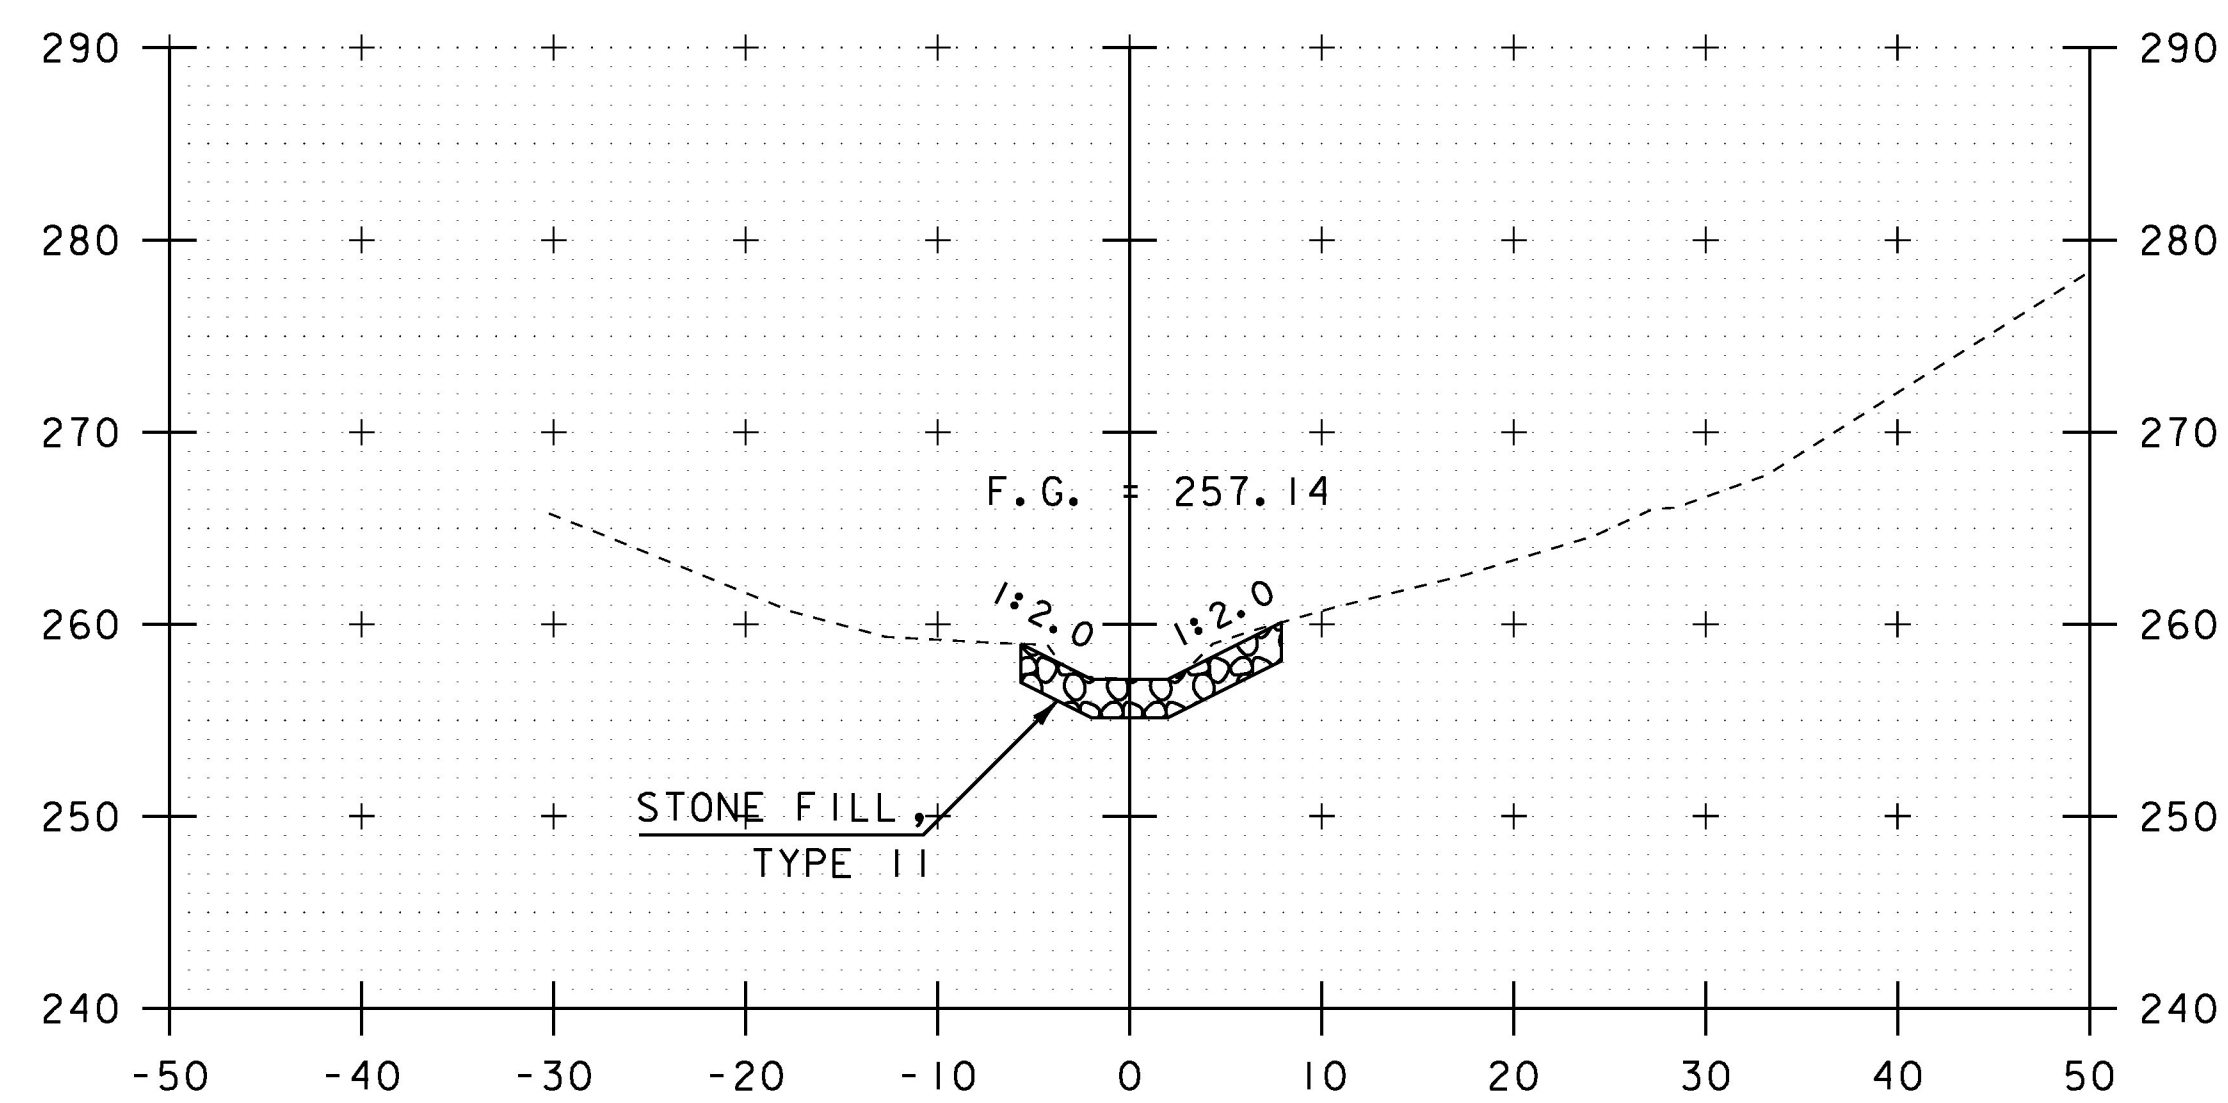

9+07  
BEGIN CHANNEL WORK

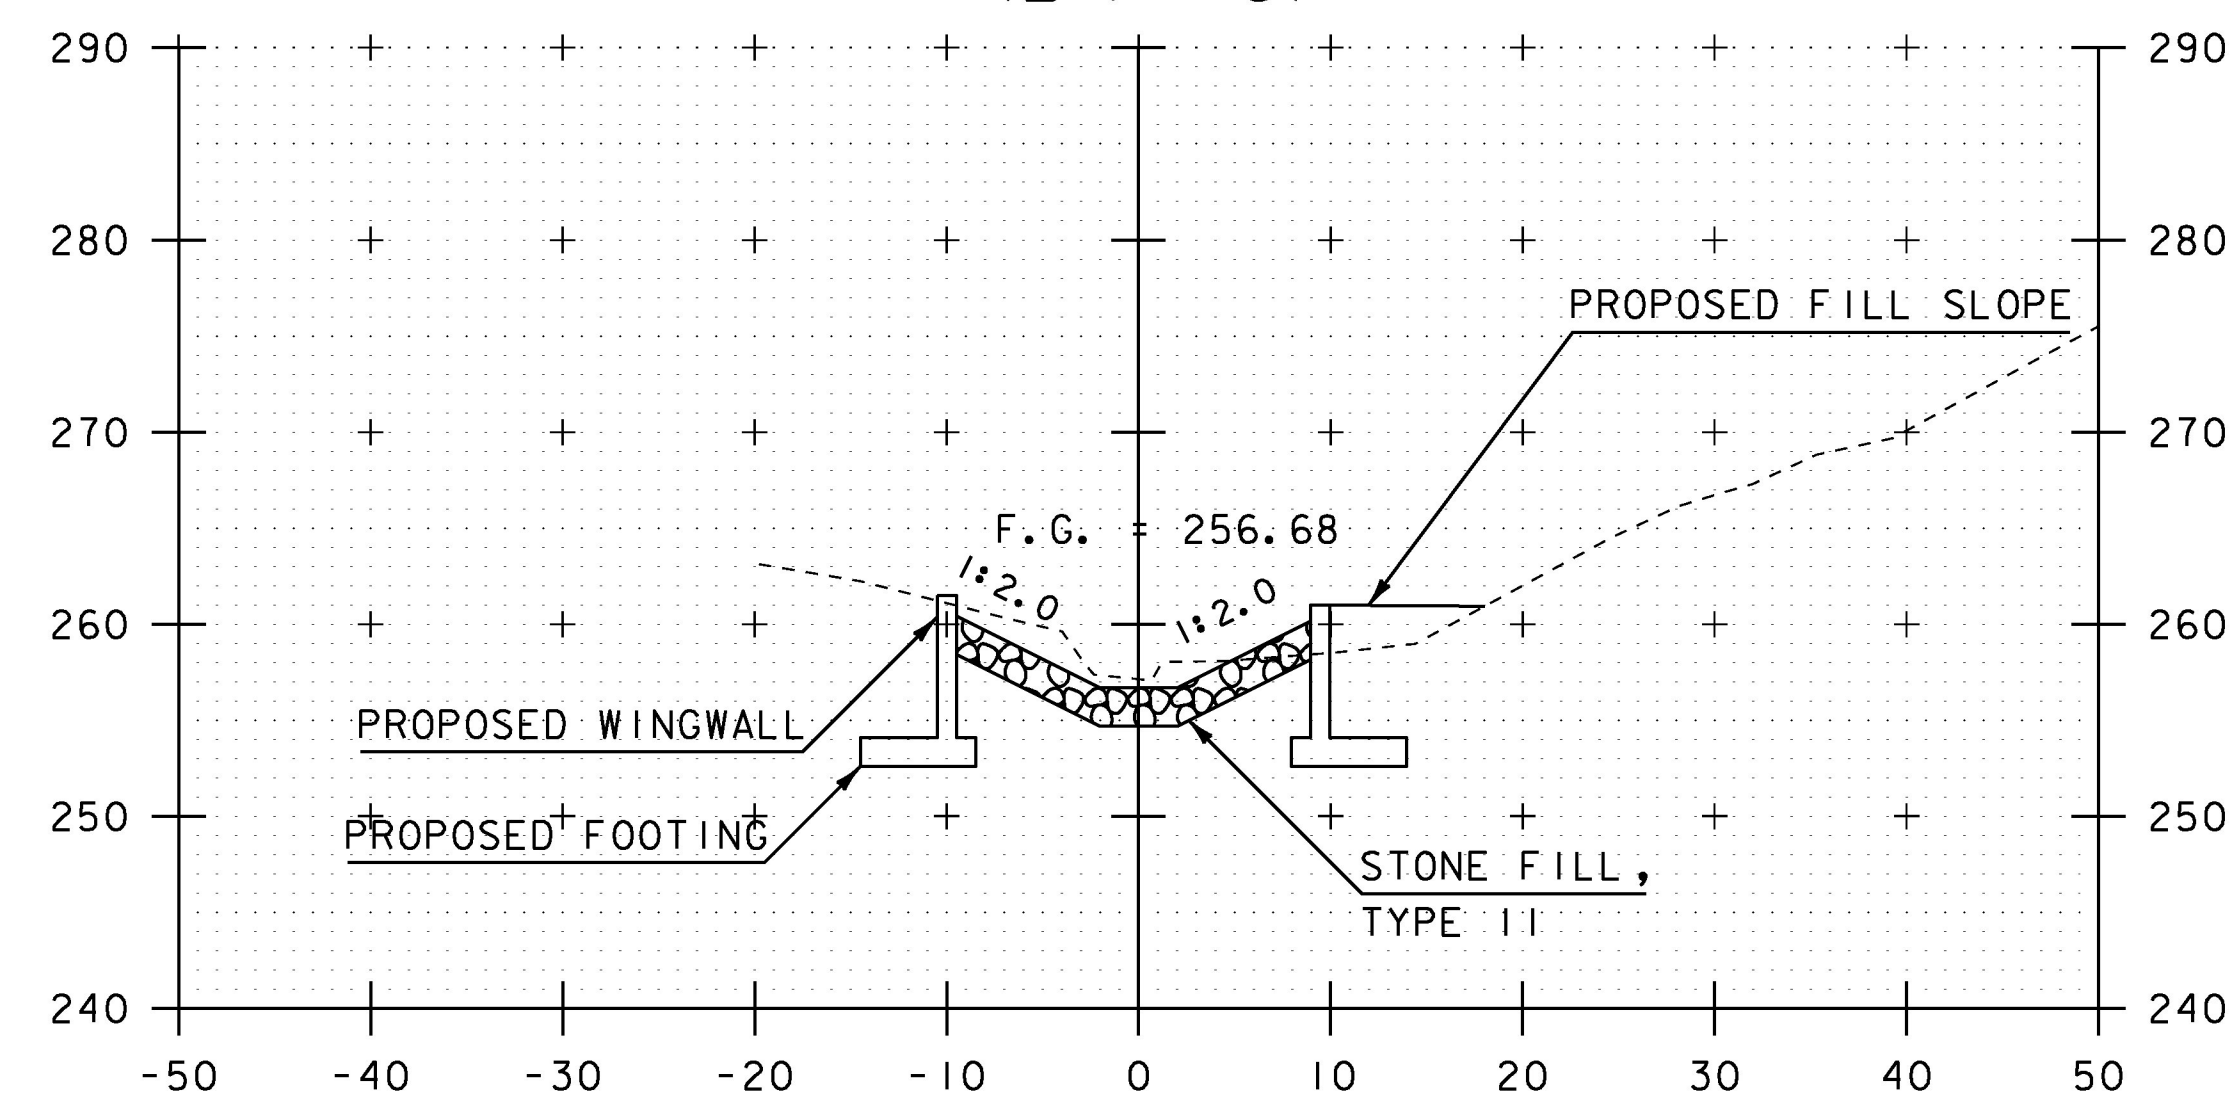


9+30


SCALE IN FEET

PROJECT NAME:	HIGHGATE
PROJECT NUMBER:	STP SCRPI(2)
FILE NAME:	d13ci34xs.dgn
PROJECT LEADER:	B. MARTIN
DESIGNED BY:	A. KEMPTON
CHECKED BY:	M. GAMELIN
PLOT DATE:	14-OCT-2016
DRAWN BY:	A. KEMPTON
CHECKED BY:	M. GAMELIN
CHANNEL CROSS SECTION SHEET 1	SHEET 34 OF 40


STA. 9+07 TO STA. 9+34

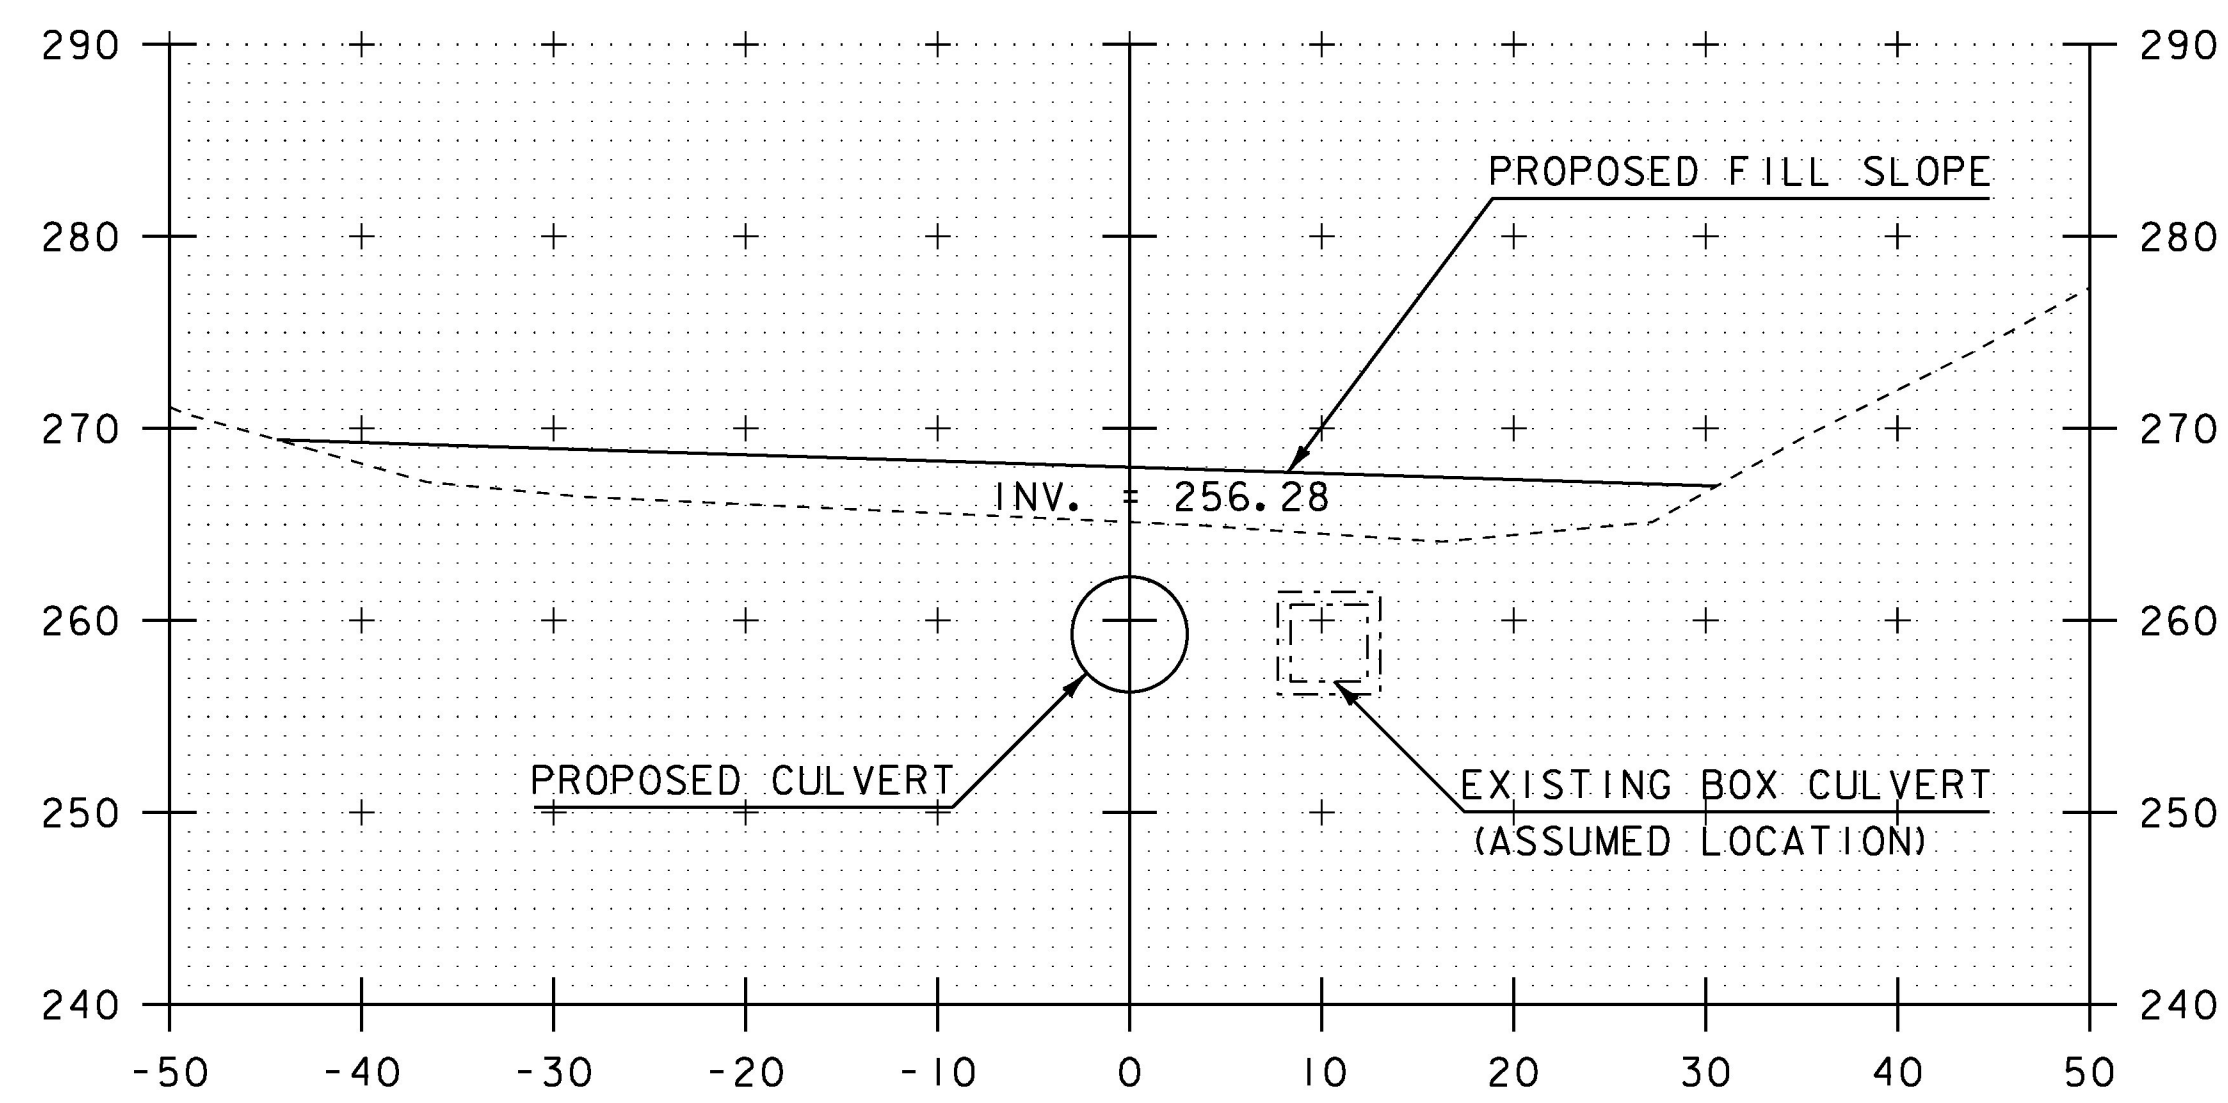


9+50

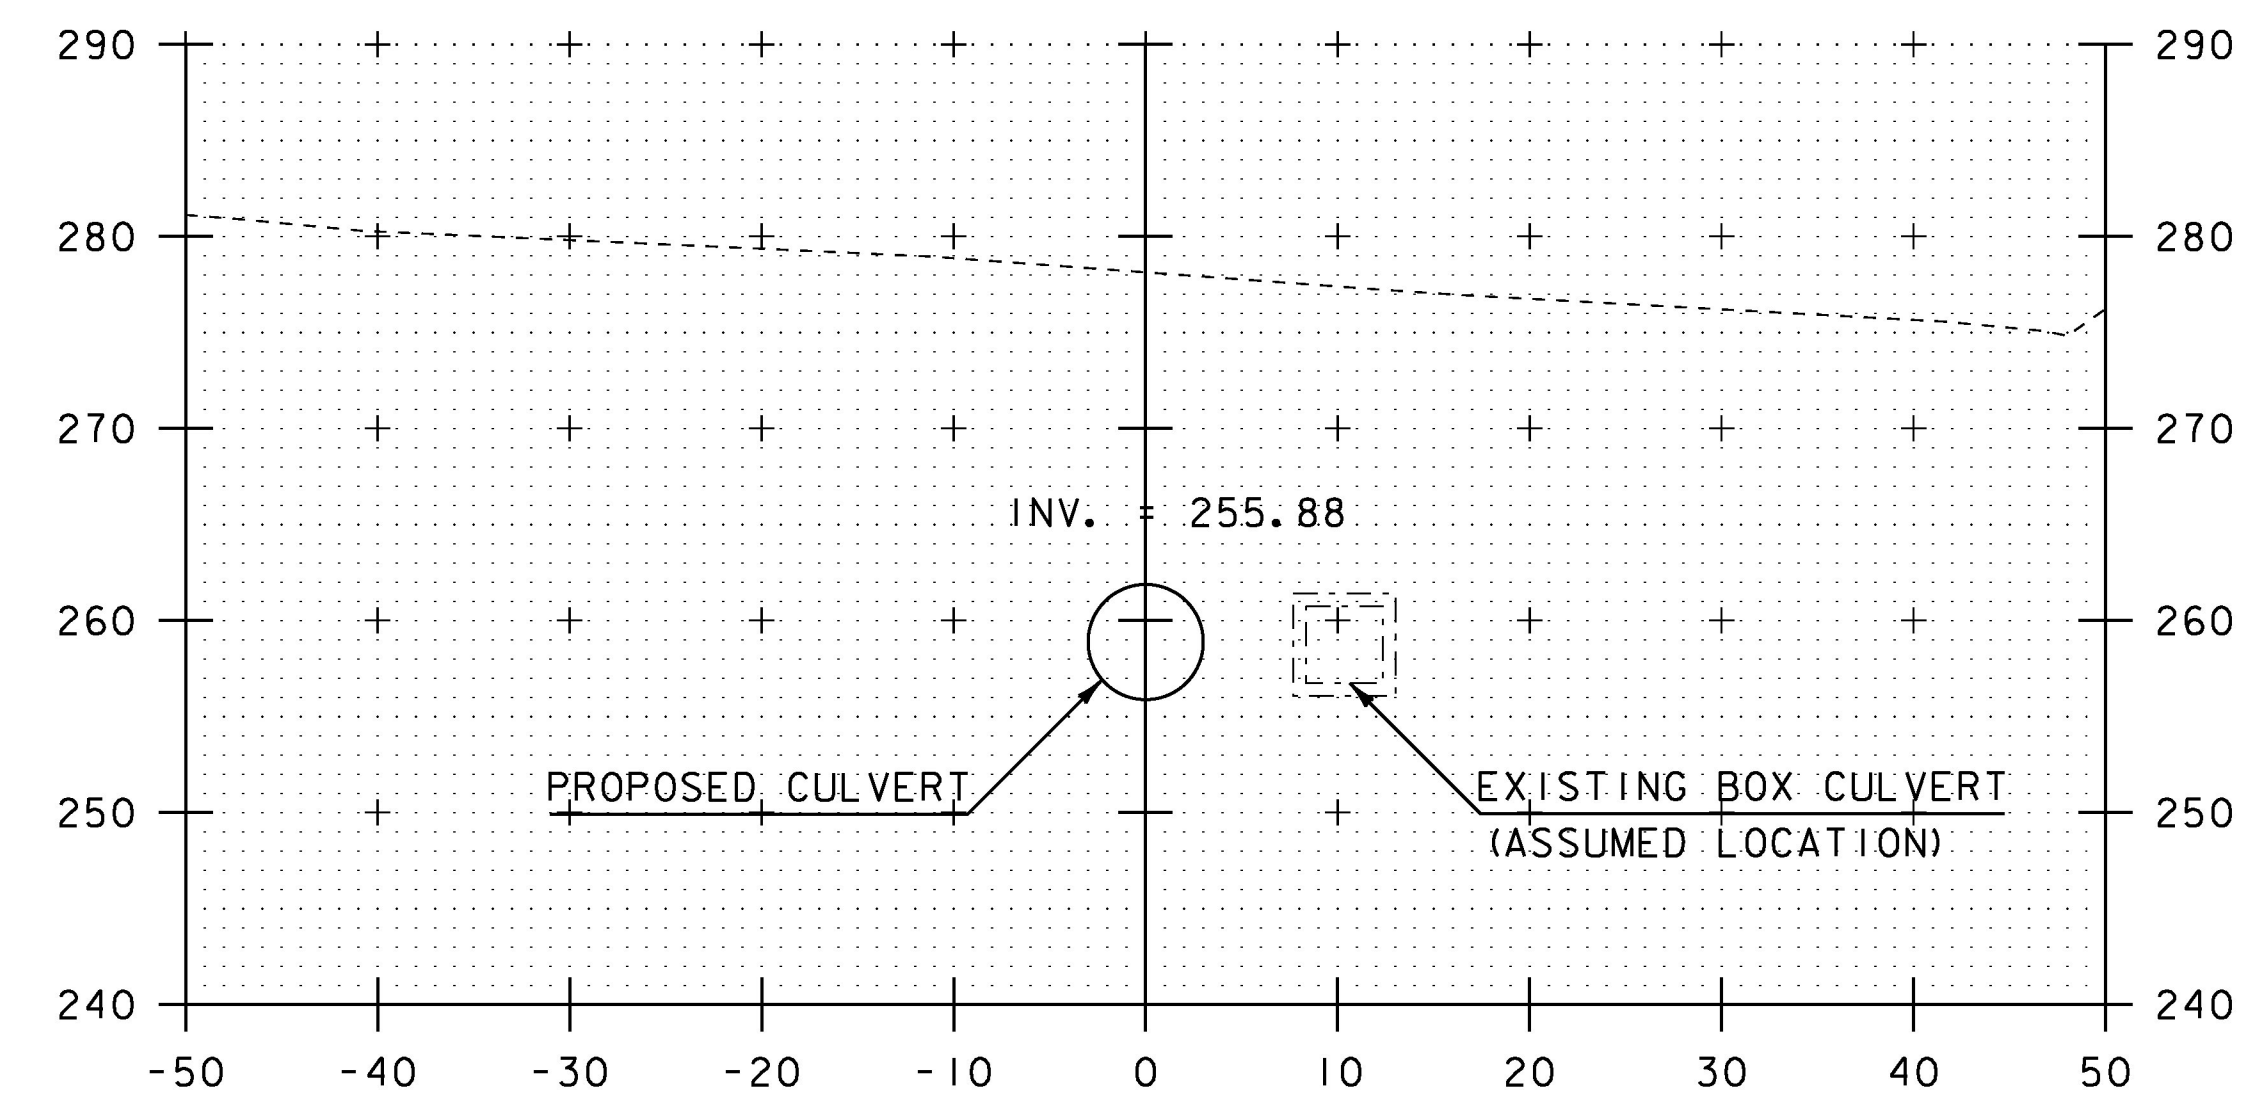

9+70

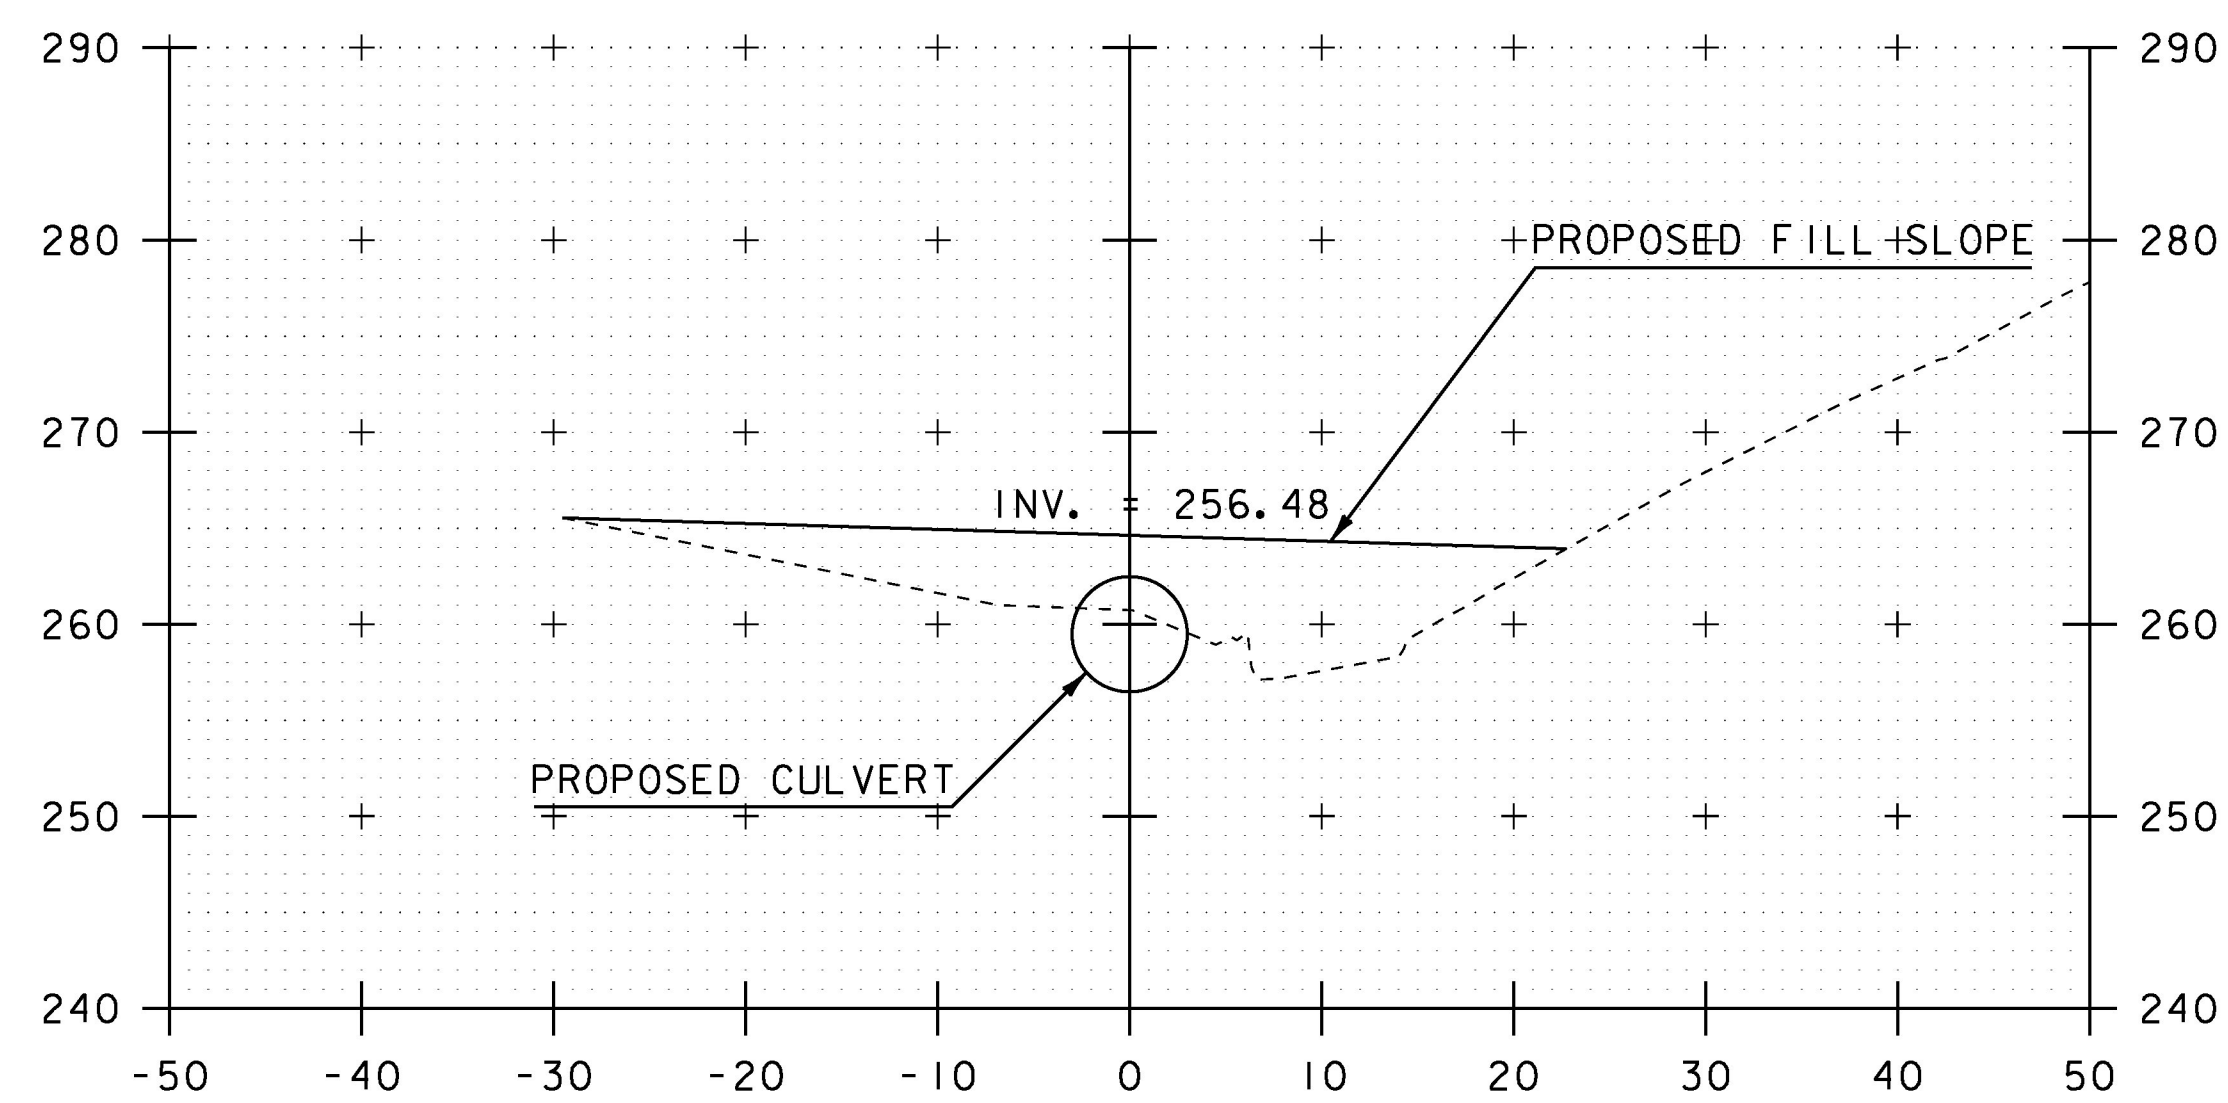

9+40

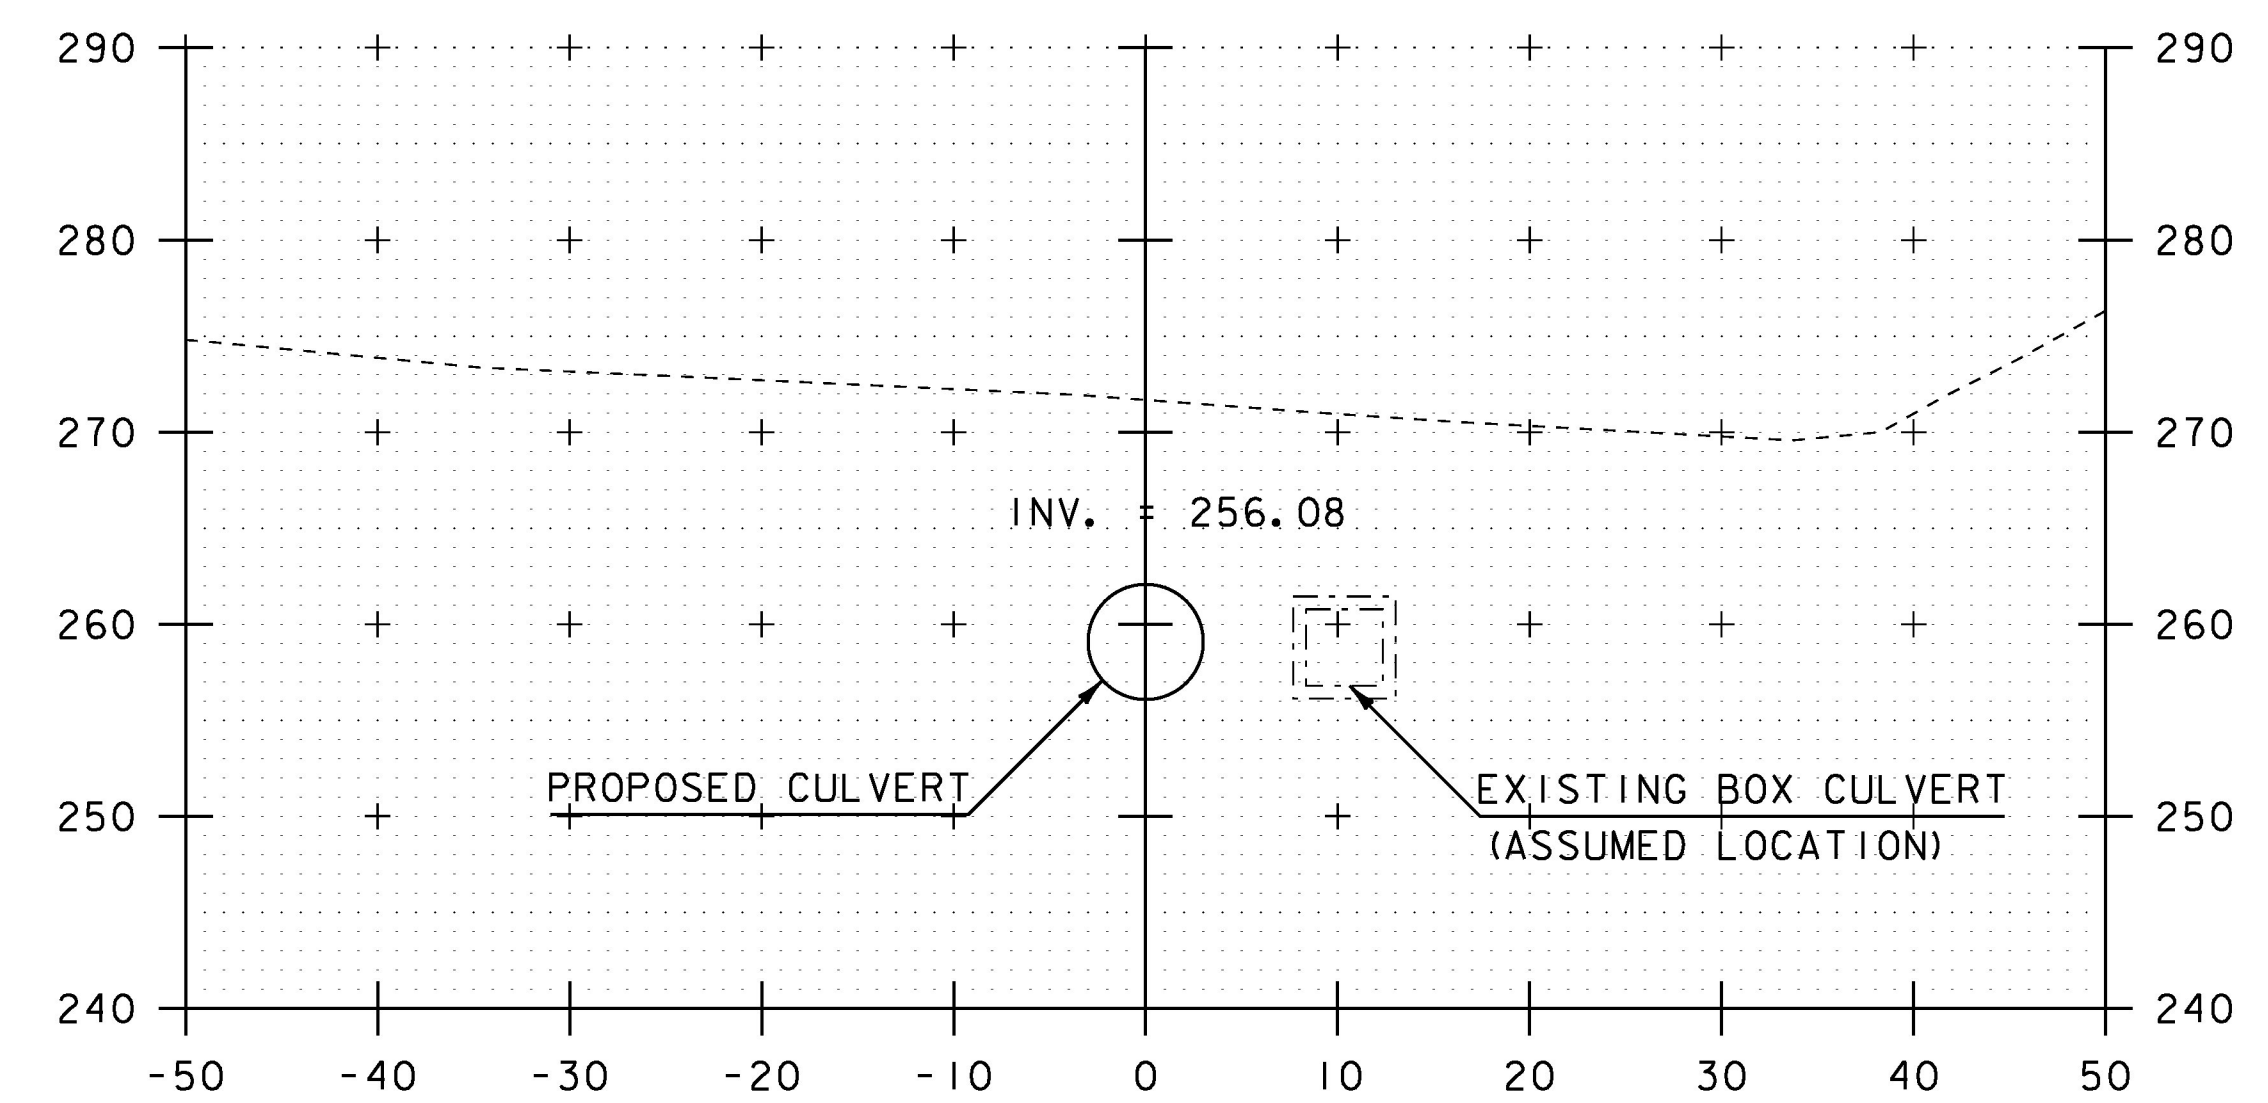


9+60


SCALE IN FEET

PROJECT NAME:	HIGHGATE
PROJECT NUMBER:	STP SCRPI(2)
FILE NAME:	d13ci34xs.dgn
PROJECT LEADER:	B. MARTIN
DESIGNED BY:	A. KEMPTON
CHANNEL CROSS SECTION SHEET 2	
PLOT DATE:	14-OCT-2016
DRAWN BY:	A. KEMPTON
CHECKED BY:	M. GAMELIN
SHEET	35 OF 40


STA. 9+40 TO STA. 9+70

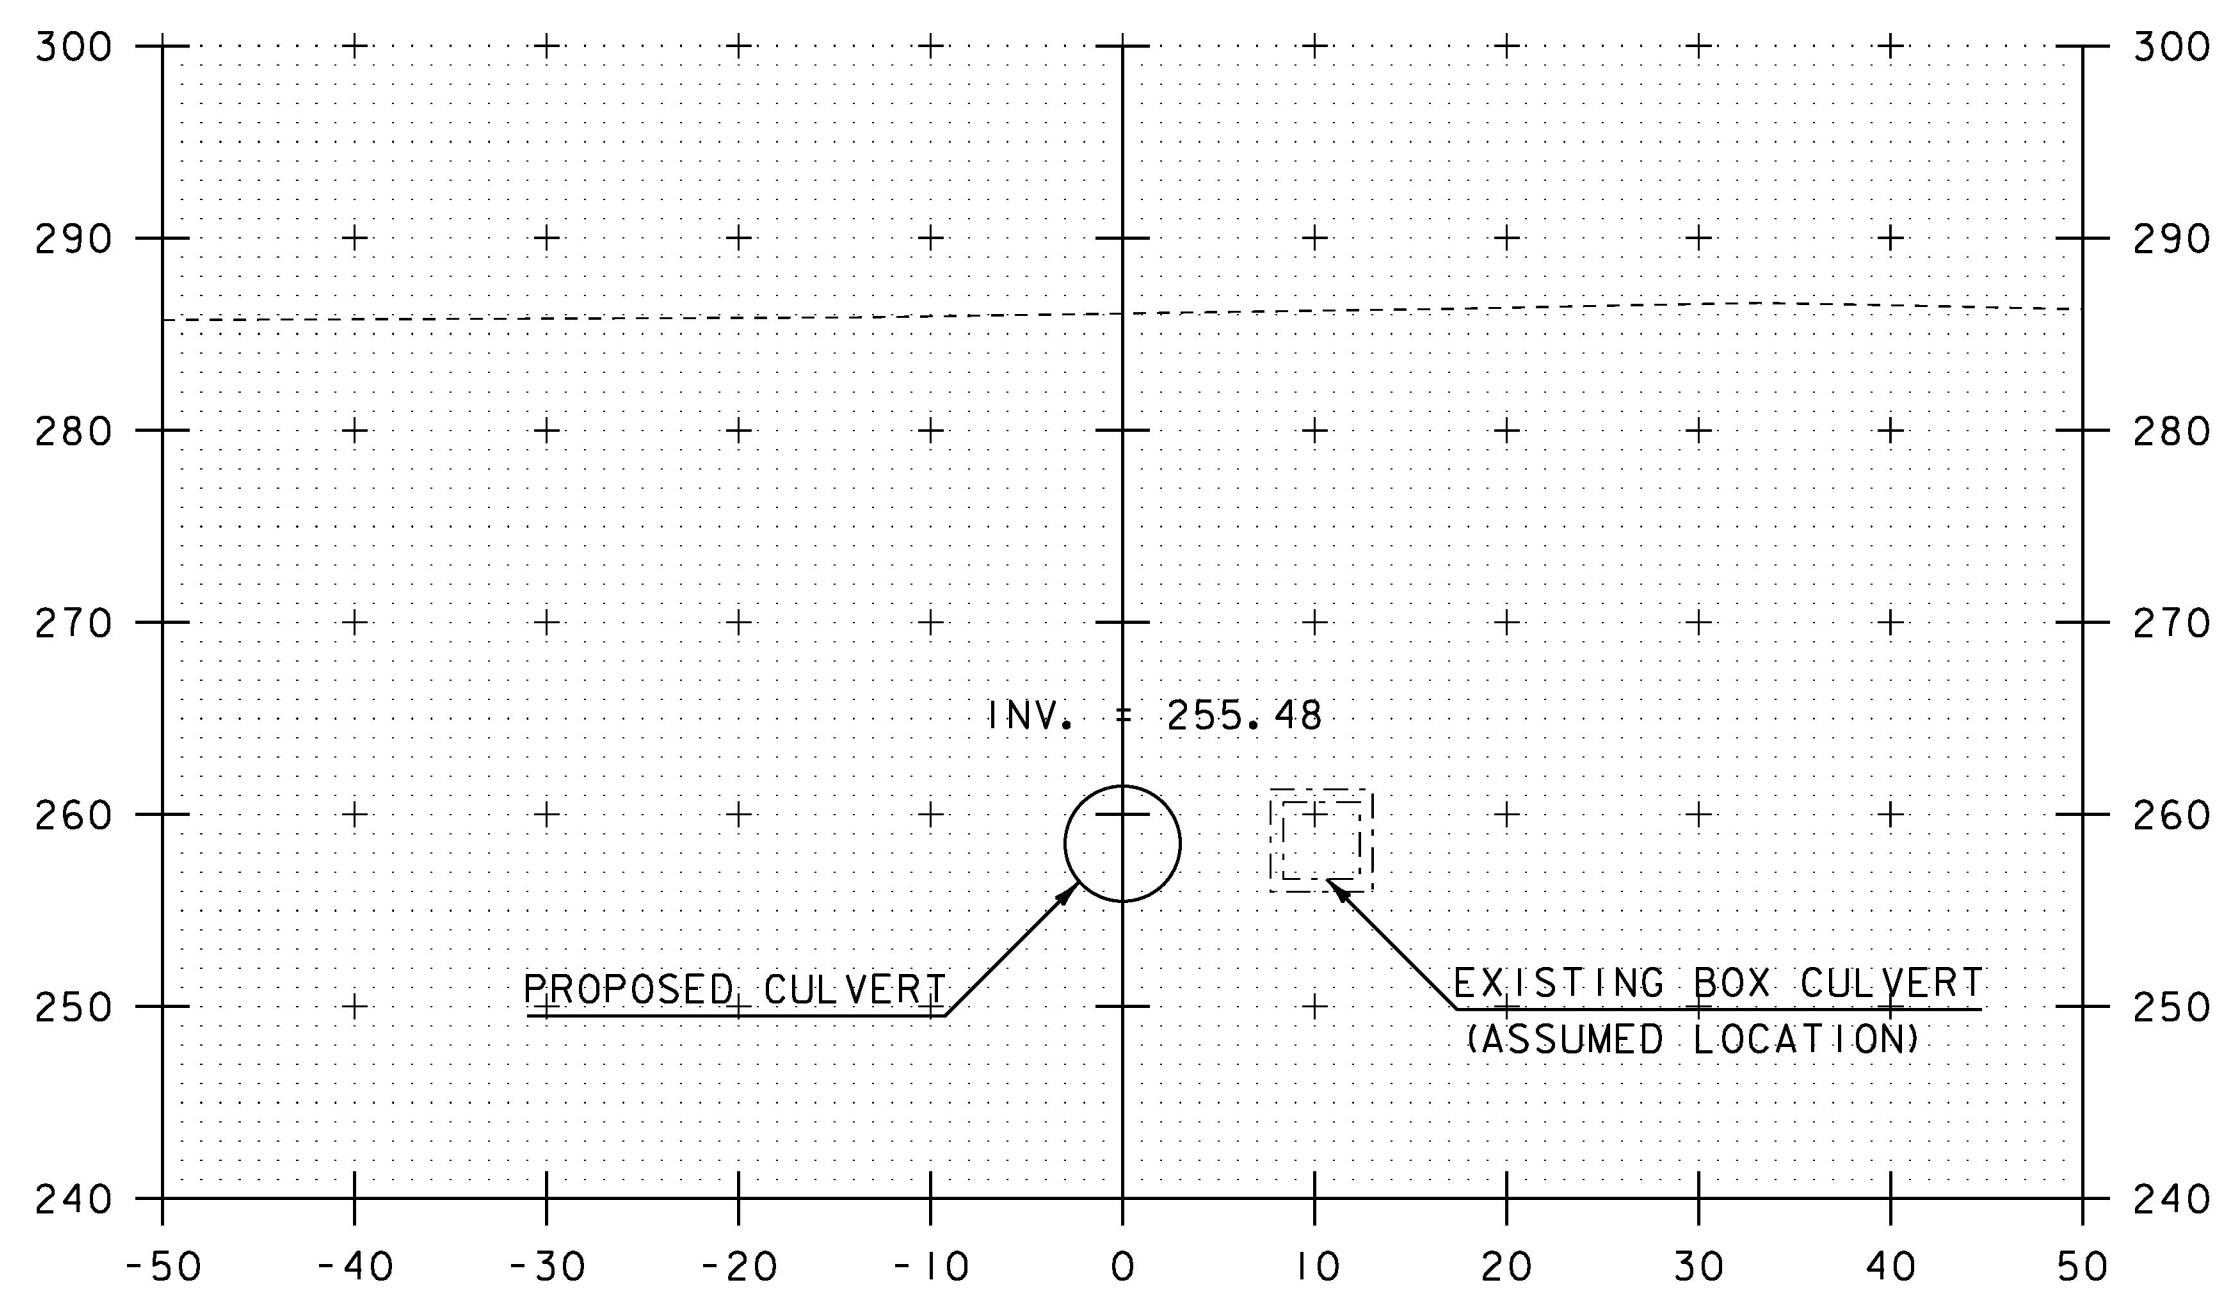


9+90

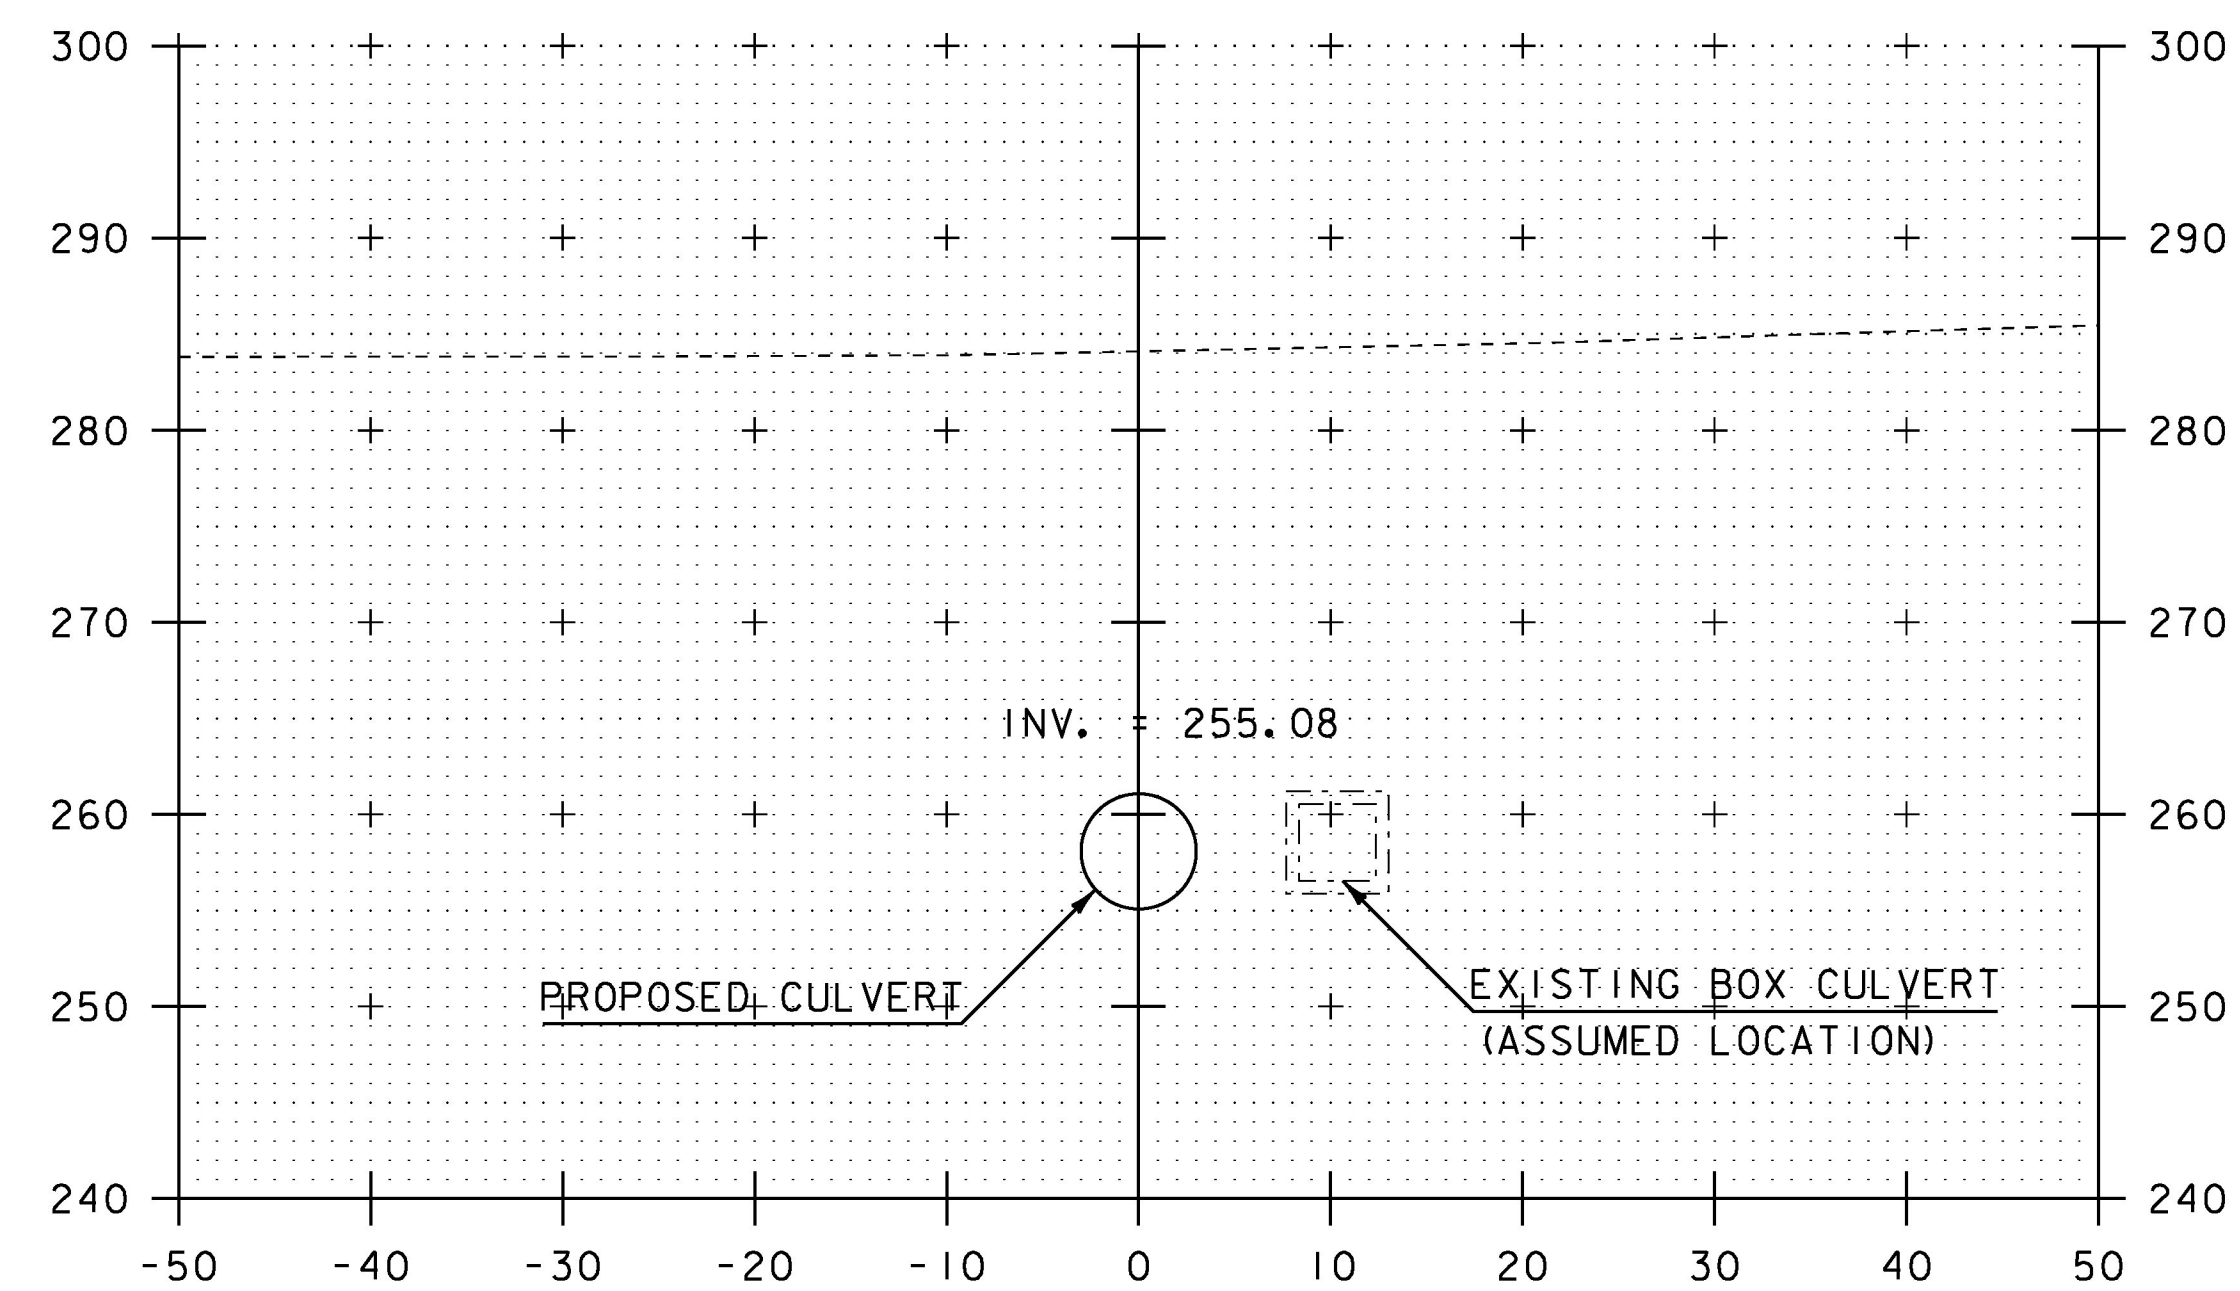

10+10

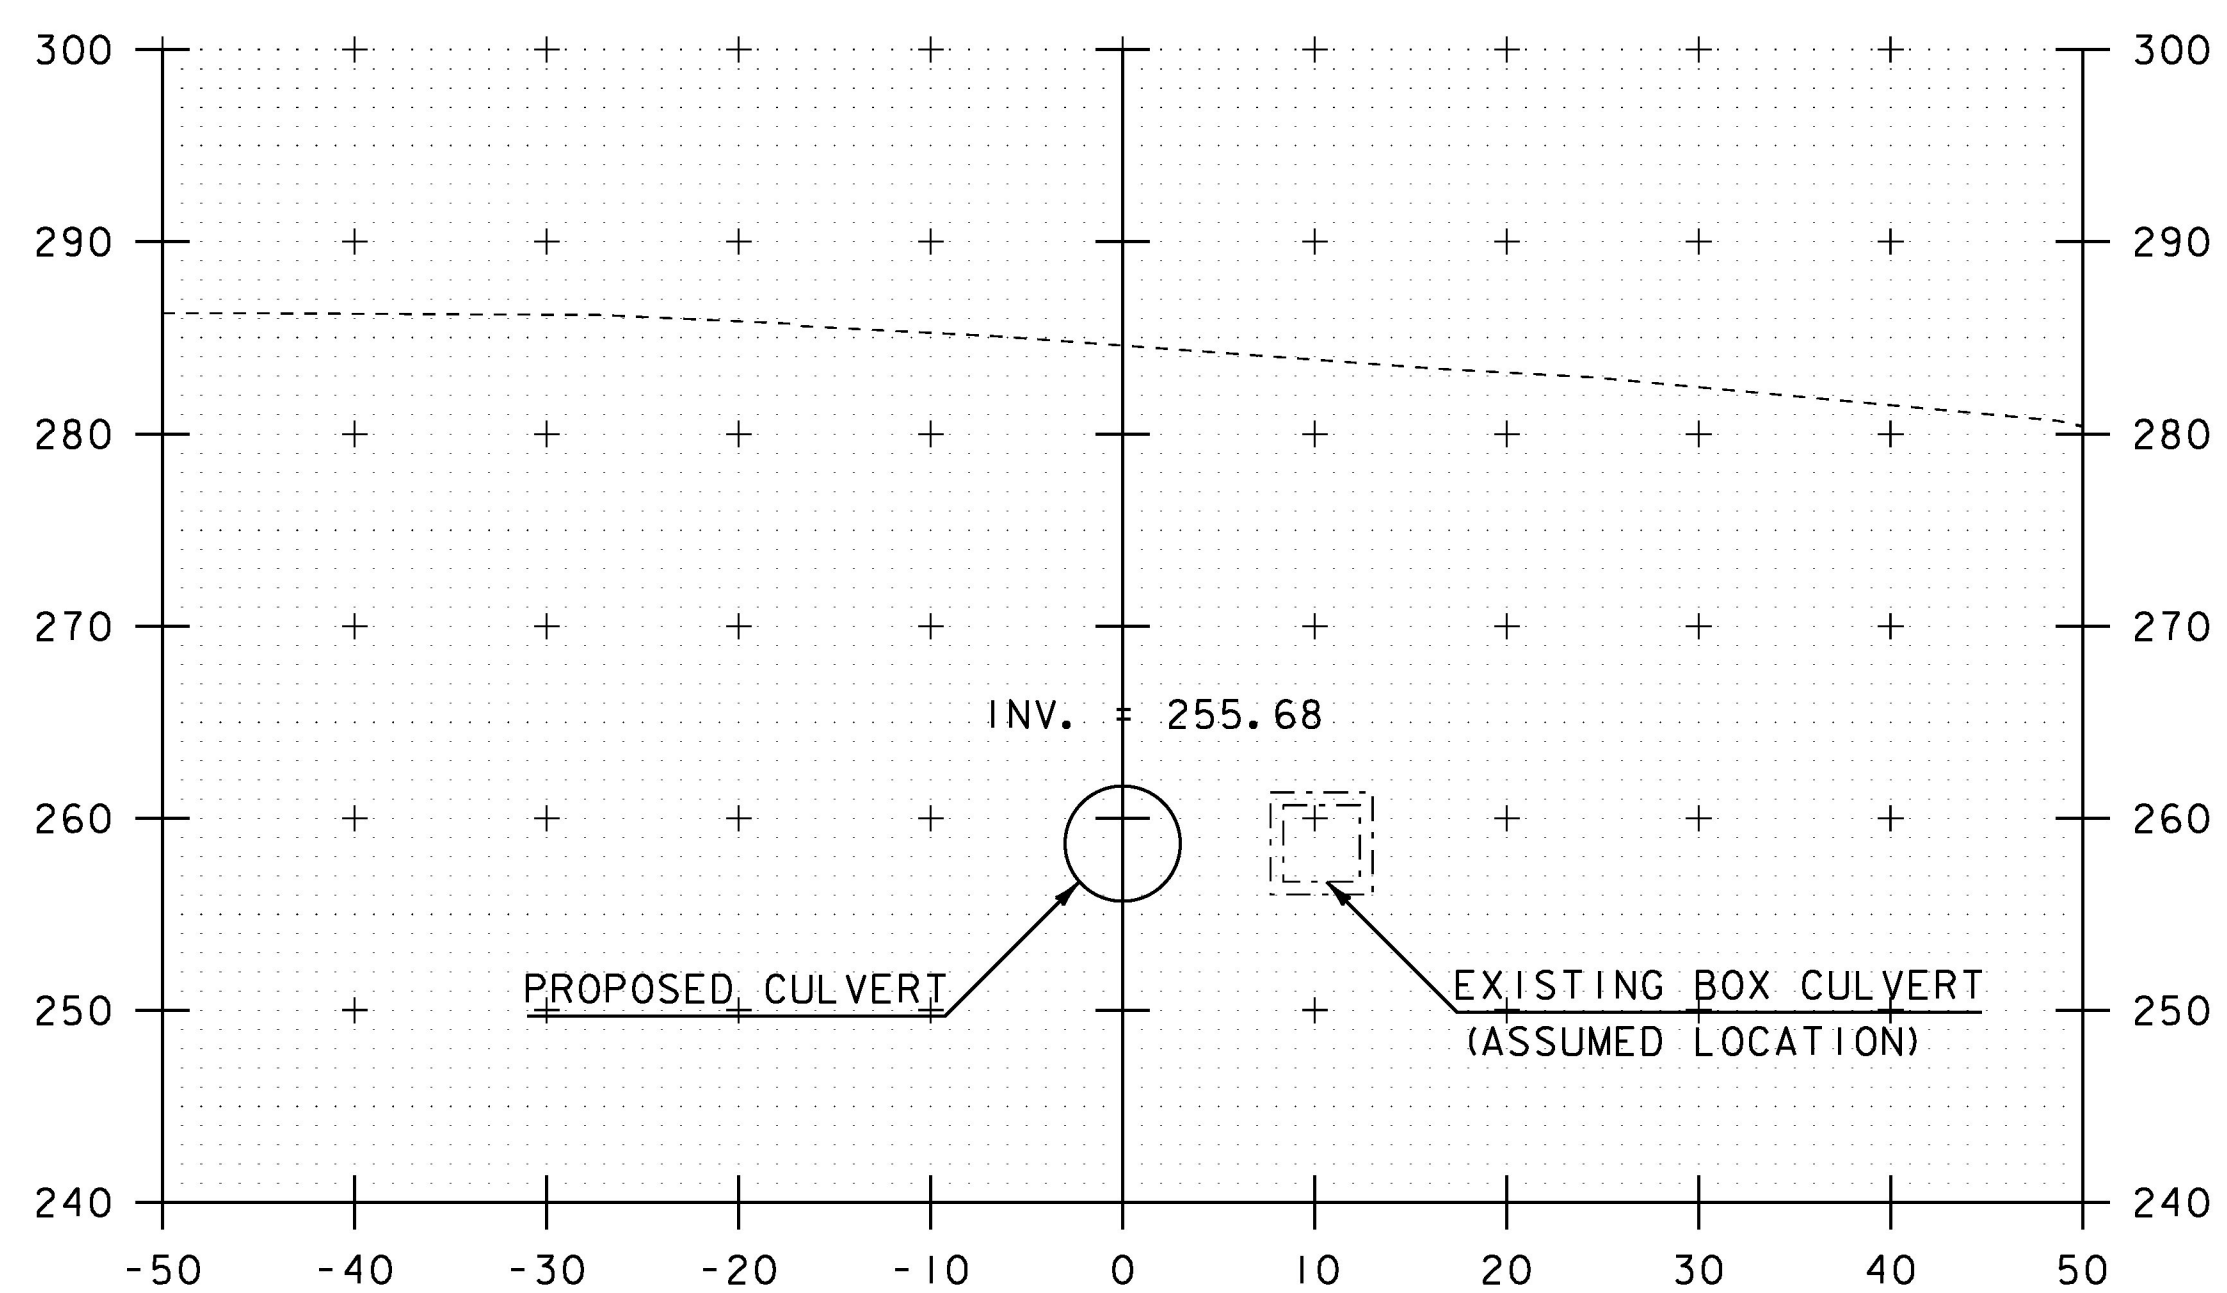

9+80

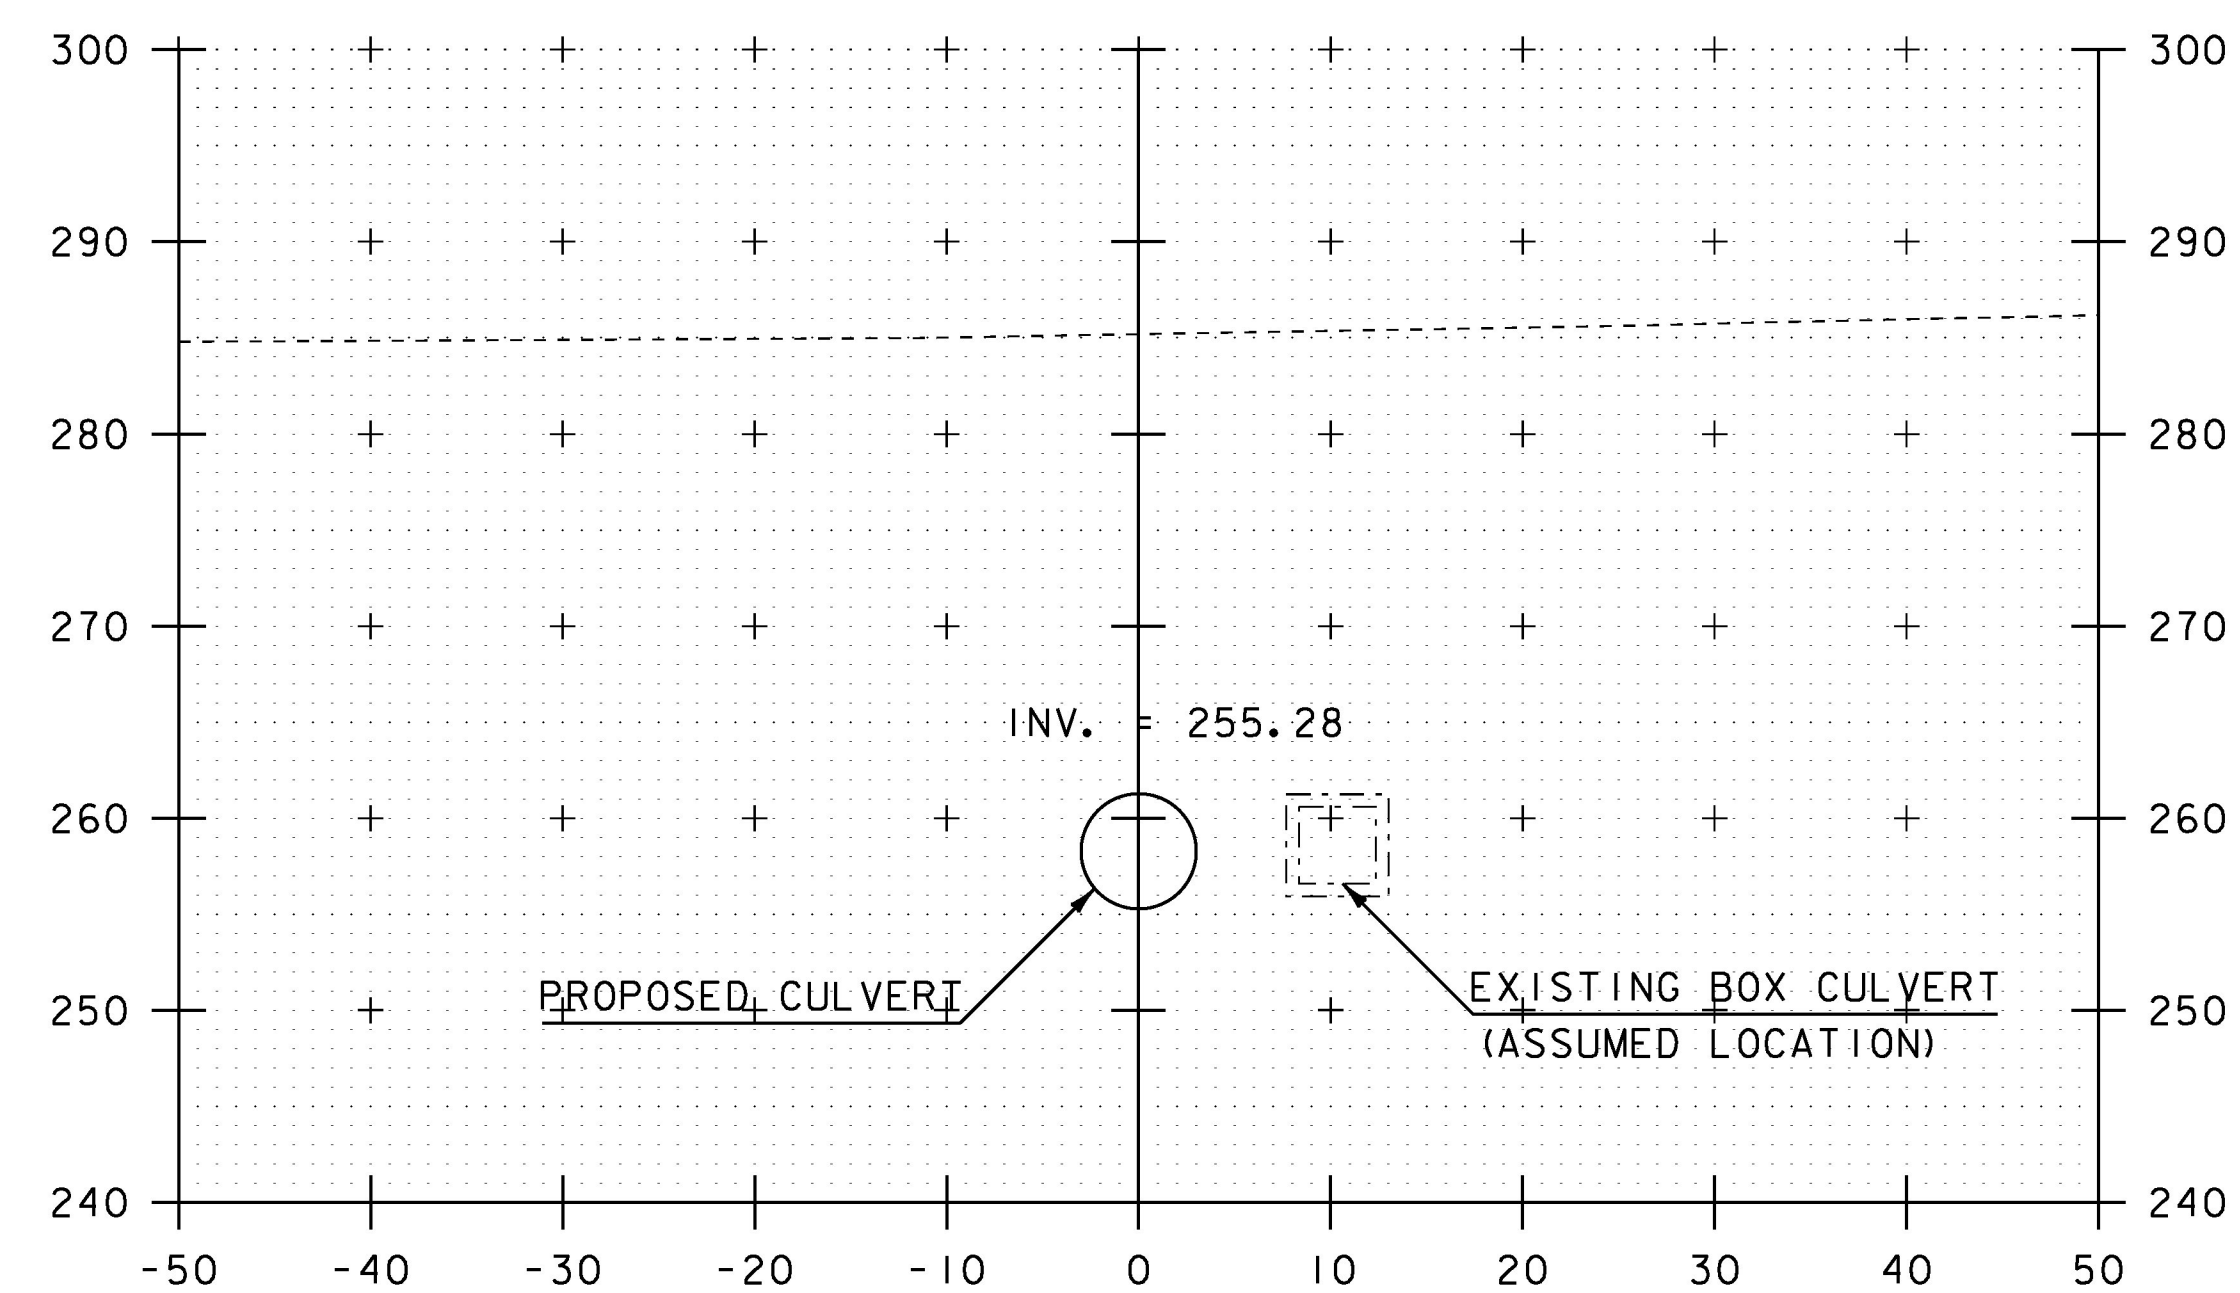


10+00


SCALE IN FEET

PROJECT NAME:	HIGHGATE
PROJECT NUMBER:	STP SCRPI(2)
FILE NAME:	d13ci34xs.dgn
PROJECT LEADER:	B. MARTIN
DESIGNED BY:	A. KEMPTON
CHANNEL CROSS SECTION SHEET 3	
PLOT DATE:	14-OCT-2016
DRAWN BY:	A. KEMPTON
CHECKED BY:	M. GAMELIN
SHEET	36 OF 40


STA. 9+80 TO STA. 10+10

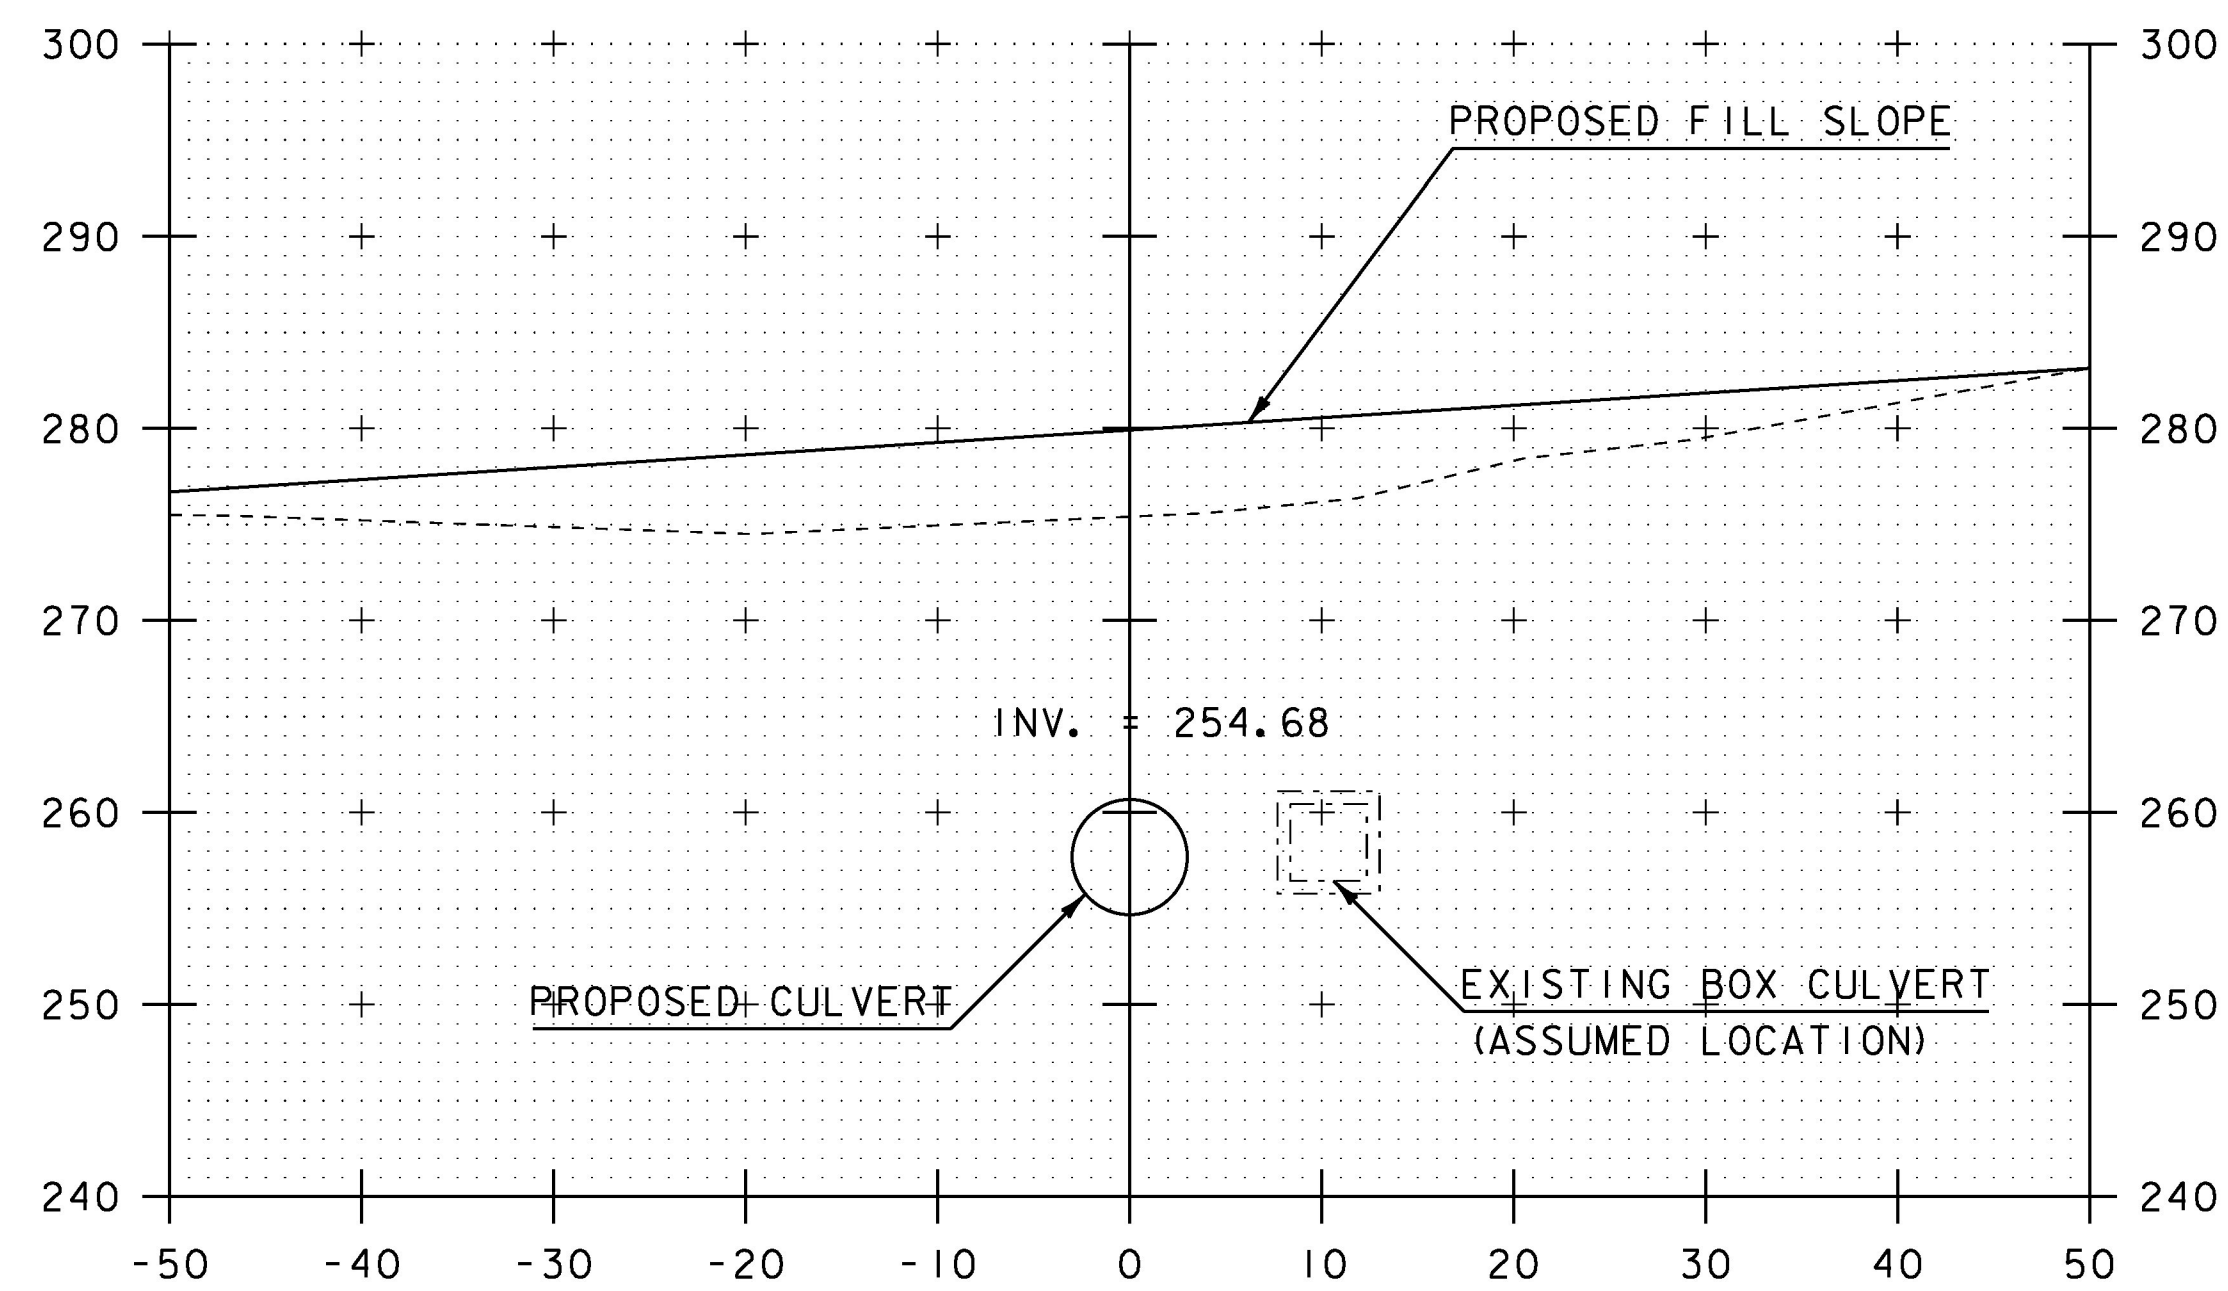


10+30

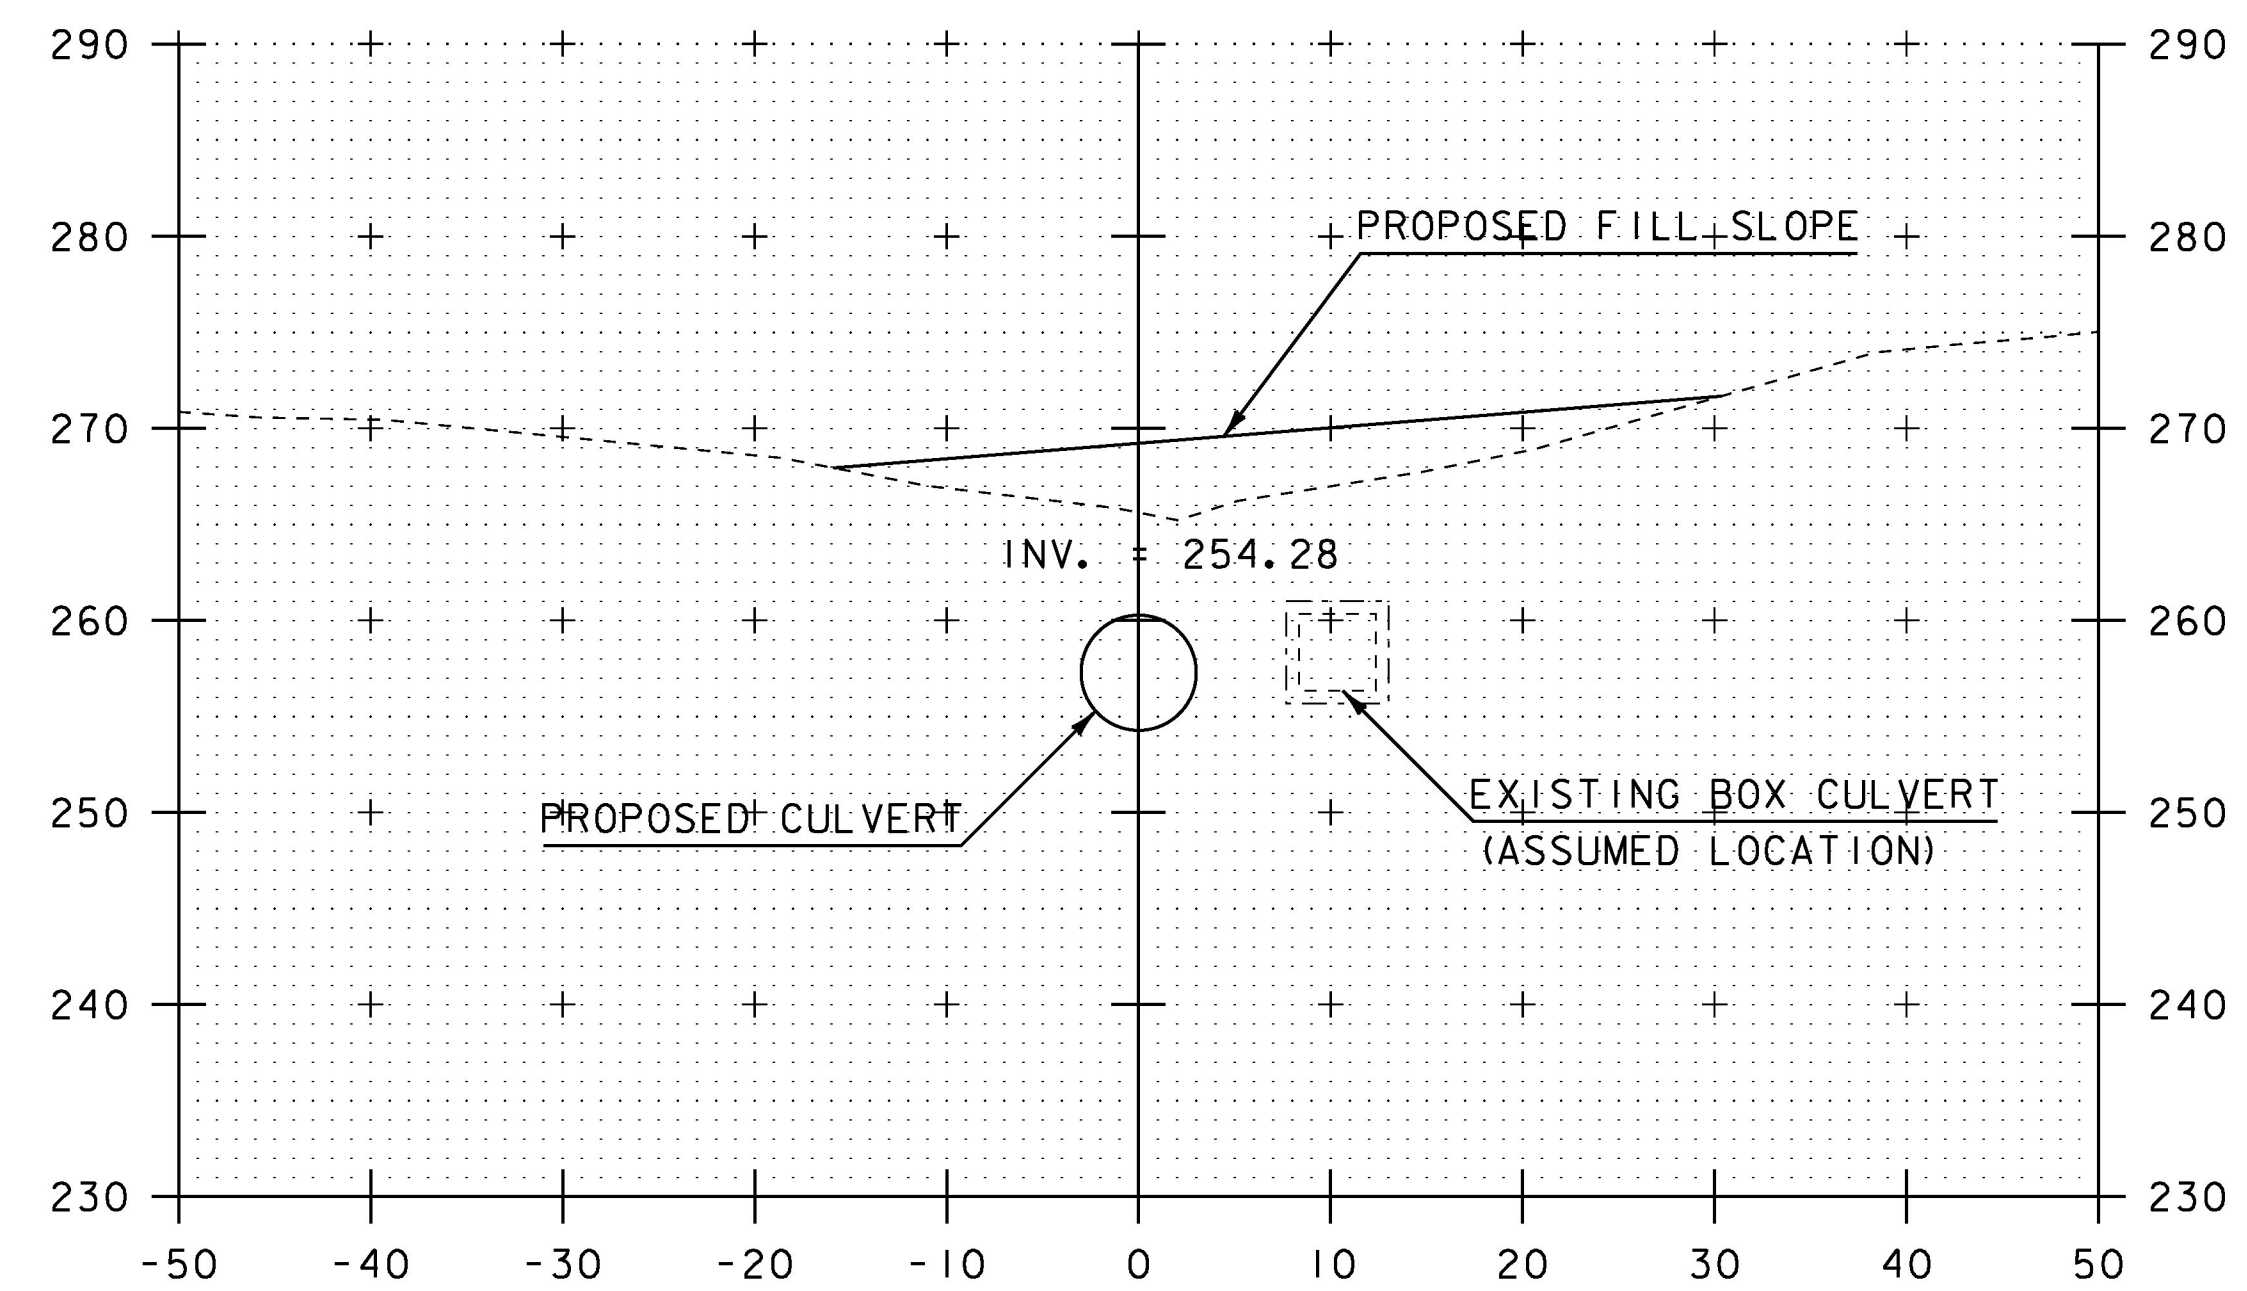

10+50

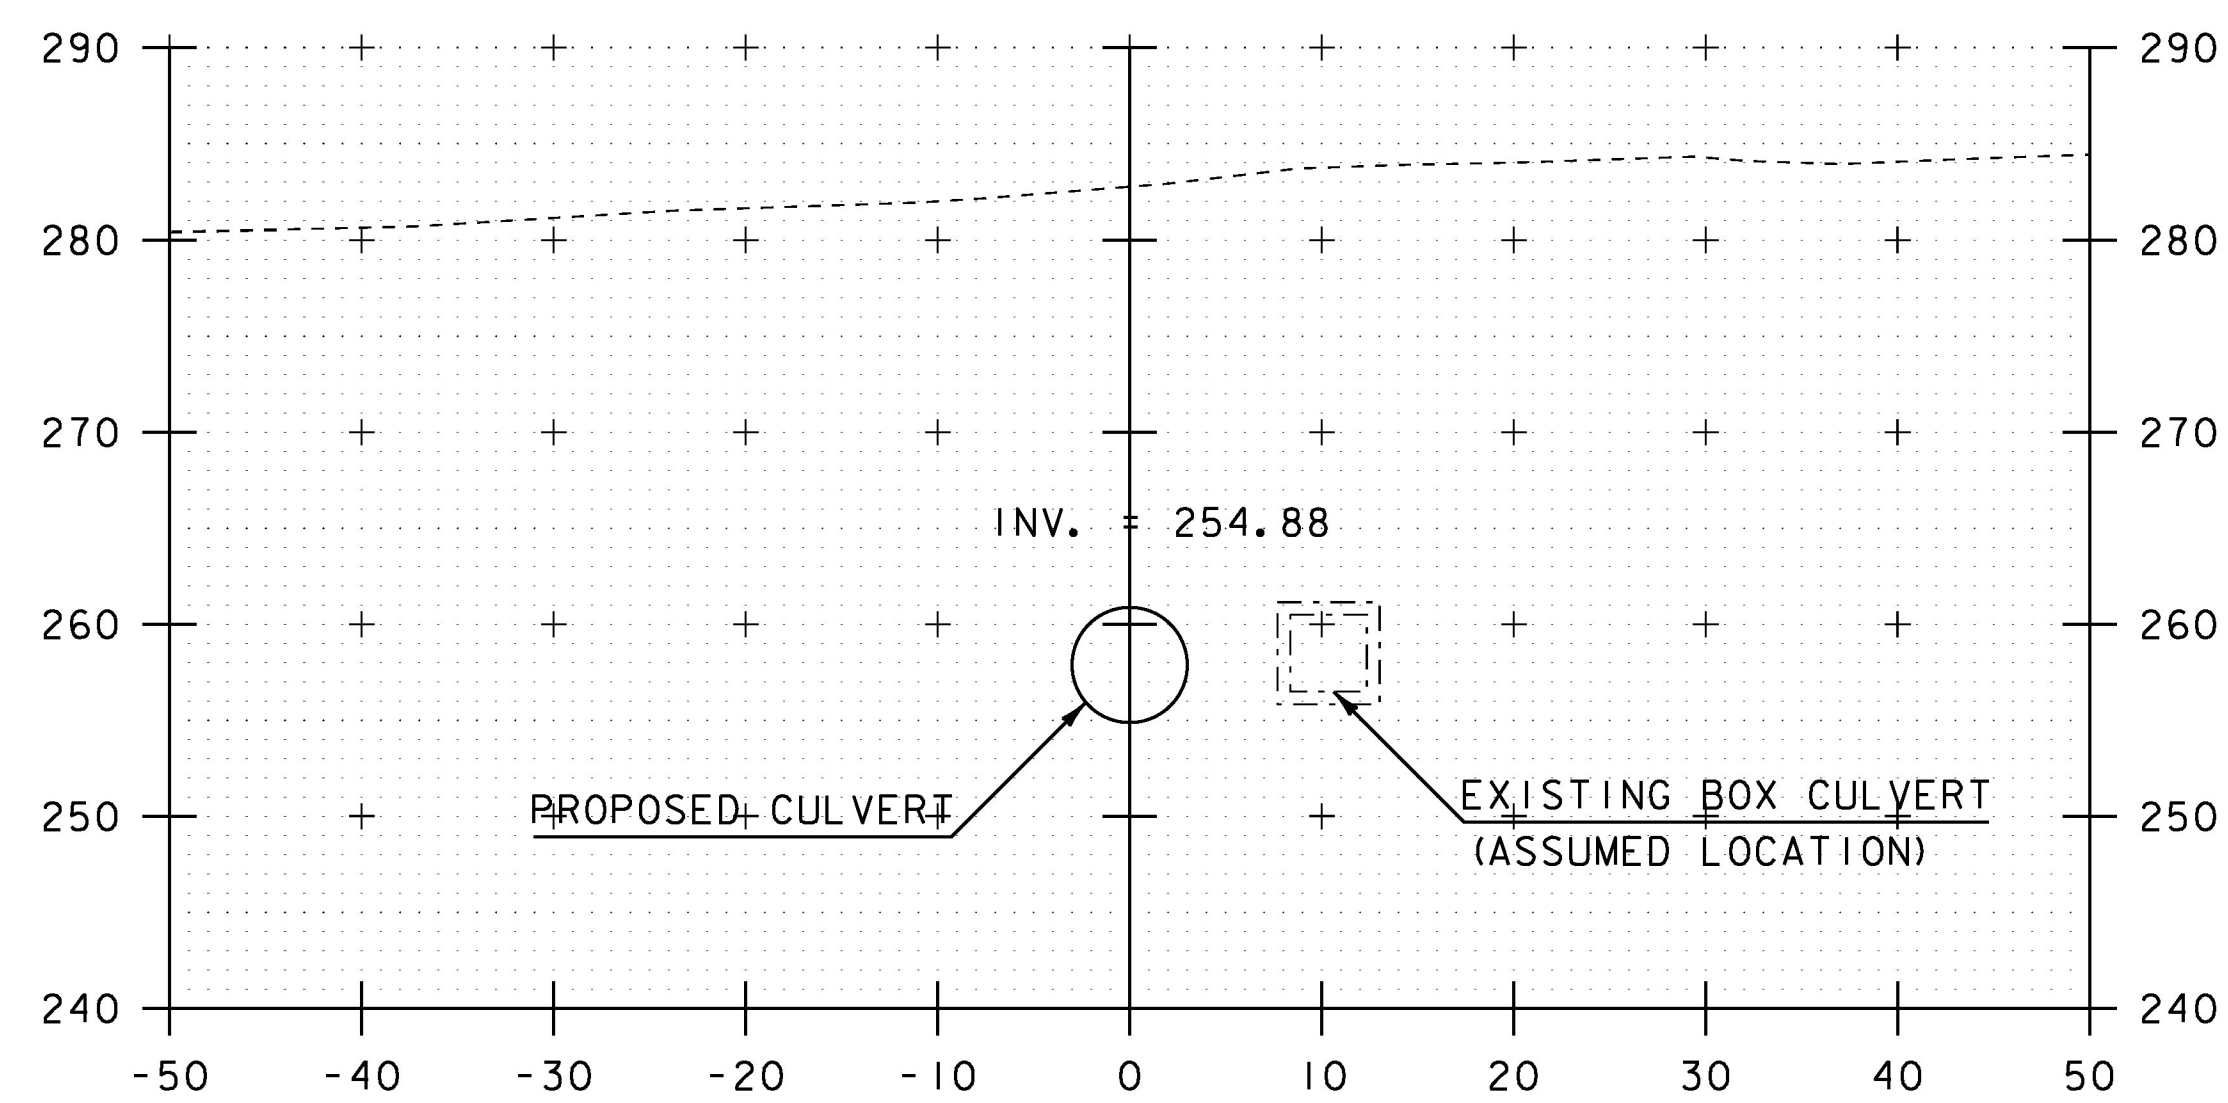

10+20

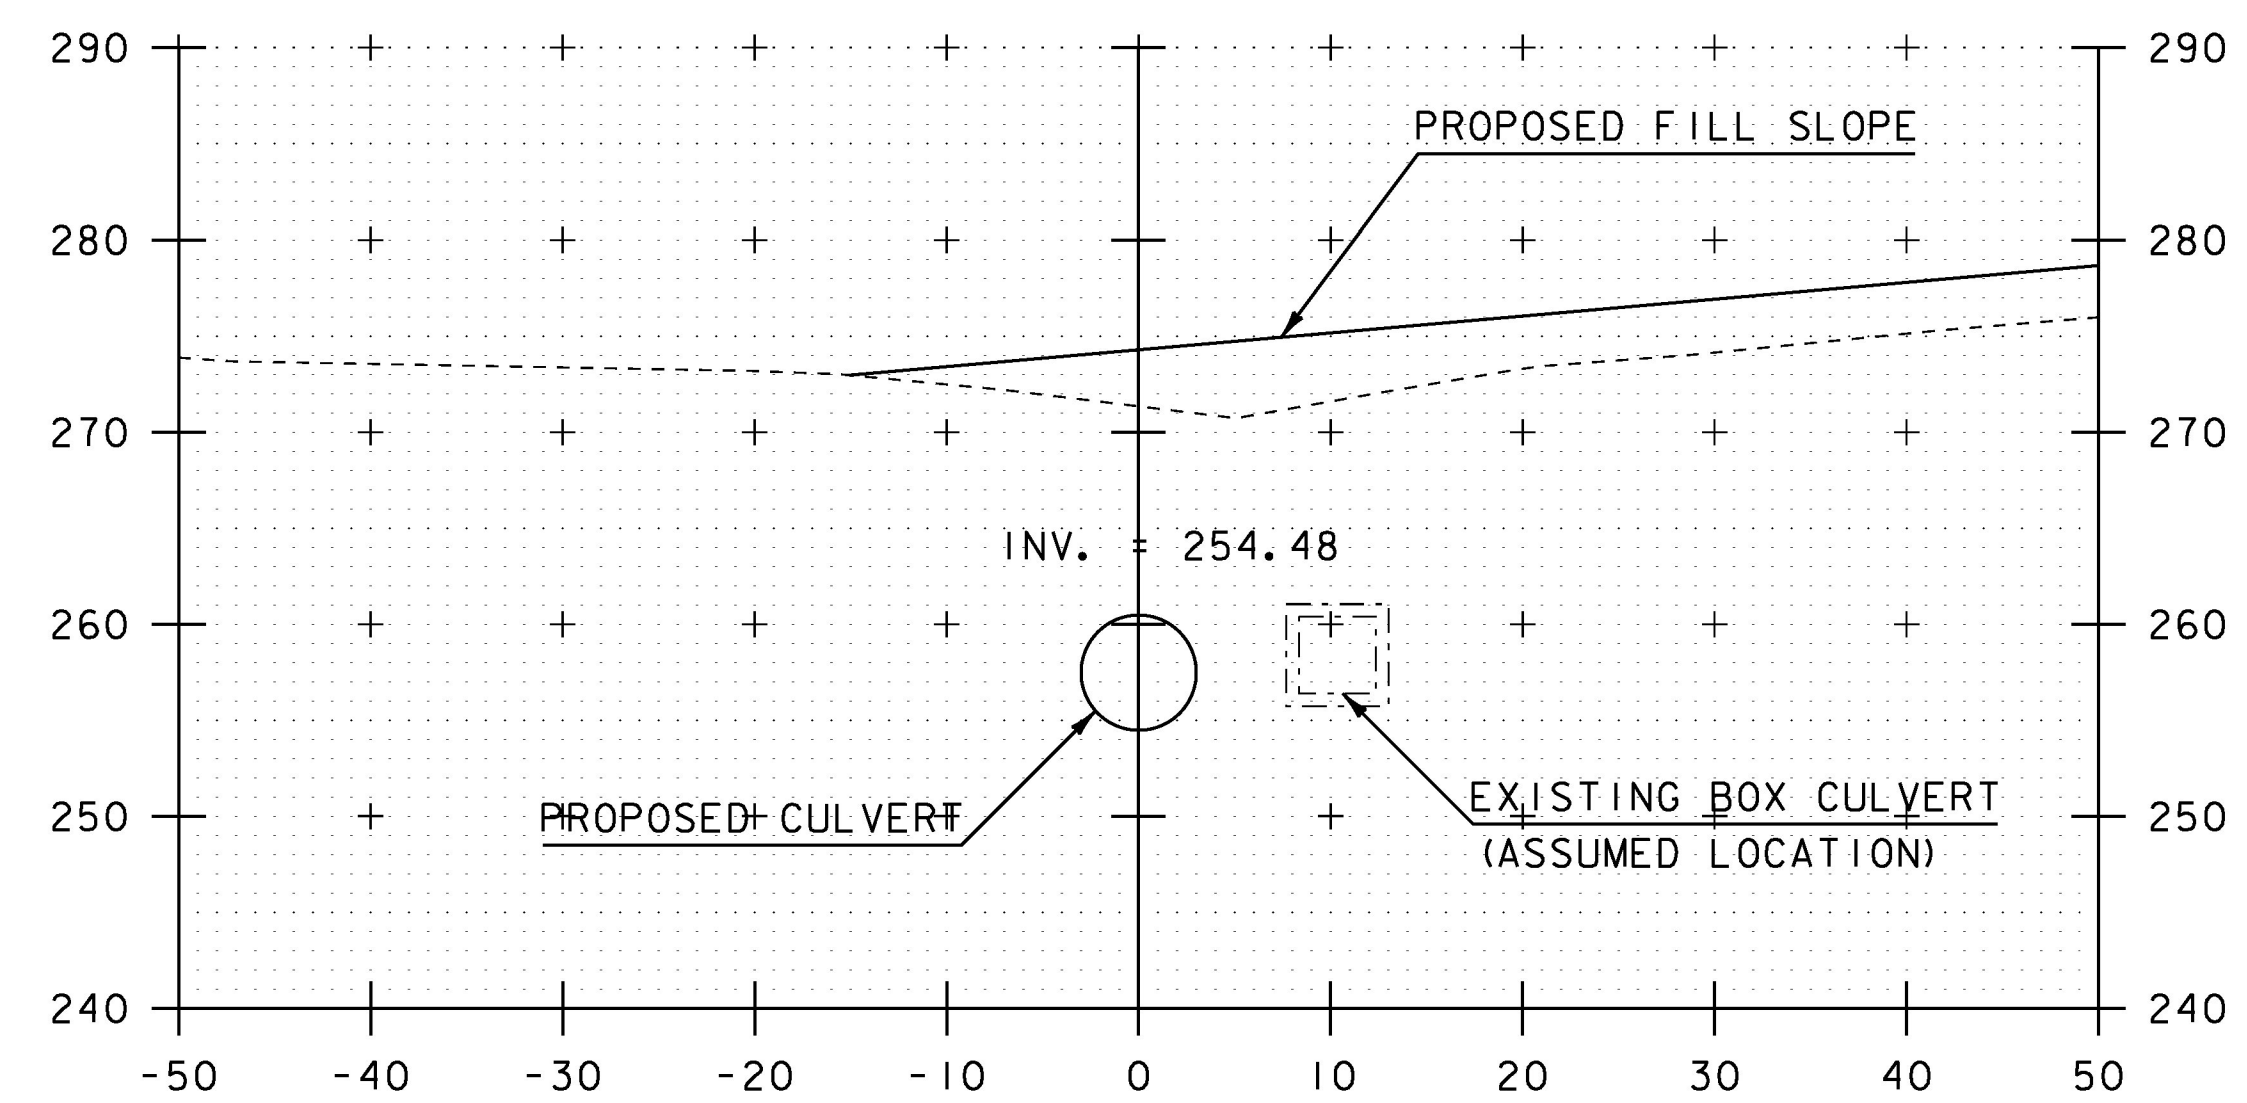


10+40


SCALE IN FEET

PROJECT NAME:	HIGHGATE
PROJECT NUMBER:	STP SCRPI(2)
FILE NAME:	d13ci34xs.dgn
PROJECT LEADER:	B. MARTIN
DESIGNED BY:	A. KEMPTON
CHANNEL CROSS SECTION SHEET 4	
PLOT DATE:	14-OCT-2016
DRAWN BY:	A. KEMPTON
CHECKED BY:	M. GAMELIN
SHEET	37 OF 40


STA. 10+20 TO STA. 10+50

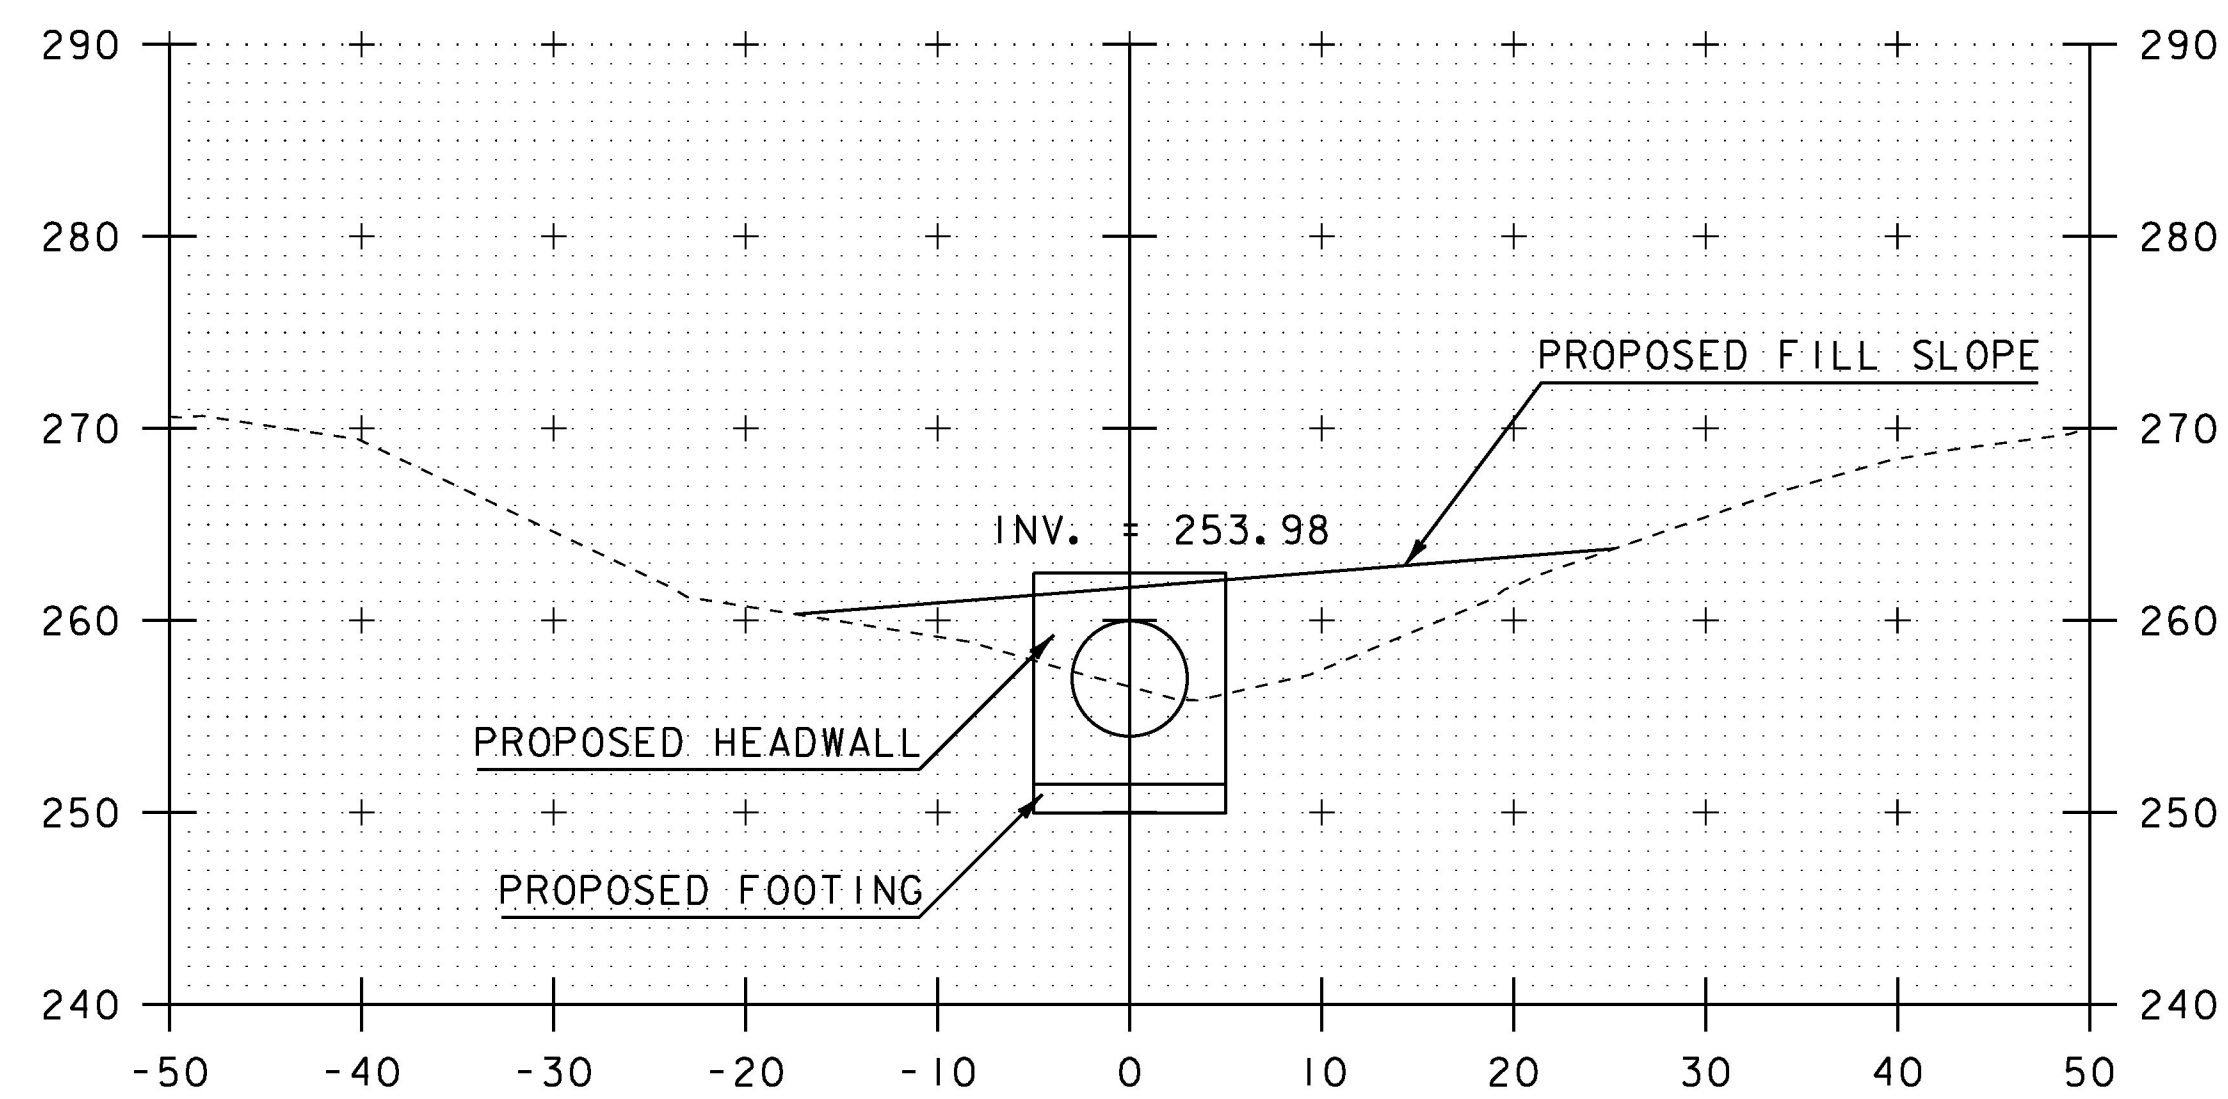


10+65.19  
END CULVERT  
(BR 10)

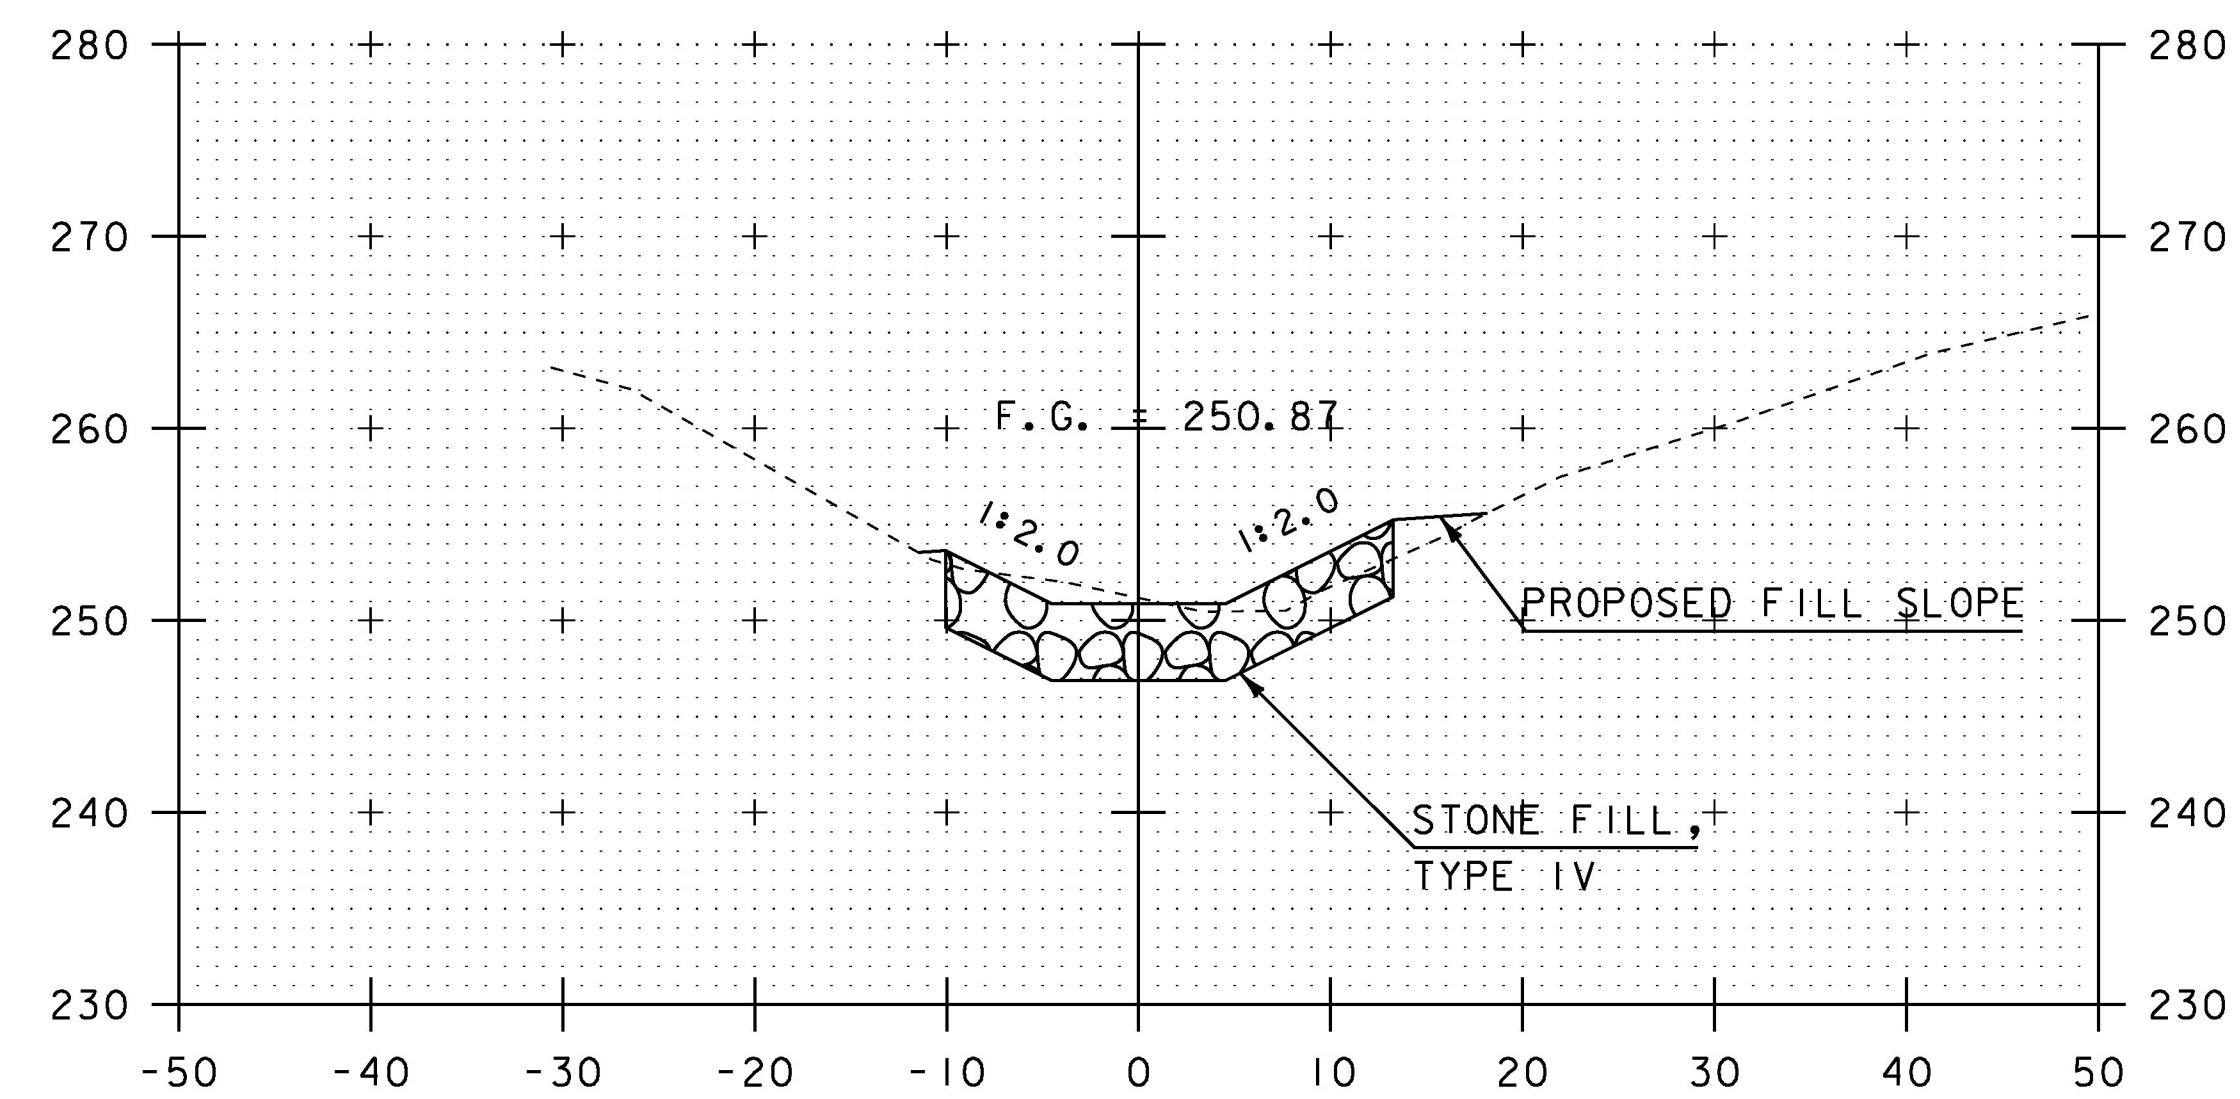

10+80

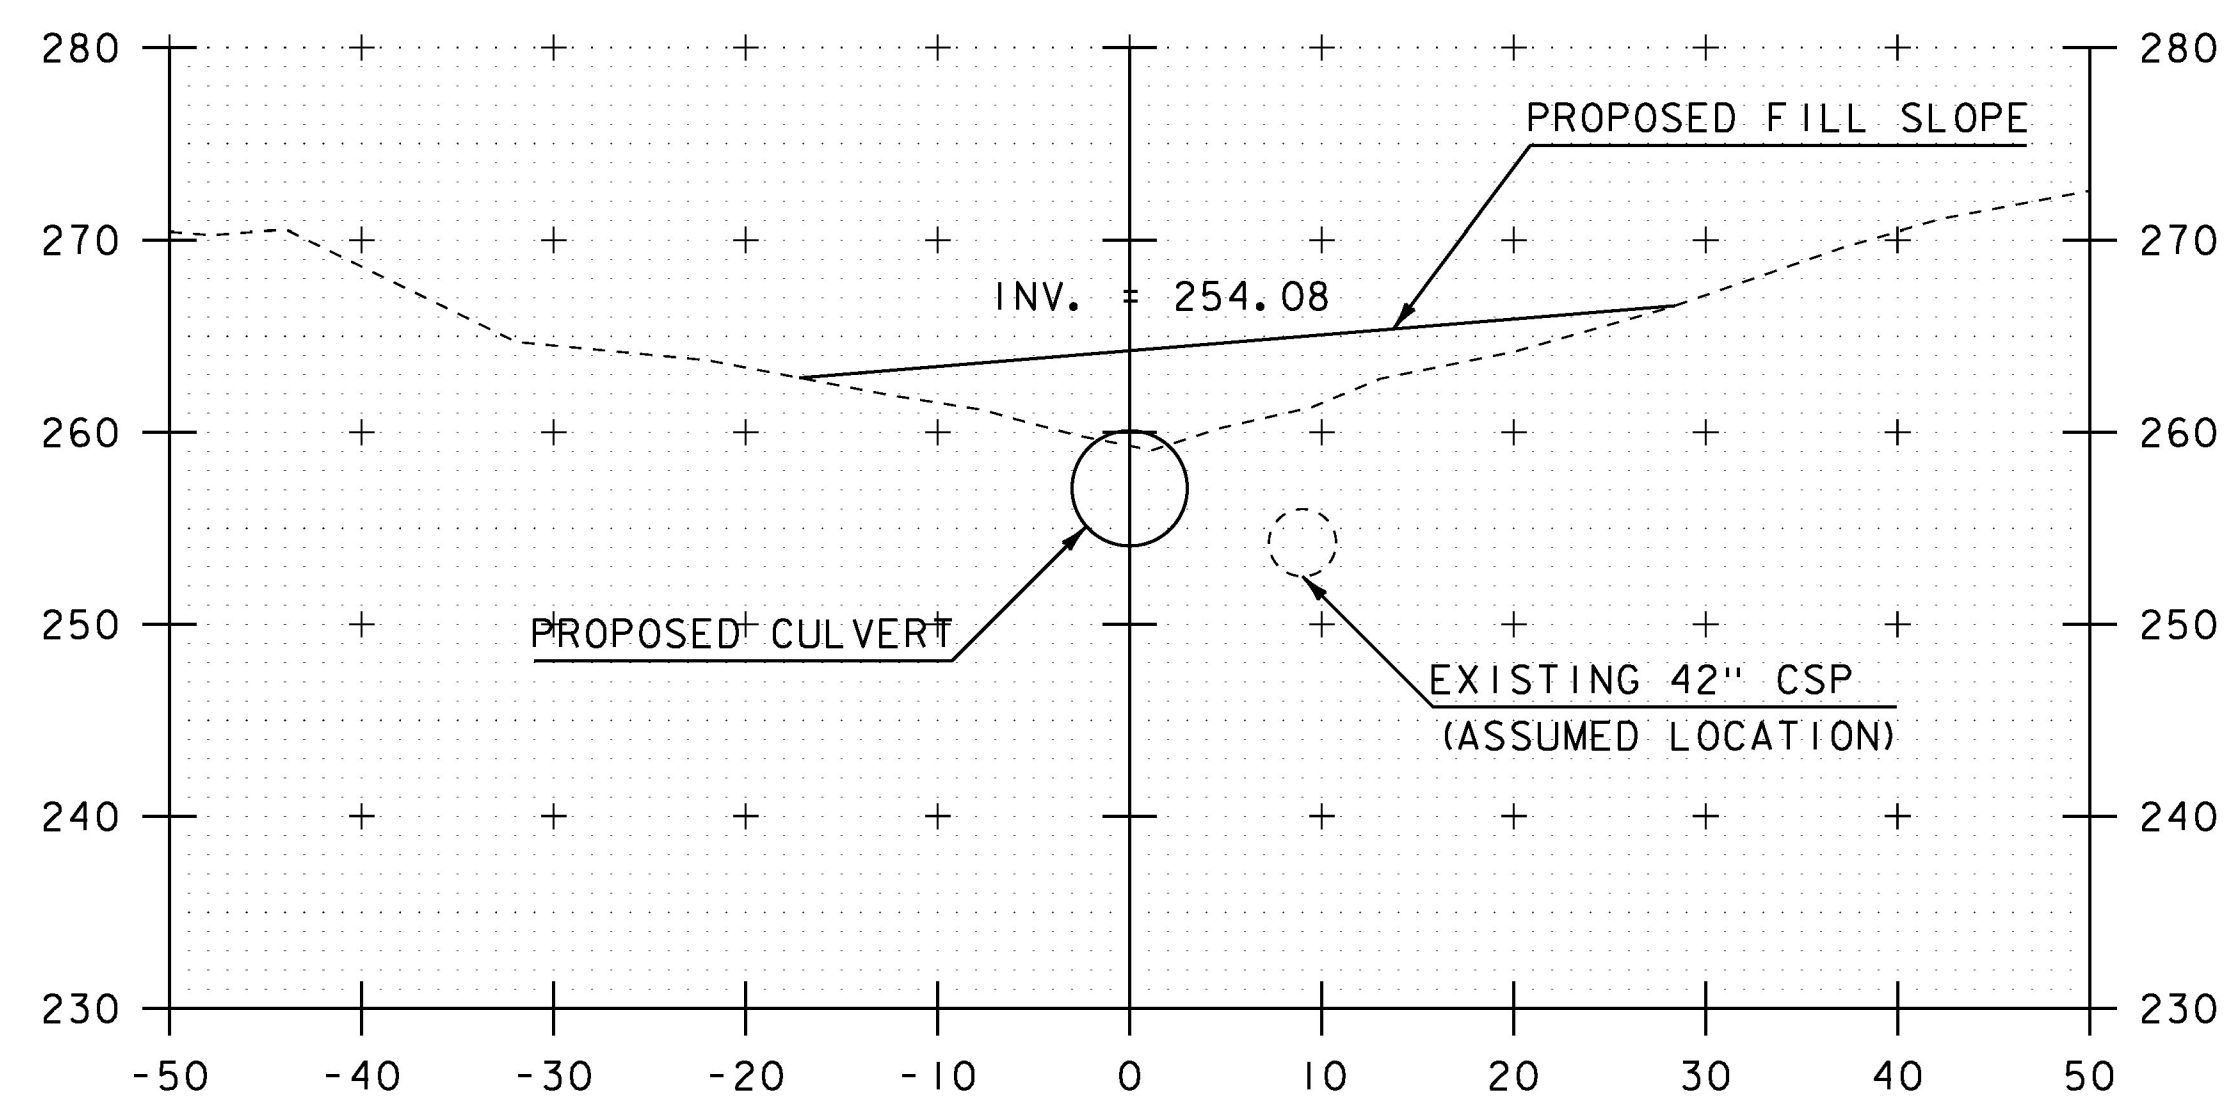

10+60

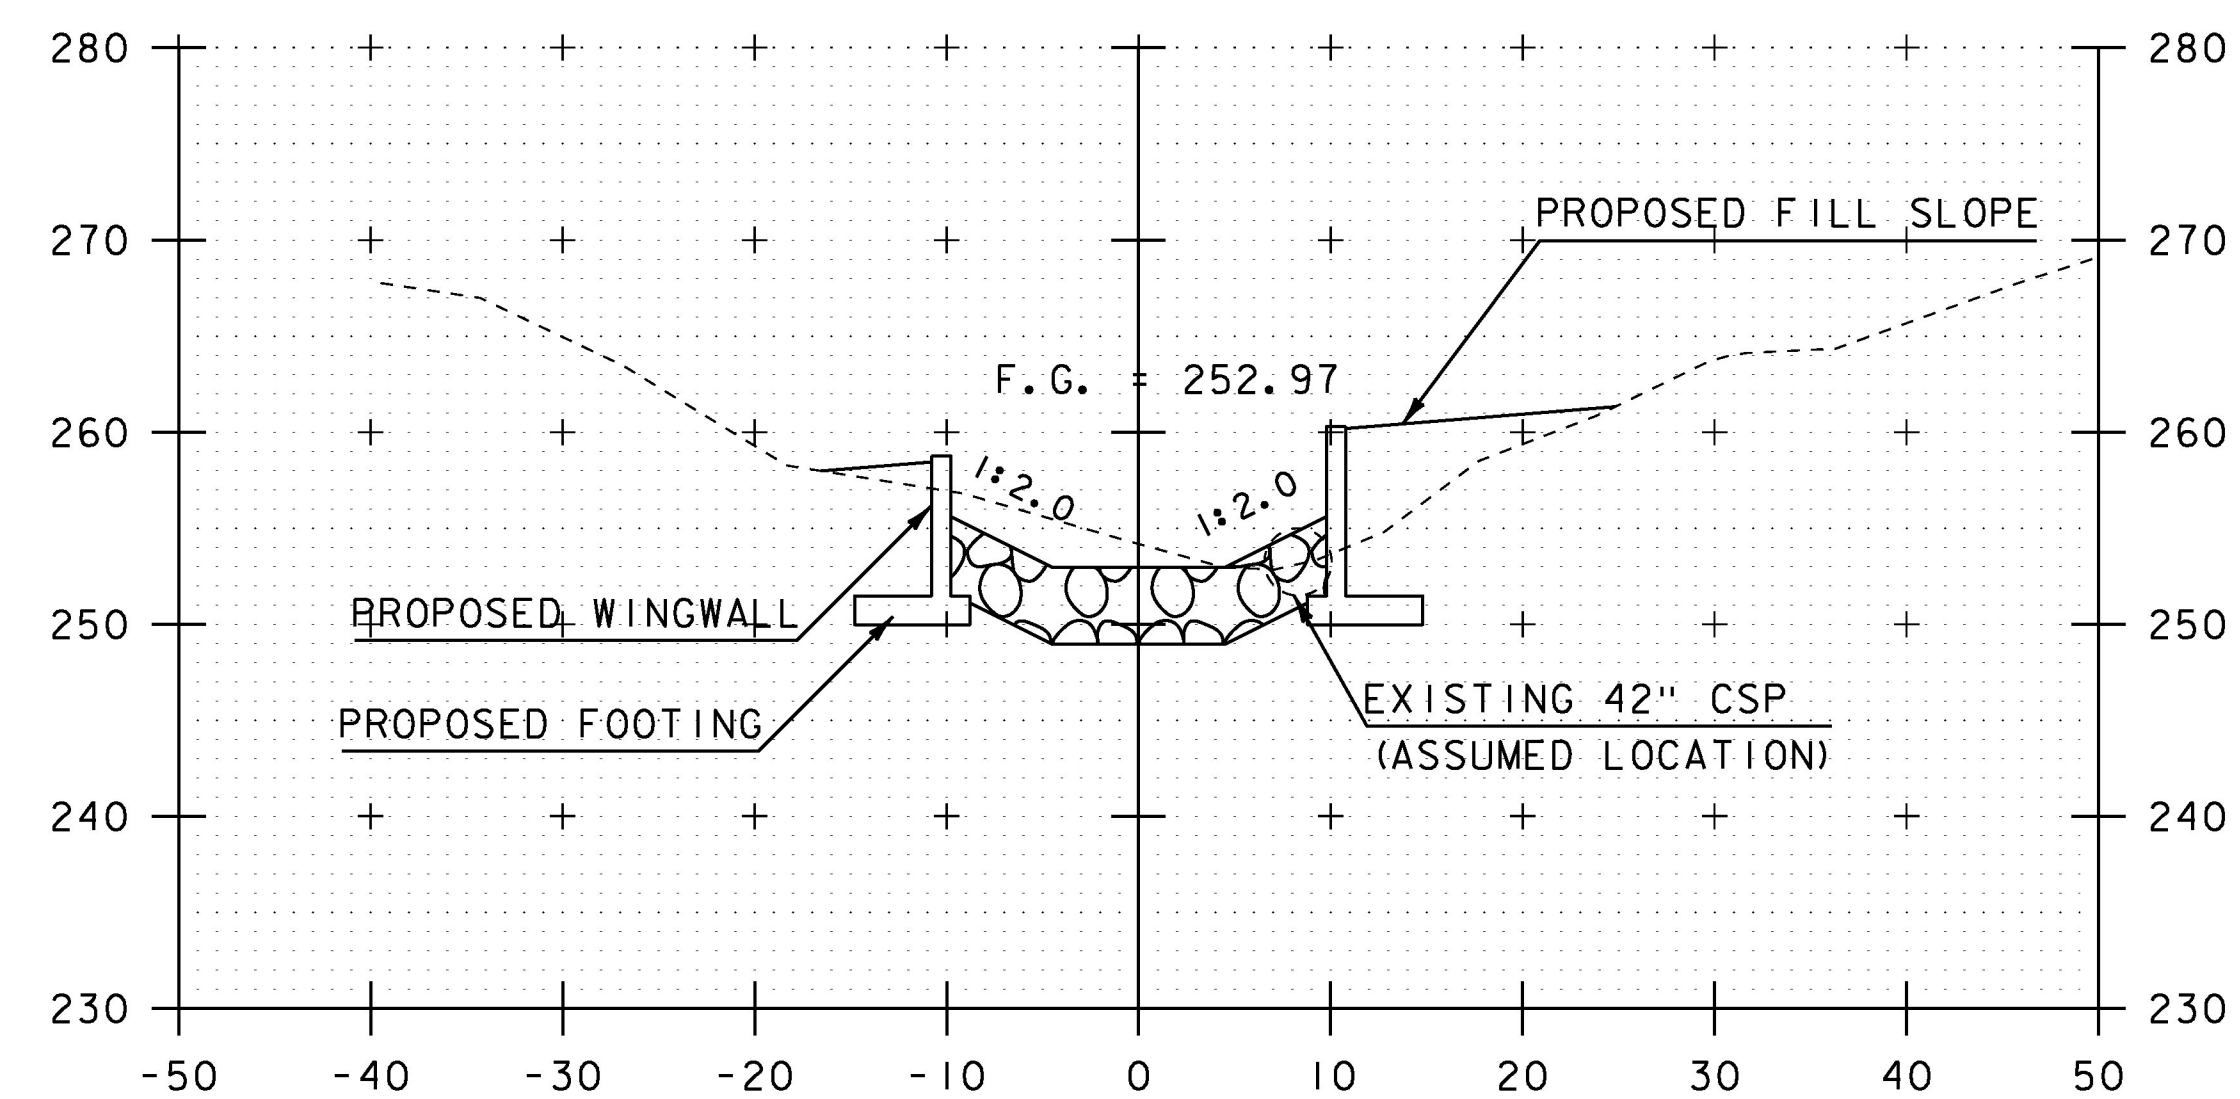


10+70


SCALE IN FEET

PROJECT NAME:	HIGHGATE
PROJECT NUMBER:	STP SCRPI(2)
FILE NAME:	d13ci34xs.dgn
PROJECT LEADER:	B. MARTIN
DESIGNED BY:	A. KEMPTON
CHANNEL CROSS SECTION SHEET 5	
PLOT DATE:	14-OCT-2016
DRAWN BY:	A. KEMPTON
CHECKED BY:	M. GAMELIN
SHEET	38 OF 40


STA. 10+60 TO STA. 10+80

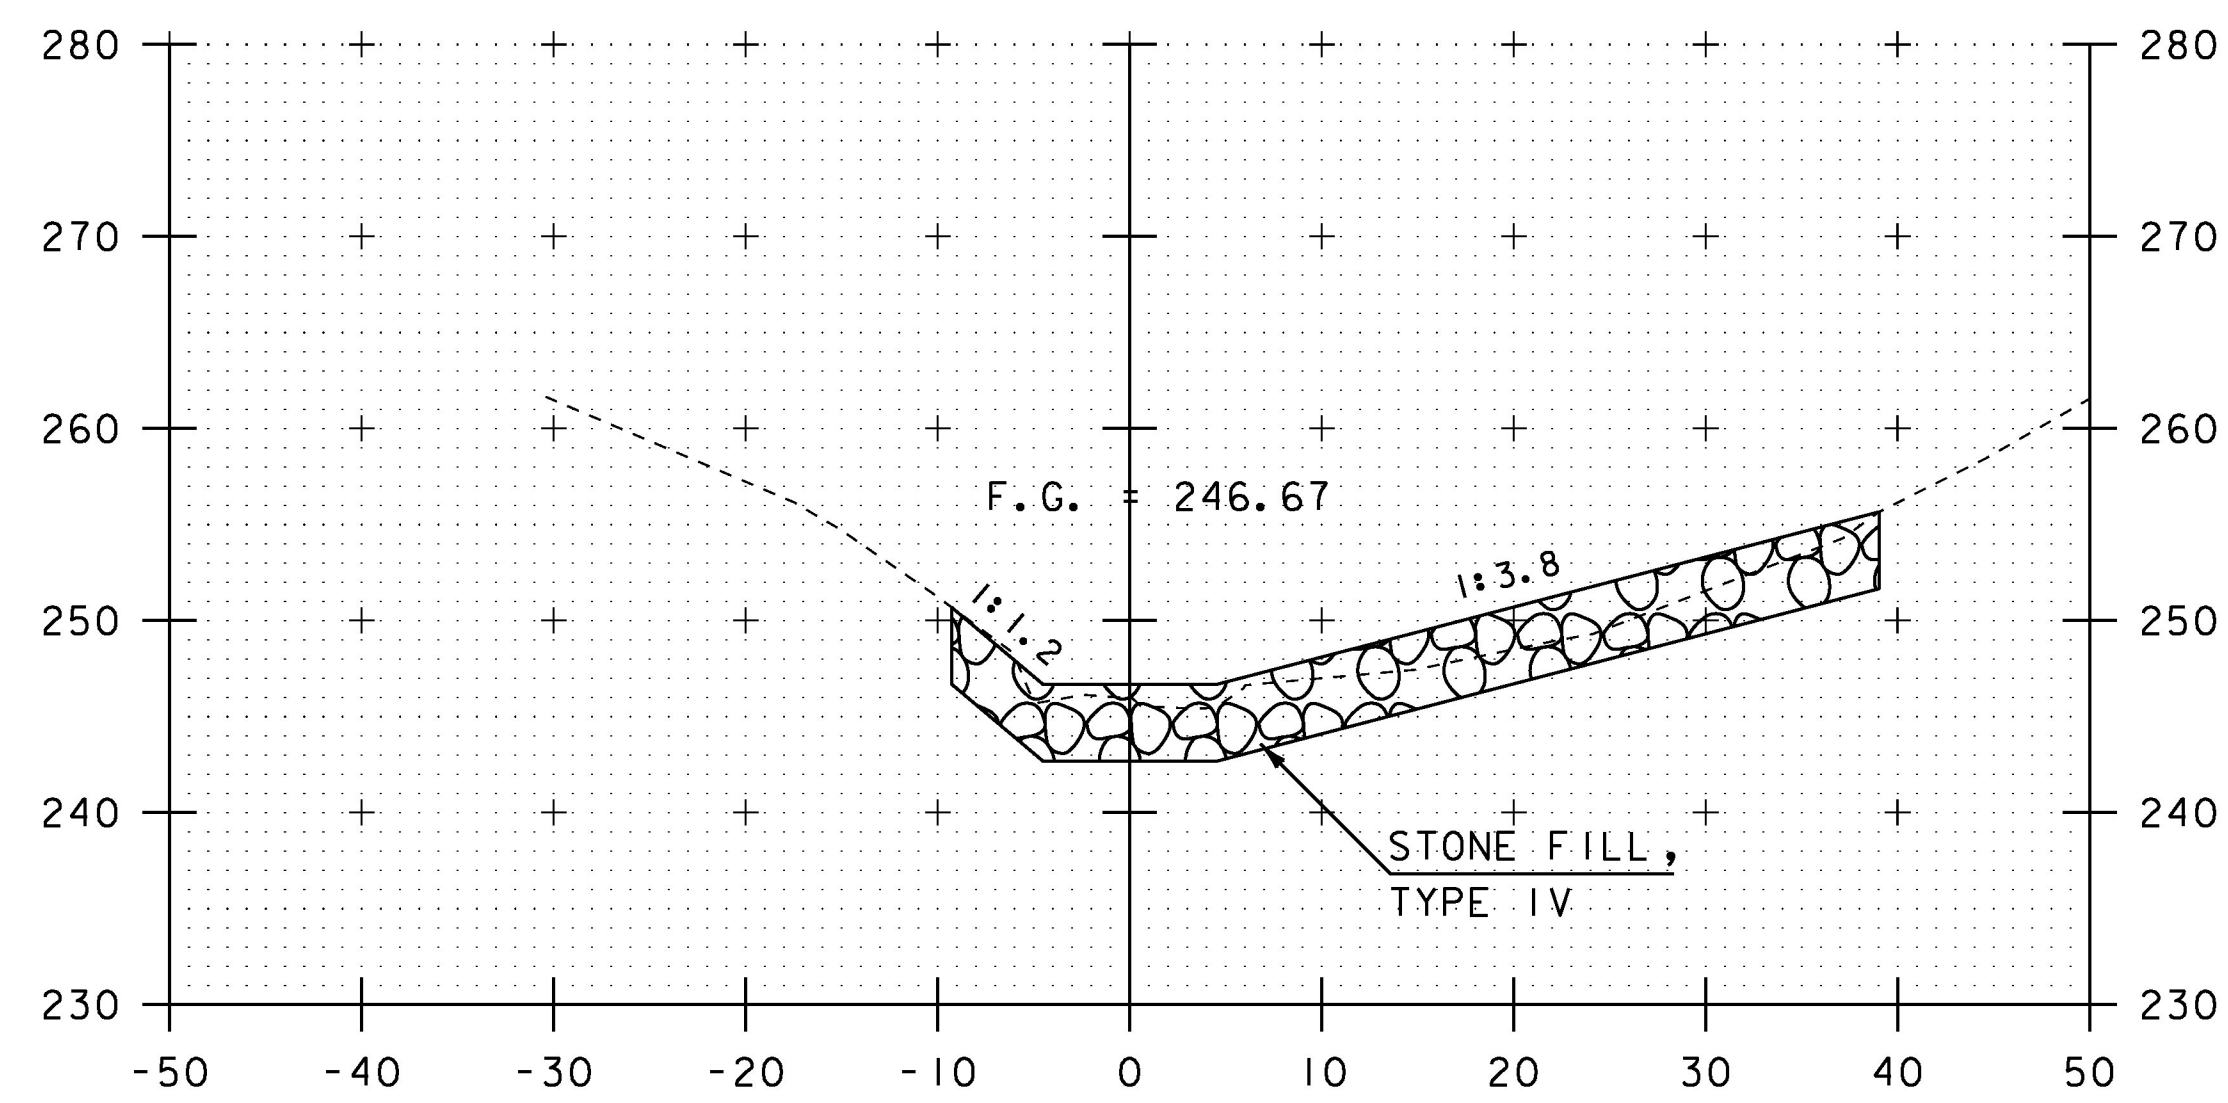


11+00

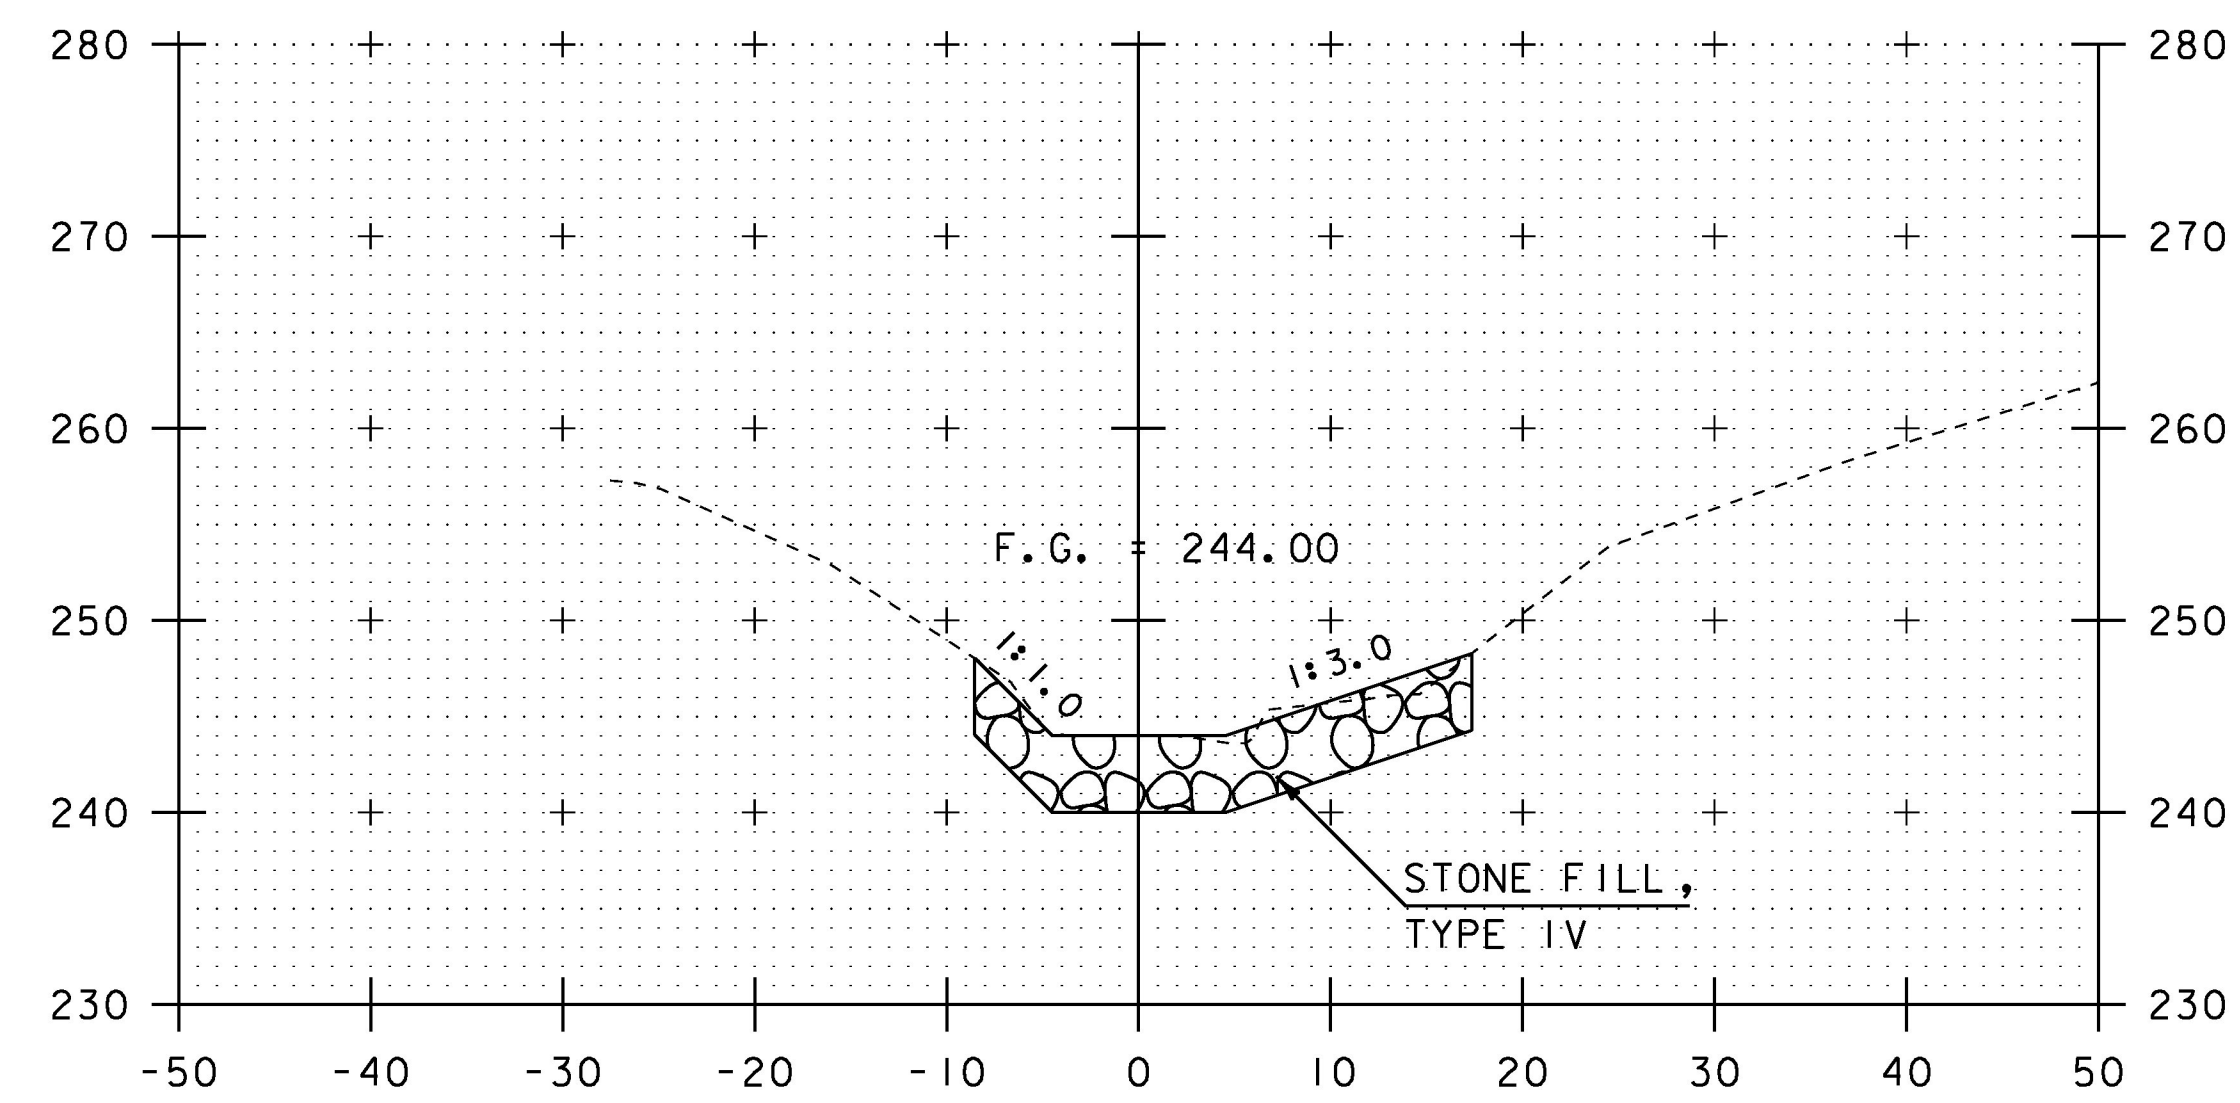

11+13  
END CHANNEL WORK

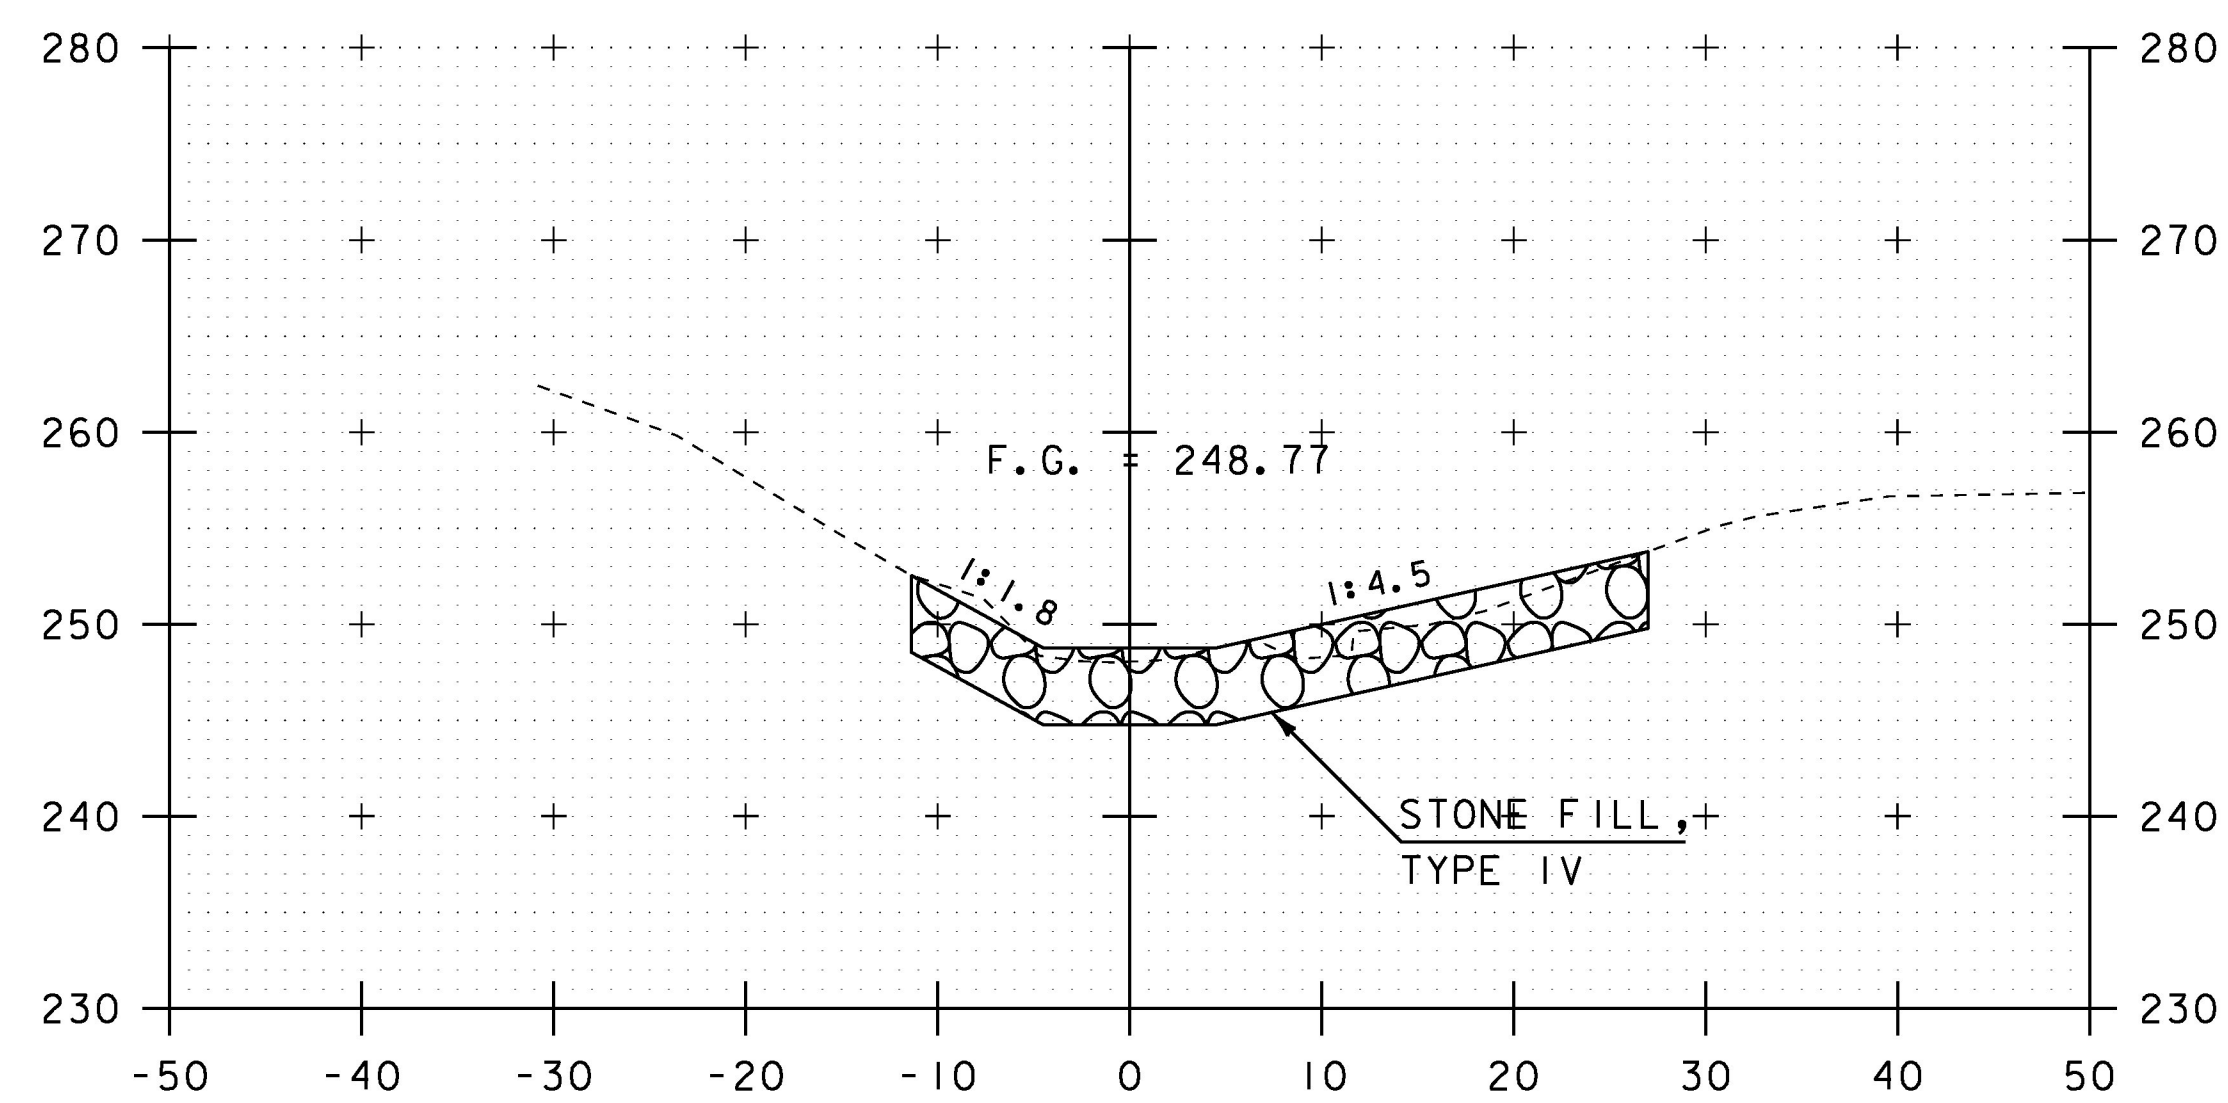

10+90

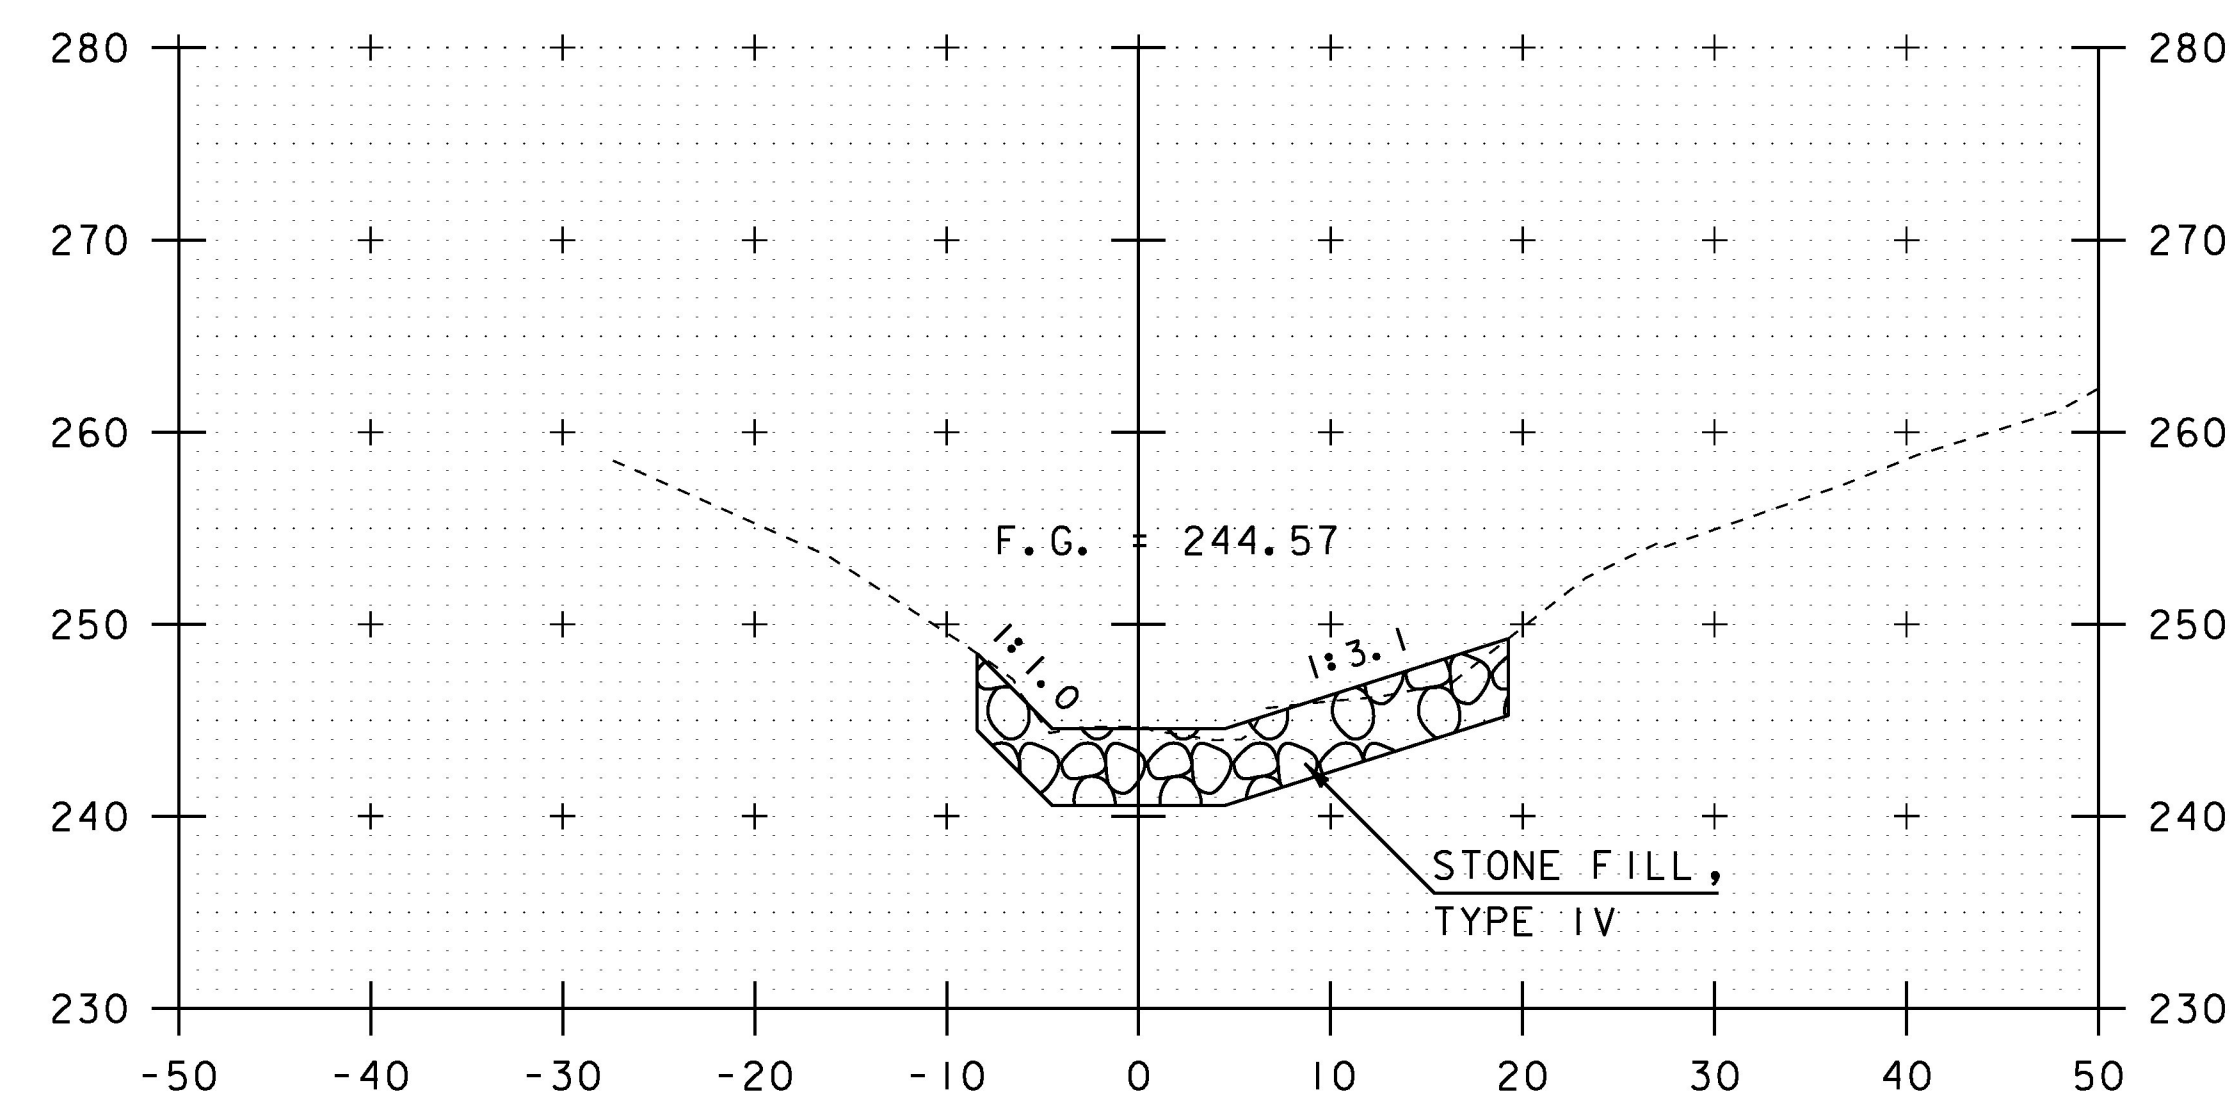


11+10




SCALE IN FEET


PROJECT NAME:	HIGHGATE
PROJECT NUMBER:	STP SCRPI(2)
FILE NAME:	d13ci34xs.dgn
PROJECT LEADER:	B. MARTIN
DESIGNED BY:	A. KEMPTON
CHANNEL CROSS SECTION SHEET 6	
PLOT DATE:	14-OCT-2016
DRAWN BY:	A. KEMPTON
CHECKED BY:	M. GAMELIN
SHEET	39 OF 40

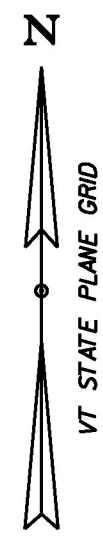STA. 10+90 TO STA. 11+13



LEGEND

- (A)  W20-1
- (B)  W20-1
- (C)  G20-2

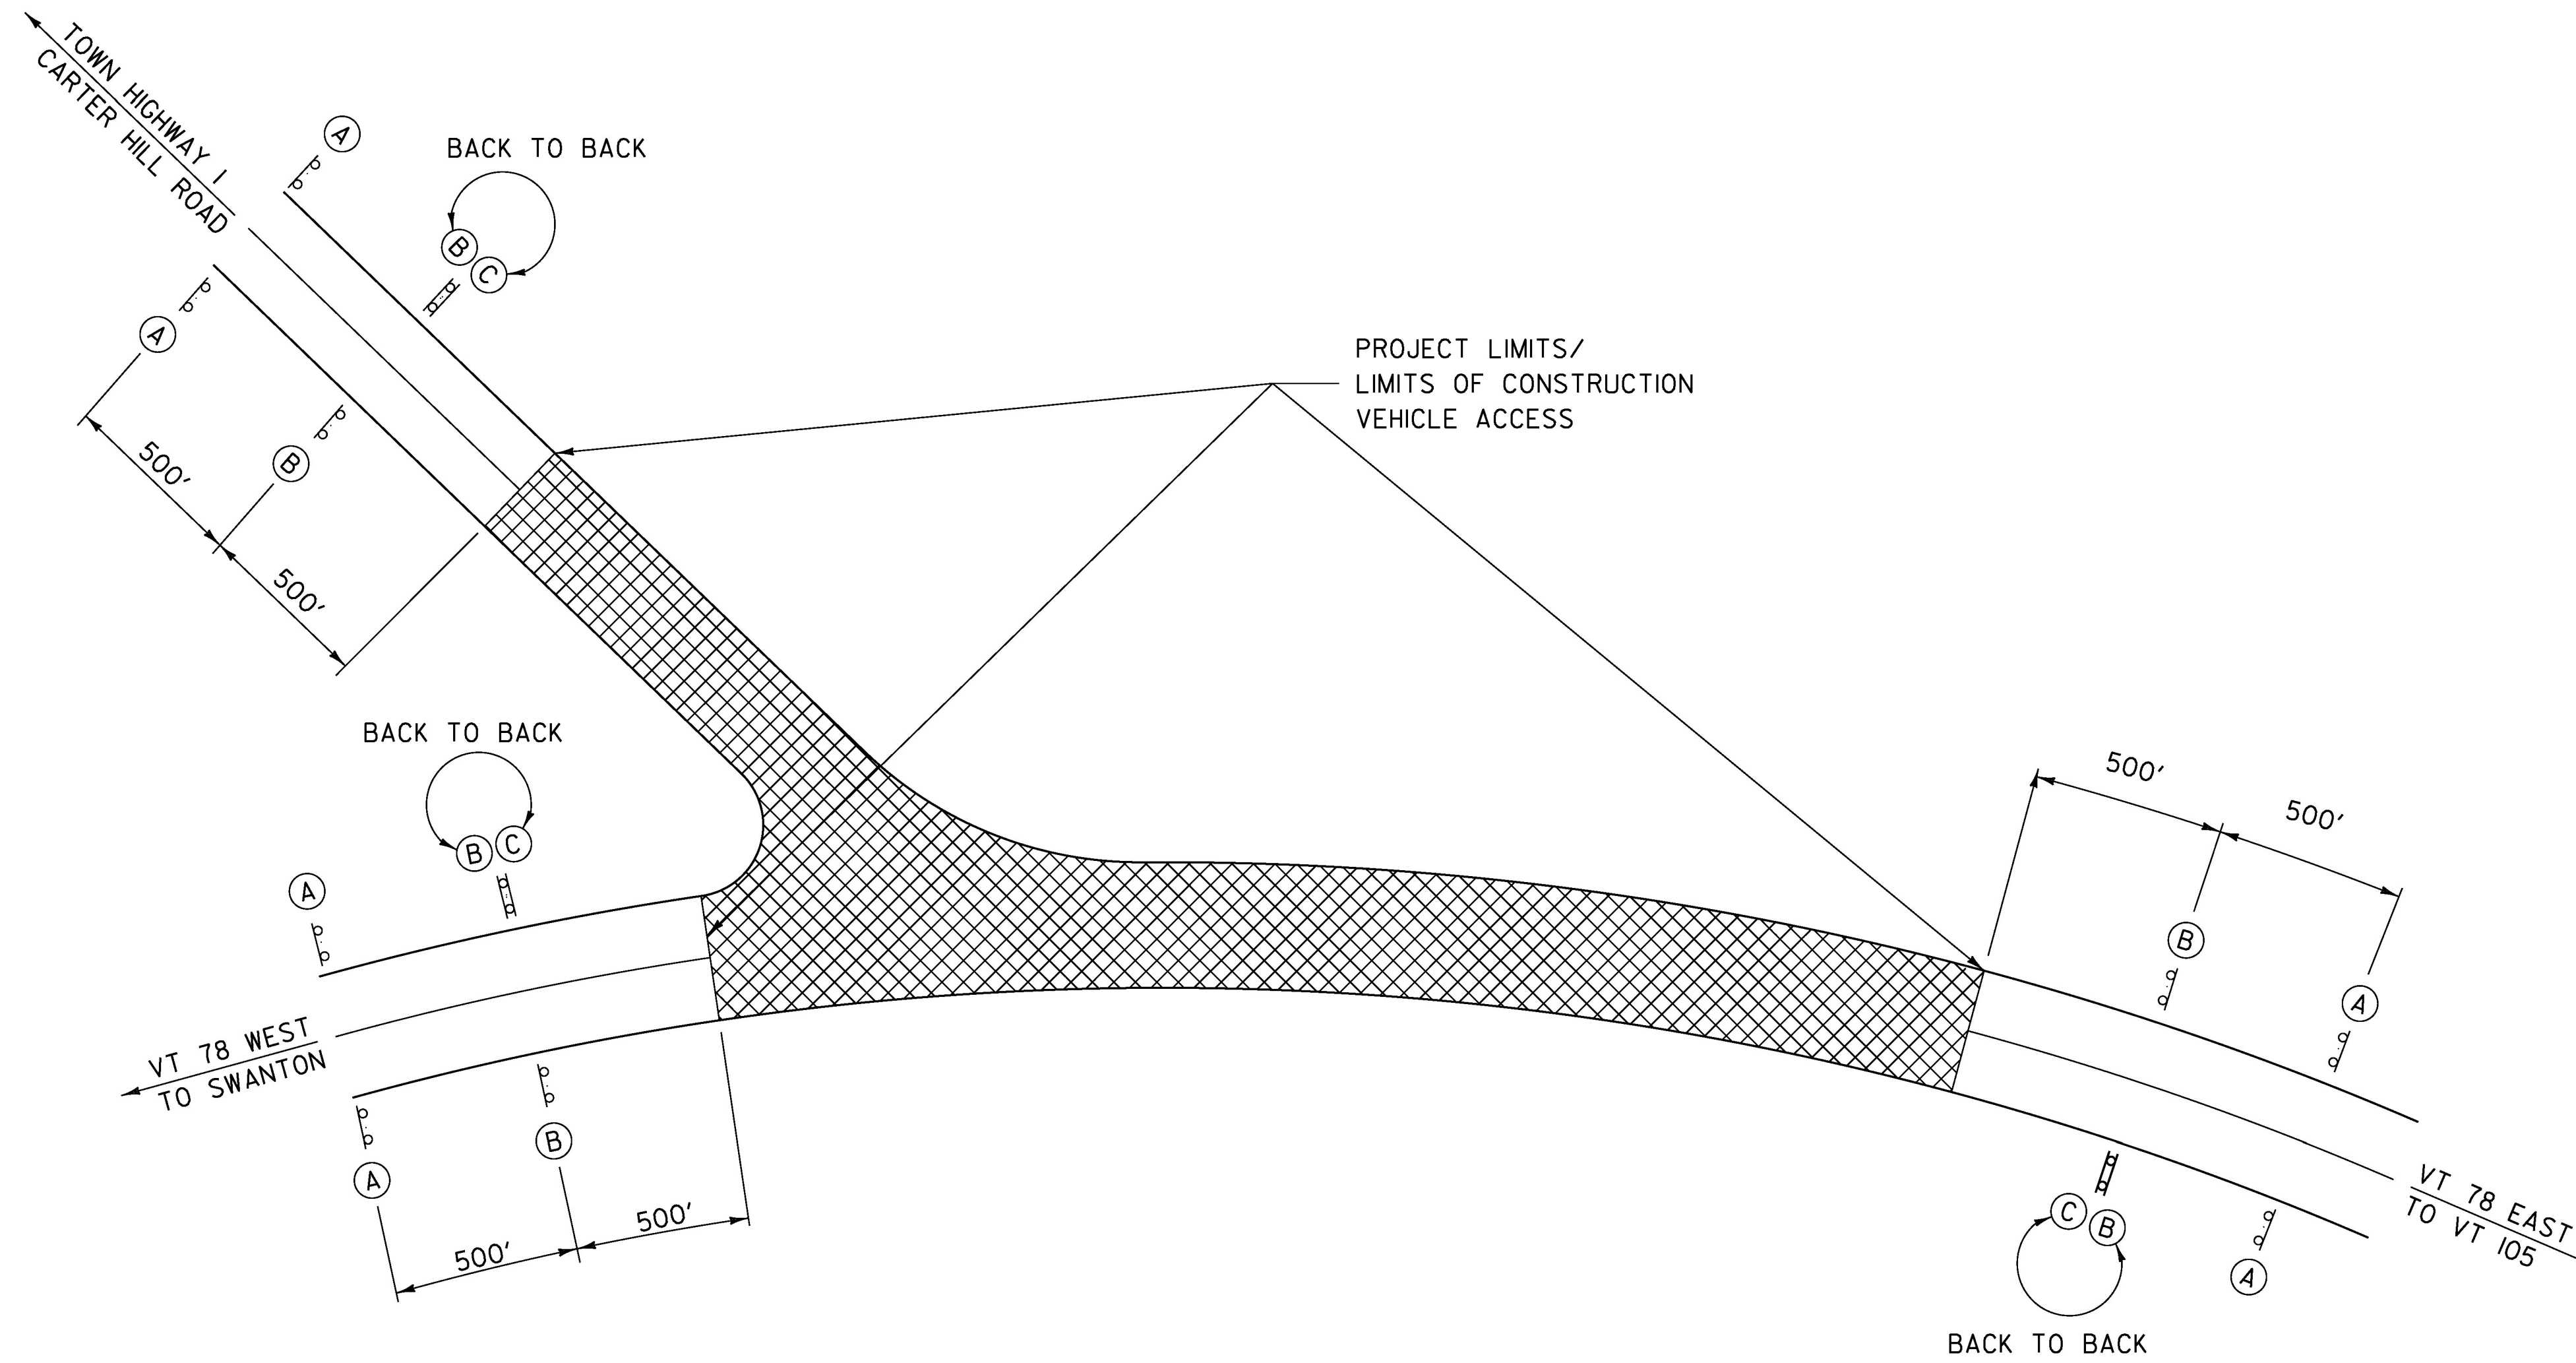

TRAFFIC CONTROL NOTES:

THE CONTRACTOR SHALL SUBMIT A SITE SPECIFIC TRAFFIC CONTROL PLAN TO THE ENGINEER. THE PLAN SHALL INCLUDE PROVISIONS FOR IMPLEMENTATION AND MAINTENANCE OF TRAFFIC CONTROL FOR ALL WORK ASSOCIATED WITH THIS PROJECT. ALL COSTS ASSOCIATED WITH THE DEVELOPMENT AND ANY NECESSARY REVISION OF A TRAFFIC CONTROL PLAN WILL BE PAID FOR UNDER ITEM 641.10 TRAFFIC CONTROL.

THE TRAFFIC CONTROL PLANS SHOWN HEREIN ARE APPROXIMATE AND INTENDED TO BE UTILIZED IN CONJUNCTION WITH APPLICABLE VTRANS STANDARD DRAWINGS AND THE MUTCD. THE USE OF ADDITIONAL SIGNAGE AND DELINEATION IS ANTICIPATED AND WILL BE DETERMINED BY THE CONTRACTORS MEANS, METHODS AND CONSTRUCTION SEQUENCING.

THE CONTRACTOR IS NOTIFIED THAT ALL ROADWAYS INCLUDED IN AND ASSOCIATED WITH THIS PROJECT ARE SUBJECT TO OCCASIONAL USE AND TRAVEL BY EMERGENCY RESPONSE VEHICLES. THE CONTRACTOR SHALL MAKE AND IMPLEMENT PLANS AND PROCEDURES DESIGNED TO ENSURE SWIFT AND UNIMPEDED TRAVEL OF EMERGENCY RESPONSE VEHICLES THROUGH CONSTRUCTION ZONES AND SHALL SUBMIT THEM TO THE ENGINEER WITH THE OVERALL TRAFFIC CONTROL PLAN.

CONSTRUCTION APPROACH SIGNING


FIELD CONDITIONS MAY DICTATE THE ACTUAL SIGN PLACEMENT.

NOT TO SCALE

PROJECT NAME:	HIGHGATE
PROJECT NUMBER:	STP SCRPI(2)
FILE NAME:	d13ci34frm.dgn
PROJECT LEADER:	B. MARTIN
DESIGNED BY:	A. KEMPTON
CONSTRUCTION APPROACH SIGNING SHEET	CHECKED BY: M. GAMELIN
	PLOT DATE: 14-OCT-2016
	DRAWN BY: A. KEMPTON
	SHEET 40 OF 40


**CONCRETE GENERAL NOTES**

1. ALL EXPOSED EDGES OF CONCRETE SHALL BE CHAMFERED 1" x 1"
2. REINFORCING STEEL SIZE AND SPACING SHOWN IN THE PLANS IS BASED ON 60 KSI STEEL, UNLESS NOTED OTHERWISE. WITH THE ENGINEER'S PERMISSION, BAR SIZE AND SPACING MAY BE MODIFIED ACCORDING TO THE LATEST AASHTO LRFD BRIDGE DESIGN SPECIFICATION AND STRUCTURES DESIGN MANUAL WHEN USING HIGHER STRENGTH STEEL.

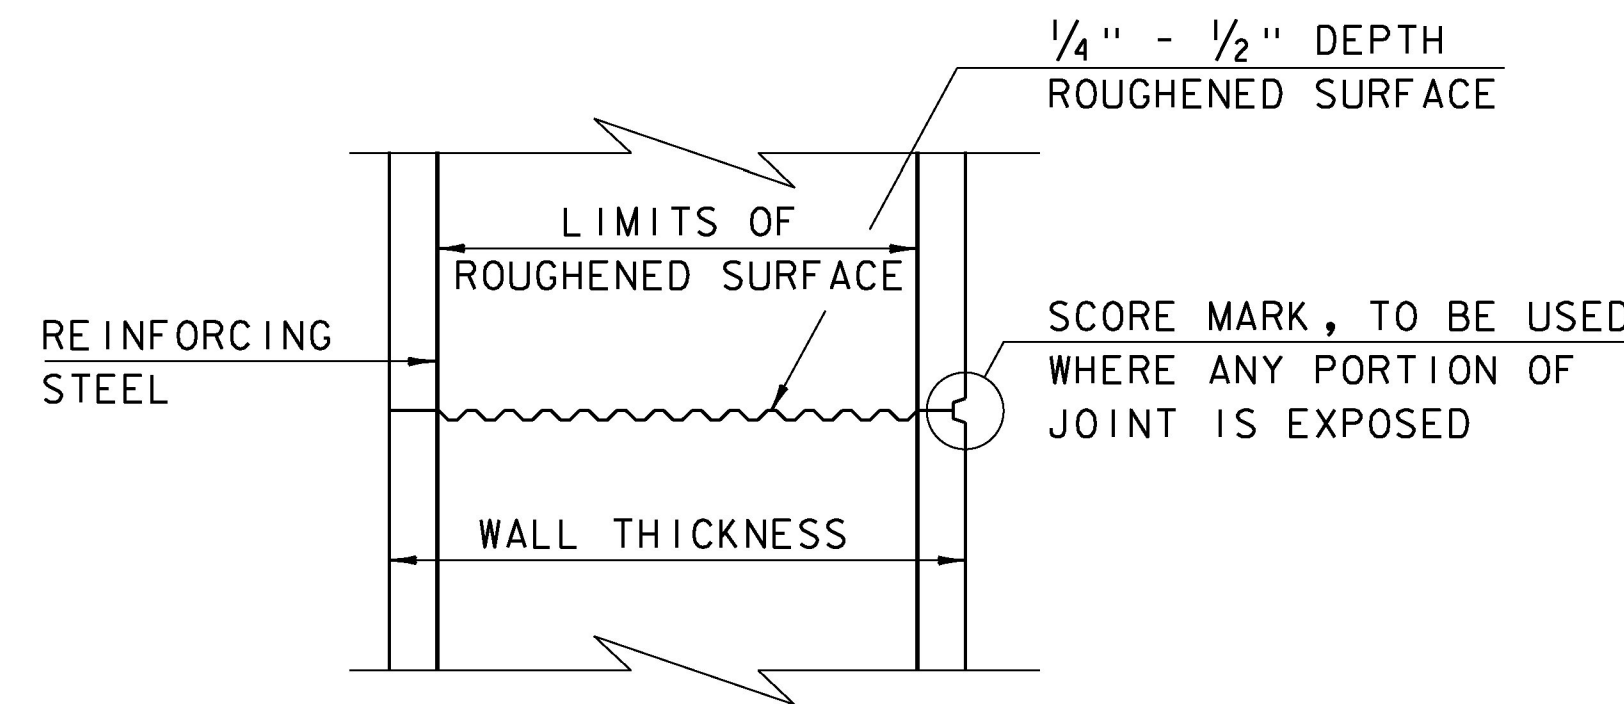


**TYPICAL HORIZONTAL CONSTRUCTION JOINT**  
(NOT TO SCALE)


1. THE SURFACE OF THE CONCRETE CONSTRUCTION JOINTS SHALL BE CLEANED AND FREE OF LAITANCE.
2. IMMEDIATELY BEFORE NEW CONCRETE IS PLACED, ALL CONSTRUCTION JOINTS SHALL BE WETTED AND STANDING WATER REMOVED.

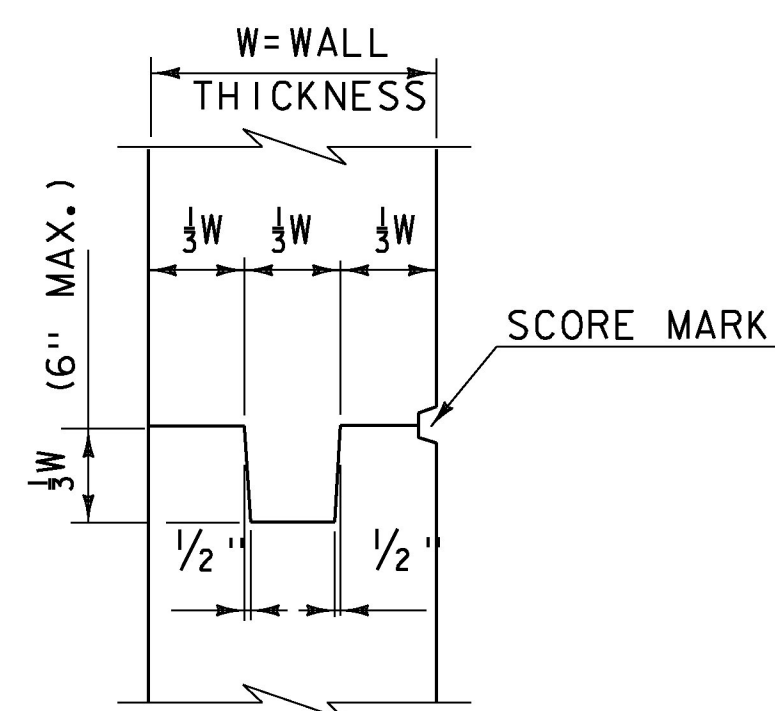


**TYPICAL CONCRETE CONSTRUCTION JOINT**  
(NOT TO SCALE)

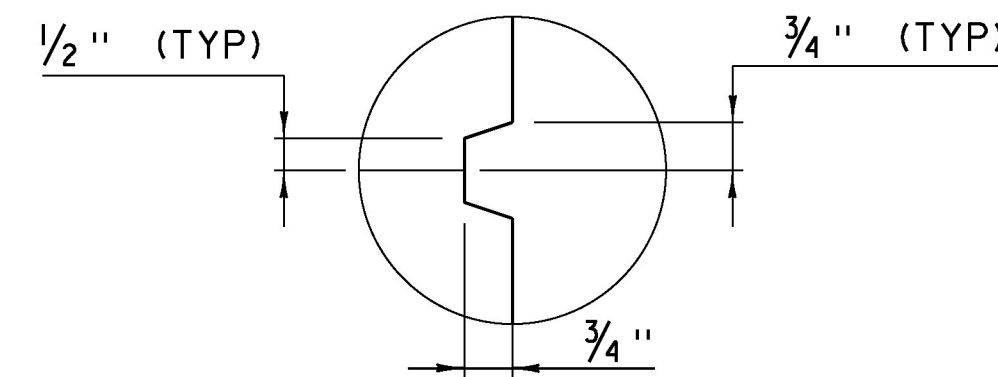


**SCORE MARK DETAIL**  
(NOT TO SCALE)

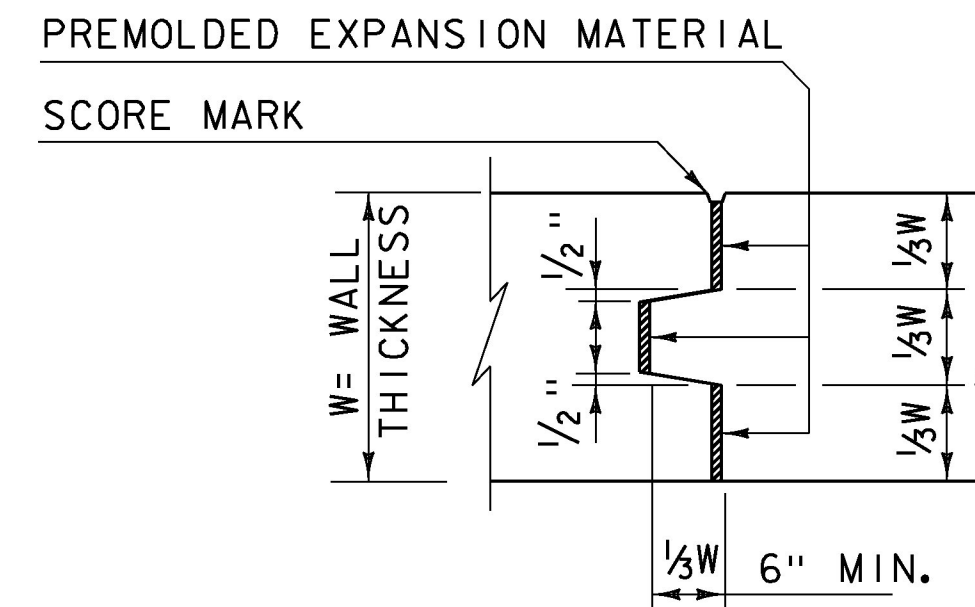

**TYPICAL CONCRETE EXPANSION JOINT**  
(NOT TO SCALE)

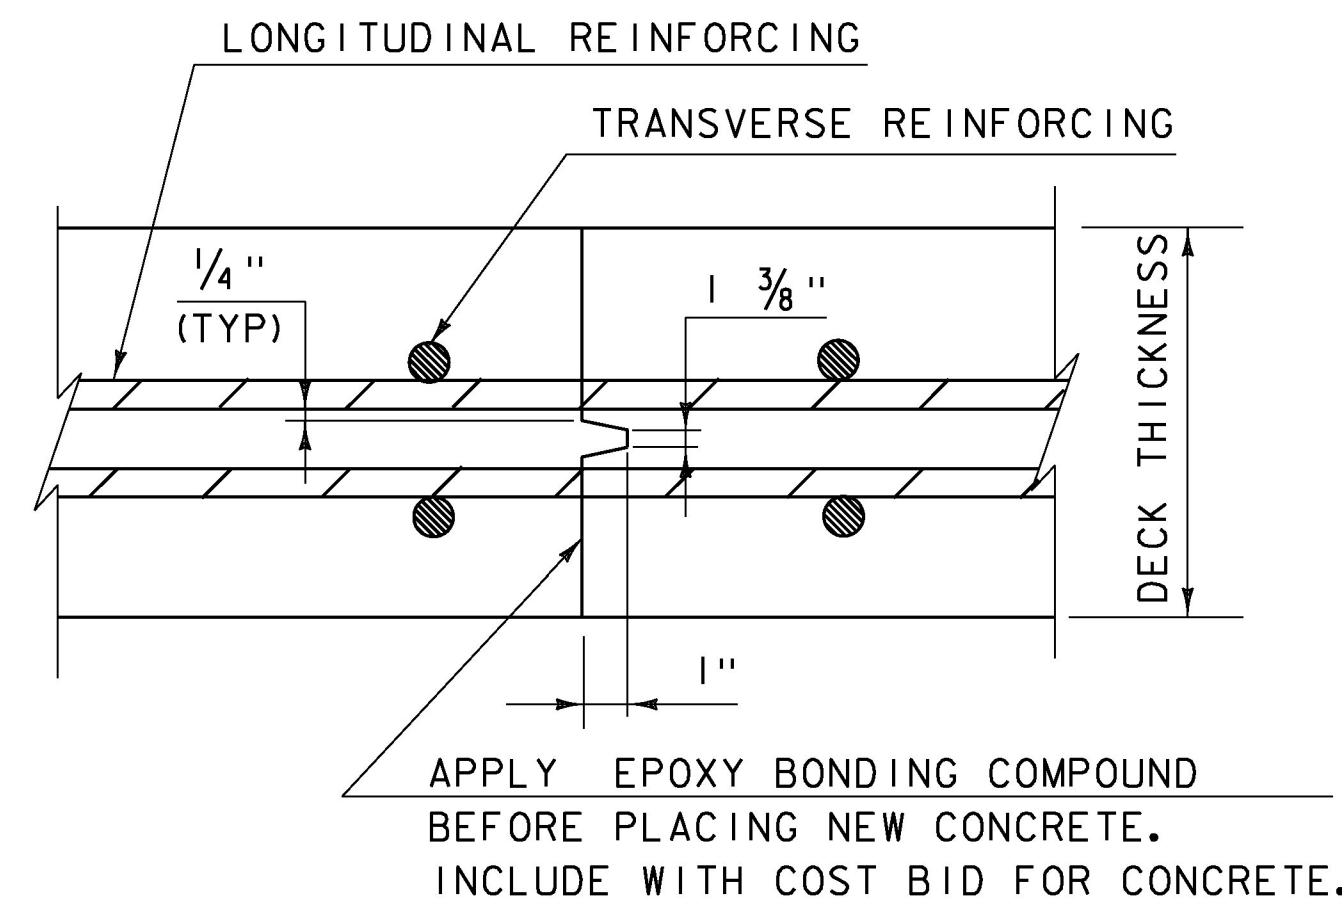


**TRANSVERSE BRIDGE SLAB CONSTRUCTION JOINT DETAILS**  
(NOT TO SCALE)

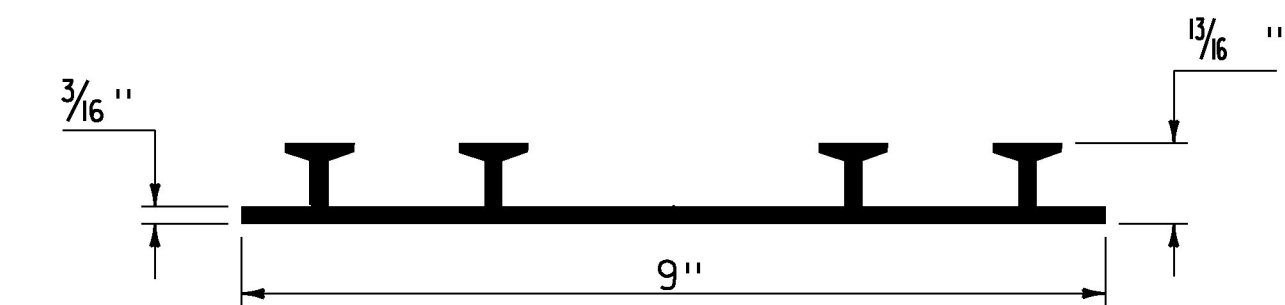

**P.V.C. WATERSTOP FOR CONSTRUCTION JOINTS**  
(NOT TO SCALE)

PAYMENT FOR THE P.V.C. WATERSTOP SHALL BE INCIDENTAL TO THE UNIT BID PRICE FOR THE ADJACENT CONCRETE.


OTHER CONFIGURATIONS OF WATERSTOP MAY BE USED UPON APPROVAL OF THE ENGINEER.

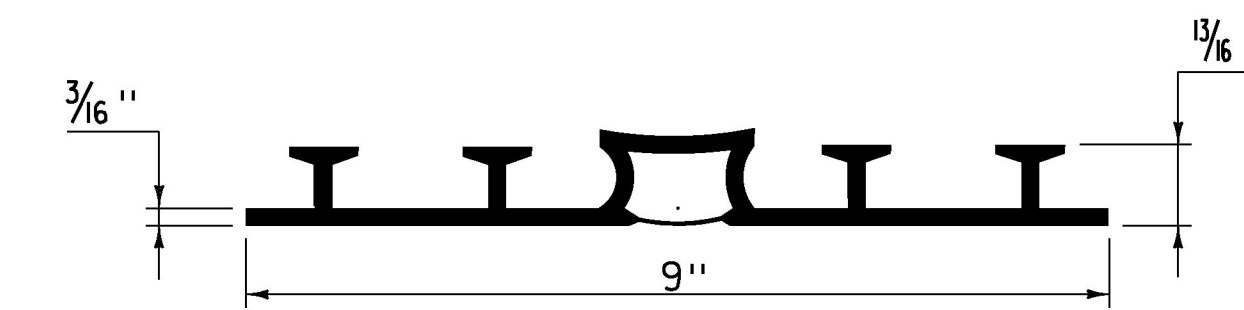

**P.V.C. WATERSTOP FOR EXPANSION JOINTS**  
(NOT TO SCALE)

PAYMENT FOR THE P.V.C. WATERSTOP SHALL BE INCIDENTAL TO THE UNIT BID PRICE FOR THE ADJACENT CONCRETE.

OTHER CONFIGURATIONS OF WATERSTOP MAY BE USED UPON APPROVAL OF THE ENGINEER.

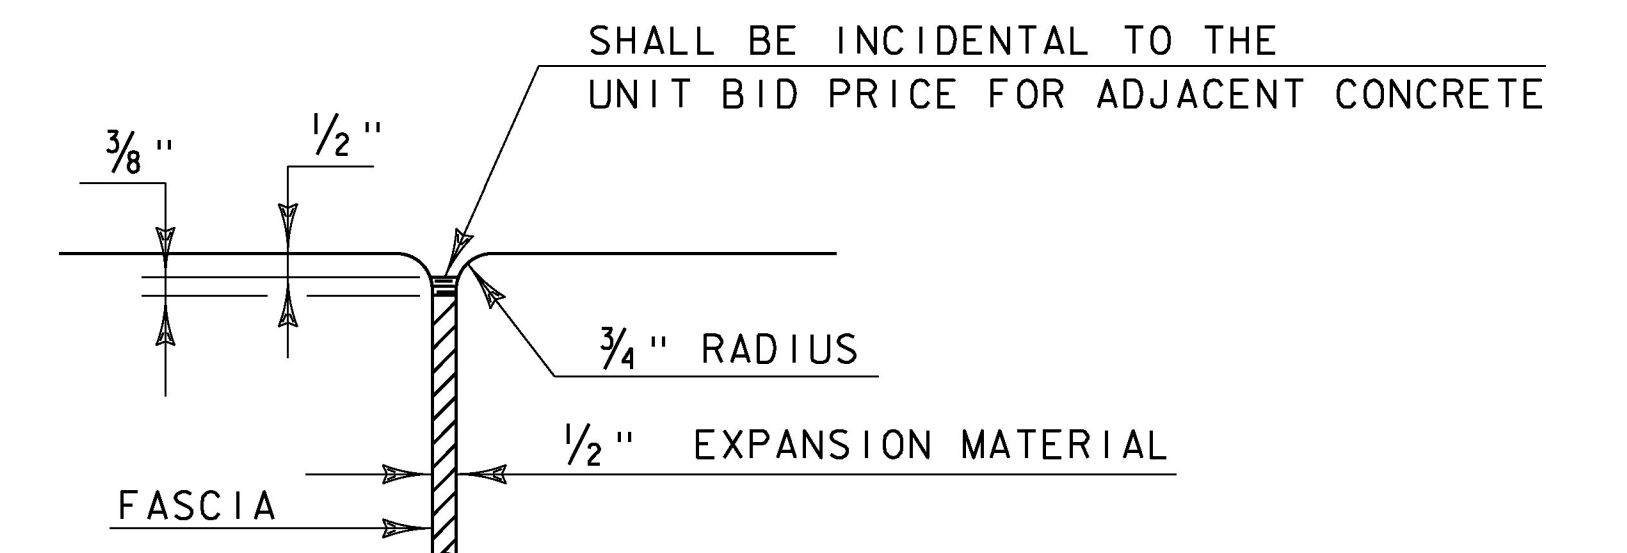


**JOINT BETWEEN FASCIA AND WINGWALL**  
(NOT TO SCALE)


**REVISIONS**

MAY 7, 2010	APPROVED FOR USE BY VAOT STRUCTURES SECTION
FEBRUARY 9, 2012	REBAR SUBSTITUTION ALLOWANCE ADDED TO CONCRETE GENERAL NOTES.


**CONCRETE  
DETAILS AND NOTES**

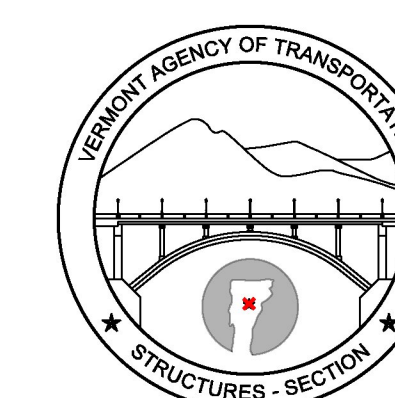


**STRUCTURES  
DETAIL  
SD-501.00**

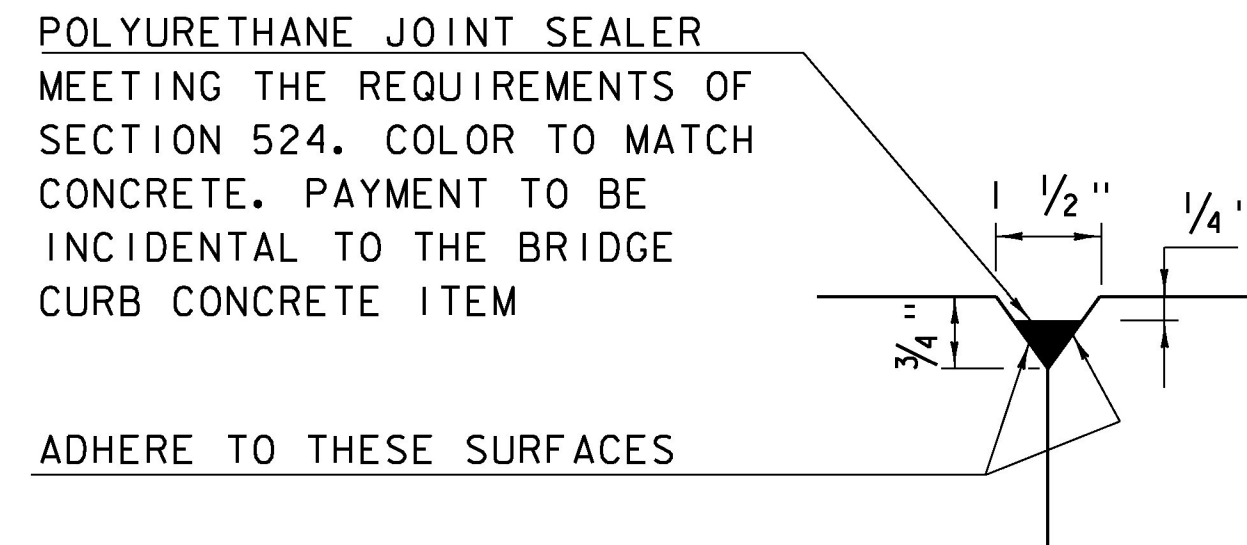


DETAIL "B"  
(NOT TO SCALE)

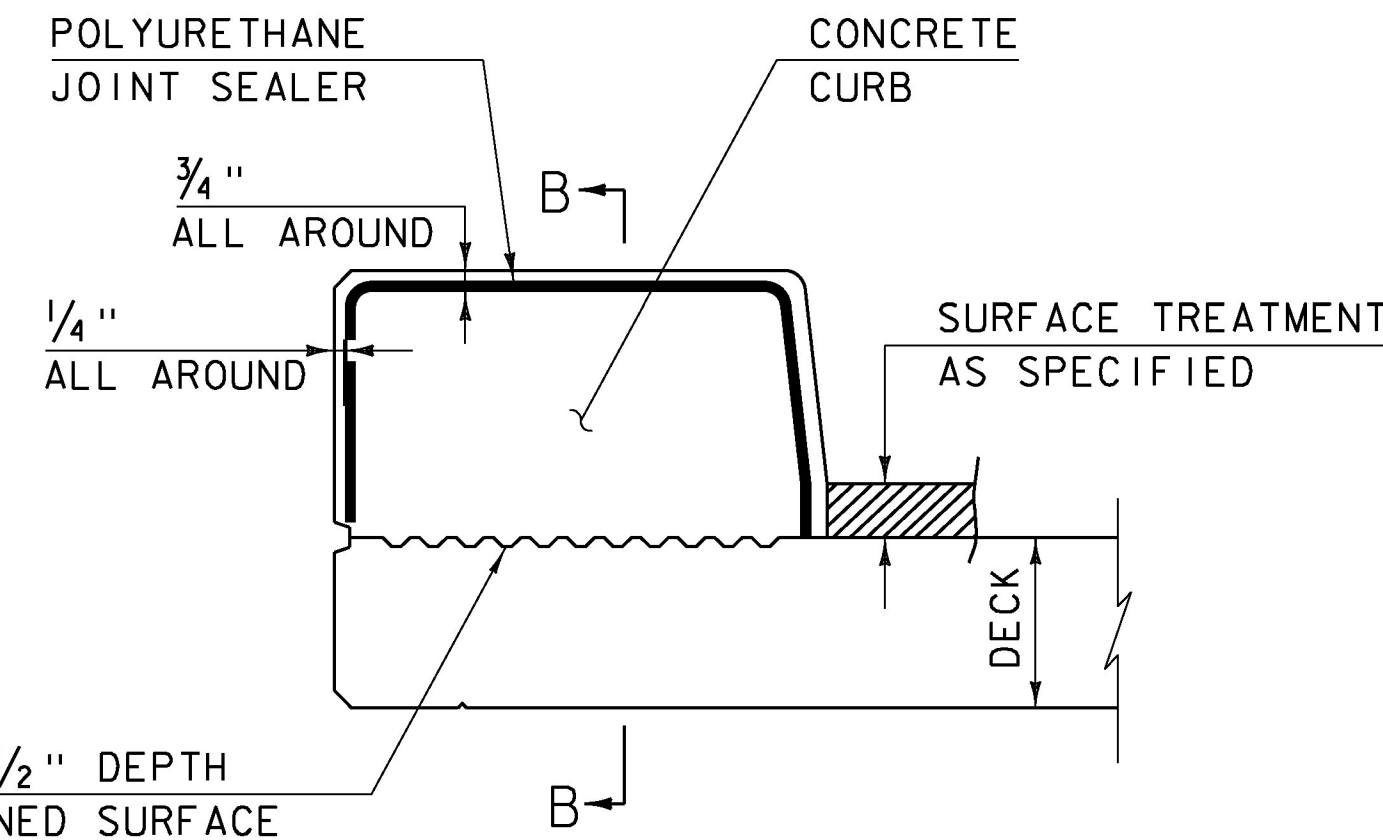

CONCRETE CURB JOINT SECTION  
(NOT TO SCALE)

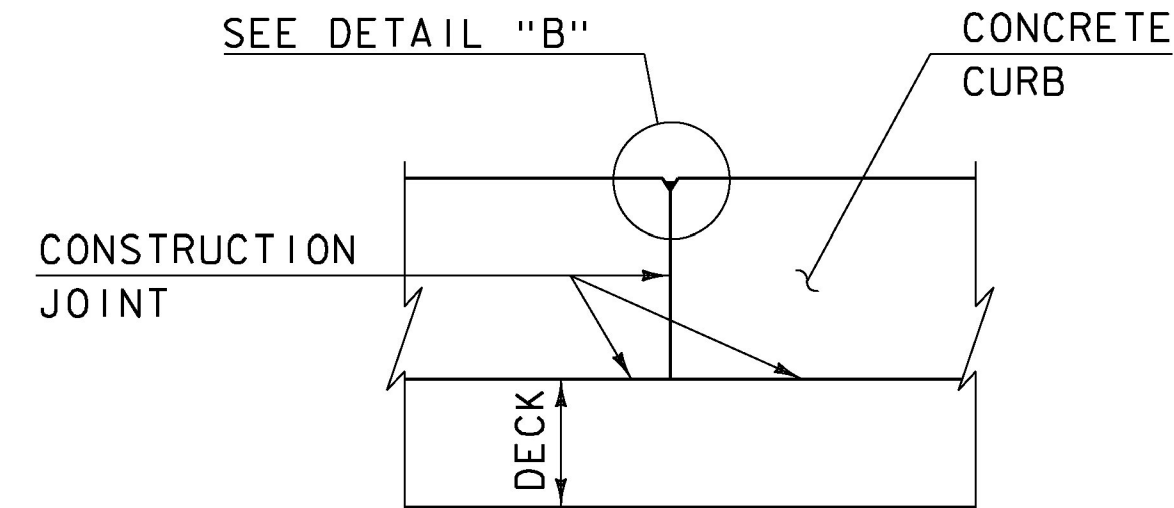


SECTION B - B  
(NOT TO SCALE)

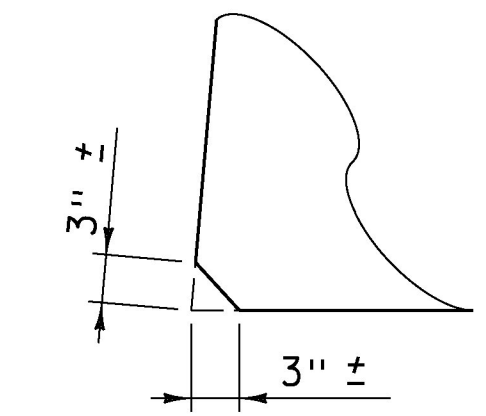


ACUTE ANGLE  
CLIP DETAIL  
(NOT TO SCALE)


- SEE TYPICAL HORIZONTAL CONSTRUCTION JOINT DETAIL FOR ADDITIONAL INFORMATION

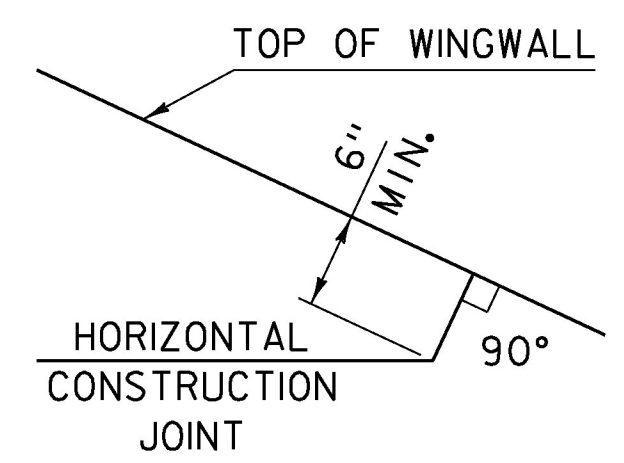


HORIZONTAL WINGWALL  
CONSTRUCTION JOINT  
(NOT TO SCALE)

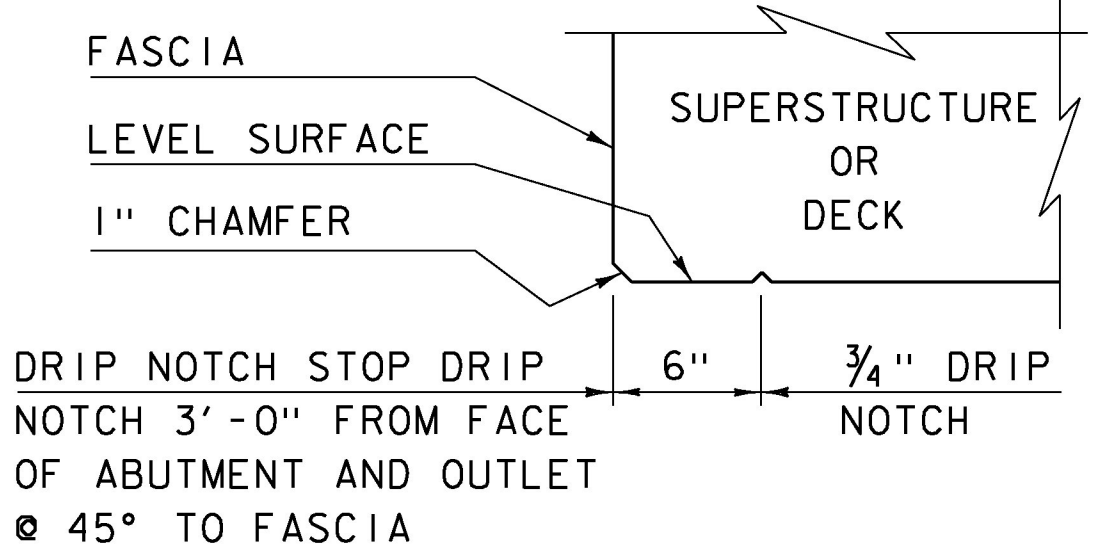

DRIP NOTCH DETAIL  
(NOT TO SCALE)

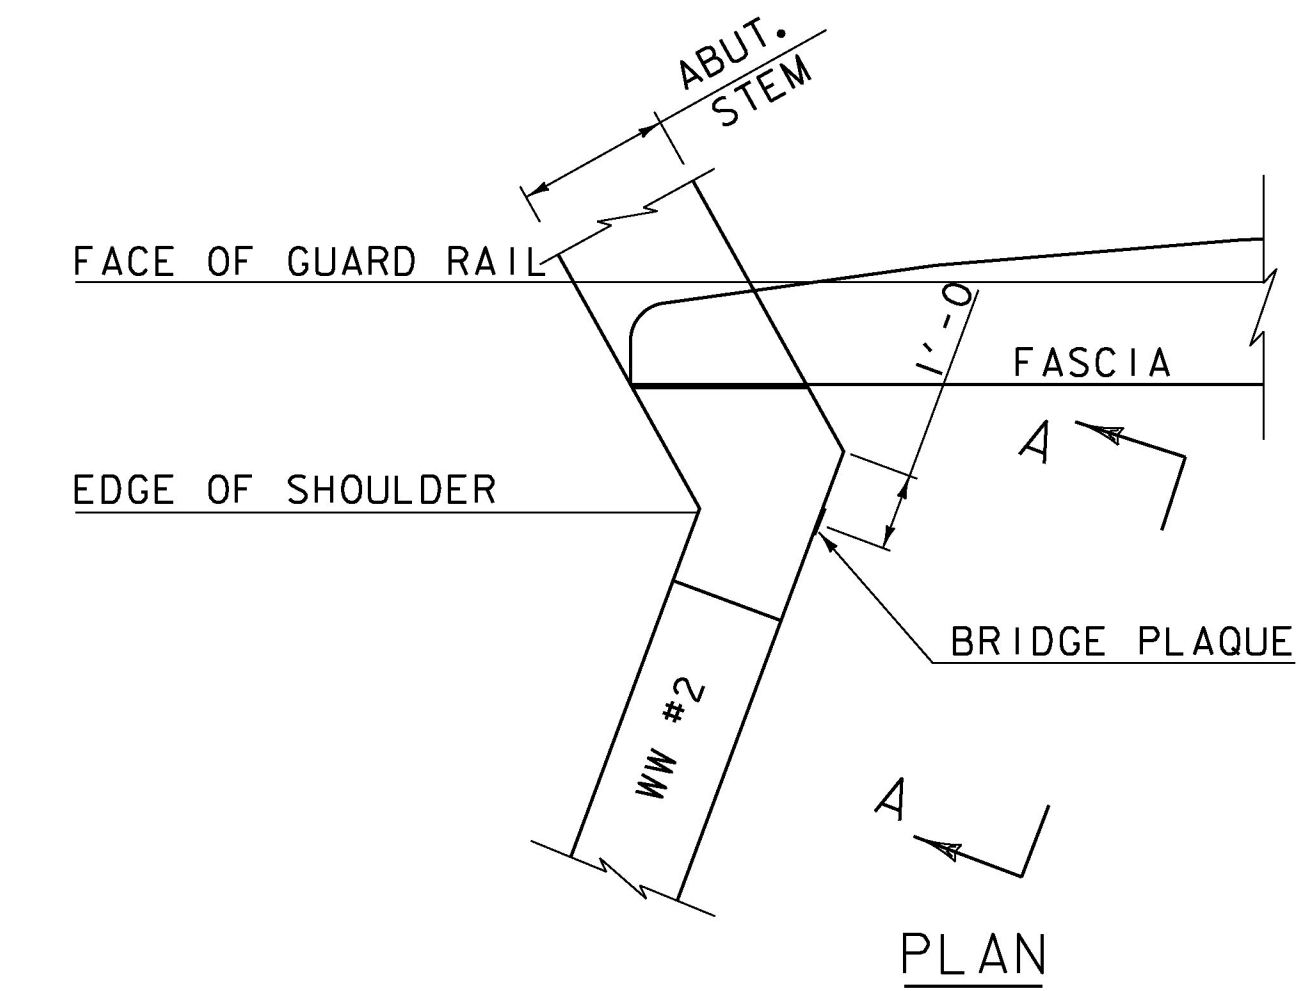

PLAN

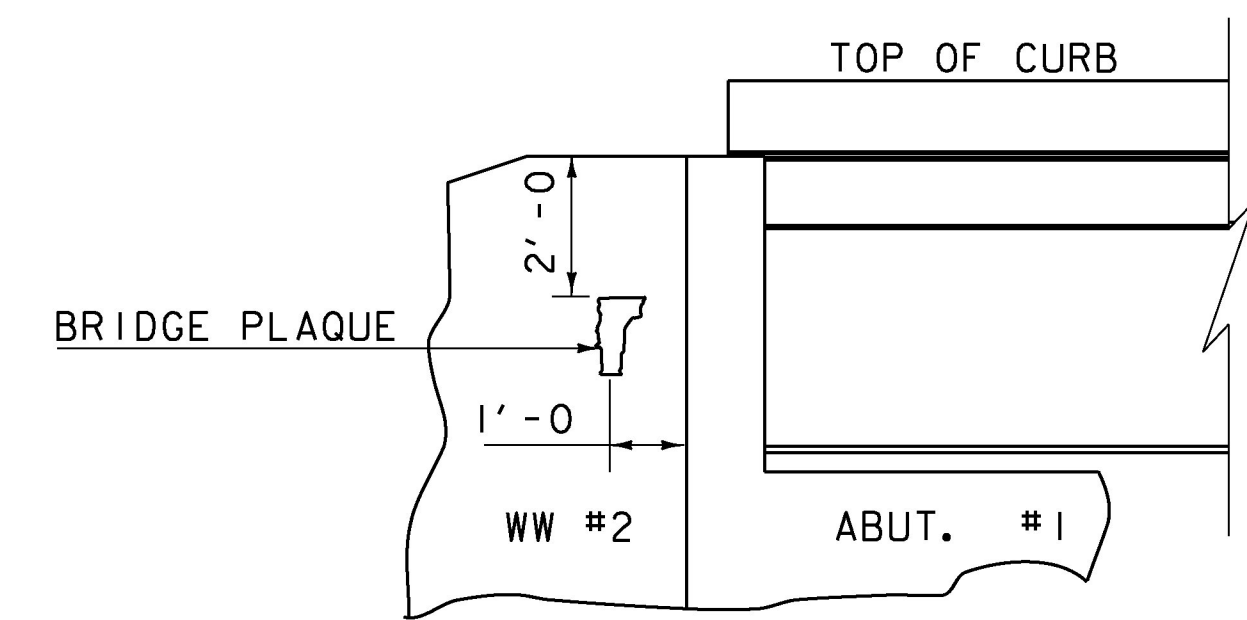

VIEW "A - A"

BRIDGE PLAQUE  
(NOT TO SCALE)

THE BRIDGE PLAQUE WILL BE SUPPLIED BY THE AGENCY OF TRANSPORTATION AND SHALL BE INSTALLED BY THE CONTRACTOR AT ABUTMENT #1 ON THE RIGHT SIDE AS SHOWN OR AS DIRECTED BY THE ENGINEER.

PAYMENT FOR INSTALLATION OF THE BRIDGE PLAQUE SHALL BE INCIDENTAL TO THE ADJACENT CONCRETE.


CONCRETE CURB JOINT NOTES

- CONCRETE CURBS MAY BE PLACED IN ONE CONTINUOUS OPERATION IF AN APPROVED SHRINKAGE REDUCING ADMIXTURE LISTED IN THE SPECIAL PROVISIONS IS USED WITH THE CONCRETE MIX DESIGN. PAYMENT FOR THE SHRINKAGE REDUCING ADMIXTURE WILL BE INCIDENTAL TO THE BRIDGE CURB CONCRETE ITEM.
- IF THE CONTRACTOR CHOOSES NOT TO USE AN APPROVED SHRINKAGE REDUCING ADMIXTURE, THE CURBS SHALL BE CONSTRUCTED WITH CONSTRUCTION JOINTS SPACED AT A MAXIMUM OF 15'-0" CENTER TO CENTER AND 2'-0" MINIMUM FROM THE CENTER OF NEAREST BRIDGE RAILING POST.
- ON MULTI-SPAN CONTINUOUS SUPERSTRUCTURES, REGARDLESS OF WHETHER APPROVED SHRINKAGE REDUCING ADMIXTURE IS USED, CURB JOINTS SHALL BE LOCATED OVER THE CENTERLINE OF PIERS AND 7'-0" EACH SIDE OF THE CENTERLINE OF EACH PIER.
- WHEN CURB JOINTS ARE USED THE CURBS SHALL BE PLACED IN ALTERNATE SECTIONS WITH A MINIMUM OF 48 HOUR DELAY BETWEEN ADJACENT PLACEMENTS.
- LONGITUDINAL REINFORCING SHALL BE CONTINUOUS THROUGH CURB CONSTRUCTION JOINTS. CURB STIRRUP BARS SHALL BE TURNED AS NECESSARY TO MAINTAIN COVER IN THE FLARED CURB ENDS.
- THE JOINT SPACING AND DETAILS SHOWN SHALL APPLY TO SIDEWALKS WHEN SHOWN IN THE PLANS.


REVISIONS

MAY 7, 2010	APPROVED FOR USE BY VAOT STRUCTURES SECTION
JUNE 4, 2010	MODIFIED AND ADDED TWO DETAILS
OCTOBER 10, 2012	MODIFIED HORZ. JOINT WINGWALL ADD 6" MIN. DIMENSION


CONCRETE  
DETAILS AND NOTES

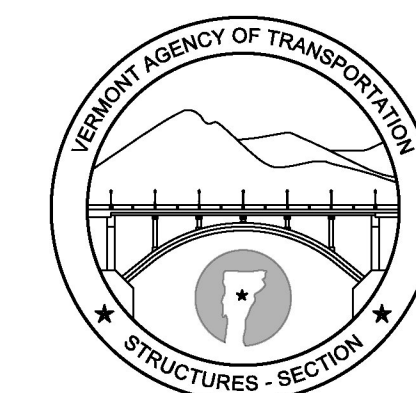


STRUCTURES  
DETAIL  
SD-502.00

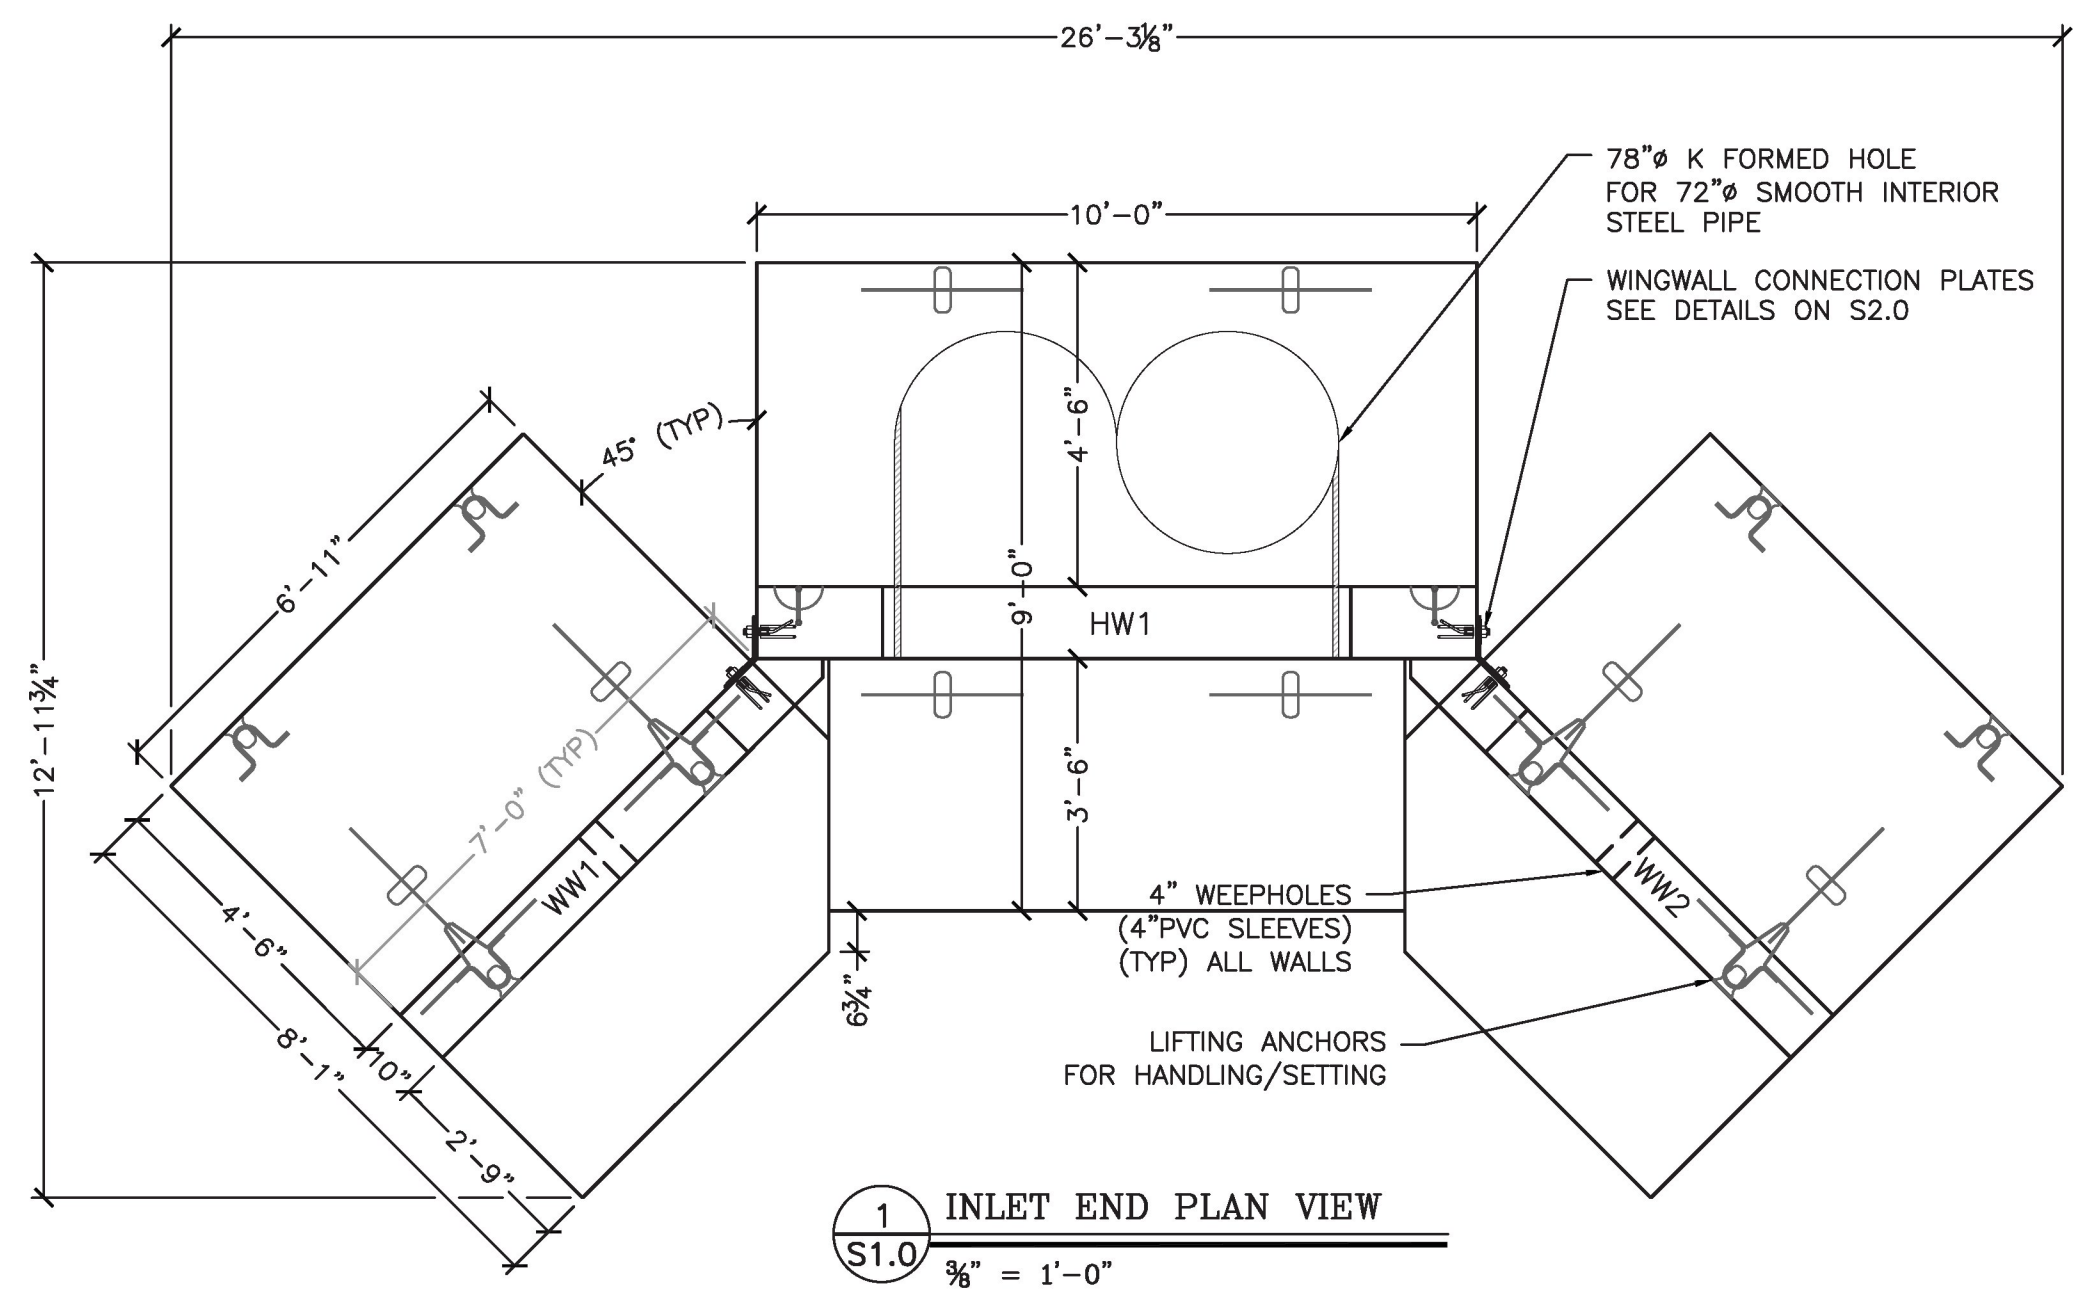


1 INLET END PLAN VIEW  
S1.0 3/8" = 1'-0"

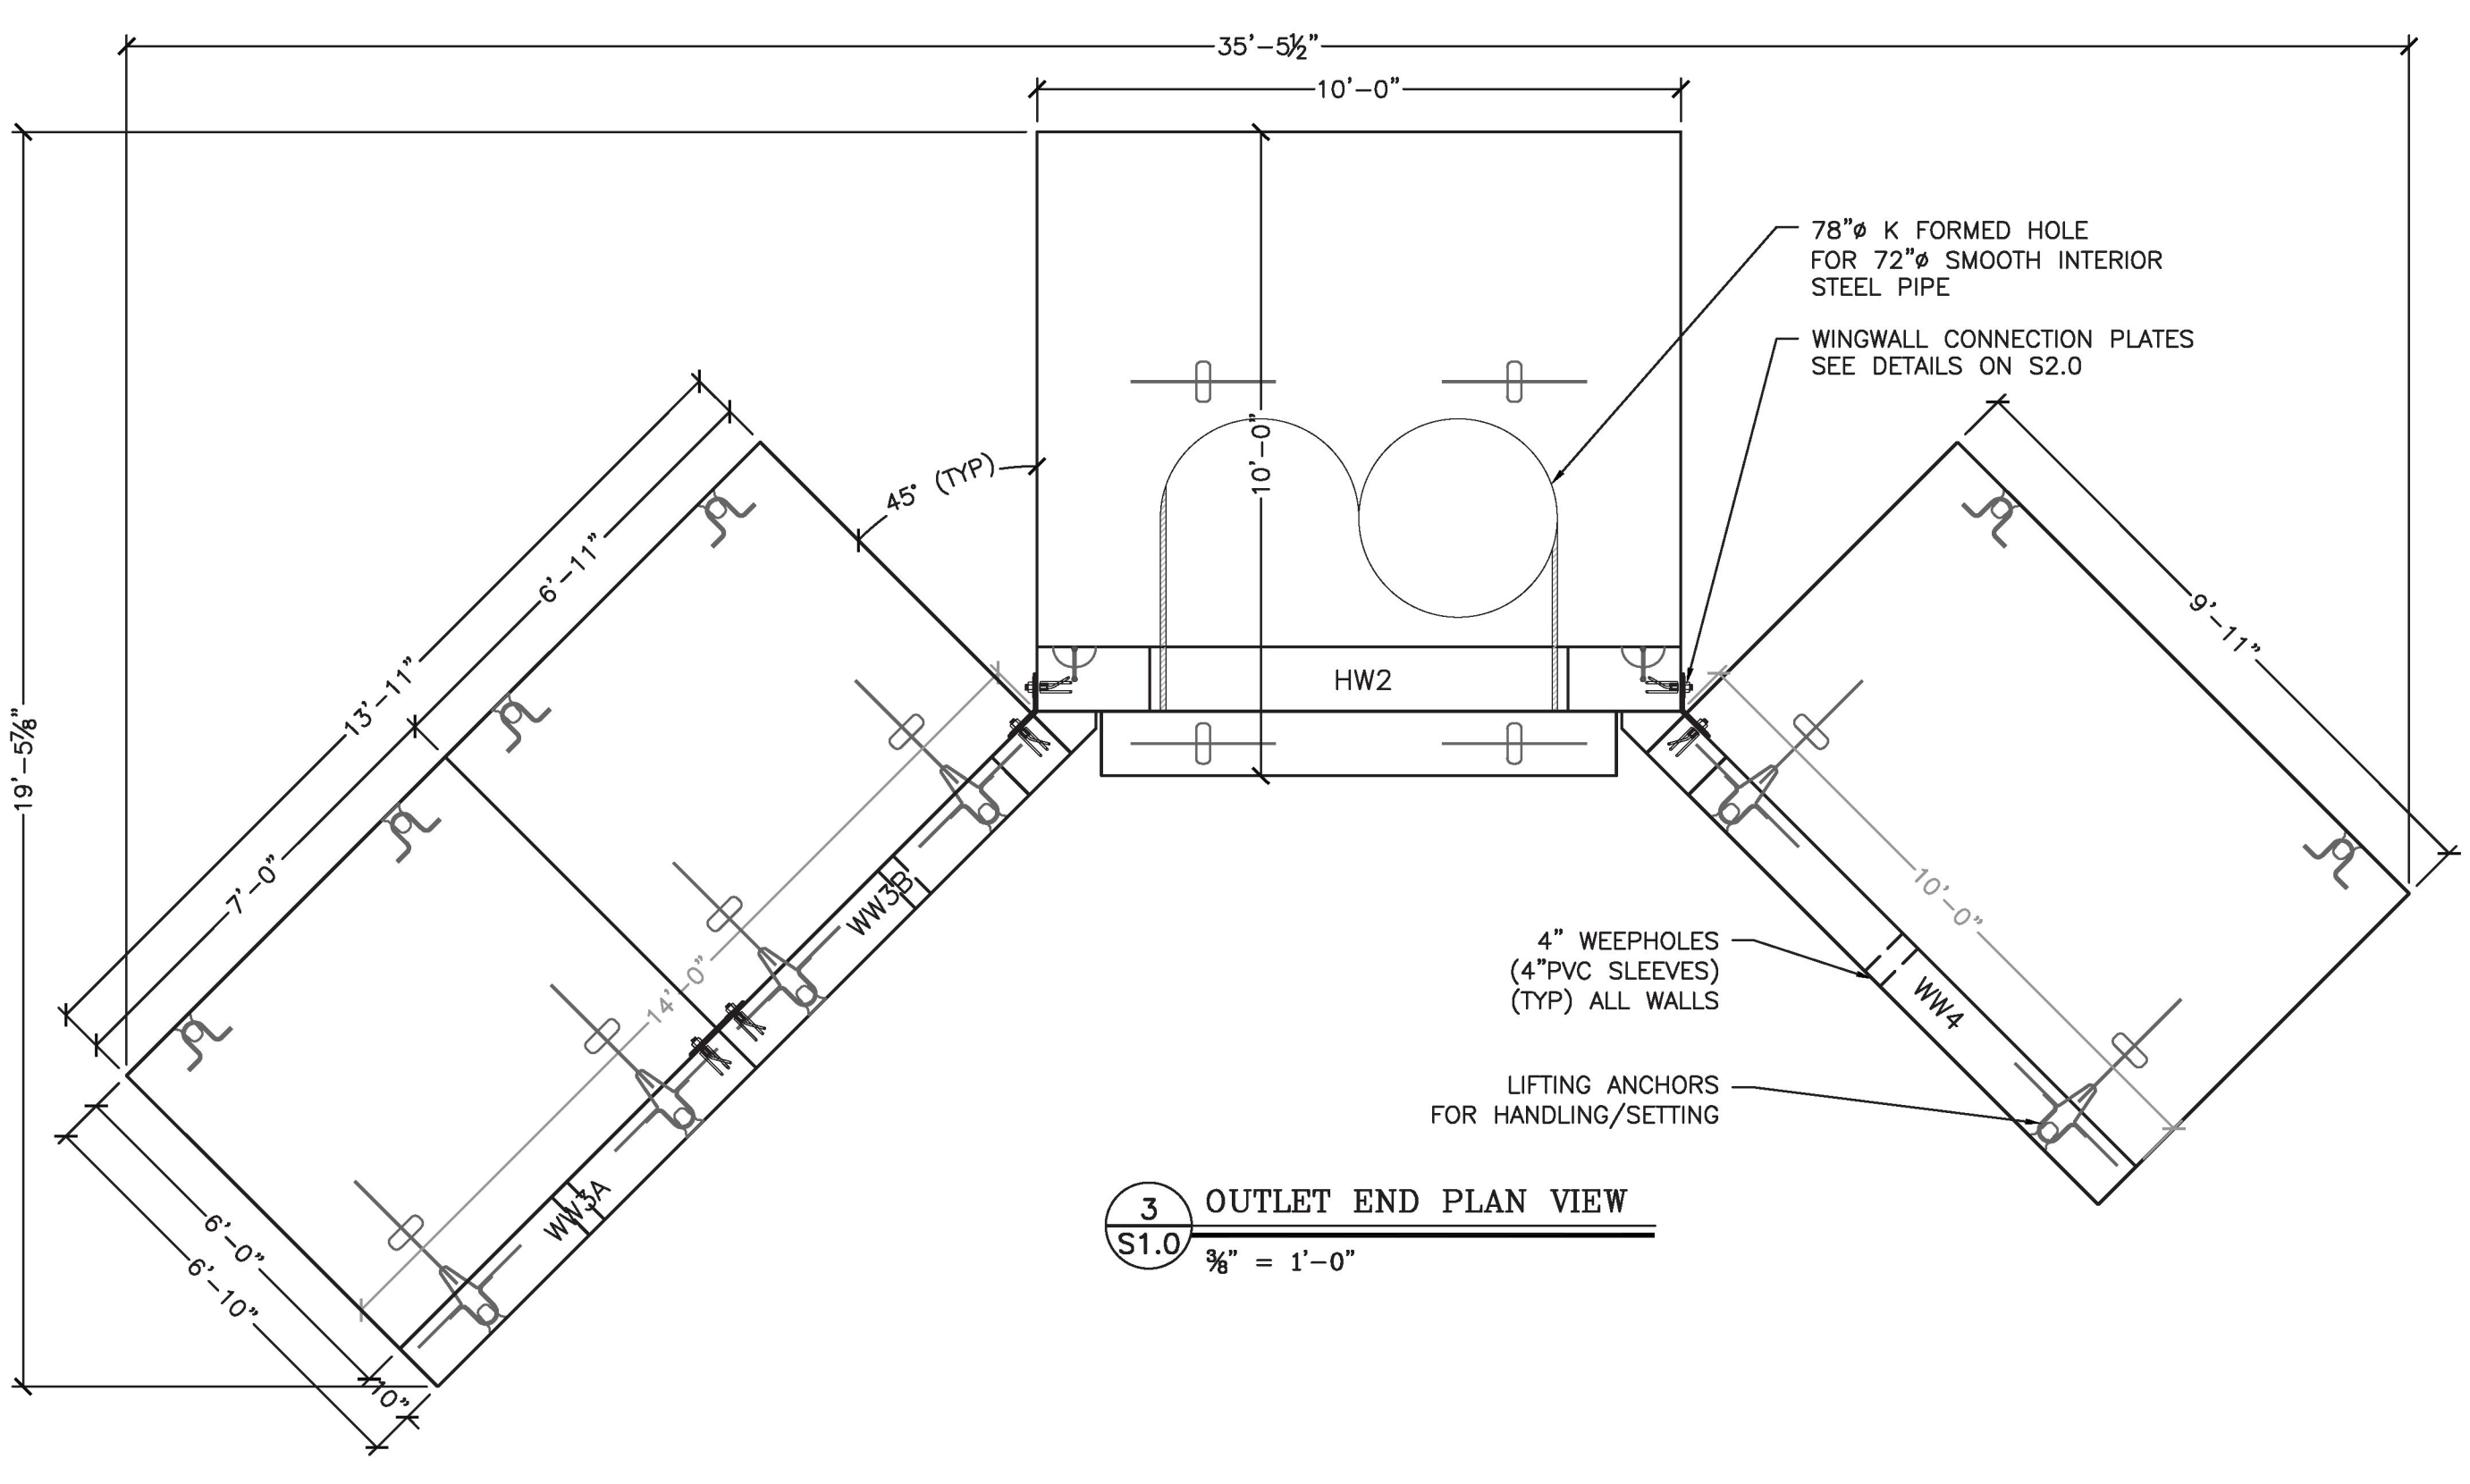

3 OUTLET END PLAN VIEW  
S1.0 3/8" = 1'-0"

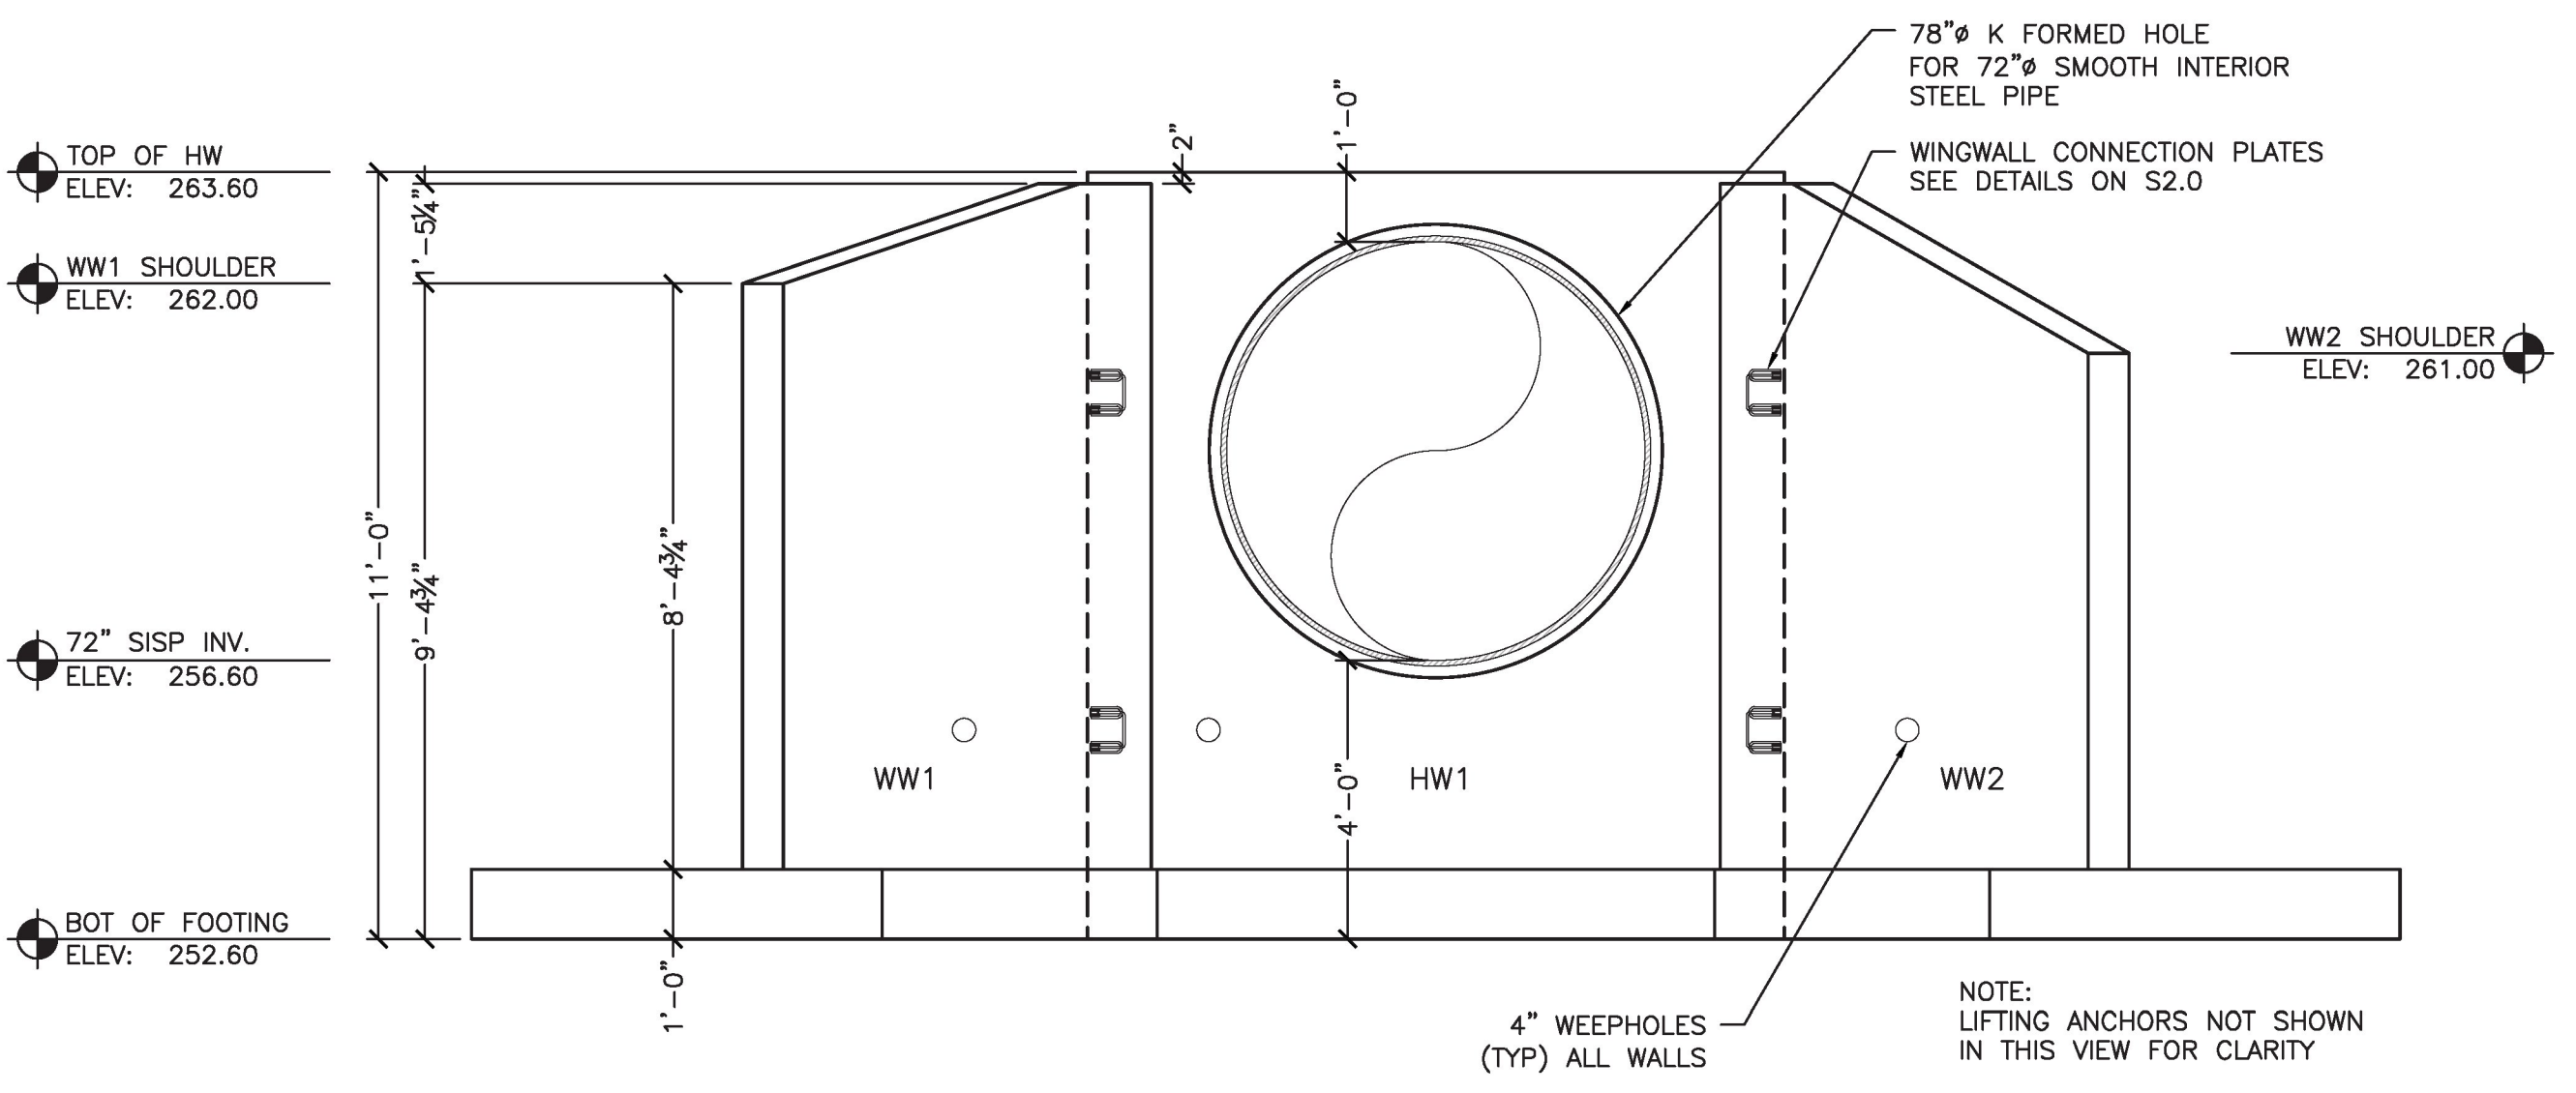

2 INLET END ELEV VIEW  
S1.0 3/8" = 1'-0"

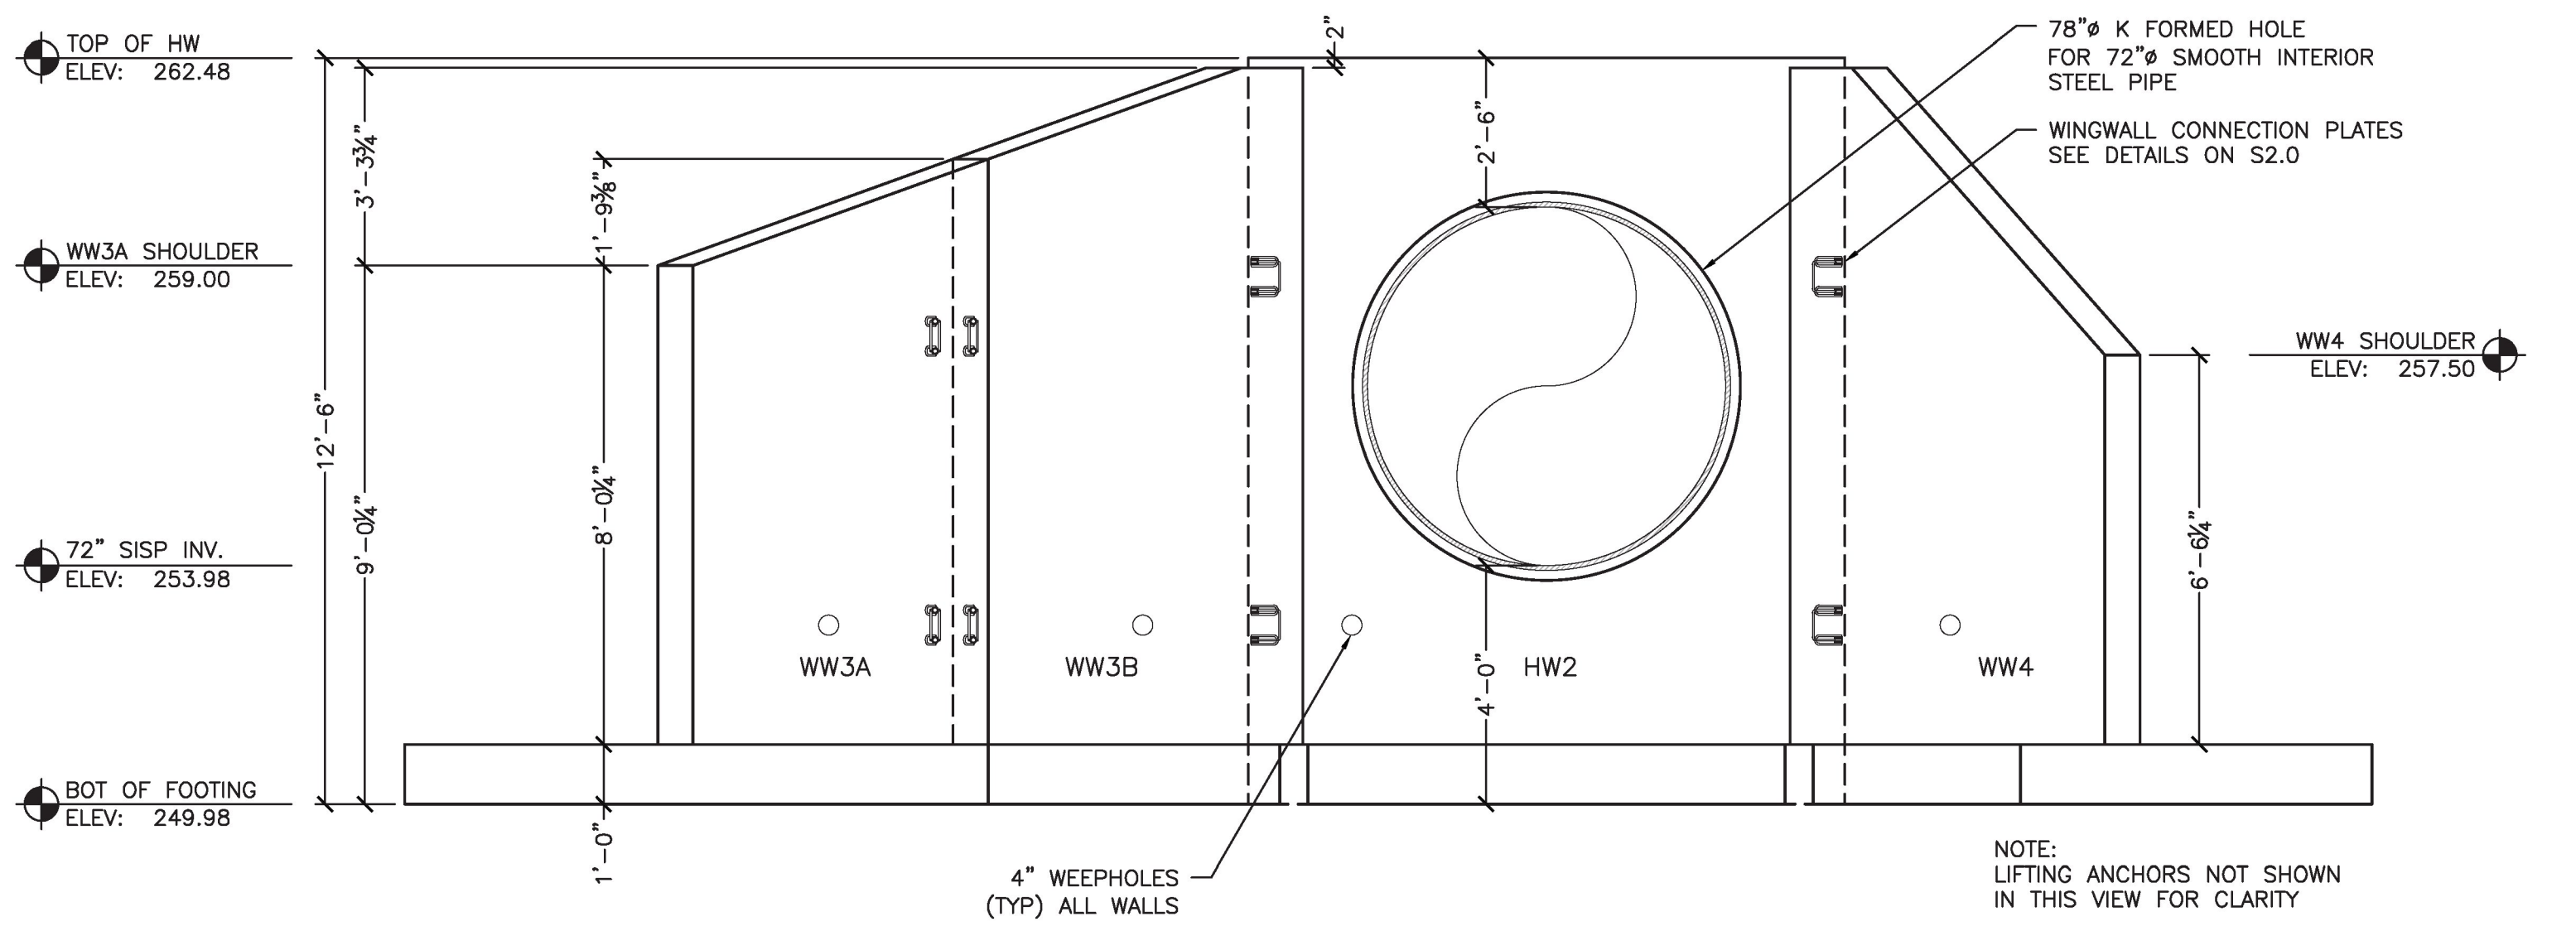

4 OUTLET END ELEV VIEW  
S1.0 3/8" = 1'-0"

- GENERAL NOTES:**
- THE PLANS ARE INTENDED TO BE DRAWN TO SCALE. HOWEVER, IF A CRITICAL DIMENSION IS NOT PROVIDED, MICHE CORPORATION SHOULD BE CONTACTED FOR VERIFICATION.
  - IF ANY OF THE WORK TO BE DONE AS SHOWN ON THE DRAWINGS DOES NOT CORRESPOND WITH THE EXISTING FIELD CONDITIONS, CONTACT THE ENGINEER PRIOR TO PROCEEDING WITH THE WORK IN QUESTION.
  - FIELD-VERIFY ALL ELEVATIONS PRIOR TO THE START OF CONSTRUCTION. IF THERE ARE ANY DISCREPANCIES, CONSULT THE ENGINEER PRIOR TO PROCEEDING WITH THE WORK IN QUESTION.
  - MAINTAIN MINIMUM 60 DEGREE SLING ANGLE WHEN HANDLING PRECAST COMPONENTS.
  - PRECAST COMPONENTS SHALL REACH A MINIMUM COMPRESSIVE STRENGTH OF 3,000 PSI PRIOR TO STRIPPING, AND THE MINIMUM DESIGN COMPRESSIVE STRENGTH PRIOR TO SHIPPING, UNLESS OTHERWISE DIRECTED BY THE ENGINEER.
  - SHOP DRAWINGS WERE DEVELOPED USING THE FOLLOWING RESOURCES FOR THE CONTRACT:
    - PROPOSED IMPROVEMENT, TOWN OF HIGHGATE, VT ROUTE 78 (MAJOR COLLECTOR) BRIDGE #10.1 PREPARED BY THE VAOT, DATED 9/19/2016.
  - IF THERE IS ADDITIONAL INFORMATION PERTINENT TO THE FABRICATION AND INSTALLATION OF THESE UNITS THAT IS NOT CONTAINED WITHIN THE RESOURCES LISTED ABOVE IT SHALL BE BROUGHT TO THE ATTENTION OF MICHE CORPORATION. FAILURE TO MAKE SUCH ADDITIONAL INFORMATION AVAILABLE SHALL RELIEVE MICHE CORPORATION OF ALL LIABILITIES ARISING FROM ERRORS OR OMISSIONS RELATED TO THE OMITTED INFORMATION.
  - ALL VOIDS SHALL BE FILLED WITH NON SHRINK GROUT.

- HEADWALL NOTES:**
- SECTIONS ARE DESIGNED IN ACCORDANCE WITH
    - AASHTO "LRFD BRIDGE DESIGN SPECIFICATIONS", 7TH EDITION
    - STANDARD SPECIFICATION AND GENERAL SPECIAL PROVISIONS SECTION 540.
  - THE FOLLOWING SOIL PROPERTIES WERE USED IN THE DESIGN:
 

SOIL WEIGHT [PCF]	FRICTION ANGLE [DEG]
RETAINED SOIL(INLET) 140	34
FOUNDATION SOIL(INLET) 95	29
RETAINED SOIL(OUTLET) 140	34
FOUNDATION SOIL(OUTLET) 135	38

    - LIVE LOAD SURCHARGE = SEE DESIGN
    - BACKSLOPE ANGLE: SEE DESIGN
    - ALLOWABLE BEARING RESISTANCE = SEE GEOTECH REPORT
  - CONCRETE SHALL BE SELF-CONSOLIDATING CONFORMING TO SECTION 540 WITH A MINIMUM 28-DAY COMPRESSIVE STRENGTH OF 5,000 PSI. AGGREGATE SHALL CONFORM TO SECTION 540 WITH A MAXIMUM DIAMETER OF 3/4". CEMENT SHALL CONFORM TO ASTM C150. MICHE MIX 5035CAS.
  - REINFORCING SHALL BE GRADE 60, DEFORMED BLACK BARS, CONFORMING TO ASTM A-615. ALL BARS SHALL BE BENT COLD.
  - ALL EXPOSED EDGES EXCEPT WHERE NOTED SHALL BE CHAMFERED 1".
  - BACKFILL SHALL CONFORM TO VTRANS SECTION 708.04 GRANULAR BACKFILL FOR STRUCTURES. BACKFILL SHALL EXTEND BEYOND THE HORIZONTAL LIMITS OF THE STRUCTURE AS DETAILED IN THE CONTRACT DOCUMENTS. PLACEMENT SHALL CONFORM TO VTRANS SECTION 204.08

**PRODUCTION CONTROL PROCEDURES**

- CYLINDER SAMPLING AND CURING:
  - A MINIMUM OF EIGHT (8) CYLINDERS PER LOT WILL BE MADE IN ACCORDANCE WITH ASTM C31. CYLINDERS WILL BE TESTED IN ACCORDANCE WITH ASTM C39.
  - UNIT WEIGHT (ASTM C138), AIR CONTENT (ASTM C231), SPREAD PER SCC GUIDELINES, AND TEMPERATURE TESTS WILL BE TAKEN INITIALLY FOR EACH BATCH, NOT TO EXCEED NINE (9) CUBIC YARDS. THE FREQUENCY OF SOME TESTS MAY BE REDUCED WHEN THE VIRANS REPRESENTATIVE DETERMINES THAT THE PRECASTER IS CONSISTENT IN HIS BATCHING OPERATION. THESE TESTS WILL BE TAKEN PRIOR TO PLACING CONCRETE IN FORM.

NOTE: 1 AIR TEST PER BATCH (OR DELIVERY TRUCK) IS REQUIRED, AND SHALL NOT BE REDUCED.

  - ALL CAST CYLINDERS WILL BE CURED IN THE SAME MANNER AS THE PIECES THEY REPRESENT.
- CYLINDER BREAKS:
  - FOR EARLY STRENGTH VERIFICATION, CYLINDERS MAY BE BROKEN AT ANY TIME UP TO 28 DAYS AFTER CASTING. IF THE AVERAGE STRENGTH OF TWO (2) CYLINDERS MEETS OR EXCEEDS THE REQUIRED 28 DAY STRENGTH (WITH EACH CYLINDER HAVING A MINIMUM OF 95% OF THE REQUIRED 28 DAY STRENGTH), THE LOT SHALL BE ACCEPTED FOR STRENGTH.
- QUALITY CONTROL TEST AND EQUIPMENT:
 

CYLINDER TESTER:	FORNEY 500 SERIES WITH DR-2 DIGITAL READOUT CALIBRATED BIANNUALLY
AIR METER:	PRESSURE METER BY FORNEY (CALIBRATED MONTHLY)
SLUMP CONE:	STANDARD 8" BASE, 4" AT RIM, 12" IN HEIGHT MEASURED IN ACCORDANCE WITH SCC GUIDELINES
SCALES FOR UNIT WEIGHT:	MEASURED IN ACCORDANCE WITH ASTM C143 100 LBS. CAPACITY CALIBRATED ANNUALLY TO THE NEAREST 1/10TH POUND 4" DIAMETER X 8" PLASTIC
- CONCRETE TESTING AND AIR METER CALIBRATION WILL BE DONE BY PLANT PERSONNEL (ACI GRADE 1 CERTIFIED) ALL TESTING PRODUCERS WILL BE OBSERVED BY VERMONT INSPECTORS OR AUTHORIZED REPRESENTATIVES.

**CURING**

- THIS SECTION APPLIES TO ALL PRECAST PIECES CAST IN EACH RESPECTIVE LOT. ALL CURING PROCEDURES SHALL ADHERE TO THE REQUIREMENTS OF SECTION 540.08 OF THE VT STANDARD SPECIFICATIONS FOR CONSTRUCTION 2011 EDITION.
- AS SOON AS PRACTICAL AFTER PLACEMENT OF FRESH CONCRETE THE CASTING FORMS SHALL BE COVERED WITH POLYETHYLENE SHEETING UNTIL STRIPPING STRENGTH HAS BEEN ACHIEVED.
- ONCE STRIPPING STRENGTH HAS BEEN ACHIEVED THE PRECAST PRODUCT SHALL BE REMOVED FROM THE FORM AND PLACED IN A DESIGNATED CURING AREA (INTERIOR OR EXTERIOR DEPENDING ON WEATHER CONDITIONS)
- AT THE DESIGNATED CURING AREA THE PRECAST SHALL BE CURED USING ONE OF THE APPROVED METHODS IN SECTION 501.17 UNTIL DESIGN STRENGTH HAS BEEN ACHIEVED.
  - FOR VAOT PROJECT# STP SCRP (12) - HIGHGATE, VT ROUTE 78 - BRIDGE #10, THE FOLLOWING METHOD WILL BE UTILIZED: 501.17 (4) - WHITE POLYETHYLENE SHEETING METHOD.
- THE TEMPERATURE MONITORING METHOD WILL BE DETERMINED DURING THE PRE-CONSTRUCTION MEETING WITH THE CONTRACTOR AND VAOT PERSONNEL.
- AS SOON AS THE DESIGN STRENGTH HAS BEEN ACHIEVED THE PRODUCT WILL BE REMOVED FROM THE CURING AREA AND TRANSPORTED TO THE STAGING AREA WHERE IT WILL BE STORED UNTIL SHIPPING.

**FINISH**

- ALL PRECAST COMPONENTS WILL HAVE A STEEL FORM FINISH ON THE VISIBLE FACES. THE BURIED SIDE OF THE WINGWALLS AND CURB WALLS WILL BE THE POUR FACE AND WILL HAVE A STEEL TROWEL FINISH. THE BRIDGE SECTIONS WILL HAVE A STEEL FORM FINISH ON ALL FACES EXCEPT THE TOP OF THE DECK. THIS WILL HAVE A STEEL TROWEL FINISH.
- ANY AND ALL REPAIR PROCEDURES WILL ADHERE TO NPCA BEST PRACTICES, AND WILL BE GENERATED SPECIFICALLY FOR THE APPLICATION AT THE TIME OF NEED.

**HANDLING/STORAGE**


- ONCE STRIPPING STRENGTH HAS BEEN ACHIEVED, ALL PRECAST COMPONENTS WILL BE REMOVED FROM THE FORMS USING OVERHEAD CRANES. THE PIECES WILL THEN BE PLACED ON FLATBED TRAILERS AND TRANSPORTED TO THE CURING AREA, OR STORAGE YARD WHERE THEY WILL EITHER BE PLACED ON DUNNAGE (WINGWALLS) OR DIRECTLY ON THE GROUND (CULVERT). ONCE THE CURING PROCESS HAS REACHED DESIGN STRENGTH, THE PRECAST WILL BE HANDLED USING THE INDICATED LIFTERS/ANCHORS AND APPROPRIATE RIGGING, IN PREPARATION FOR SHIPPING ON FLAT BED TRAILERS. PLACEMENT OF THE DUNNAGE WILL GENERALLY FOLLOW THE 3/8 RULE OR BE PLACED UNDER THE LIFTERS, HOWEVER FINAL DECISIONS REGARDING PLACEMENT WILL BE THAT OF THE MANUFACTURER/DESIGNER.

**BILL OF MATERIALS**

QTY	DESCRIPTION	IN STOCK		DATE	
		IN	FROM	ORDERED	DELIVERED
<b>ITEMS CAST-IN</b>					
7LF	4" DIA PVC PIPE FOR WEEP HOLES				
60	5 TON UTILITY ANCHORS				
20	1-8NC 6X6 DWA				
<b>ITEMS FOR PRESHIPPING/PREP.</b>					
<b>ITEMS TO SHIP TO THE JOB</b>					
8	(10'X14'X1/2" GALV. STEEL WW PLATE (135 DEG)				
2	(10'X14'X1/2" GALV. STEEL WW PLATE (180 DEG)				
40	1" DIA X 5" NC THREAD ROD W/ NUT				
40	4"X4"X1/4" PLATE WASHER				

**SHEET LIST**

S1.0 LAYOUT AND ELEVATION VIEWS
S2.0 INLET HEADWALL DETAILS
S3.0 OUTLET HEADWALL DETAILS

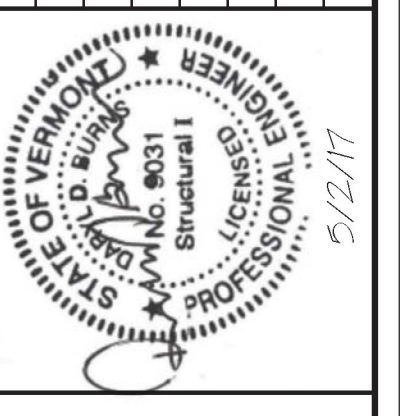


**MICHE CORPORATION**  
173 BUXTON INDUSTRIAL DRIVE - PO BOX 870  
HENNIKER, NH 03248  
PHONE 603-498-3218  
WWW.MICHECORP.COM

**VT Route 78 - VAOT # STP SCRP (12)**  
**Highgate, VT**  
**Special Headwalls - 72"Ø SI Steel Pipe**

Project No. 7910  
Date: 3/7/2017  
Drawn by: CJP  
Checked by: Delta  
Scale: AS SHOWN  
By: Delta


Prepared for:  
**Casella Construction, Inc.**  
25 Industrial Ave.  
Mendon, VT 05701

DWG NO.  
**S1.0**

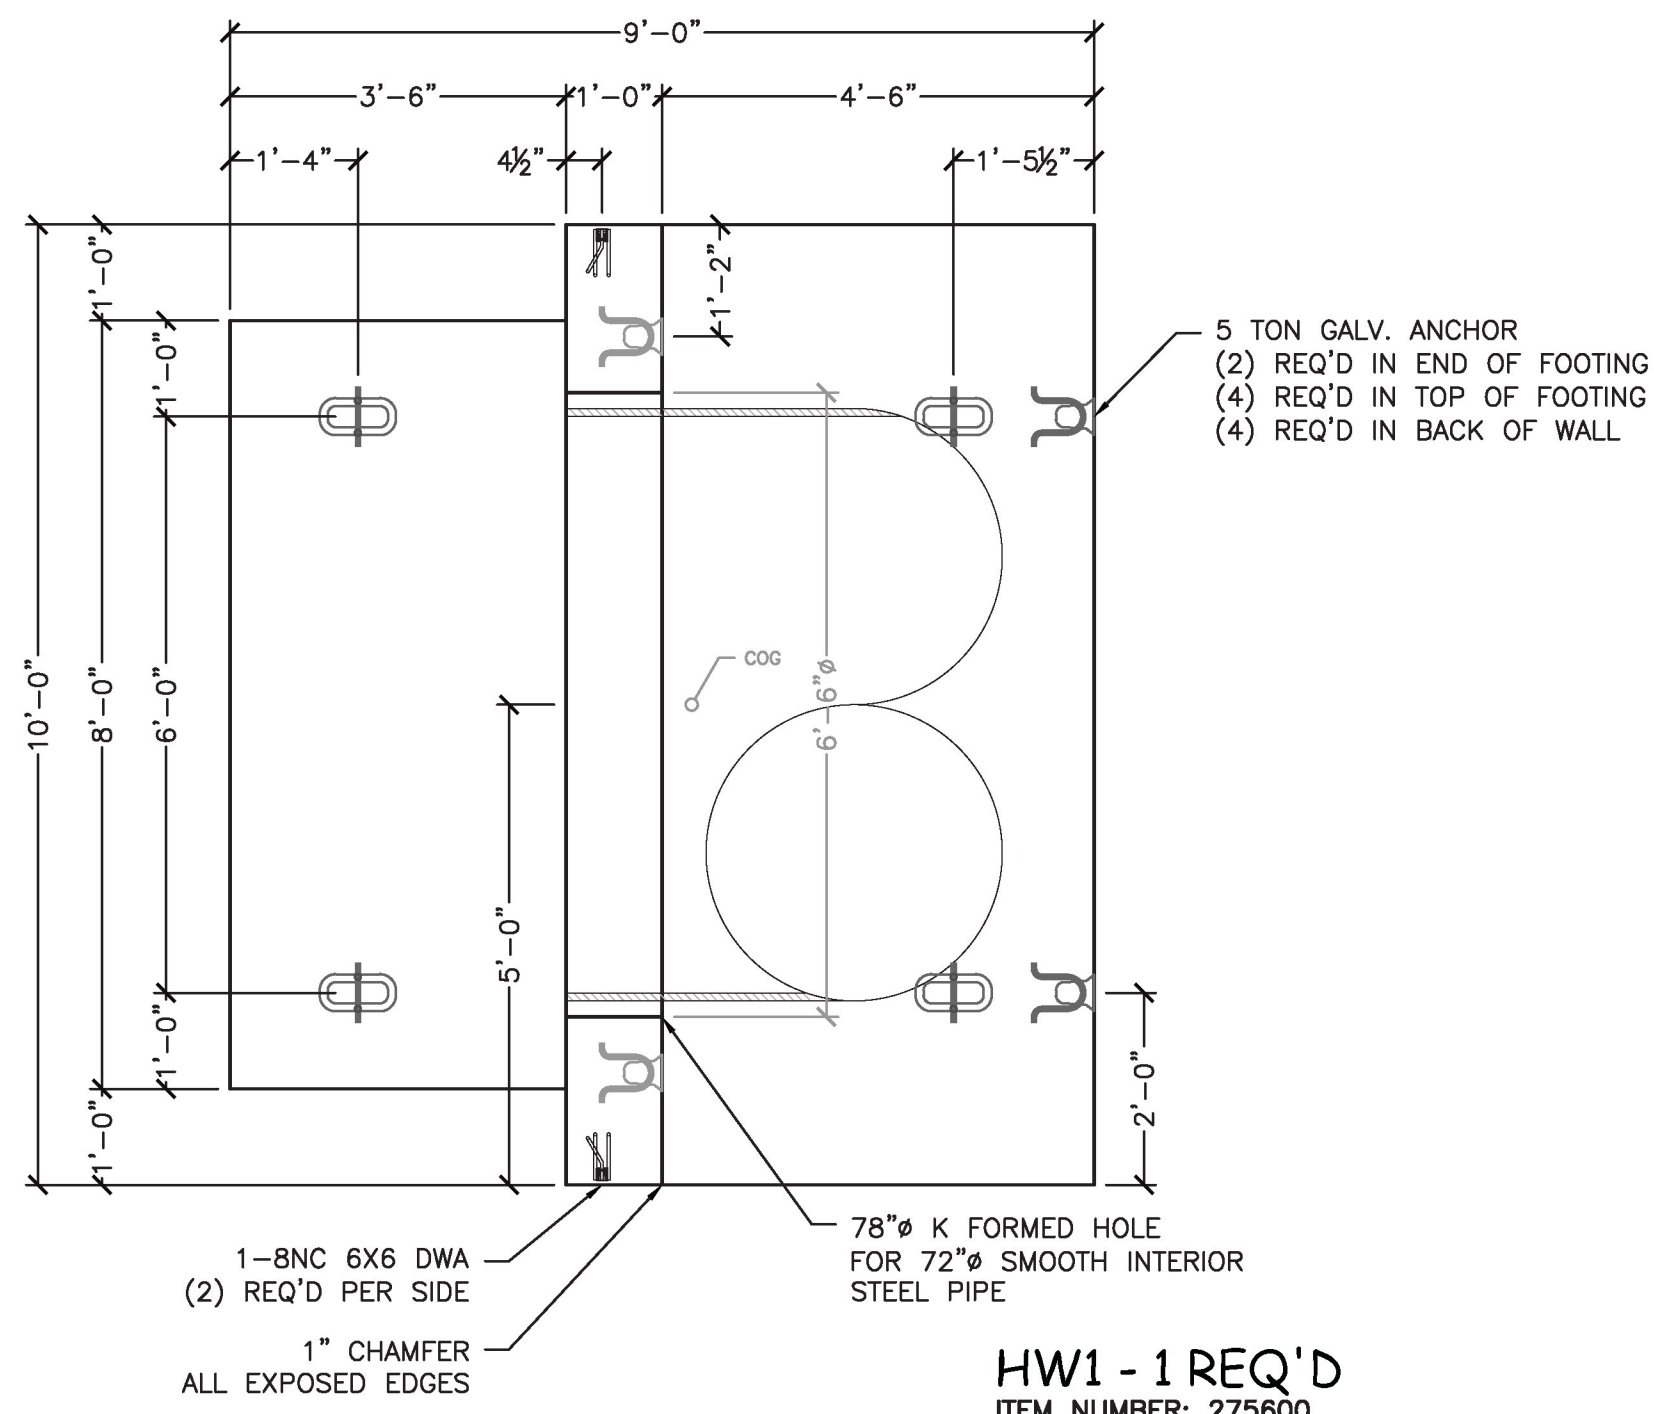

**1 HW1 PLAN VIEW**  
S2.0  
1/2" = 1'-0"

**HW1 - 1 REQ'D**  
ITEM NUMBER: 275600  
UNIT WEIGHT AND VOLUME:  
FOOTING: 3.08CY (12,940#)  
WALL: 2.47CY (10,370#)  
TOTAL WEIGHT: 23,310#

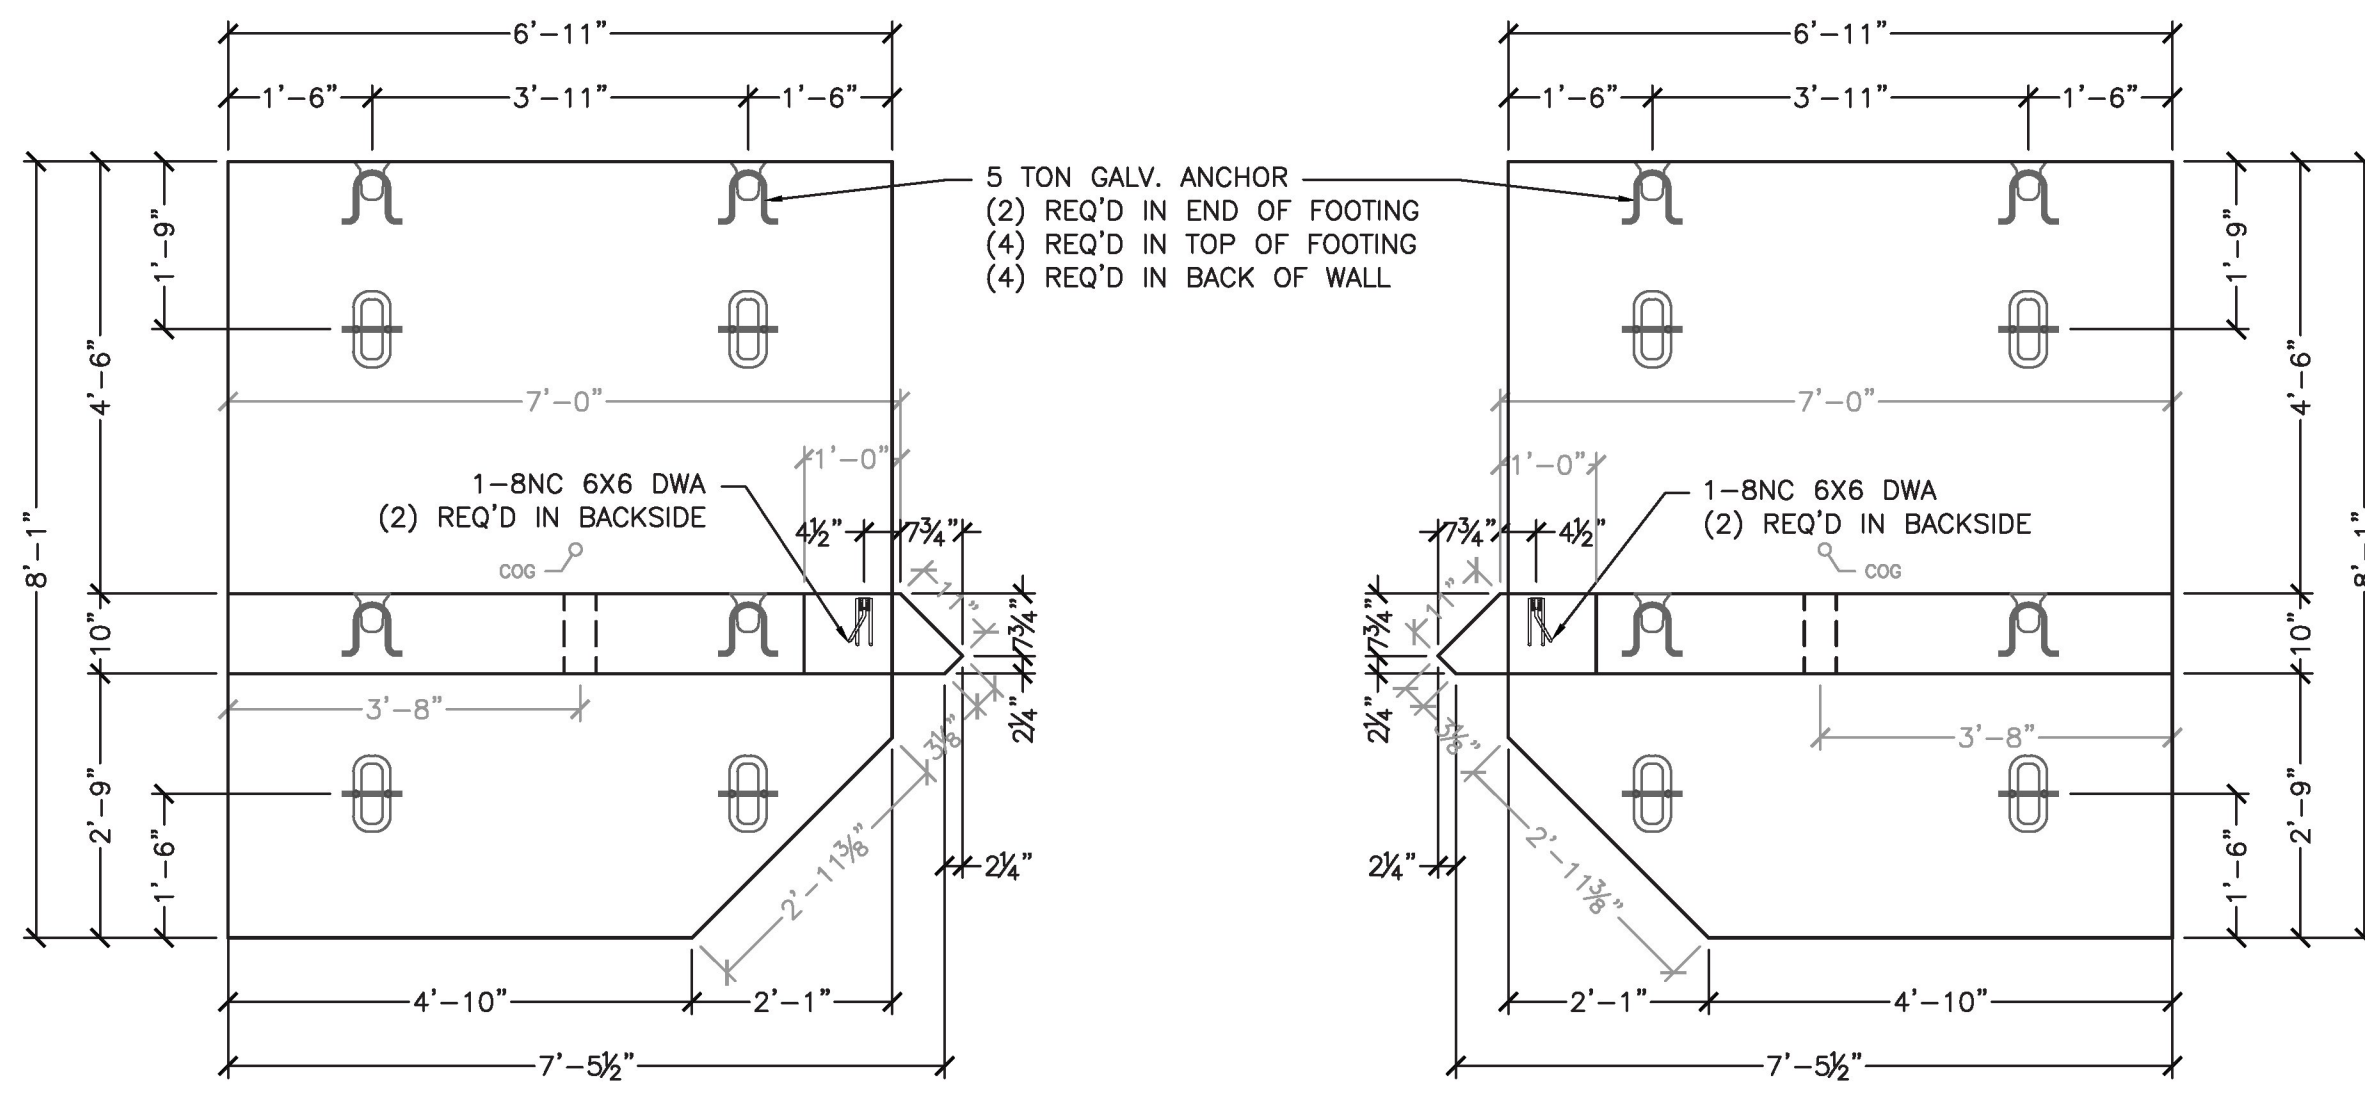


**4 WW1 PLAN VIEW**  
S2.0  
1/2" = 1'-0"

**WW1 - 1 REQ'D**  
ITEM NUMBER: 275600  
UNIT WEIGHT AND VOLUME:  
FOOTING: 2.00CY (8,400#)  
WALL: 2.09CY (8,820#)  
TOTAL WEIGHT: 17,220#

**6 WW2 PLAN VIEW**  
S2.0  
1/2" = 1'-0"

**WW2 - 1 REQ'D**  
ITEM NUMBER: 275600  
UNIT WEIGHT AND VOLUME:  
FOOTING: 2.00CY (8,400#)  
WALL: 2.09CY (8,820#)  
TOTAL WEIGHT: 17,220#

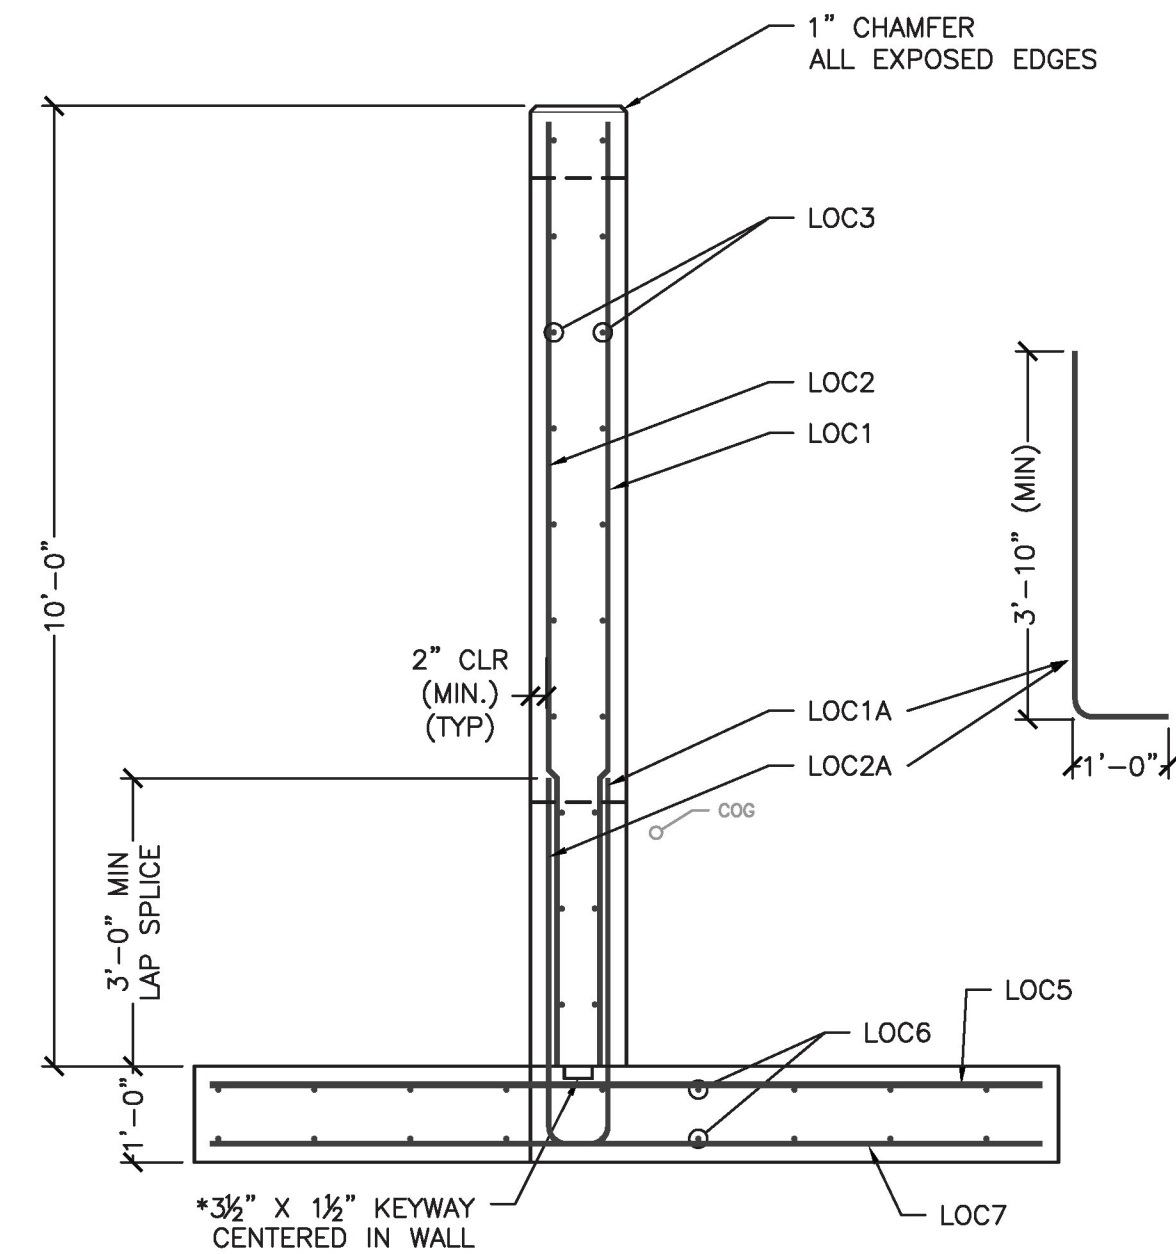


**3 HW1 REINFORCING SECTION**  
S2.0  
1/2" = 1'-0"


**HW REINFORCING SCHEDULE**

MARK	TYPE	SIZE	SPACING	QTY	LENGTH
LOC1	STR	** #6	8"	15	9'-10"
LOC1A	LBAR	#6	8"	15	4'-9"
LOC2	STR	** #4	12"	10	9'-10"
LOC2A	LBAR	#4	12"	10	4'-9"
LOC3	STR	#4	12"	20	8'-8"
LOC5	STR	#6	10"	12	8'-8"
LOC6	STR	#4	12"	20	8'-8"
LOC7	STR	#4	10"	12	8'-8"


** TWO EXTRA BARS WILL BE NEEDED. EACH SIZE FOR SAMPLING.

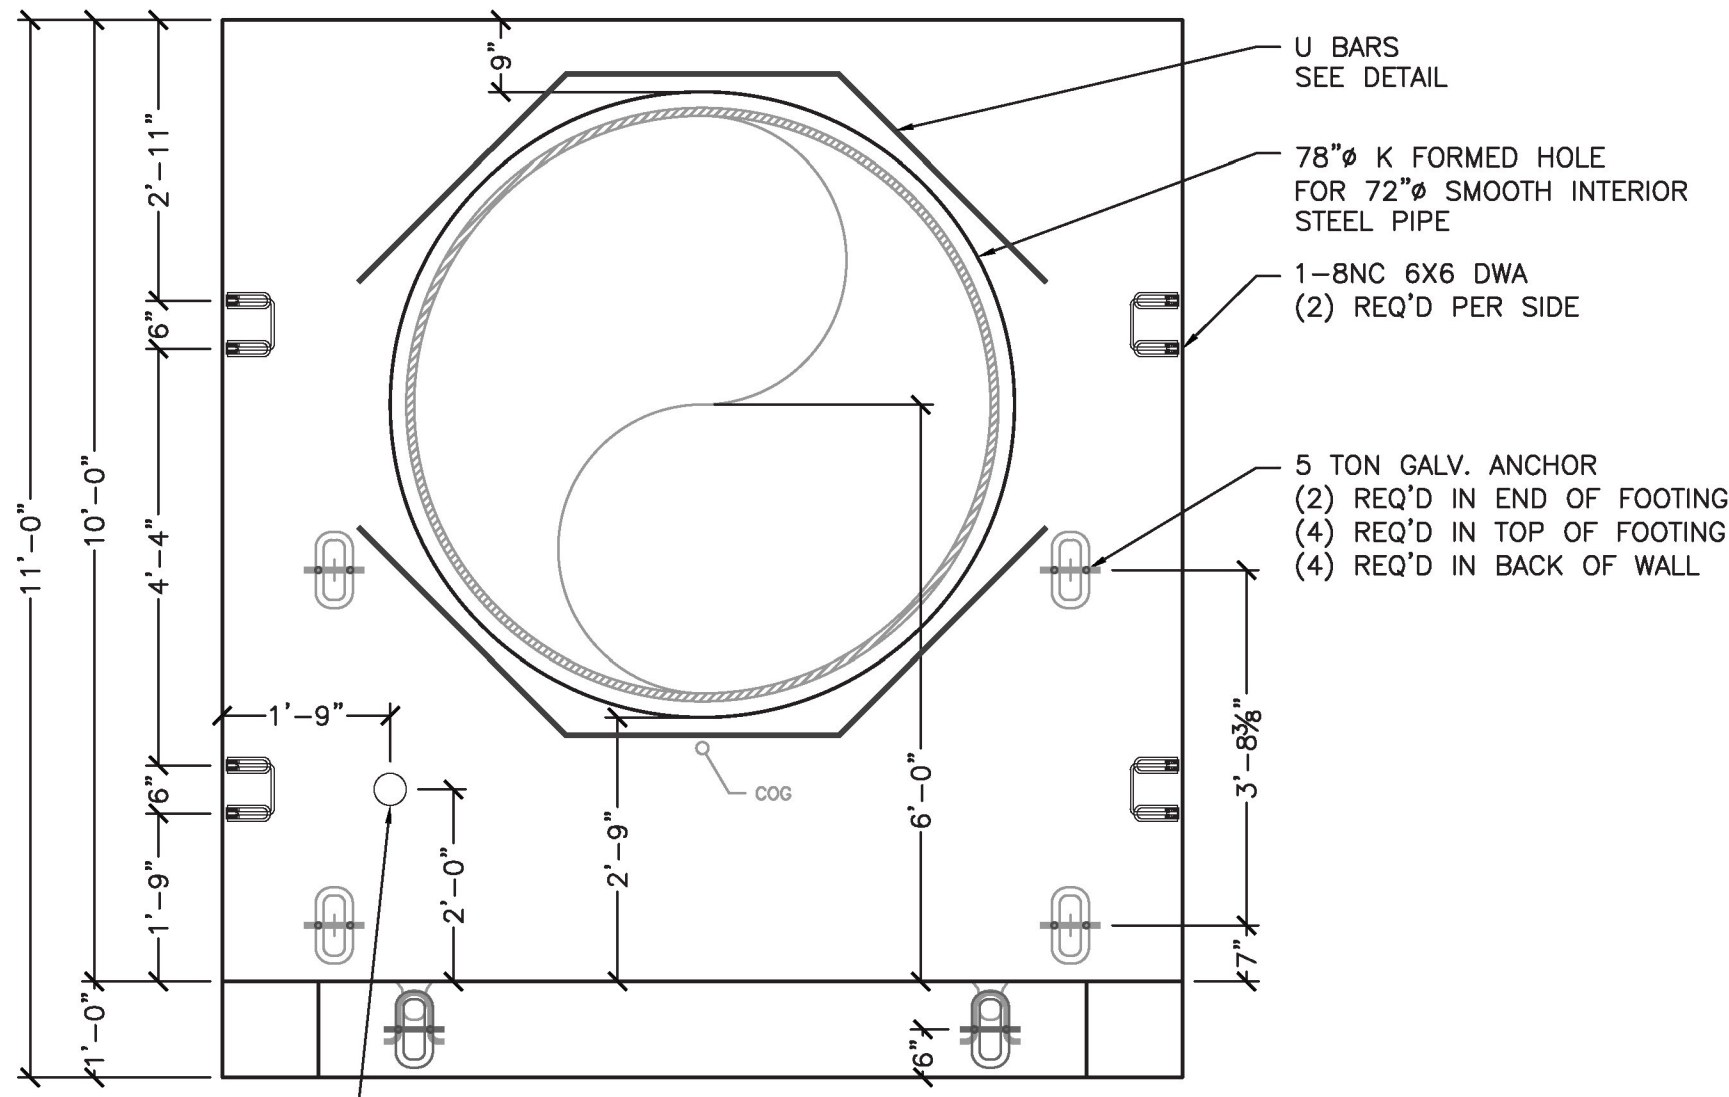


**2 HW1 ELEV. VIEW**  
S2.0  
1/2" = 1'-0" (Looking @ Front)

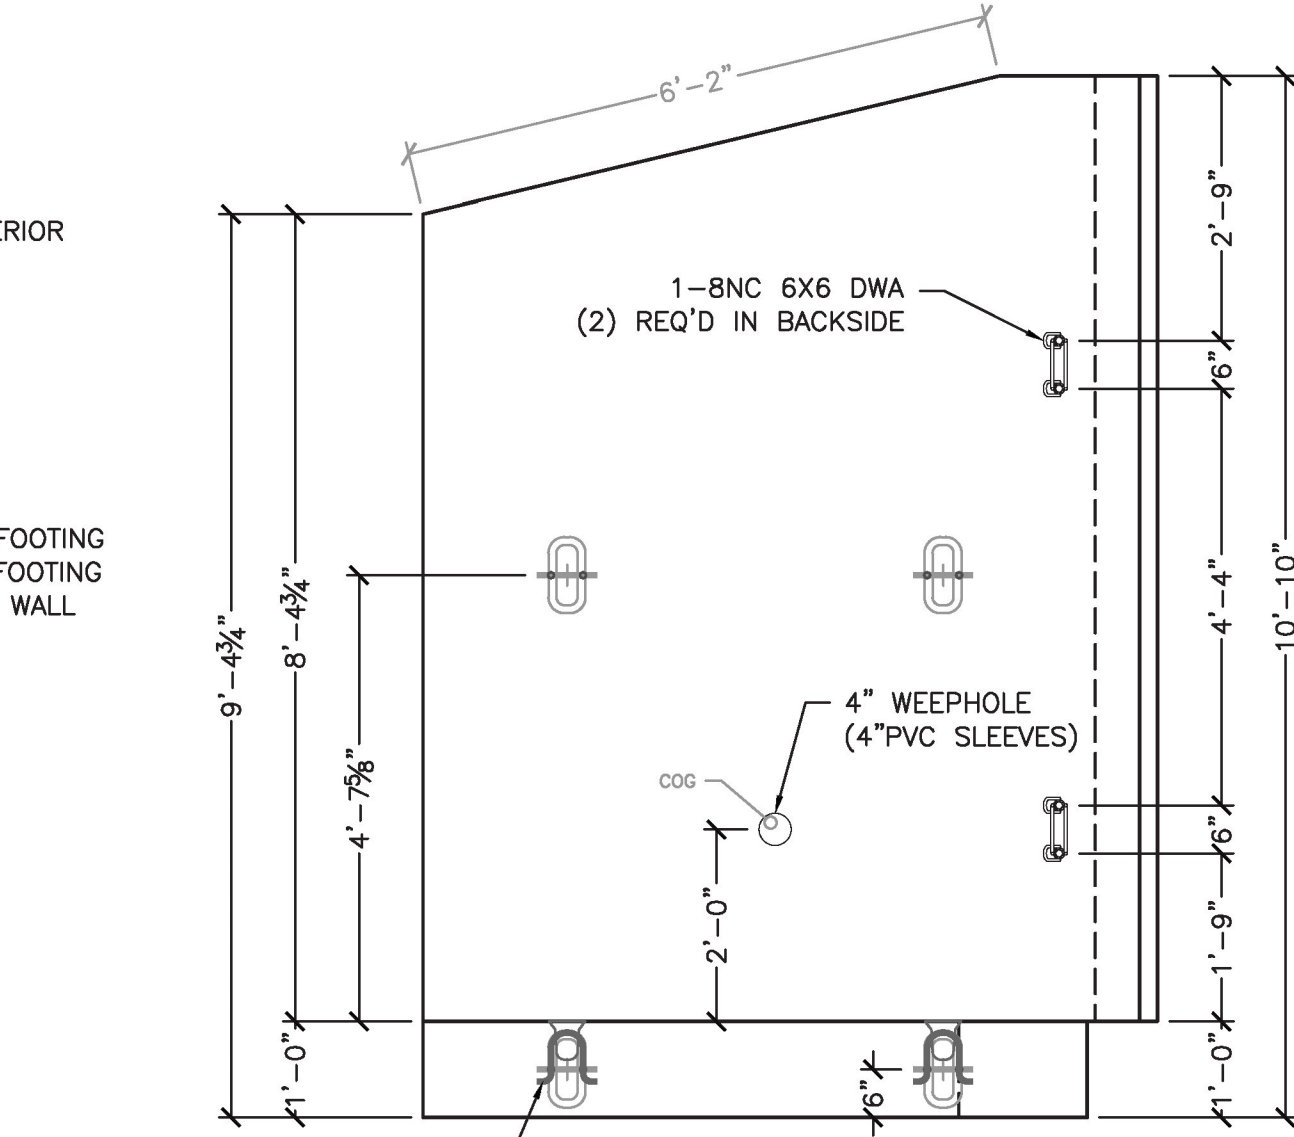

**5 WW1 ELEV. VIEW**  
S2.0  
1/2" = 1'-0" (Looking @ Front)

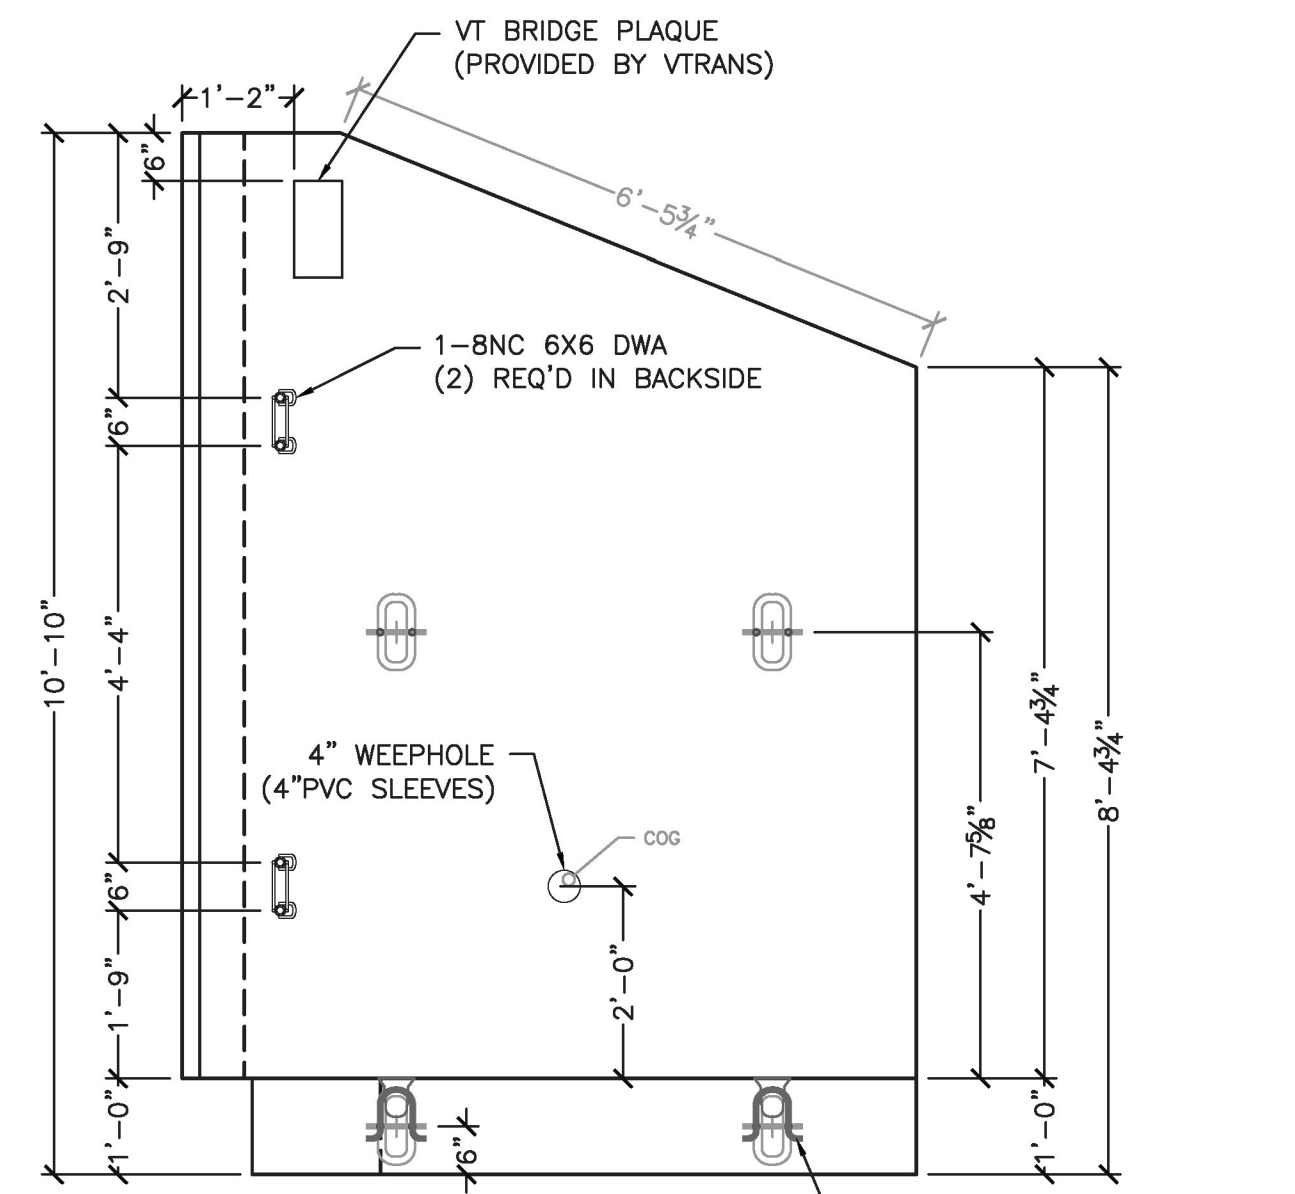





**7 WW2 ELEV. VIEW**  
S2.0  
1/2" = 1'-0" (Looking @ Front)

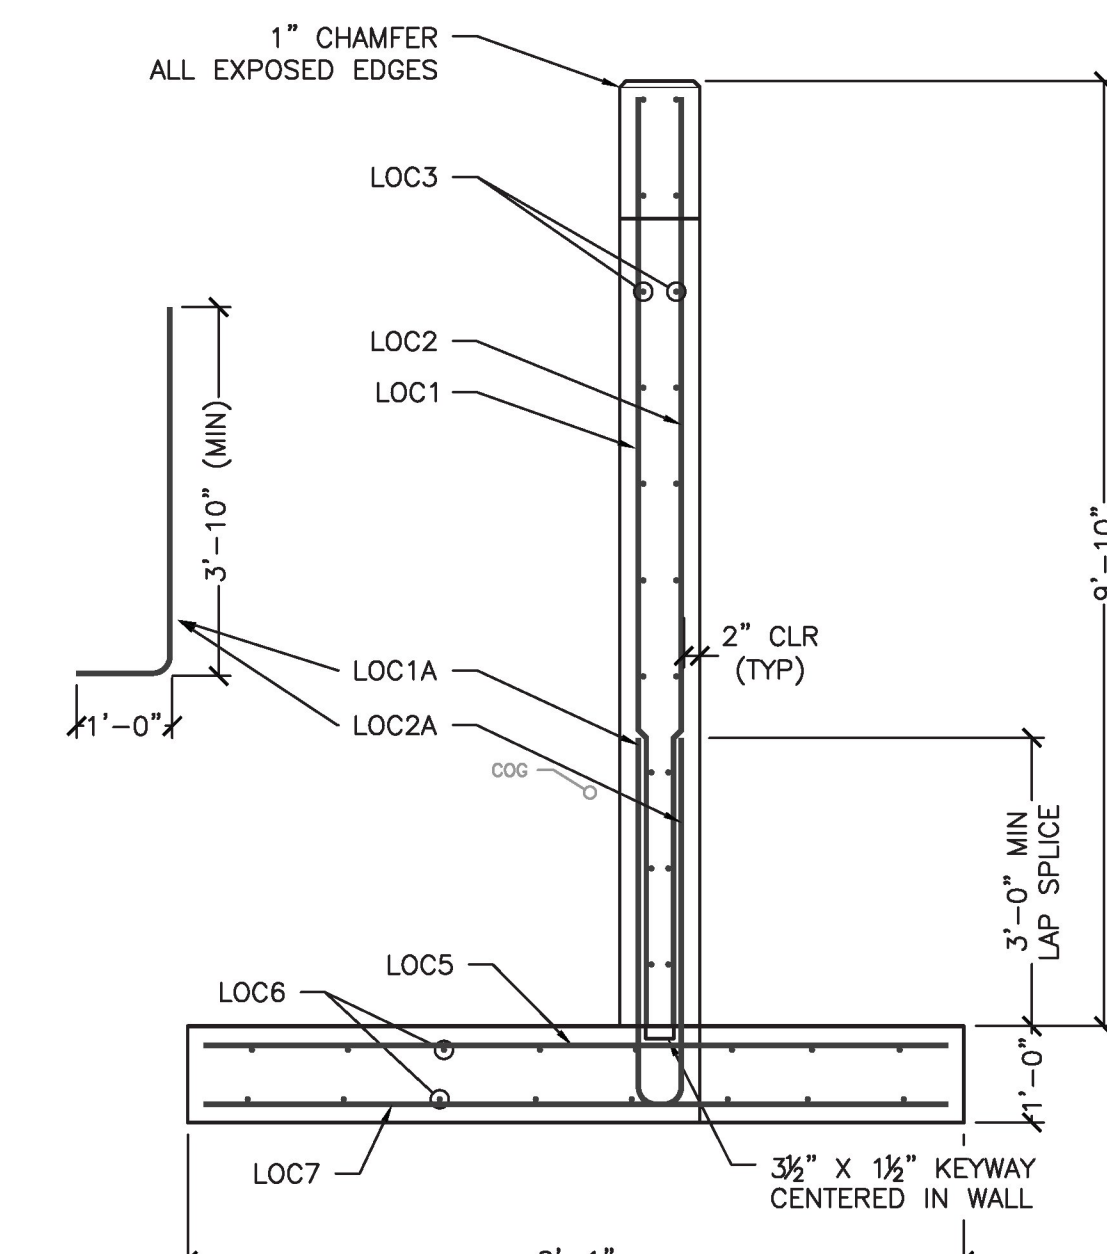

**8 WW REINFORCING SECTION**  
S2.0  
1/2" = 1'-0"


**WW REINFORCING SCHEDULE**

MARK	TYPE	SIZE	SPACING	QTY	LENGTH
LOC1	STR	#5	8"	11	9'-8"
LOC1A	LBAR	#5	8"	11	4'-9"
LOC2	STR	#4	12"	7	9'-8"
LOC2A	LBAR	#4	12"	7	4'-9"
LOC3	STR	#4	12"	20	7'-4" OF / 6'-10" IF
LOC5	STR	#5	8"	10	7'-9"
LOC6	STR	#4	12"	16	6'-7"
LOC7	STR	#4	12"	7	7'-9"

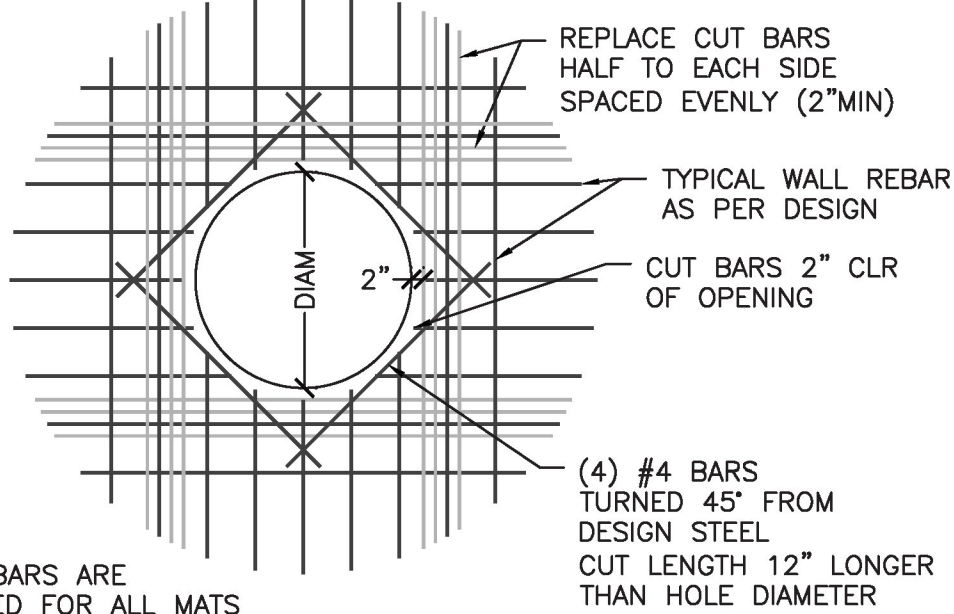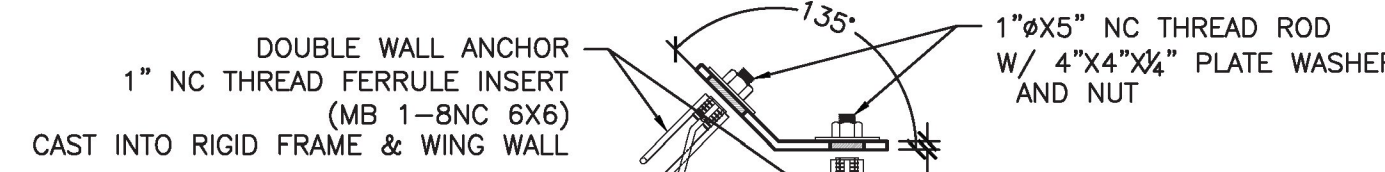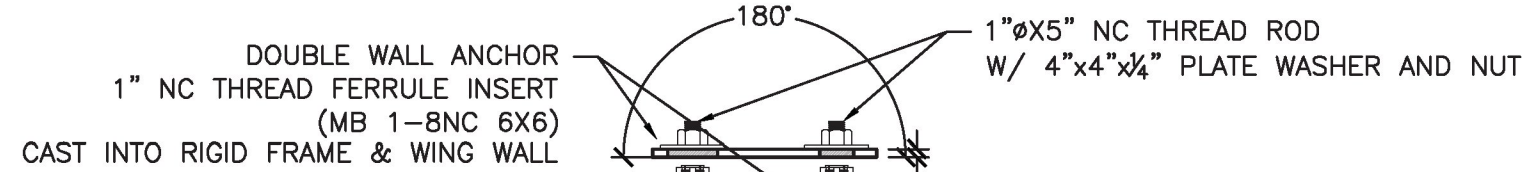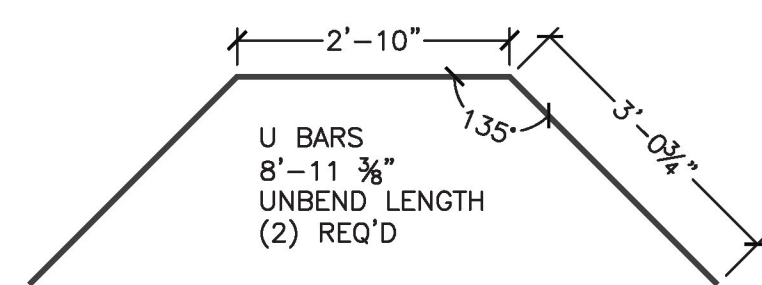

NOTE: EXTRA BARS ARE REQUIRED FOR ALL MATS


**9 TYPICAL REINFORCEMENT AT HOLE**  
S2.0  
3/8" = 1'-0"

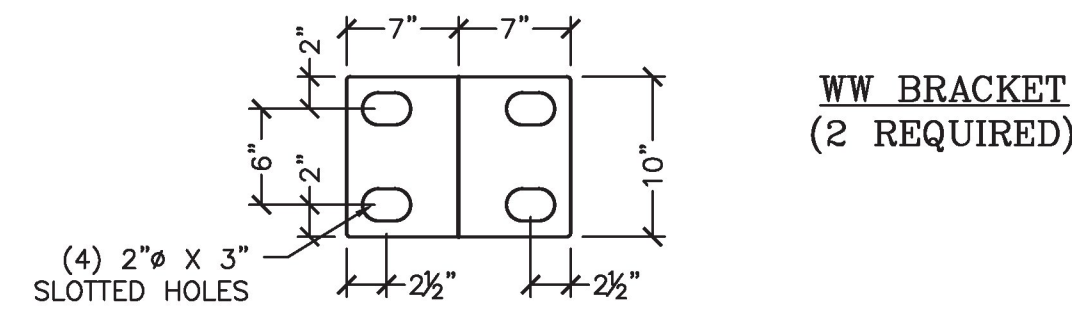

**WW BRACKET**  
(2 REQUIRED)

PLATES TO BE MADE OF MILD STEEL, PLASMA CUT, AND BENT AS REQUIRED. (HOT DIPPED GALVANIZED AFTER BENDING)

**10 WINGWALL BRACKET DETAIL**  
S2.0  
1" = 1'-0"

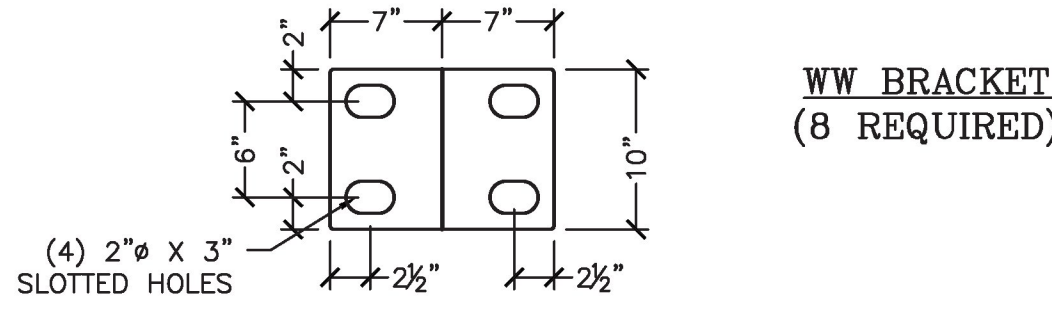

**WW BRACKET**  
(8 REQUIRED)

PLATES TO BE MADE OF MILD STEEL, PLASMA CUT, AND BENT AS REQUIRED. (HOT DIPPED GALVANIZED AFTER BENDING)


**11 WINGWALL BRACKET DETAIL**  
S2.0  
1" = 1'-0"

No.	Date	Revision
XXX		By
XX		XX
XX		XX

**MICHIE**  
CONSULTANTS  
INCORPORATED  
PROFESSIONAL ENGINEER  
173 BUXTON INDUSTRIAL DRIVE - PO BOX 870  
HENNIKER, NH 03242  
PHONE 603-498-3218  
WWW.MICHIEGRP.COM


Project No. 7910  
Date: 3/7/2017  
Designed by: Delta  
Drawn by: CJP  
Checked by: Delta  
Scale: AS SHOWN  
VT Route 78 - VAOT # STP SCRIP (12)  
Highgate, VT  
Inlet End Headwall Details

Prepared for:  
**Casella Construction, Inc.**  
25 Industrial Ave.  
Mendon, VT 05701

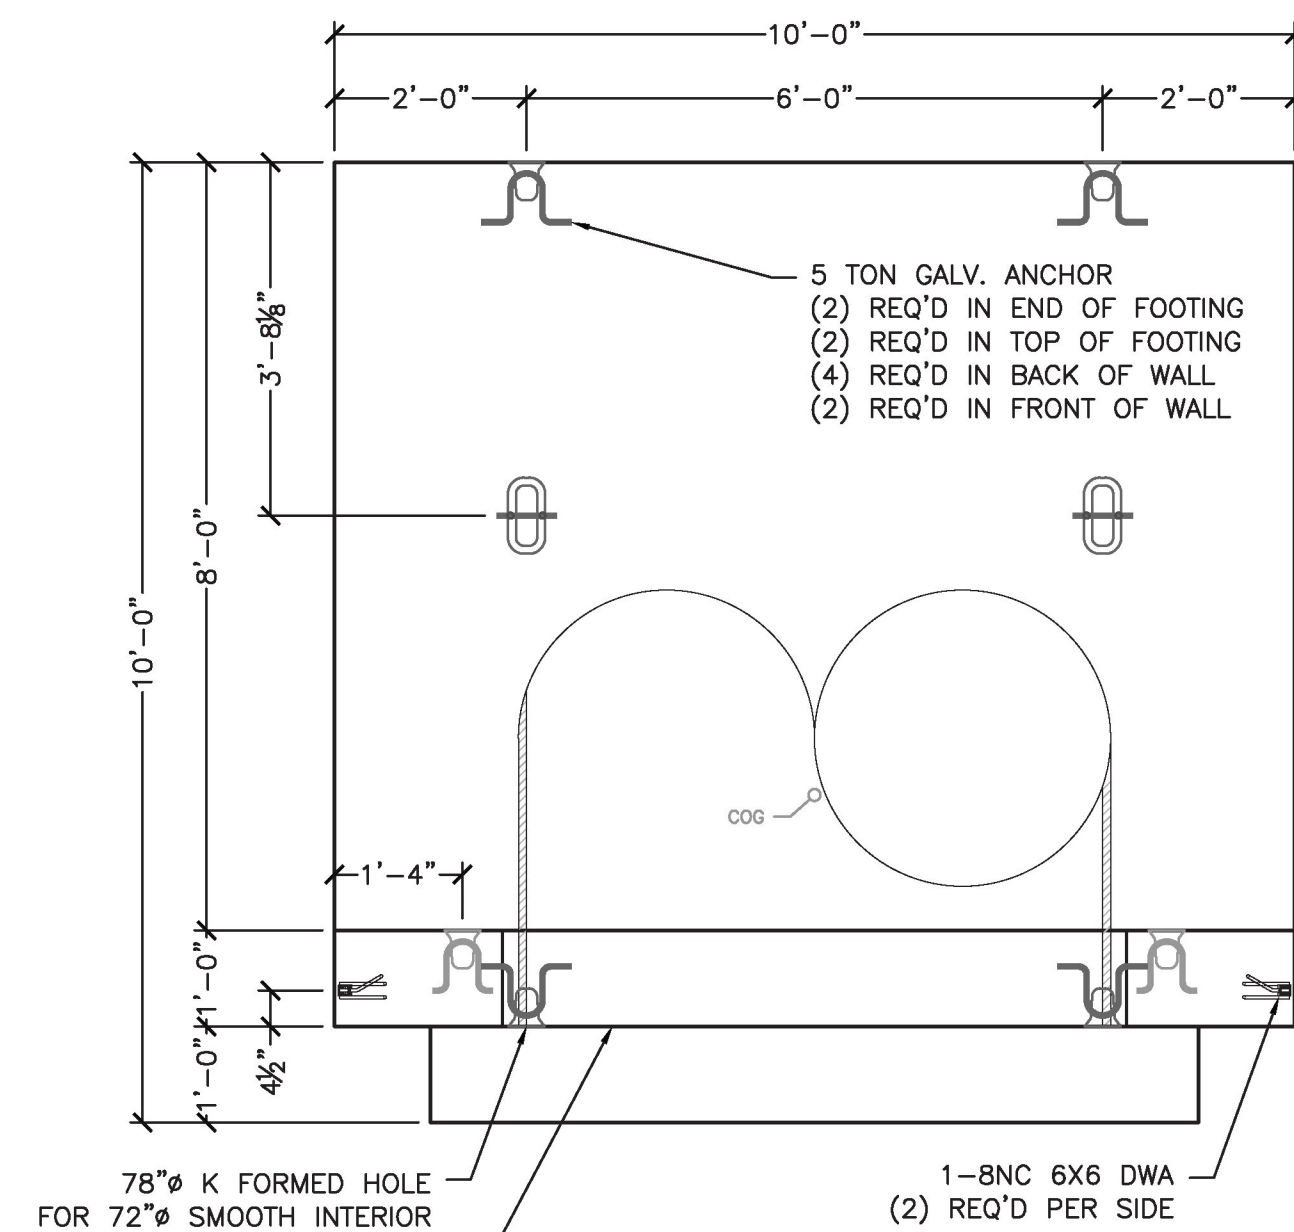


**1 HW2 PLAN VIEW**  
 S3.0  
 1/2" = 1'-0"

**HW2 - 1 REQ'D**  
 ITEM NUMBER: 275600  
 UNIT WEIGHT AND VOLUME:  
 FOOTING: 3.63CY (15,245#)  
 WALL: 3.03CY (12,730#)  
 TOTAL WEIGHT: 27,975#

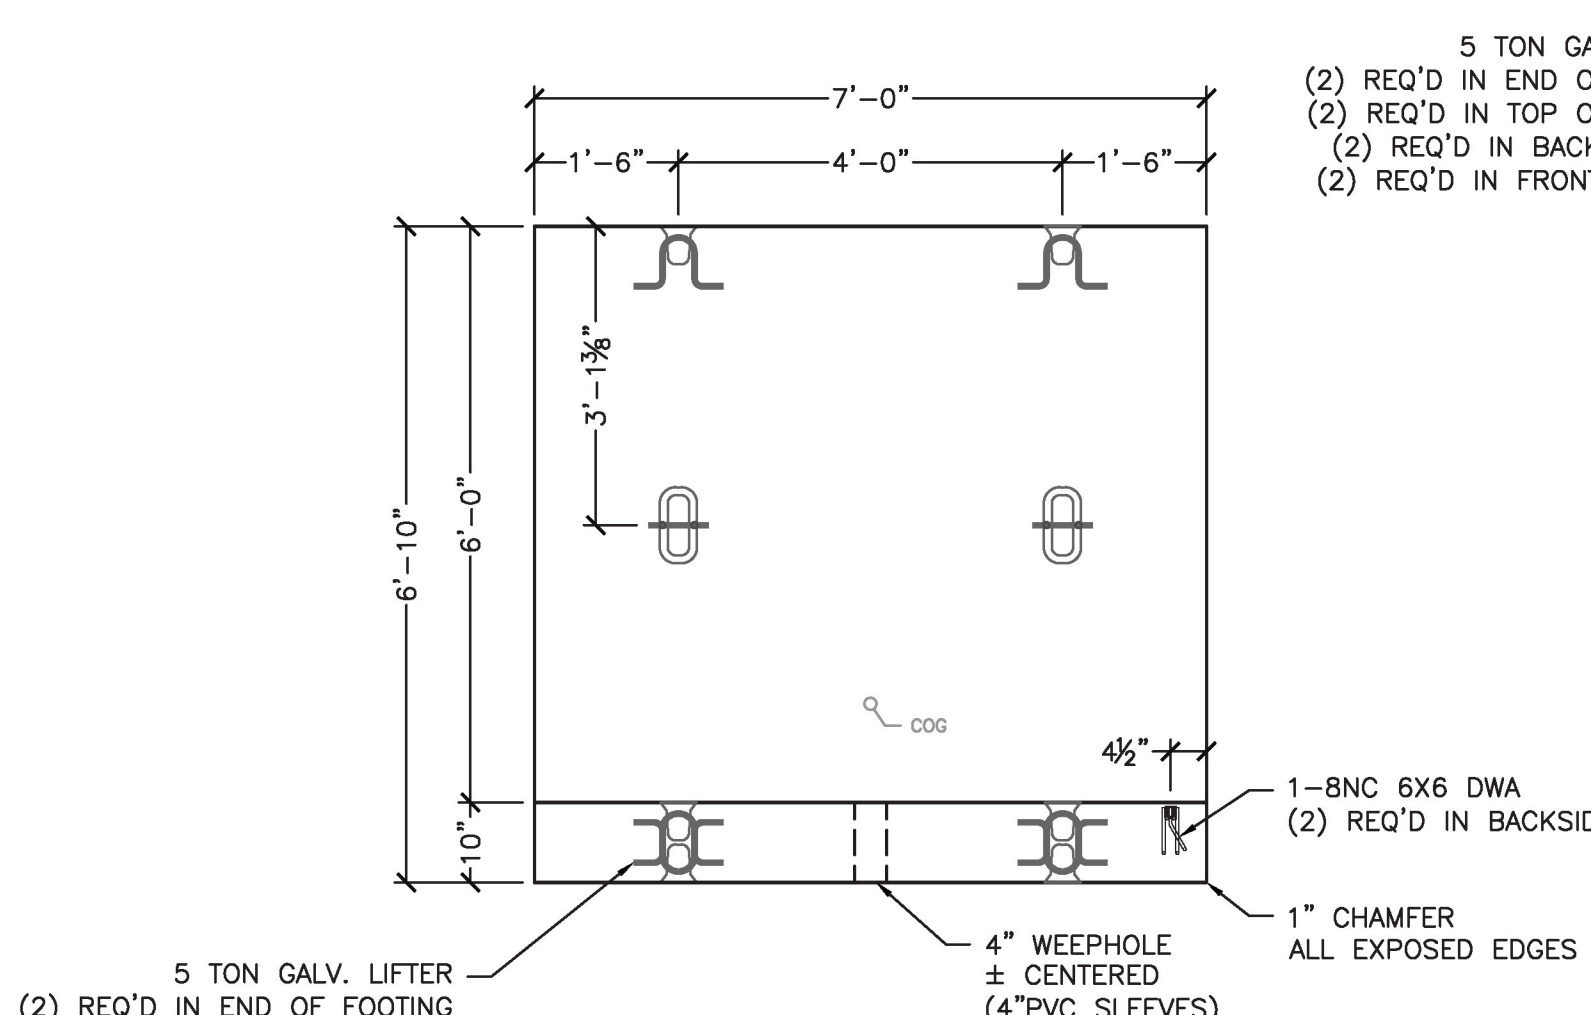


**3 WW3A PLAN VIEW**  
 S3.0  
 1/2" = 1'-0"

**WW3A - 1 REQ'D**  
 ITEM NUMBER: 275600  
 UNIT WEIGHT AND VOLUME:  
 FOOTING: 1.77CY (7,440#)  
 WALL: 1.93CY (8,100#)  
 TOTAL WEIGHT: 15,540#

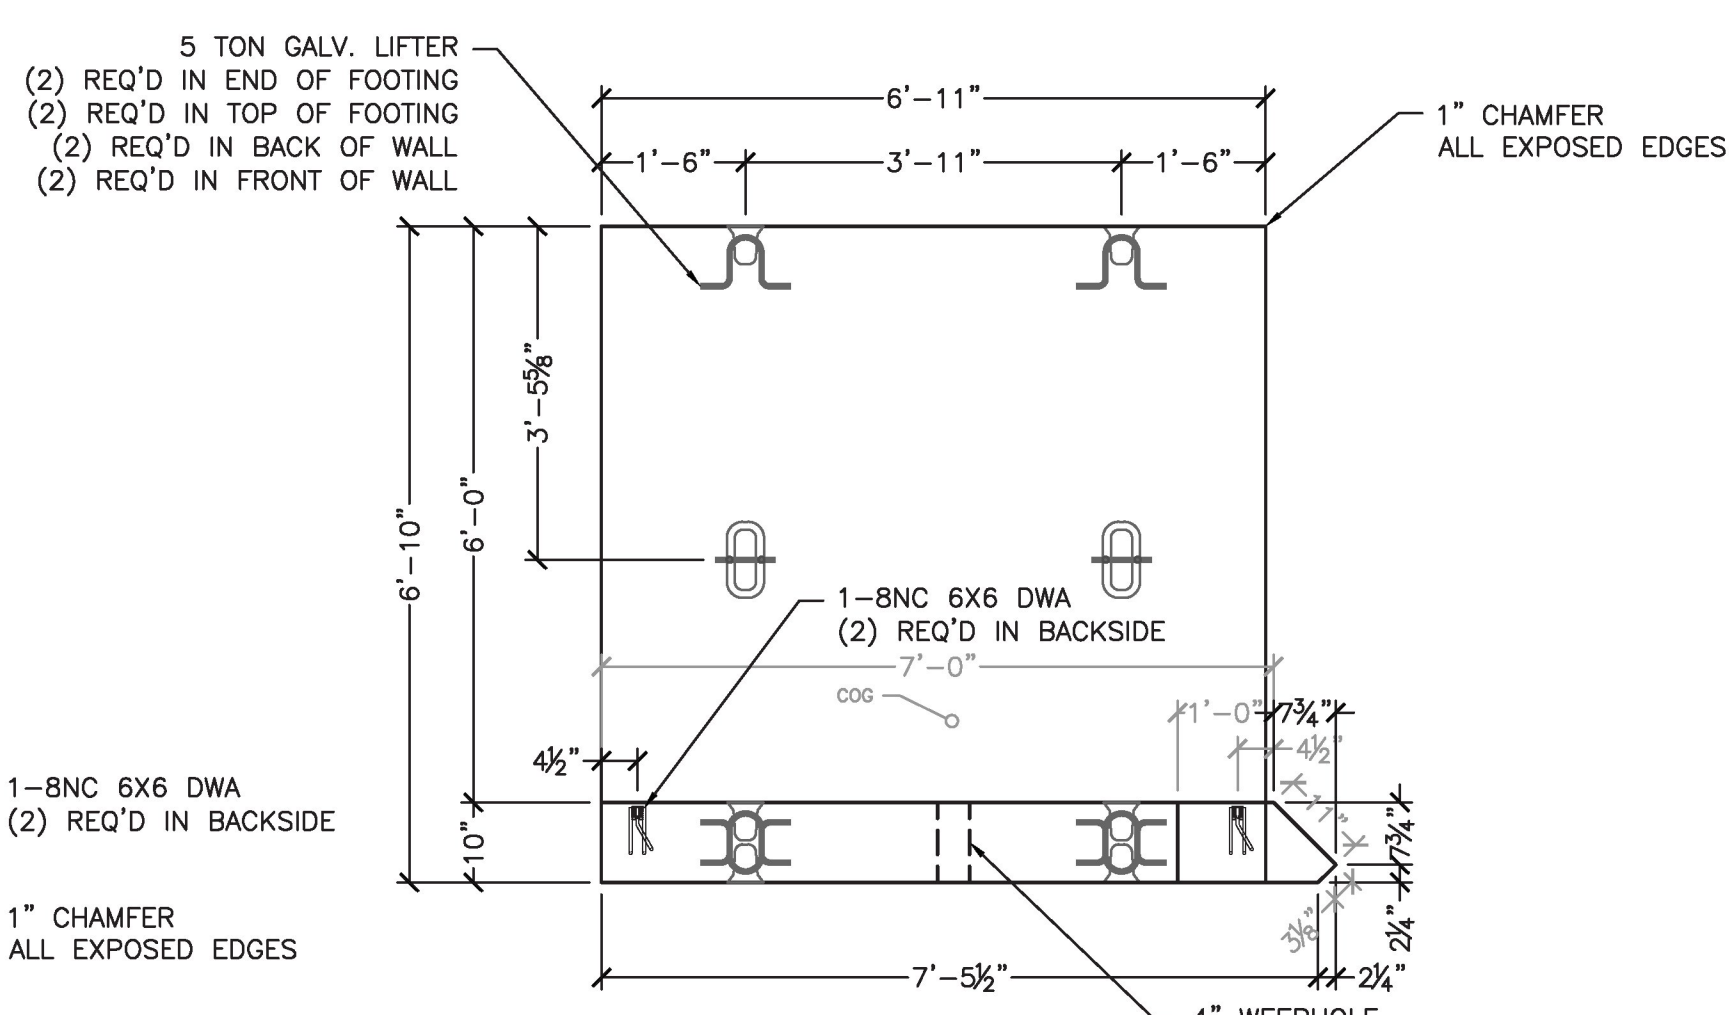


**5 WW3B PLAN VIEW**  
 S3.0  
 1/2" = 1'-0"


**WW3B - 1 REQ'D**  
 ITEM NUMBER: 275600  
 UNIT WEIGHT AND VOLUME:  
 FOOTING: 1.75CY (7,350#)  
 WALL: 2.42CY (10,164#)  
 TOTAL WEIGHT: 17,514#

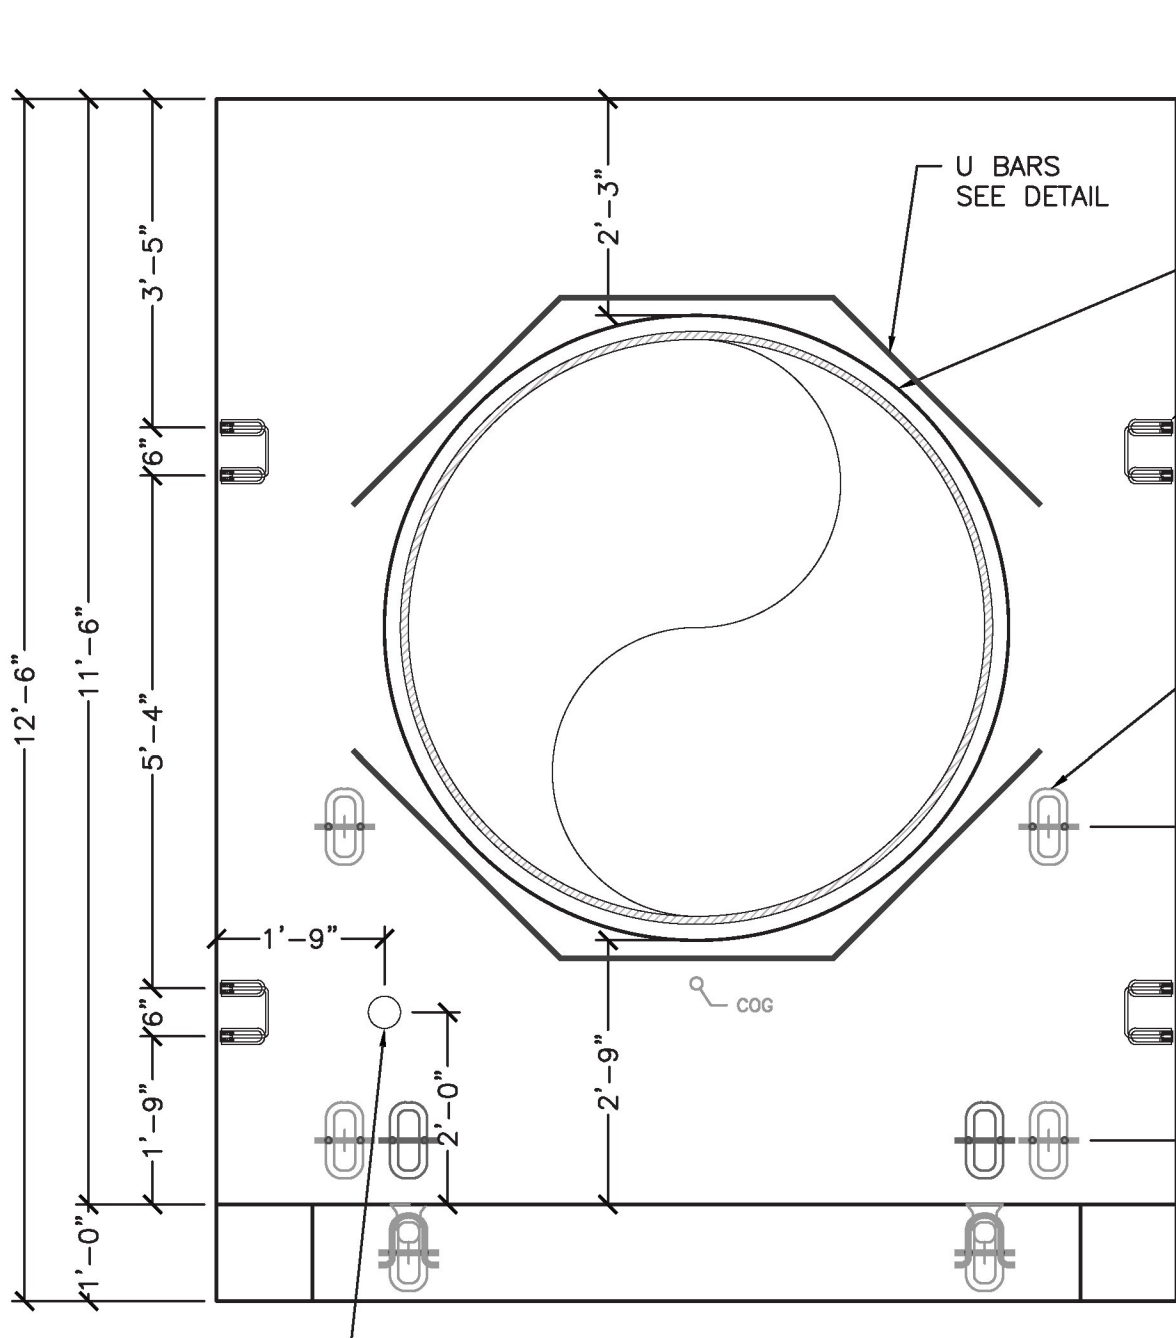

**2 HW2 ELEV. VIEW**  
 S3.0  
 1/2" = 1'-0" (Looking @ Front)

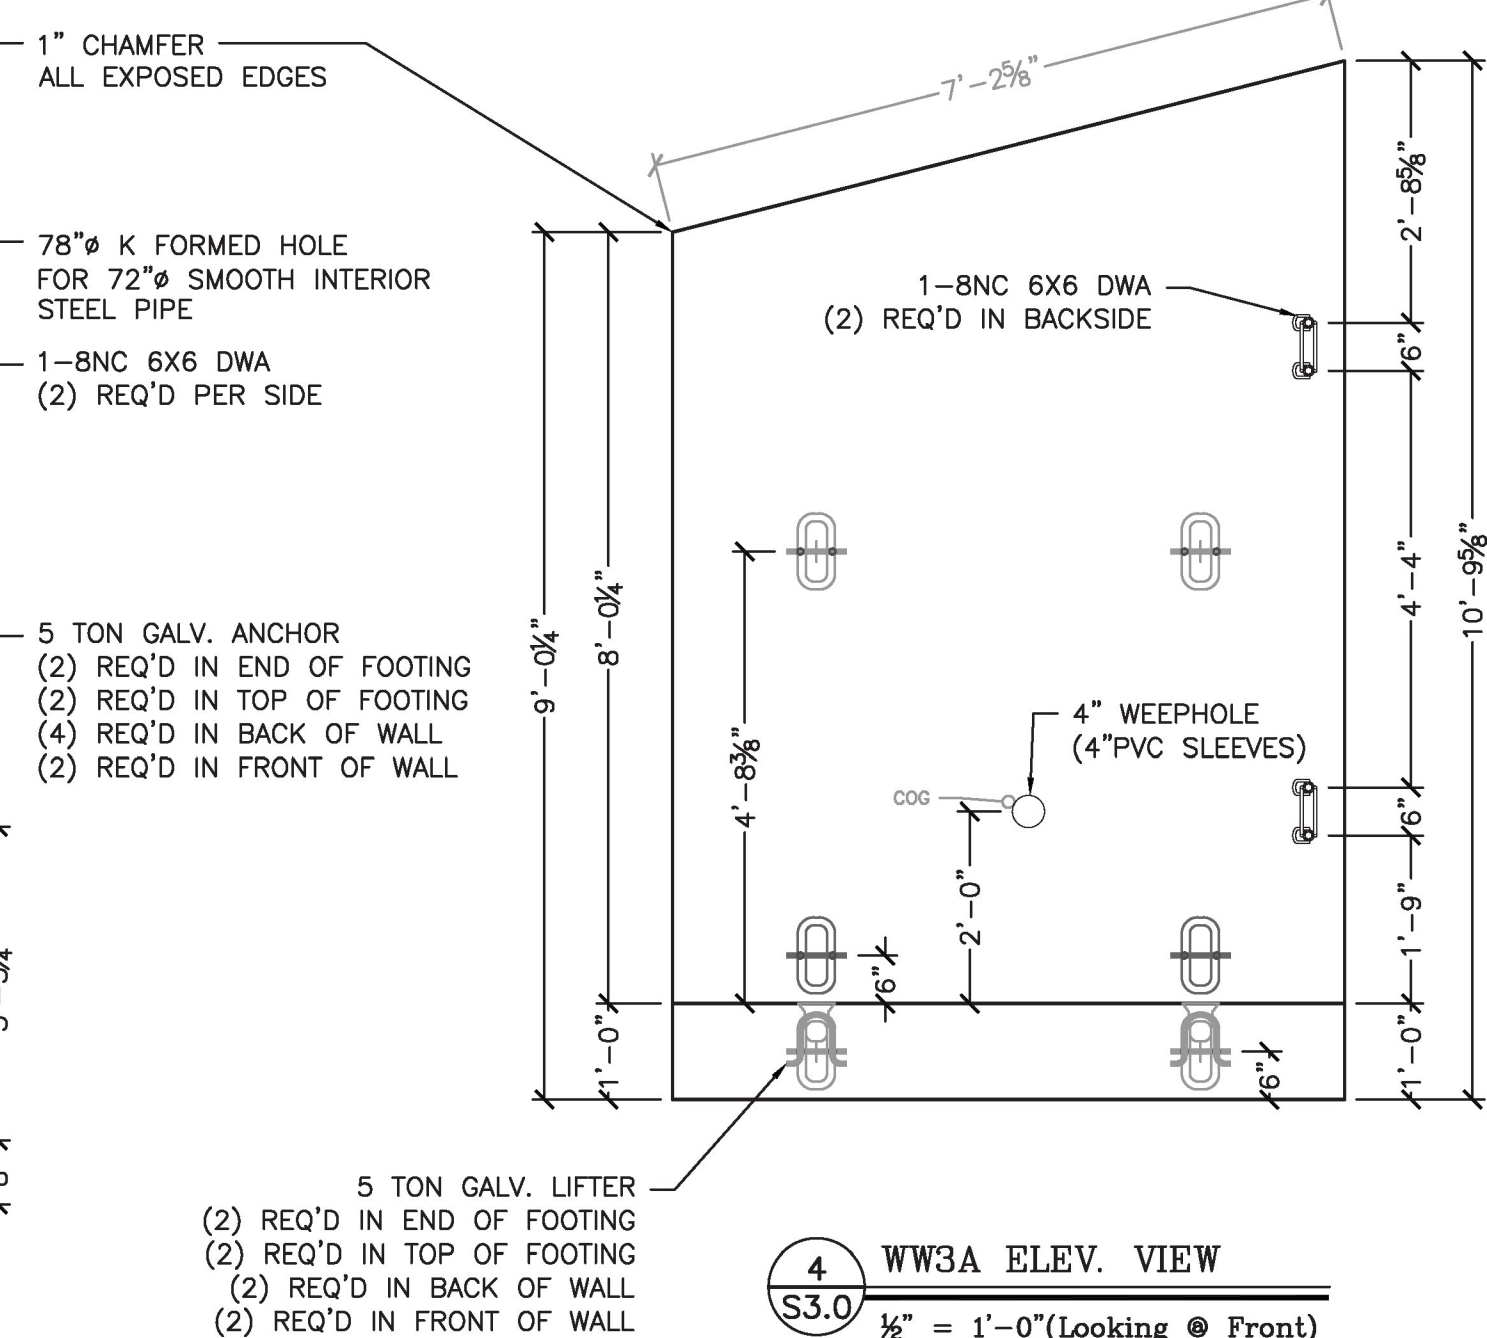

**4 WW3A ELEV. VIEW**  
 S3.0  
 1/2" = 1'-0" (Looking @ Front)

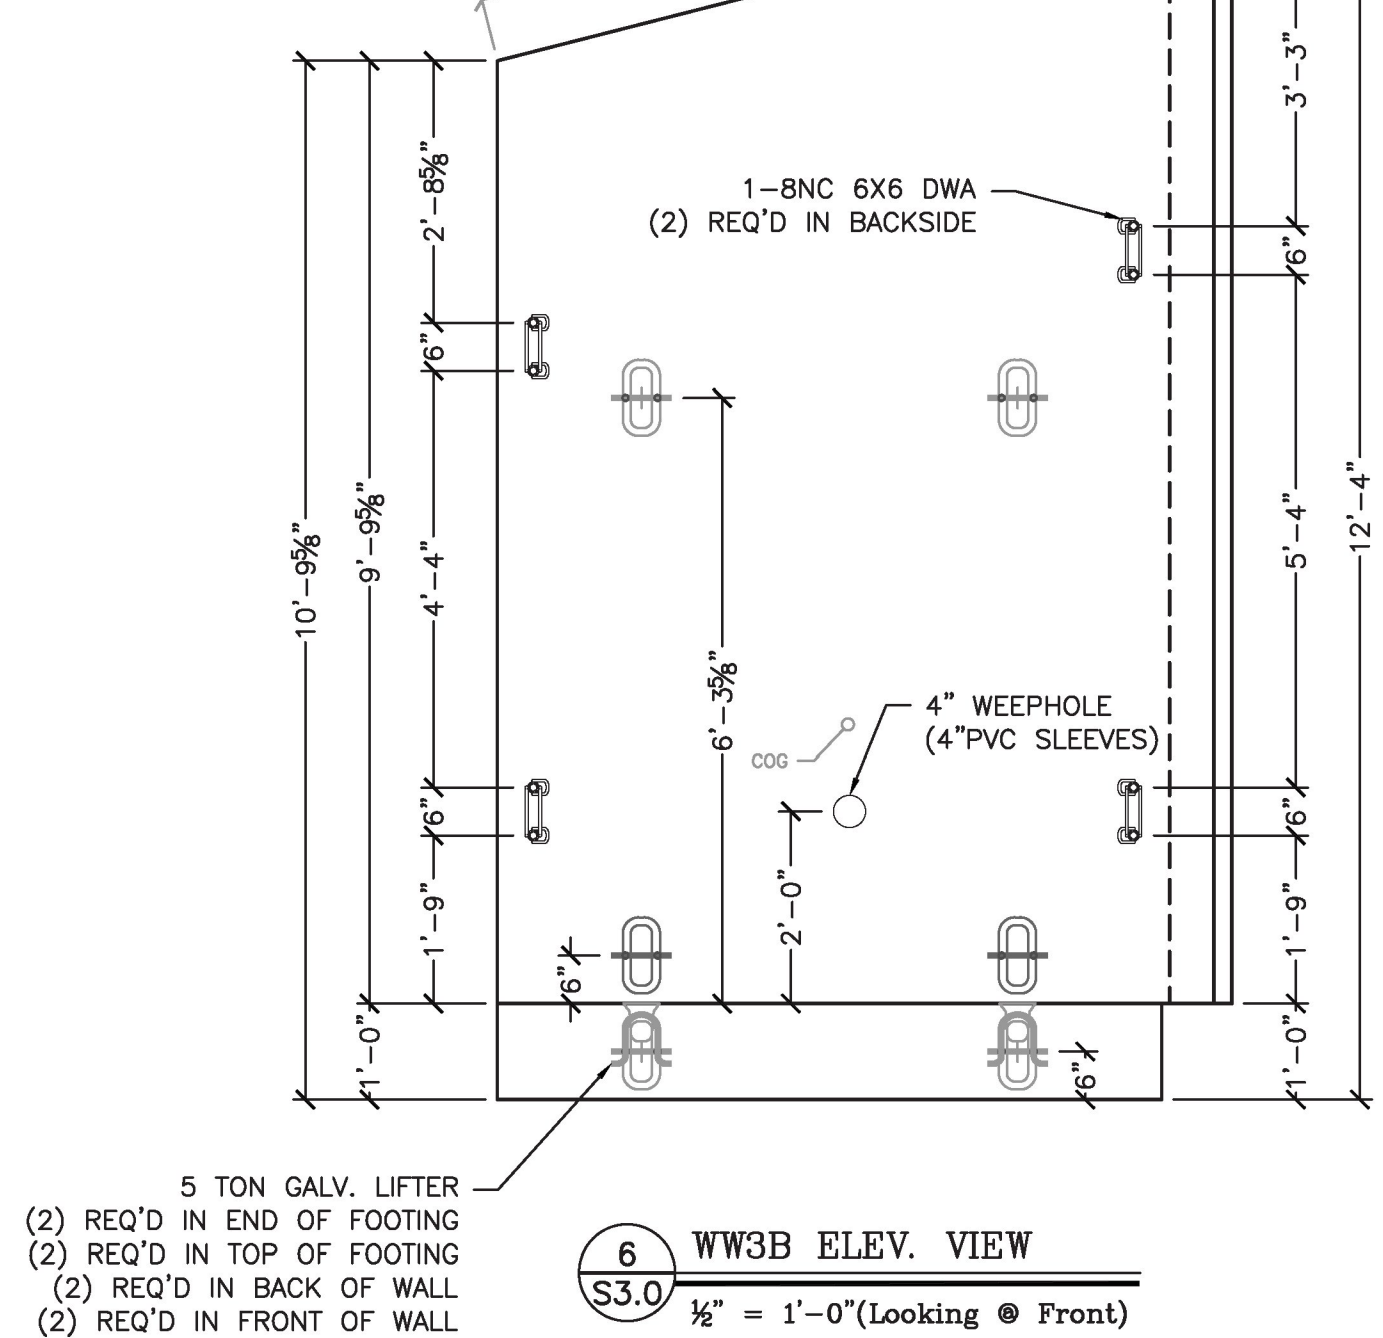


**6 WW3B ELEV. VIEW**  
 S3.0  
 1/2" = 1'-0" (Looking @ Front)

**WW3A REINFORCING SCHEDULE**

MARK	TYPE	SIZE	SPACING	QTY	LENGTH
LOC1	STR	#5	6"	14	9'-7 1/2"
LOC1A	LBAR	#5	6"	14	4'-9"
LOC2	STR	#4	12"	7	9'-7 1/2"
LOC2A	LBAR	#4	12"	7	4'-9"
LOC3	STR	#4	12"	20	6'-8"
LOC5	HOOK	#5	6"	14	7'-1"
LOC6	STR	#4	12"	14	6'-8"
LOC7	STR	#4	12"	7	6'-6"


**WW3B REINFORCING SCHEDULE**

MARK	TYPE	SIZE	SPACING	QTY	LENGTH
LOC1	STR	#5	6"	14	11'-2"
LOC1A	LBAR	#5	6"	14	4'-9"
LOC2	STR	#4	12"	7	11'-2"
LOC2A	LBAR	#4	12"	7	4'-9"
LOC3	STR	#4	12"	22	7'-3" OF / 6'-10" IF
LOC5	HOOK	#5	6"	14	7'-1"
LOC6	STR	#4	12"	14	6'-7"
LOC7	STR	#4	12"	7	6'-6"

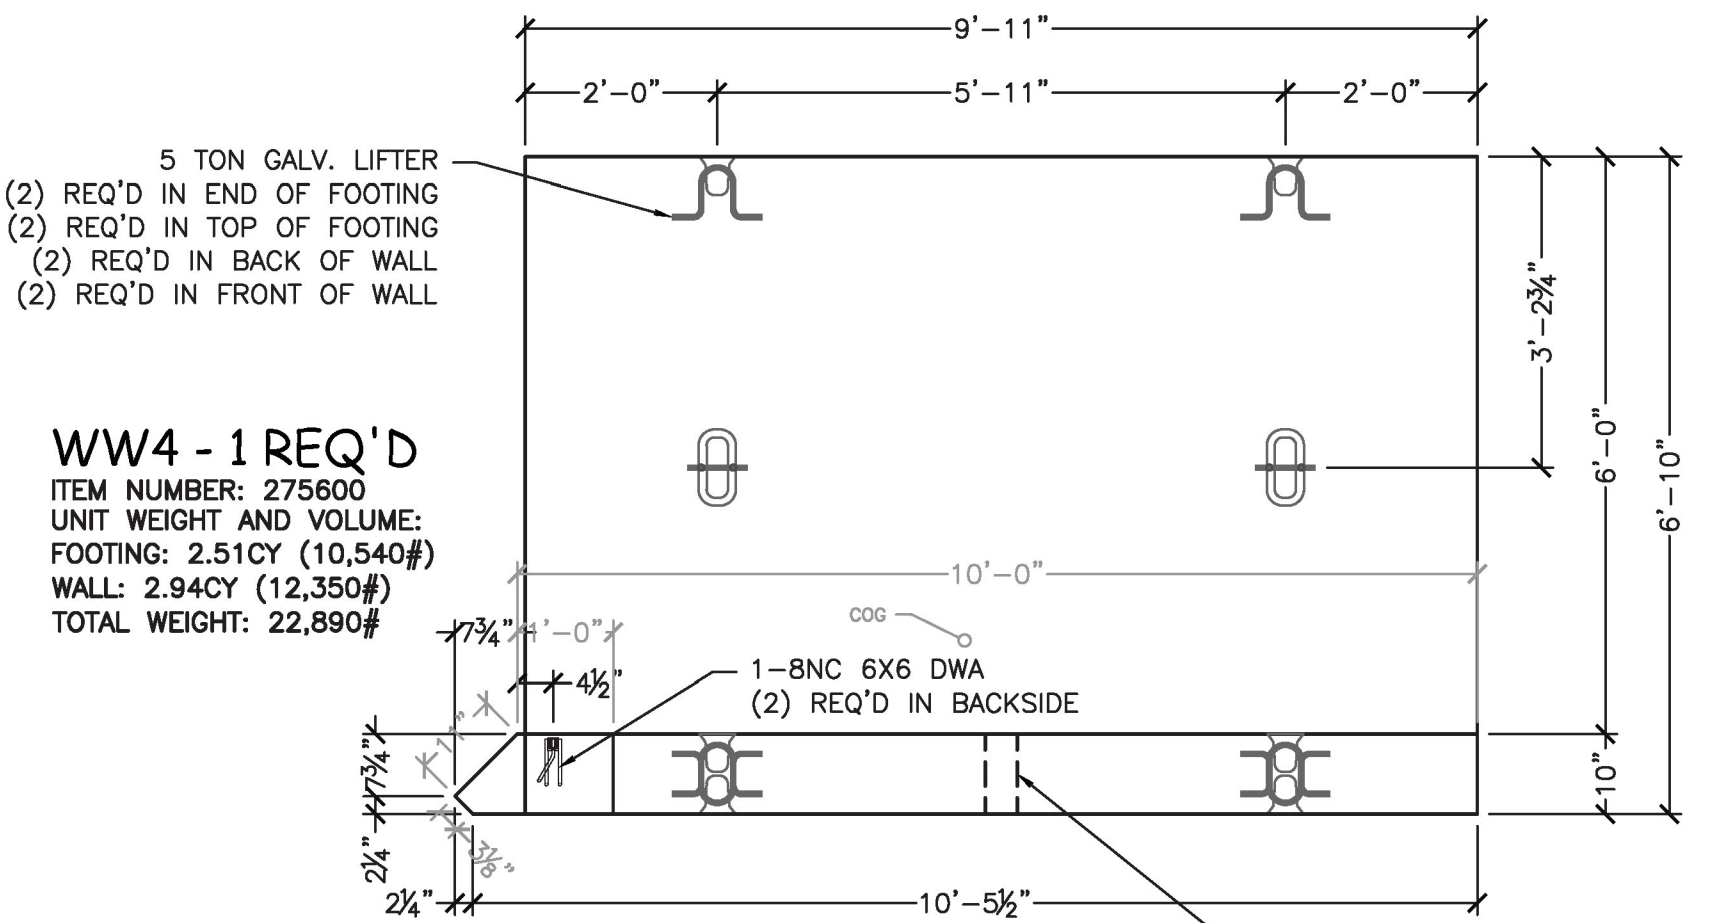


**7 WW4 PLAN VIEW**  
 S3.0  
 1/2" = 1'-0"

**WW4 - 1 REQ'D**  
 ITEM NUMBER: 275600  
 UNIT WEIGHT AND VOLUME:  
 FOOTING: 2.51CY (10,540#)  
 WALL: 2.94CY (12,350#)  
 TOTAL WEIGHT: 22,890#

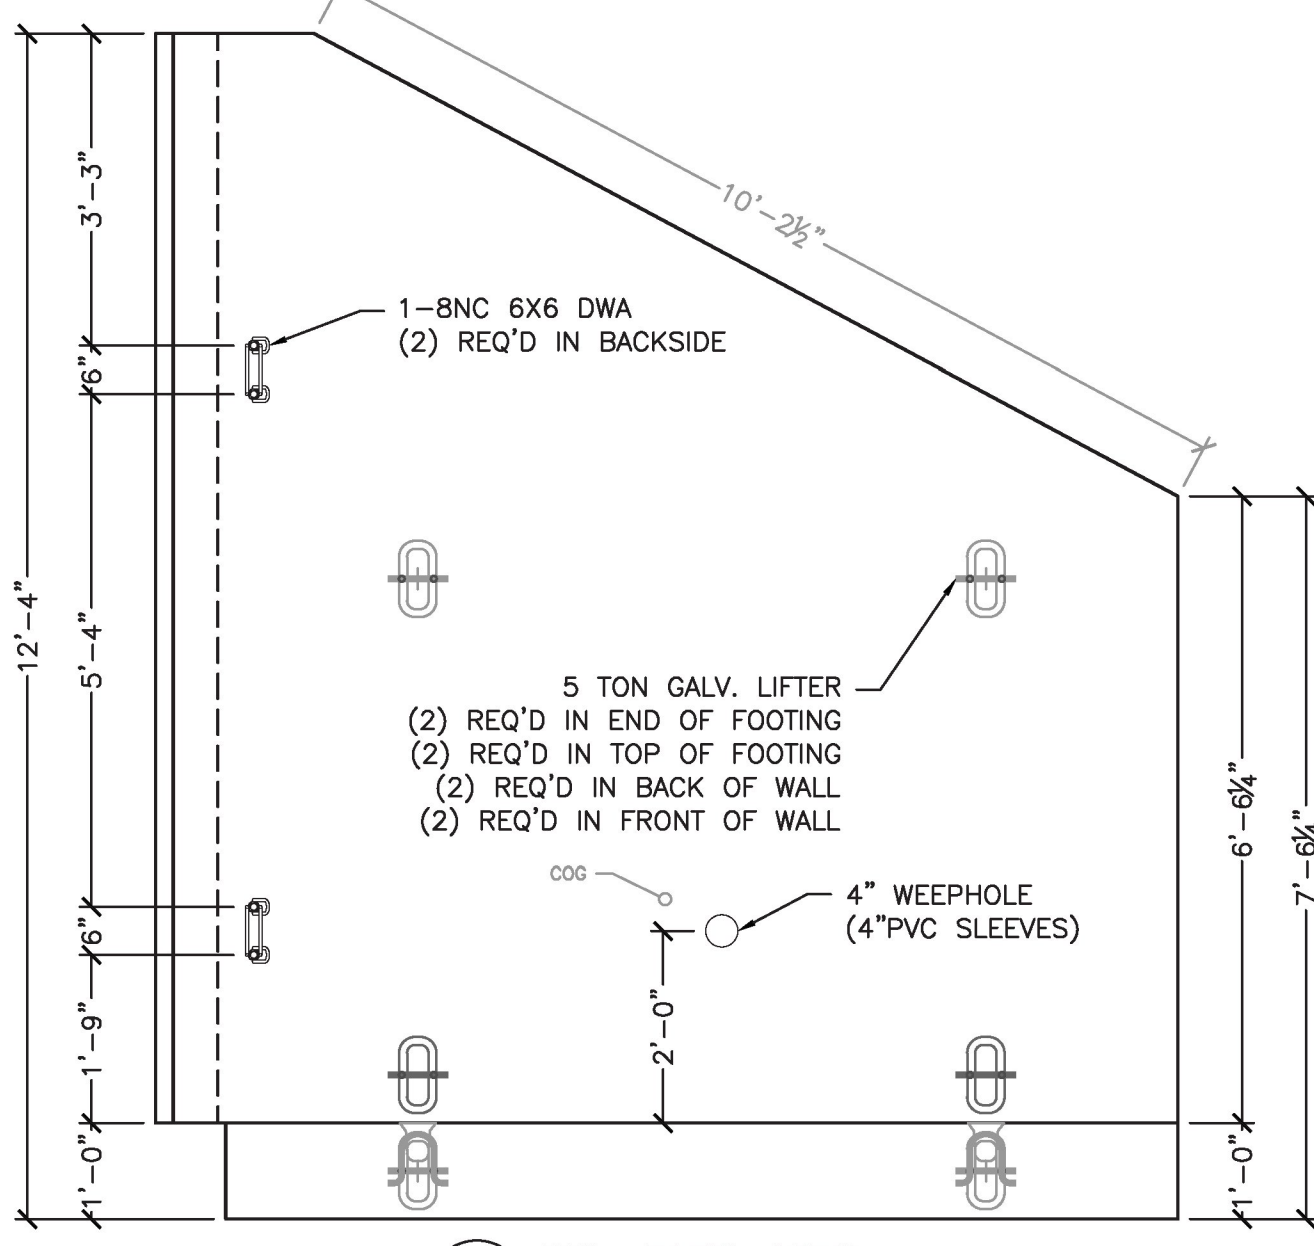


**8 WW4 ELEV. VIEW**  
 S3.0  
 1/2" = 1'-0" (Looking @ Front)

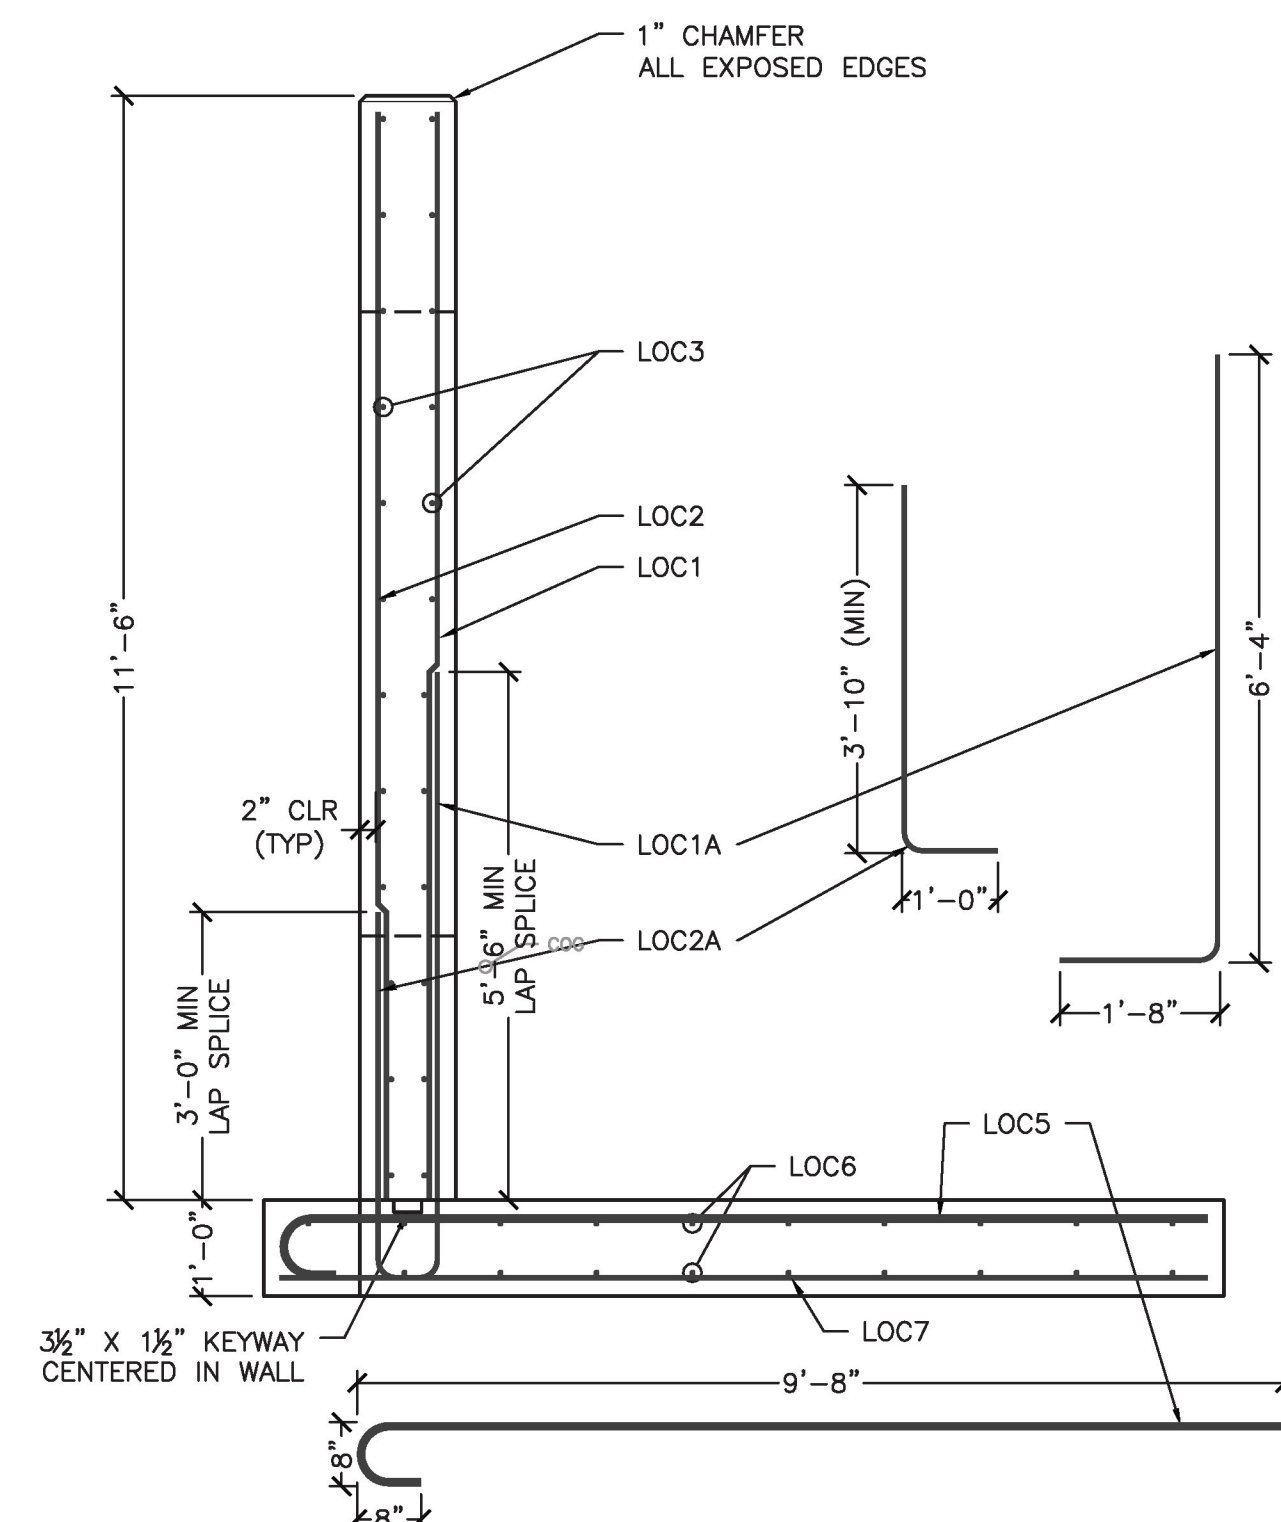

**9 HW1 REINFORCING SECTION**  
 S3.0  
 1/2" = 1'-0"

**HW REINFORCING SCHEDULE**

MARK	TYPE	SIZE	SPACING	QTY	LENGTH
LOC1	STR	#8	6"	20	11'-4"
LOC1A	LBAR	#8	6"	20	7'-10 1/2"
LOC2	STR	#4	12"	10	11'-4"
LOC2A	LBAR	#4	12"	10	4'-9"
LOC3	STR	#4	12"	24	9'-8"
LOC5	HOOK	#8	5"	20	10'-7"
LOC6	STR	#4	12"	20	9'-8"
LOC7	STR	#4	12"	10	9'-8"

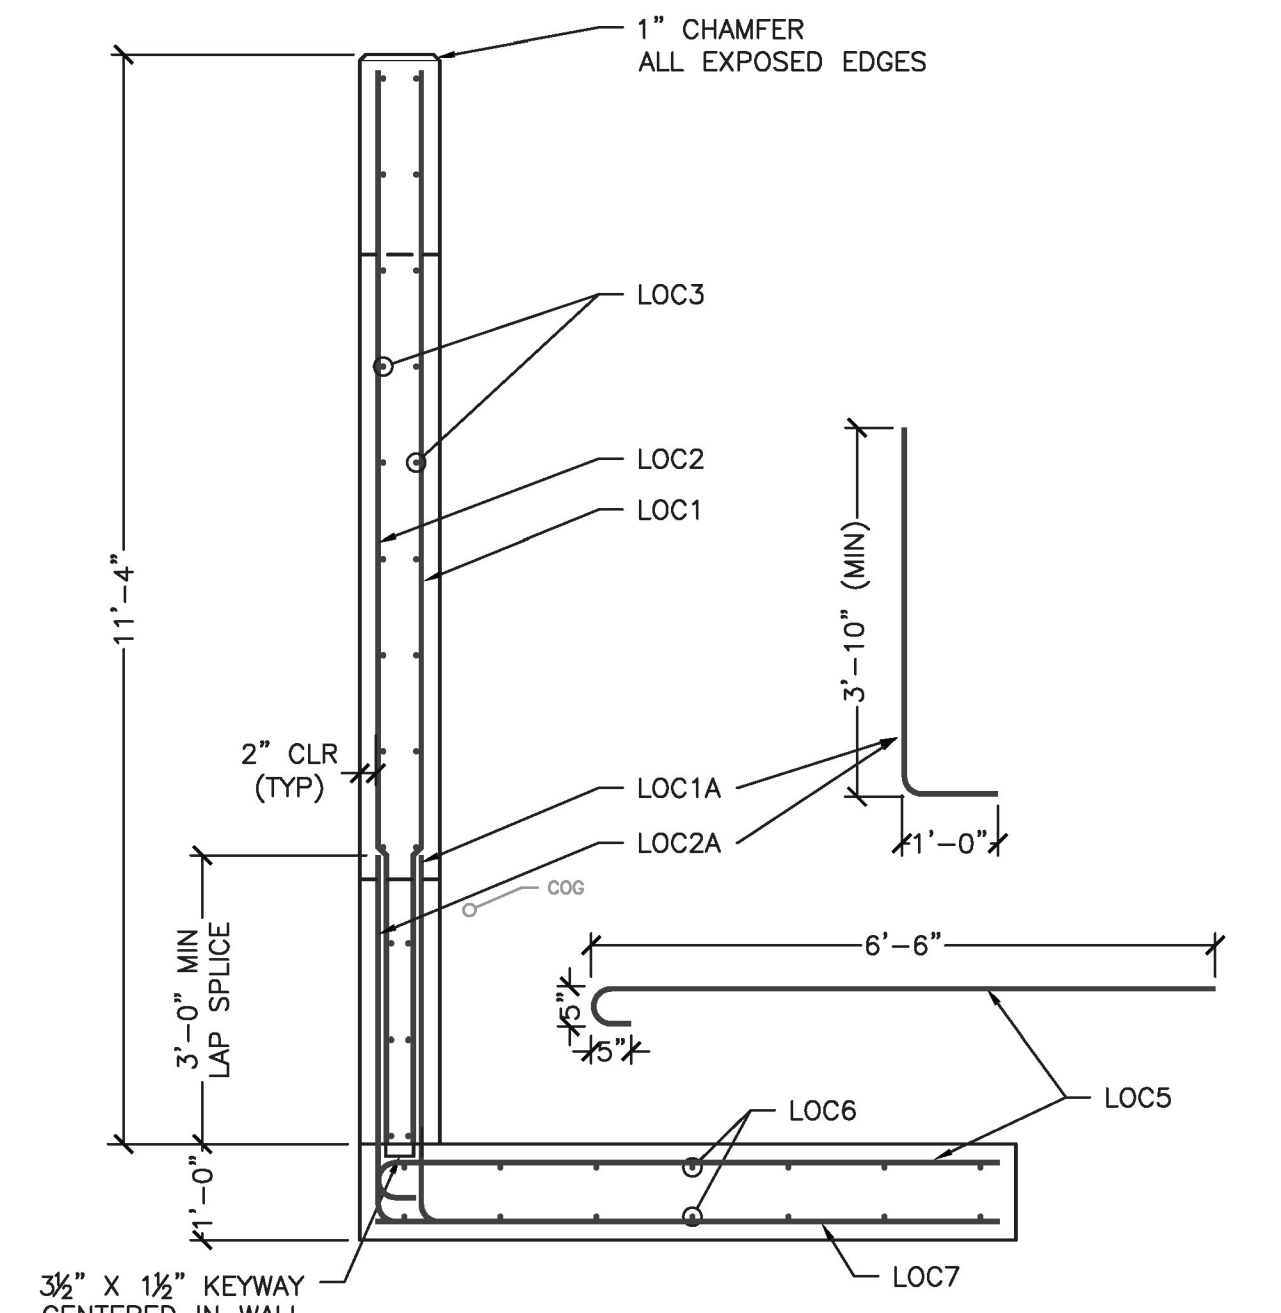

**10 WW REINFORCING SECTION**  
 S3.0  
 1/2" = 1'-0"

**WW4 REINFORCING SCHEDULE**

MARK	TYPE	SIZE	SPACING	QTY	LENGTH
LOC1	STR	#5	5"	20	11'-2"
LOC1A	LBAR	#5	6"	20	4'-9"
LOC2	STR	#4	12"	10	11'-2"
LOC2A	LBAR	#4	12"	10	4'-9"
LOC3	STR	#4	12"	24	10'-3" OF / 9'-10" IF
LOC5	HOOK	#6	6"	20	7'-1"
LOC6	STR	#4	12"	20	9'-7"
LOC7	STR	#4	12"	10	6'-6"

Prepared for:  
**Casella Construction, Inc.**  
 25 Industrial Ave.  
 Mendon, VT 05701

Scale: AS SHOWN  
 Checked by: XXX  
 Drawn by: CJP  
 Project No. 7910 Date: 3/7/2017

**VT Route 78 - VAOT # STP SCRIP (12)**  
 Higgate, VT  
 Outlet End Headwall Details


Professional Engineer  
 State of Vermont  
 License No. 8031  
 5/2/17

Rev	Date	By
XXX		



PO Box 736 ■ Stevenson, CT 06491  
 www.oxfordtechusa.com  
 Phone: (203) 268-6030  
 Fax: (203) 445-1240  
 info@oxfordtechusa.com

**Oxford Lift System®**

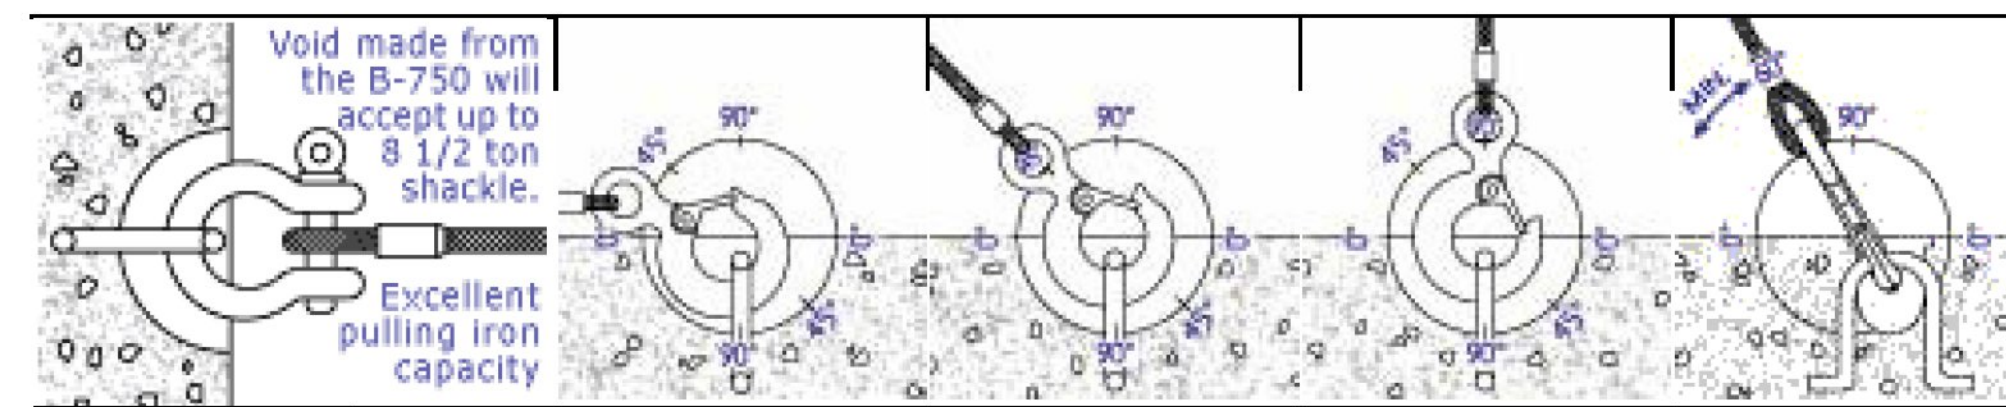

Anchor Product Code	Slab Min. Inches	Safe Working Load @ 90 degree Shear-0 degree Pull	Safe Working Load @ 90 degree Shear-45 degree Pull	Safe Working Load @ 90 degree Tension-90 degree Pull	Safe Working Load @ 90 degree Shear-60 degree Pull
A 500-3	4.00"	4,500	4,000	3,500	4,000
A 500-4	5.00"	8,000	5,500	4,000	5,000
A 500-5	6.00"	10,500	6,500	5,000	5,500
A 750-5	6.00"	12,500	8,000	7,000	7,000
A 750-7	8.00"	15,000	12,500	10,000	10,000

Note: Safe Working Load provides a factor of safety of approximately 4:1  
 Test Results are based on a minimum concrete compressive strength of 4,000 psi.

[<back](#) [next>](#)

Home	B-500 & B-750	S-150	S-300	Lift Anchor & Order Form	Concrete Products
Pull Iron Capacity	Anchors & Accessories	Toggle-Lok	Insert/Lift Anchor	Grid-Lok/ Rebar Chair	Helpful Calculations <small>COMING SOON!</small>



PO Box 736 ■ Stevenson, CT 06491  
 www.oxfordtechusa.com  
 Phone: (203) 268-6030  
 Fax: (203) 445-1240  
 info@oxfordtechusa.com

**Oxford Lift System®**

**Anchors & Accessories**


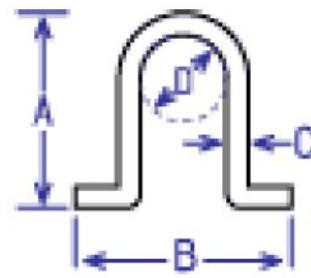

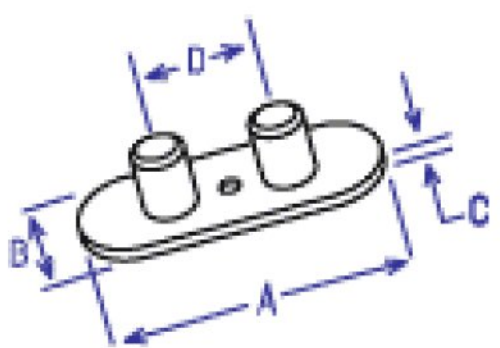
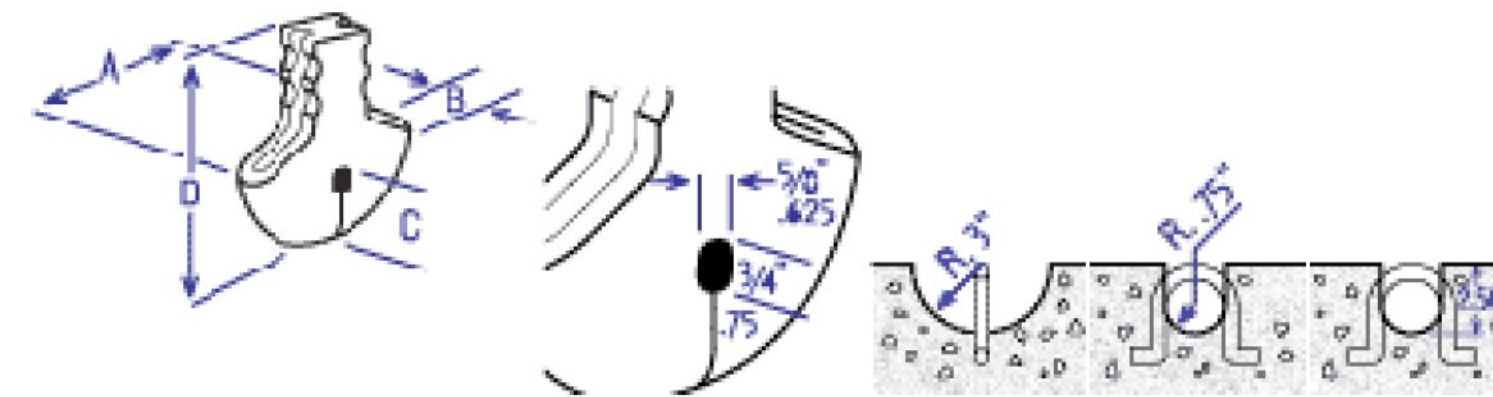
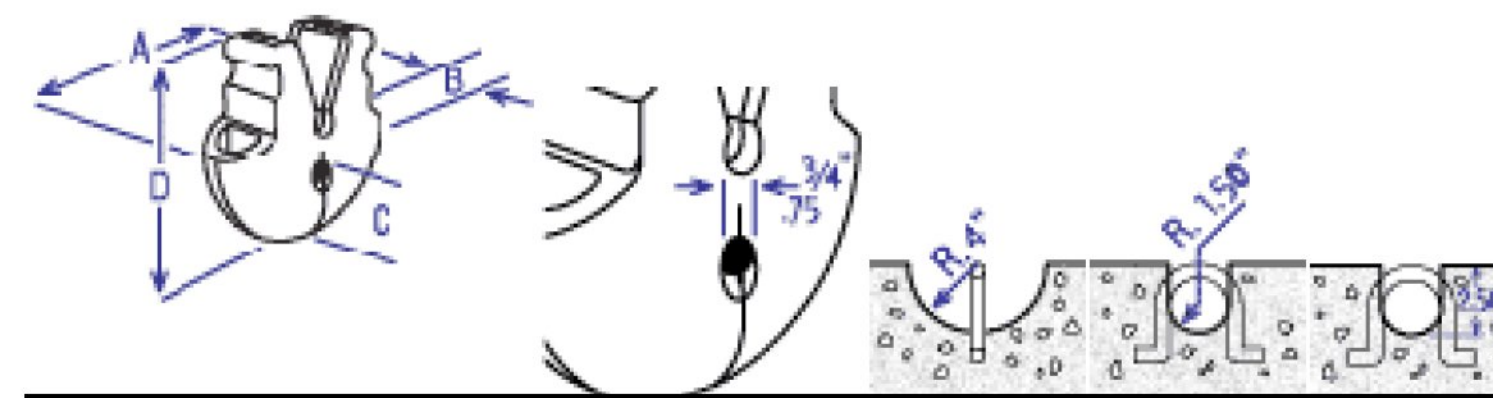
Anchor	Product Code	A	B	C	D	Unit Weight
	<b>A 500-3</b>	3.00"	6.25"	(1/2") .500"	2.00"	.625 lbs.
	<b>A 500-4</b>	4.00"	6.25"	(1/2") .500"	2.00"	.75 lbs.
	<b>A 500-5</b>	5.00"	6.25"	(1/2") .500"	2.00"	.775 lbs.
	<b>A 750-5</b>	4.75"	7.50"	(3/4") .750"	3.00"	1.75 lbs.
	<b>A 750-7</b>	6.75"	7.50"	(3/4") .750"	3.00"	2.00 lbs.
Block Out	Product Code	A	B	C	D	Unit Weight
	<b>B 500</b>	7.00"	2.00"	3.00"	(1/2") .500"	1.10 lbs.
	<b>Void Dimensions</b>					
	Shown without Anchor					
	<b>B 750</b>	8.00"	3.00"	4.00"	(3/4") .750"	3.50 lbs.
	<b>Void Dimensions</b>					
Shown without Anchor						
Mounting Plate	Product Code	A	B	C	D	Unit Weight
	<b>SMP 500</b> (Snap-On Mounting Plate)	6.50"	1.50"	(3/8") .375"	2.25"	7.95 lbs.
	<b>MMP 500</b> (Magnetic Mounting)	6.50"	1.50"	(3/8") .375"	2.25"	.900 lbs.

	Plate)				Unit	
	<b>SMP 750</b>					
	(Snap-On Mounting Plate)					
	7.25"	2.25"	(3/8") .375"	2.25"	1.75 lbs.	
	<b>MMP 750</b>					
	(Magnetic Mounting Plate)					
	7.25"	2.25"	(3/8") .375"	2.25"	2.00 lbs.	
Original Sink-It	Product Code	A	B	C	D	Unit Weight
	<b>S 150</b>	6.00"	1.50"	2.50"	6.75"	1.50 lbs.



	Product Code				Unit
	<b>S 300</b>				
S-300 Sink-It	A	B	C	D	Unit Weight
	8.00"	3.00"	3.50"	8.00"	4.00 lbs.

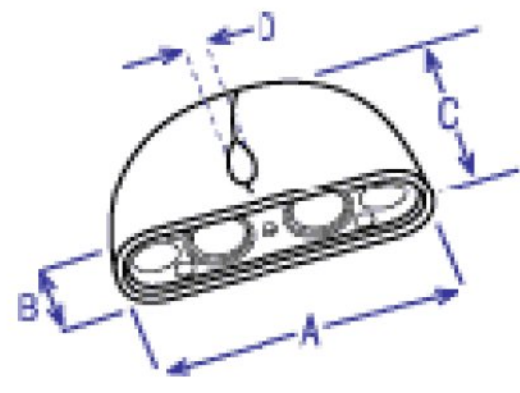


[<back](#) [next>](#)

Home	B-500 & B-750	S-150	S-300	Lift Anchor & Order Form	Concrete Products
Pull Iron Capacity	Anchors & Accessories	Toggle-Lok	Insert/Lift Anchor	Grid-Lok/Rebar Chair	Helpful Calculations <small>COMING SOON!</small>

INSERTS

**FI-57, FI-59, FI-61: EXPANDED COIL, FERRULE INSERT**

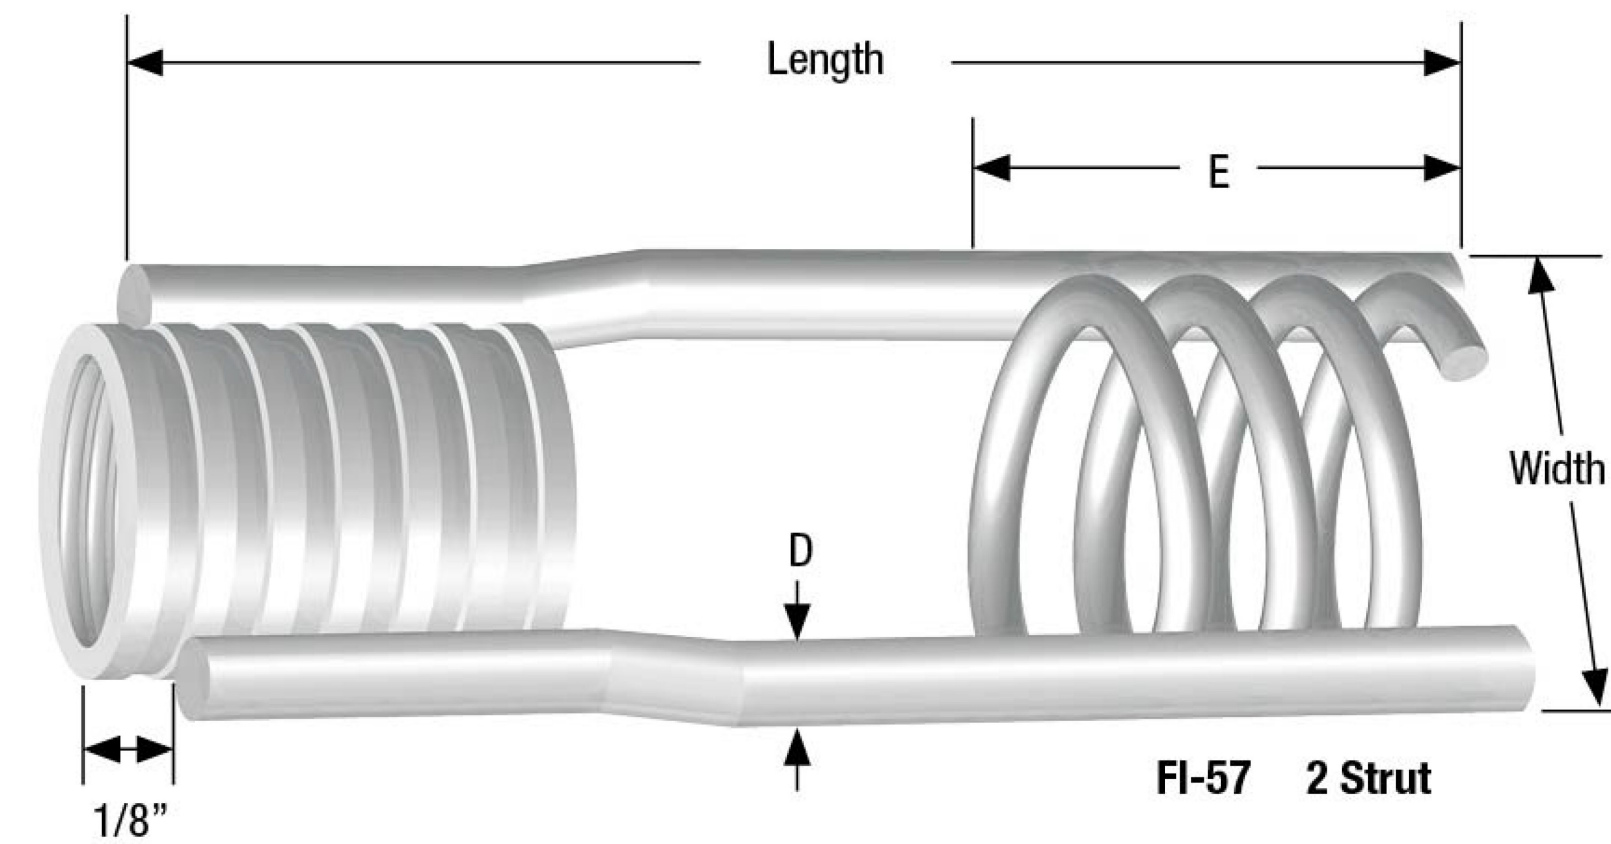


The Expanded Coil, Ferrule Insert is a high-strength, highly versatile insert available for numerous precast concrete applications. It is available in 3/4", 1", 1-1/4" and 1-1/2" bolt diameters. The insert is constructed with a NC threaded ferrule, shaped struts (two, four or six depending on model) and an expanded wire coil. This efficient design increases the shear cone surface area thus increasing the load capacity of the insert. Insert is available in plated finish.

Standard inserts not designed for use with hot dip galvanized bolts.



FI-59 4 Strut

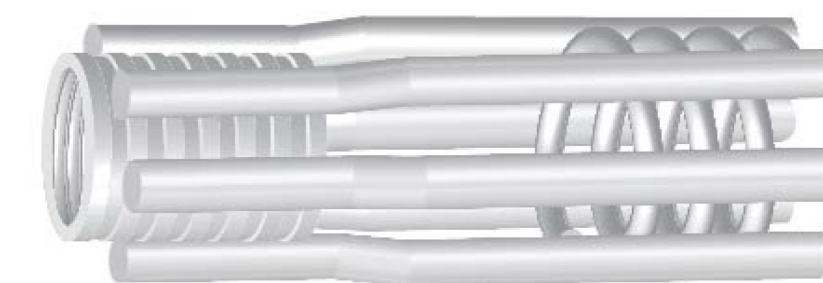


FI-61 6 Strut

**EXPANDED COIL, FERRULE INSERT DIMENSIONS AND LOAD CHART**


Part Number	Bolt Diameter	Threads per Inch (N.C.)	Length	Width	# of Struts	Wire Diameter D	E	Insert Ultimate Mechanical Capacity (lbs)	In-Concrete Capacity, 3:1 SWL		
									Min. Edge Distance	Tension (lbs)	Shear (lbs)
FI5734412P	3/4"	10	4-1/2"	2-3/8"	2	0.375"	1-5/8"	17,670	14"	5,890	5,890
FI571512P	1"	8	5-1/2"	2-7/8"	2	0.440"	2-1/8"	24,300	16"	8,100	8,100
FI59114712P	1-1/4"	7	7-1/2"	3-1/8"	4	0.440"	2-7/8"	39,930	18"	13,310	13,310
FI61112912P	1-1/2"	6	9-1/2"	3-3/8"	6	0.440"	3-7/8"	56,040	22"	18,680	18,680

Safe Working Load is based on 3,000 psi concrete and insert setback 1/2" from the concrete surface.

**FI-WW: WING WALL ANCHOR**

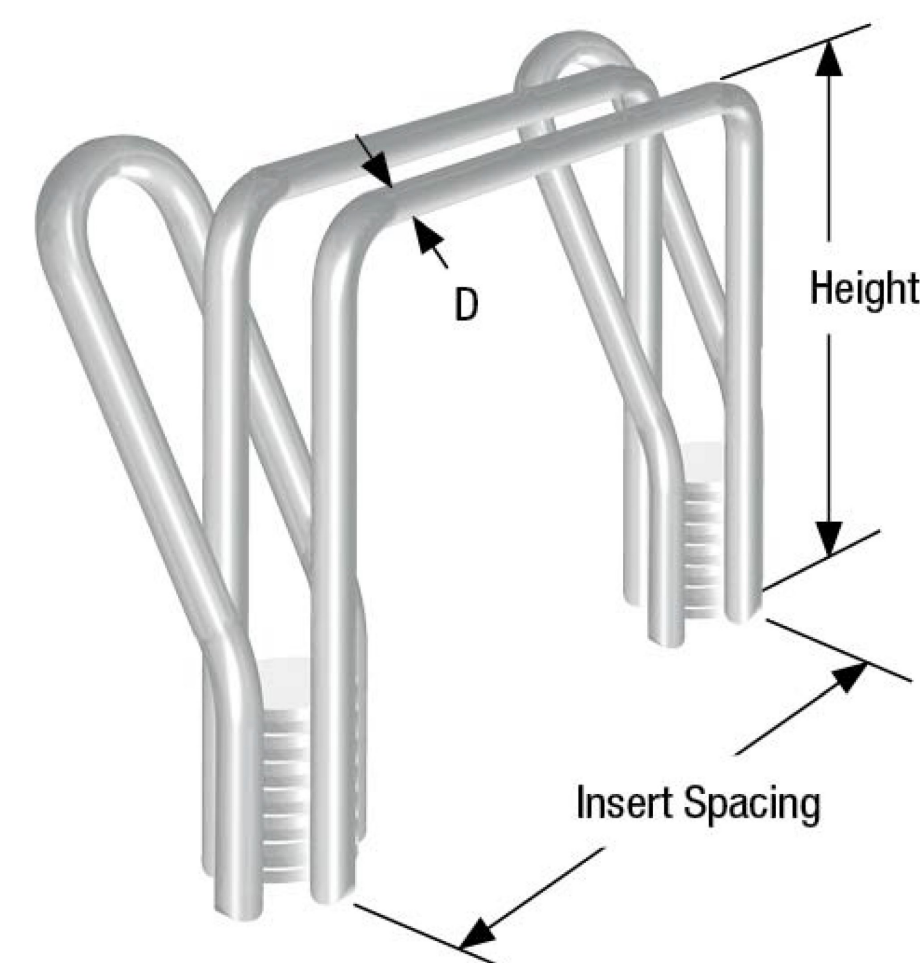

Fabricated for a precast concrete retaining wall which forms a wing wall for a precast concrete culvert unit, the Wing Wall Anchor supports a concrete footer projecting laterally from the wing wall into the back-filled soil behind the wing wall. Insert is available in plated finish.

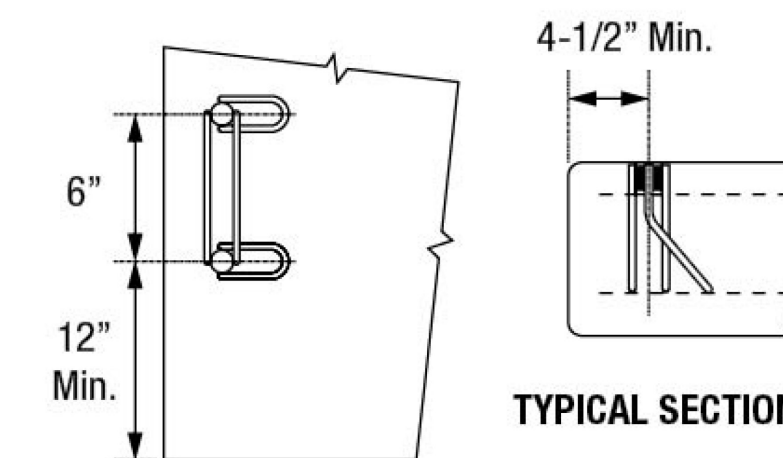

**WING WALL ANCHOR DIMENSIONS**

Part Number	Bolt Diameter	Insert Spacing	Height	Wire Diameter D	In-Concrete Capacity, 3:1 SWL	
					Tension (lbs)	Shear (lbs)
FIWW166P	1"	6"	6"	0.375"	8,500	4,500
FIWW168P	1"	6"	8"	0.375"	8,500	4,500

Safe Working Load is based on 3,000 psi concrete and insert setback 1/2" from the concrete surface.

Standard inserts not designed for use with hot dip galvanized bolts.

## **APPENDIX A – Trinity Material Certification and Fabrication Drawings**

***  
**CERTIFICATE**  
— OF MATERIALS —  
***

Customer: Bore Tech LLC  
Address: 1569 Breezy Hill Road  
City/State/Zip: St. Johnsbury, VT 05819

Date: 3/22/2017  
Date Shipped: April 2017  
Contract #: Highgate STP SCRIP (12) VAOT  
Our Order #: TPIO15878

**MATERIALS**

132LF of 72" OD x .750" Nom Wall. ASTM A252 Grade 3 Spiral Weld Steel Pipe. Bare. Bev x Sq Ends.  
Melted & Manufactured in The USA with Mill Test Reports (MTR's). Final Lengths TBD

Manufacturer: Domestic

**CERTIFICATION**

This will certify that to the best of my knowledge and belief, the above described material was produced with the following specifications:

ASTM A252 Grade 3. 45 KSI Min Yeild, 66 KSI Min Tensile  
Melted & Manufactured in USA with MTR's.

*Buyer Davis*

Subscribed and affirmed before me  
this 22nd day of March, 2017

JOAN McLAIN  
Notary Public - Notary Seal  
State of Missouri  
Commissioned for St. Charles County  
My Commission Expires: November 17, 2019  
Commission Number: 11384333

*Joan McLain*  
Notary Public



Trinity Products, LLC  
1969 West Terra Lane  
O'Fallon, Mo 63366

4

3

2

1

**NOTE TO FABRICATOR:**  
ALL HOLES TO BE FREE OF BURRS

**NOTE TO CUSTOMER:**

**TRINITY PRODUCTS, INC. STANDARD TOLERANCES**

**DRILLED AND/OR BURNED ITEMS:**

- DRILLED/BURNED HOLE SIZE: TOLERANCE (+1/16"; -0")
- DRILLED/BURNED HOLE PLACEMENT: TOLERANCE (+1/16"; -1/16")
- BURNED PARTS (NON-HOLE DIMS.): TOLERANCE (+1/16"; -1/16")

*DIMENSIONS APPLIED TO ITEMS CREATED ON A BURN TABLE, NOT INCLUDING HOLES - SEE PREVIOUS LISTINGS.*

**FOR CUT MATERIAL: MATERIAL MADE TO LENGTH TO INCLUDE, BUT NOT LIMITED TO, I-BEAM, CHANNEL, ANGLE, TUBING, PIPE, OR BARSTOCK ON EQUIPMENT SUCH AS A SAW, BEAM COPER, OR IRON WORKER.**

- WELDED CONNECTIONS: TOLERANCE (+1/8"; -1/8")  
*A PART WHOSE ENDS WILL BE WELDED TO ANOTHER PIECE OF STRUCTURAL MATERIAL WITH NO INTENTION OF BOLTING.*
- BOLTED END CONNECTIONS: TOLERANCE (+0"; -1/16")  
*A PART WHOSE ENDS WILL BE WELDED TO A MATCH PLATE OR FLANGE.*
- ANGLE OF CUT: TOLERANCE (+1 DEGREE; -1 DEGREE)

- FABRICATION PIPE CUTTING: TOLERANCE (+1/16"; -3/8")  
*DIMENSIONS APPLIED TO PIPES WHOSE END USE IS FABRICATION.*

**FOR GENERAL FITTING: THE ASSEMBLY OF ITEMS PER PRINTS PRIOR TO WELDING**

- WELDED MEMBERS: TOLERANCE (+1/8"; -1/8")  
*DIMENSIONS APPLIED TO ASSEMBLIES WHICH ARE STAND ALONE ASSEMBLIES AND HAVE NO CONNECTIONS TO BE MADE IN THE FIELD OR REQUIRE A WELDED CONNECTION IN THE FIELD.*
- BOLTED CONNECTIONS FOR SHOP FIT: TOLERANCE (+1/8"; -1/8")  
*DIMENSIONS APPLIED TO ASSEMBLIES WHICH TRINITY WILL BE PERFORMING A SHOP FIT TO ENSURE CONFORMANCE TO CUSTOMER DESIGN.*
- UNCONTROLLED BOLTED CONNECTIONS: TOLERANCE (+1/16"; -1/16")  
*DIMENSIONS APPLIED TO ASSEMBLIES WHICH WILL BE BOLTED TO AN OBJECT IN THE FIELD, TRINITY DOES NOT HAVE ACCESS TO CONFIRM ACCURACY OF CONNECTION.*

**TRINITY PRODUCTS, INC. SIGN POLE TOLERANCES**

- EXPOSED DIMENSIONS: TOLERANCE (+1/16"; -1/16" AT FIT, WITH +1/8"; -1/8" POST WELD.)  
*THE DIMENSION APPLIED TO THE DISTANCE FROM THE TOP OF A SIGNPOLE PIPE OR MATCH PLATE TO THE BASE OF THE CAP PLATE.*
- LENGTH OF PAINT OMISSION BELOW GRADE: TOLERANCE (+6"; -0")
- SPACER RINGS: TOLERANCE (+3/16"; -3/16" IF TRINITY IS PROVIDING THE LOWER POLE, AND +1/8"; -1/8" IF TRINITY IS NOT PROVIDING THE BASE POLE.)

**• FABRICATOR SHALL HOLD ALL LISTED TOLERANCES UNLESS OTHERWISE NOTED ON THE DRAWING.**

DUE TO PIPE LENGTHS AVAILABLE AT TIME OF ORDER CUSTOMER MAY HAVE MIDWELD PRODUCED TO AWS D1.1 PRE-QUALIFIED CJP WELD JOINT AND AISC SPECIFICATIONS. SEE BELOW FOR PRE QUALIFIED JOINT DETAILS:

- ALL PIPE WITH MAT'L THICKNESS LESS THAN OR EQUAL TO .500" NOMINAL AND OUTSIDE DIAMETER LESS THAN OR EQUAL TO 30":  
PREQUALIFICATION JOINT DESIGNATION: B-U4a-GF  
NOMENCLATURE: BEVEL-GROOVE WELD WITH BACKING BAND  
WELD PROCESS: FCAW  
ROOT OPENING: 3/16" +1/4"; -1/16"  
GROOVE ANGLE: 30 DEG +10 DEG; -5 DEG  
POSITIONS: ALL

- ALL PIPE WITH MAT'L THICKNESS GREATER THAN .500" NOMINAL AND OUTSIDE DIAMETER LESS THAN OR EQUAL TO 30":  
PREQUALIFICATION JOINT DESIGNATION: B-U4a-S  
NOMENCLATURE: BEVEL-GROOVE WELD WITH BACKING BAND  
WELD PROCESS: SAW  
ROOT OPENING: 3/8" +1/4"; -1/16"  
GROOVE ANGLE: 30 DEG +10 DEG; -5 DEG  
POSITIONS: FLAT

- ALL PIPE WITH MAT'L THICKNESS LESS THAN OR EQUAL TO .500" NOMINAL AND OUTSIDE DIAMETER GREATER THAN OR EQUAL TO 36":  
PREQUALIFICATION JOINT DESIGNATION: B-U4b-GF  
NOMENCLATURE: BEVEL-GROOVE WELD WITH BACKING WELD  
WELD PROCESS: FCAW  
ROOT OPENING: 0" +1/16"; -1/8"  
GROOVE ANGLE: 45 DEG +10 DEG; -5 DEG  
POSITIONS: ALL

- ALL PIPE WITH MAT'L THICKNESS GREATER THAN .500" NOMINAL AND OUTSIDE DIAMETER GREATER THAN OR EQUAL TO 36":  
PREQUALIFICATION JOINT DESIGNATION: B-L2c-S  
NOMENCLATURE: V BEVEL-GROOVE WELD WITH BACKGOUGE  
WELD PROCESS: SAW  
ROOT OPENING: 0" +1/16"; -0"  
GROOVE ANGLE: 60 DEG +10 DEG; -5 DEG  
POSITIONS: FLAT

**CUSTOMER APPROVAL:**

SIGNED _____ DATE _____

THIS FABRICATION DRAWING REPRESENTS TRINITY PRODUCTS' UNDERSTANDING OF THE DRAWINGS AND/OR REQUIREMENTS PROVIDED BY THE CUSTOMER. TRINITY PRODUCTS DOES NOT PROVIDE DESIGN, ENGINEERING OR ANALYSIS SERVICES. IT IS THE CUSTOMERS RESPONSIBILITY TO HAVE ALL DESIGNS AND DRAWINGS REVIEWED AND APPROVED BY THE APROPRIATE PARTIES. UNLESS OTHERWISE SHOWN, ALL MATERIAL SIZES AND THICKNESS ARE NOMINAL, MATERIAL SUPPLIED WILL BE WITHIN ASTM TOLERANCES

REQUIRED WELD PRE-HEAT	
MATERIAL THICKNESS	PRE-HEAT TEMP.
3/4" OR LESS	32 DEGREES
> 3/4" TO 1 1/2"	50 DEGREES
> 1 1/2" TO 2 1/2"	150 DEGREES
> 2 1/2"	225 DEGREES




<b>Trinity Products</b>			
TITLE BORE TECH			
SIZE B	JOB NO. 17-0219-JW	REV	
SCALE	SHEET 1 OF 2		

4

3

2

1

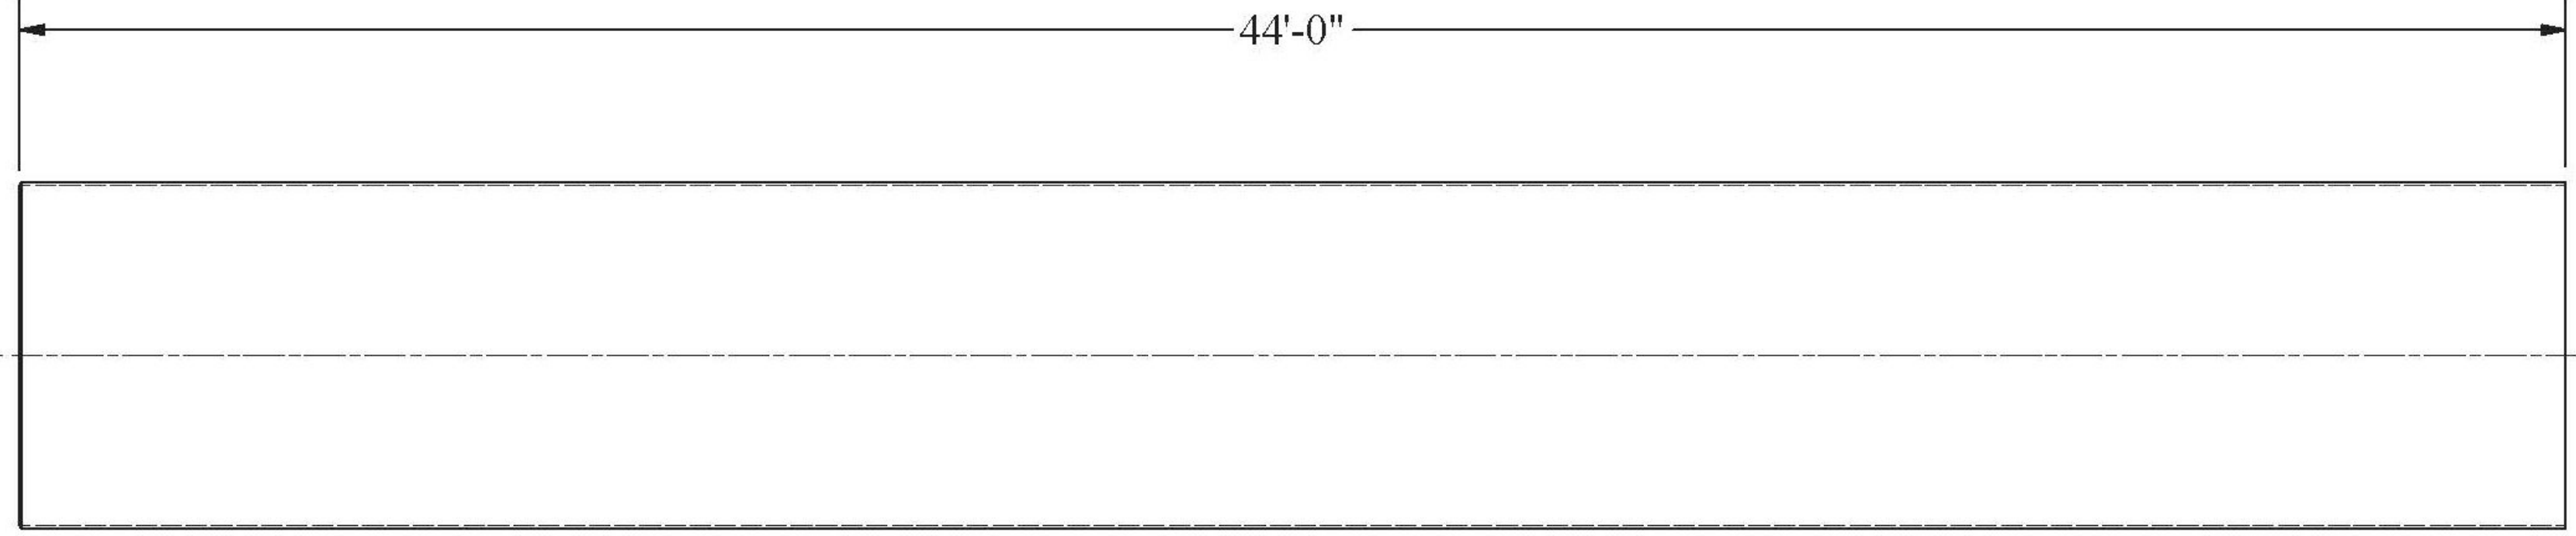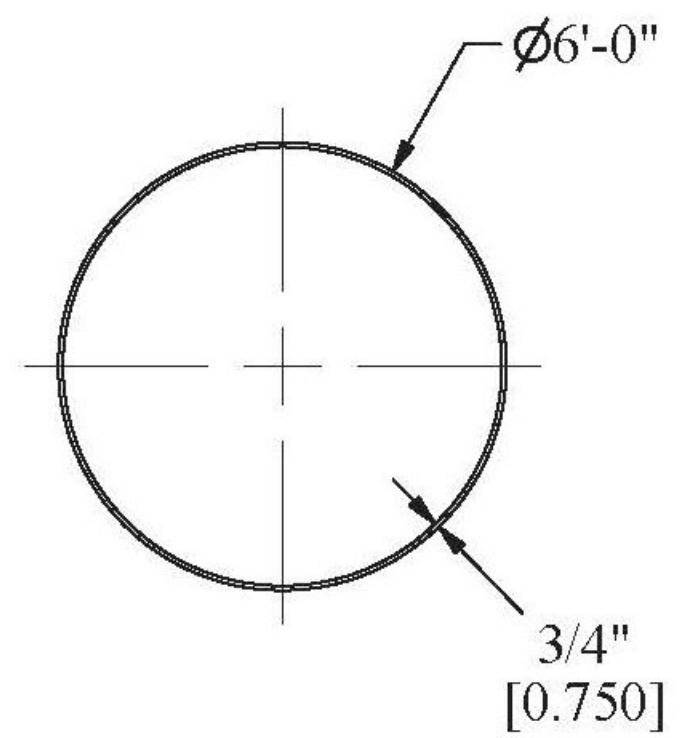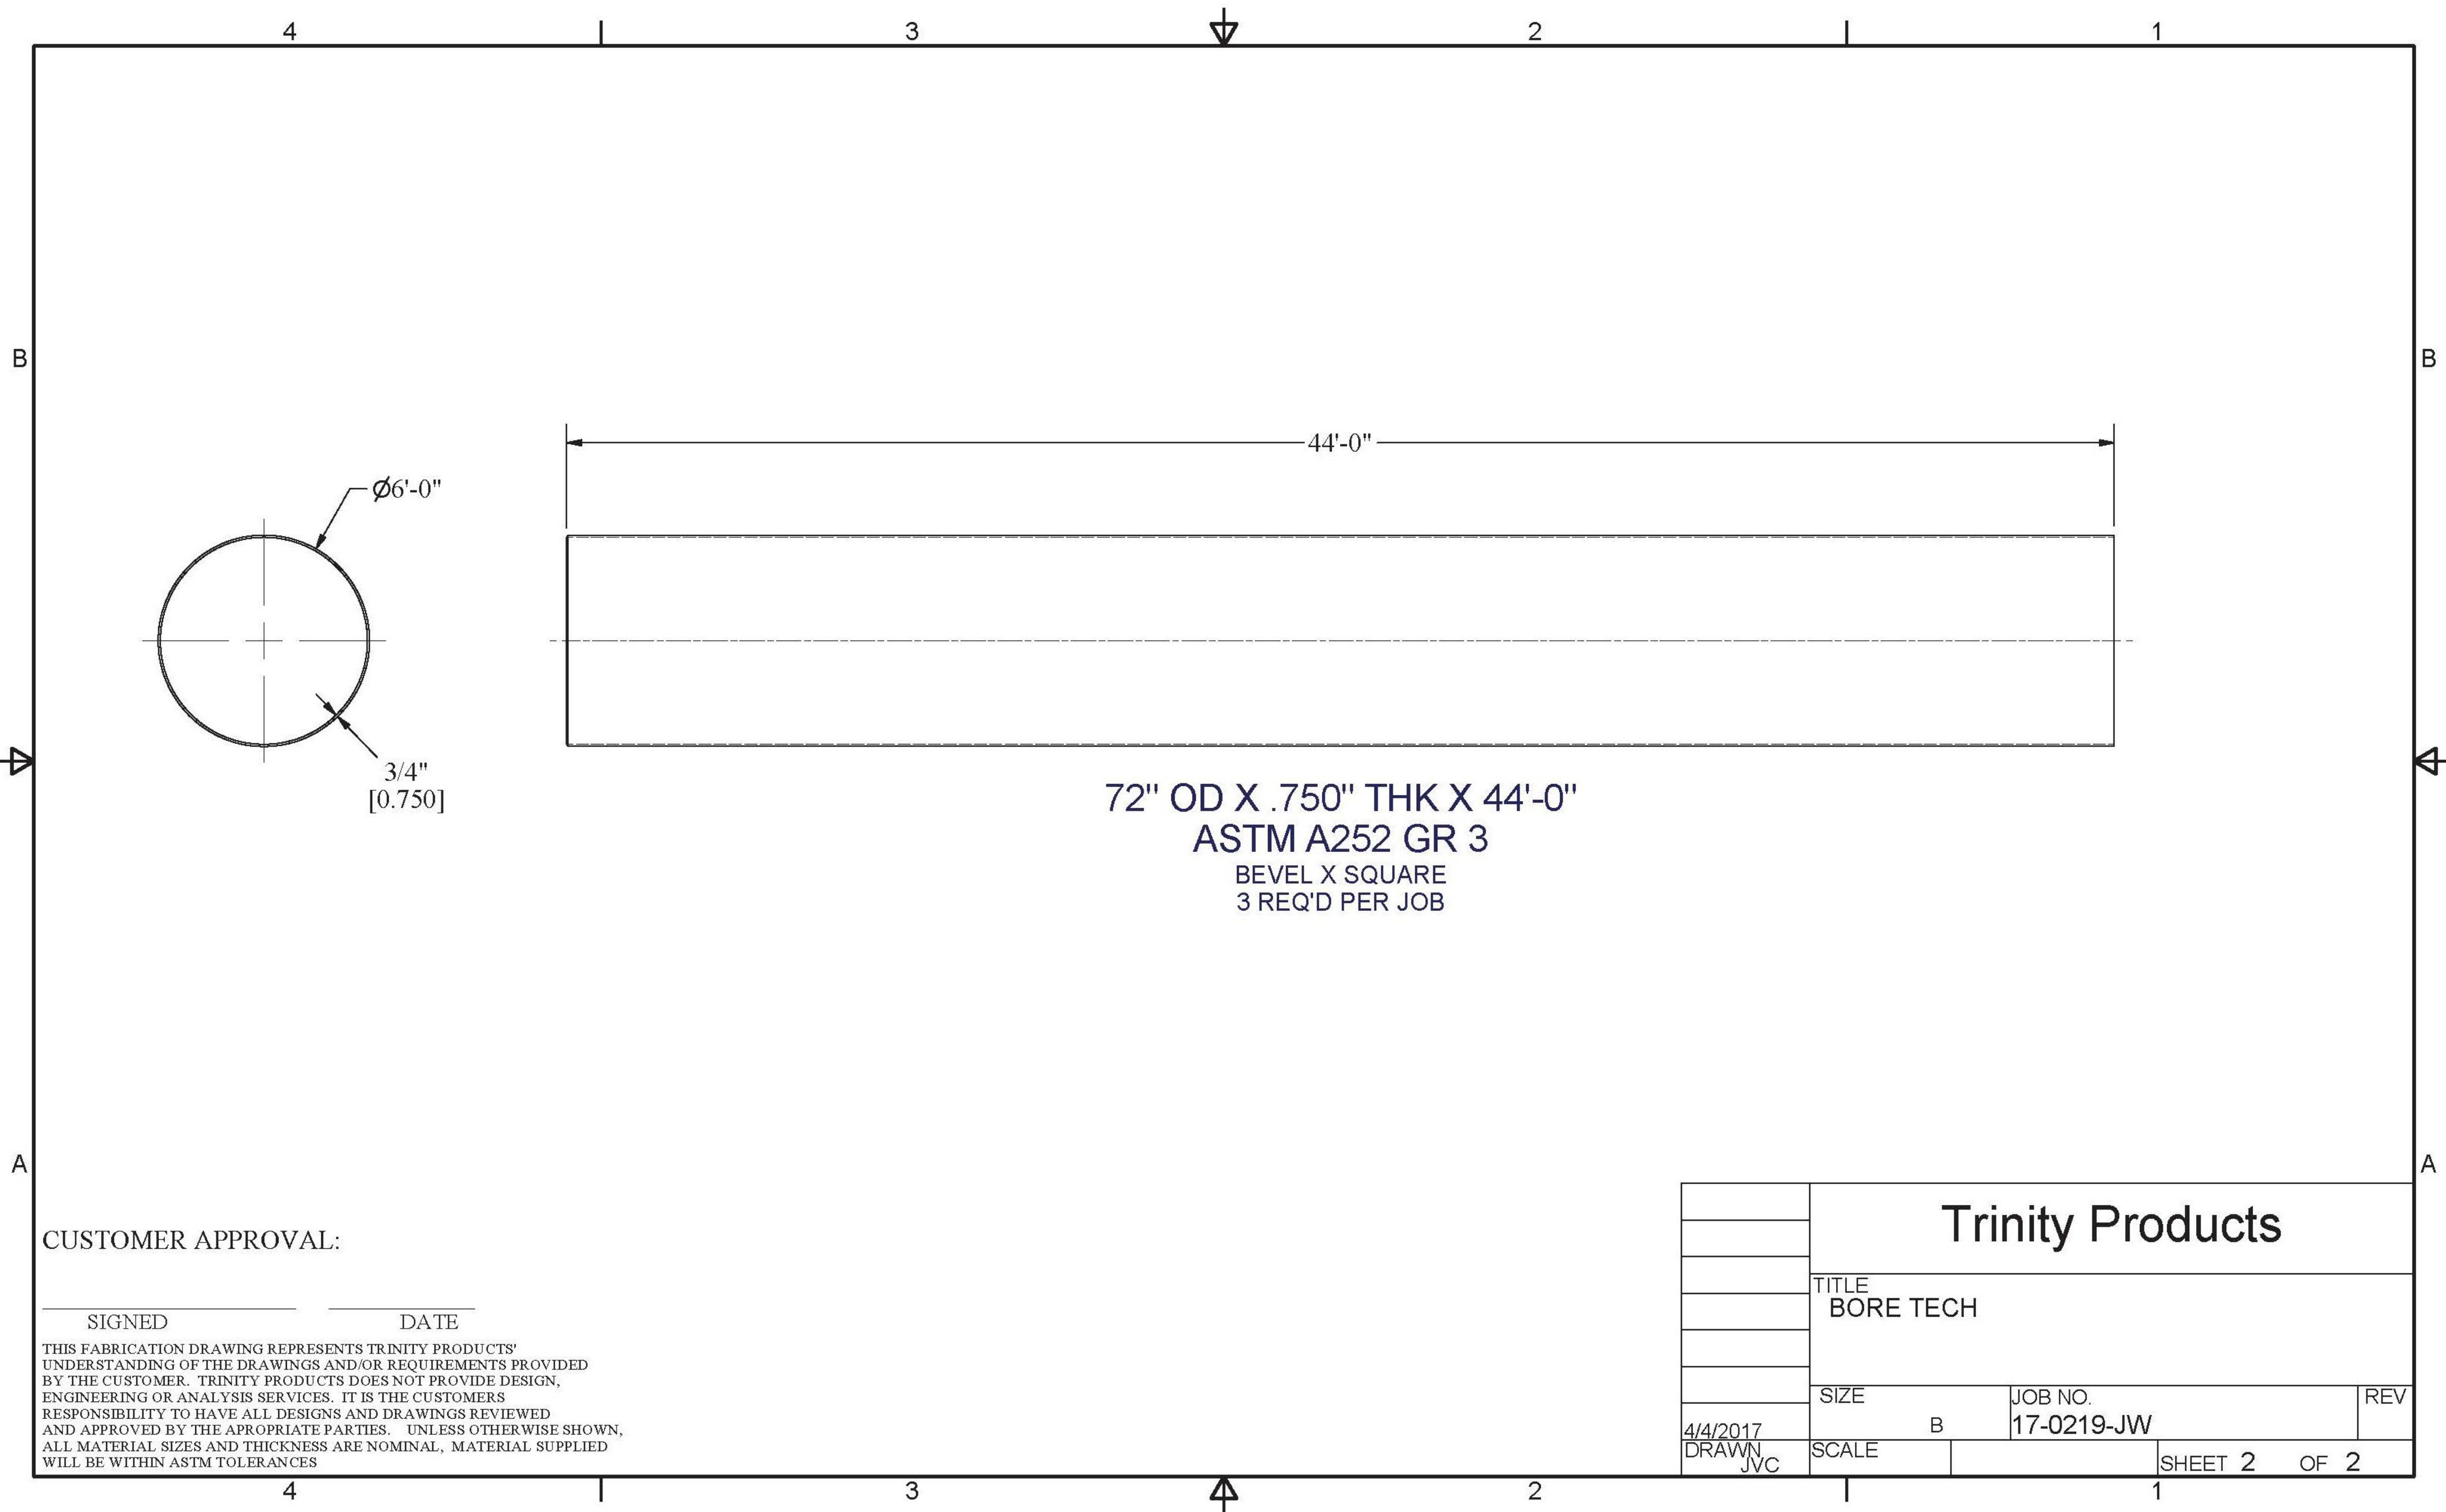

72" OD X .750" THK X 44'-0"  
 ASTM A252 GR 3  
 BEVEL X SQUARE  
 3 REQ'D PER JOB

CUSTOMER APPROVAL:

SIGNED _____ DATE _____  
 THIS FABRICATION DRAWING REPRESENTS TRINITY PRODUCTS' UNDERSTANDING OF THE DRAWINGS AND/OR REQUIREMENTS PROVIDED BY THE CUSTOMER. TRINITY PRODUCTS DOES NOT PROVIDE DESIGN, ENGINEERING OR ANALYSIS SERVICES. IT IS THE CUSTOMERS RESPONSIBILITY TO HAVE ALL DESIGNS AND DRAWINGS REVIEWED AND APPROVED BY THE APROPRIATE PARTIES. UNLESS OTHERWISE SHOWN, ALL MATERIAL SIZES AND THICKNESS ARE NOMINAL, MATERIAL SUPPLIED WILL BE WITHIN ASTM TOLERANCES

<b>Trinity Products</b>			
TITLE BORE TECH			
SIZE B	JOB NO. 17-0219-JW	REV	
4/4/2017 DRAWN JVC	SCALE	SHEET 2	OF 2

## **APPENDIX B – Welding Procedures and Welder Certification**

**WELDING PROCEDURE SPECIFICATION (WPS)**  
**PREQUALIFIED  QUALIFIED BY TESTING**   
**or PROCEDURE QUALIFICATION RECORDS (PQR) Yes**   
**AASHTO/AWS D1.5 Qualification Type 5.12.1  - 5.12.2  - 5.12.4**

Contractor/ Organization Boretech, LLC  
 Welding Process(es) SMAW  
 Type: Manual  Semiautomatic   
 Mechanized  Automatic   
 Tandem  Parallel

Identification WPS - 2 Fillet Field Welding of Cutting Shoe  
 Revision NA Date NA By NA  
 Authorized by Boretech, LLC Date NA  
 Supporting PQR No.(s) NA

Lap Joint  
**JOINT DESIGN USED**  
 Single  Double Weld   
 Backing: Yes  No  Material NA  
 Root Opening NA Root Face Dimension NA  
 Groove Angle NA Radius (J-U) NA  
 Backgouging: Yes  No  Method NA  
 Root Treatment Remove grease and oil with solvent.  
Surface will be cleaned with wire brush and grinder. Joint shall be dry prior to welding.

**POSITION**  
 Position of Groove NA Fillet Vertical 5G  
 Vertical Progression: Up  Down   
**ELECTRICAL CHARACTERISTICS**  
 Transfer Mode (GMAW): Globular  Spray   
 Current: AC  DCEP  DCEN  Pulsed   
 Electrical Stick Out NA  
 Other NA

**BASE METALS**  
 Material Spec. ASTM A252  
 Type or Grade Grade 3 Spiral Weld Steel Pipe  
 Thickness: Groove NA Fillet NA  
 Diameter (Pipe) 72"

**TECHNIQUE**  
 Stringer or Weave Bead Either  
 Multi-pass or Single Pass (per side) Either  
 Number of Electrodes 1  
 Electrode Spacing: Longitudinal NA  
 Lateral NA Angle NA  
 Interpass Cleaning Clean slag with chipping hammer and wire brush

**FILLER METALS**  
 AWS Specification AWS A5/A5.1M  
 AWS Classification E7018  
 Manufacturer Trade Name NA

**PREHEAT**  
 Preheat Temp., Min. 50 degrees F  
 Interpass Temp., Min. 50 degrees F  
 Interpass Temp., Max. 500 degrees F


**SHIELDING**  
 Flux NA Mfg. Trade Name NA  
 Electrode-Flux (Class) NA  
 Gas Composition NA  
 Flow Rate NA Gas Cup Size NA

**POSTWELD HEAT TREATMENT**  
 Temp. None Hold Time NA  
 Heating/Cooling Rate 15 minutes minimum

**HEAT INPUT**  
 Calculated Heat Input Value: kJ/in  kJ/mm   
 Max. Heat Input NA Min. Heat Input NA

**WELDING PROCEDURE**

Pass or Weld Layer(s)	Process	Filler Metals		Current		Volts	Travel Speed
		Diam.	Type & Polarity	Amps or Wire Feed Speed			
1	SMAW	1/8"	DCEP	115		21-25	4-8 ipm
2	SMAW	1/8"	DCEP	115		21-25	4-8 ipm
3	SMAW	1/8"	DCEP	115		21-25	4-8 ipm
4	SMAW	1/8"	DCEP	115		21-25	4-8 ipm
5	SMAW	1/8"	DCEP	115		21-25	4-8 ipm
6	SMAW	1/8"	DCEP	115		21-25	4-8 ipm
7	SMAW	1/8"	DCEP	115		21-25	4-8 ipm
8	SMAW	1/8"	DCEP	115		21-25	4-8 ipm

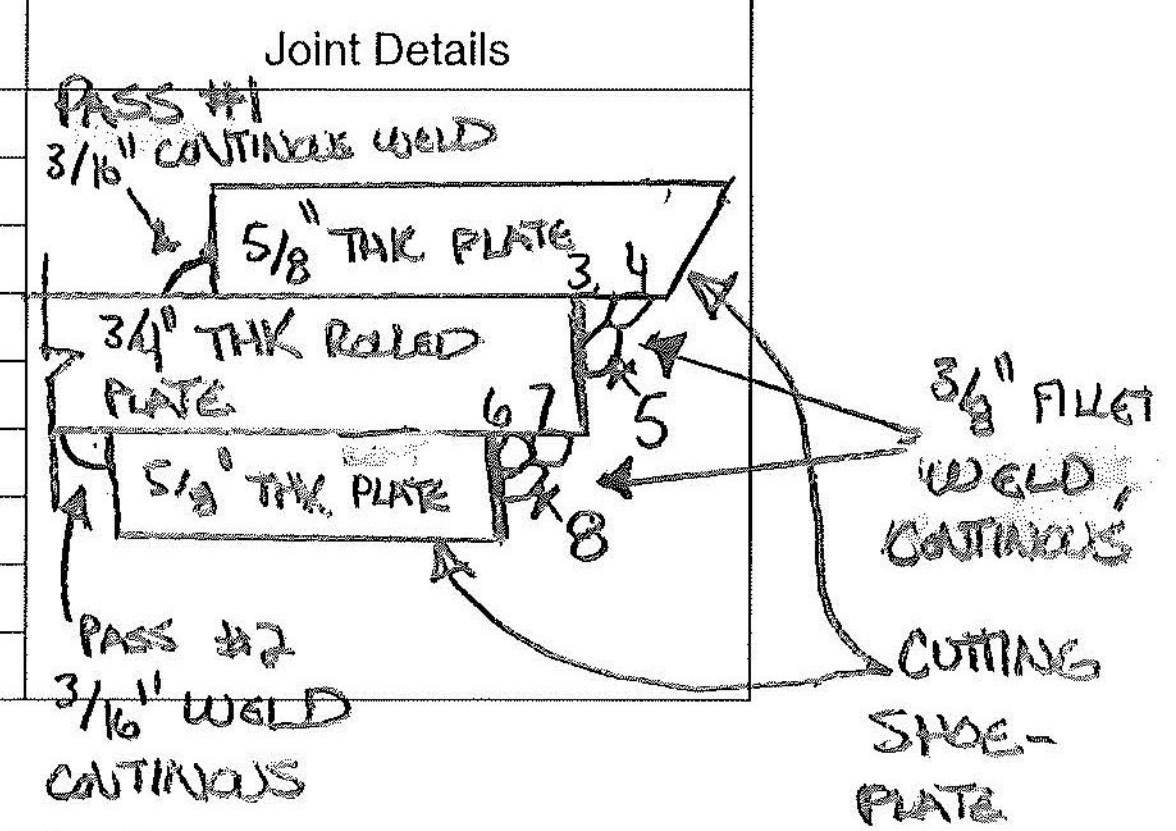

Form N-2

Max Layer Thickness will be 3/16" for all passes

Welding Procedure Specification

3/8" FILLET WELD, CONTINUOUS  
 CUTTING SHOE- PLATE ADDED TO END OF PIPE FOR REINFORCING

**WELDING PROCEDURE SPECIFICATION (WPS)**  
**PREQUALIFIED  QUALIFIED BY TESTING**   
**or PROCEDURE QUALIFICATION RECORDS (PQR) Yes**   
**AASHTO/AWS D1.5 Qualification Type 5.12.1  - 5.12.2  - 5.12.4**

Contractor/ Organization Boretech, LLC  
 Welding Process(es) SMAW  
 Type: Manual  Semiautomatic   
 Mechanized  Automatic   
 Tandem  Parallel

Single V Groove  
**JOINT DESIGN USED**  
 Single  Double Weld   
 Backing: Yes  No  Material NA  
 Root Opening 1/8" Root Face Dimension 1/8"  
 Groove Angle 30 Radius (J-U) NA  
 Backgouging: Yes  No  Method Bevel done at Fabricator  
 Root Treatment Remove grease and oil with solvent.  
Surface will be cleaned with wire brush and grinder. Joint shall be dry prior to welding.

**BASE METALS**  
 Material Spec. Pipe - ASTM A252  
 Type or Grade Grade 3 Spiral Weld Steel Pipe  
 Thickness: Groove 3/4" Fillet           
 Diameter (Pipe) 72

**FILLER METALS**  
 AWS Specification AWS A5/A5.1M  
 AWS Classification Pass 1 E6010 / Pass 2+ E7018  
 Manufacturer Trade Name NA

**SHIELDING**  
 Flux NA Mfg. Trade Name NA  
 Electrode-Flux (Class) NA  
 Gas Composition NA  
 Flow Rate NA Gas Cup Size NA

Identification WPS 1 - Full Penetration Field Welding of Pipe Sections  
 Revision NA Date NA By NA  
 Authorized by Boretech, LLC Date 4/26/17  
 Supporting PQR No.(s) NA

**POSITION**  
 Position of Groove All Fillet NA  
 Vertical Progression: Up  Down

**ELECTRICAL CHARACTERISTICS**  
 Transfer Mode (GMAW): Globular  Spray   
 Current: AC  DCEP  DCEN  Pulsed   
 Electrical Stick Out NA  
 Other NA

**TECHNIQUE**  
 Stringer or Weave Bead Either  
 Multi-pass or Single Pass (per side) Either  
 Number of Electrodes 1  
 Electrode Spacing: Longitudinal NA  
 Lateral          Angle           
 Interpass Cleaning Clean slag with chipping hammer and wire brush

**PREHEAT**  
 Preheat Temp., Min. 50 degrees F  
 Interpass Temp., Min. 50 degrees F  
 Interpass Temp., Max. 500 degree F

**POSTWELD HEAT TREATMENT**  
 Temp. None Hold Time NA  
 Heating/Cooling Rate 15 minutes minimum

**HEAT INPUT**  
 Calculated Heat Input Value: kJ/in  kJ/mm   
 Max. Heat Input NA Min. Heat Input NA

**WELDING PROCEDURE**

Pass or Weld Layer(s)	Process	Filler Metals		Current		Volts	Travel Speed
		Diam.	Type & Polarity	Amps or Wire Feed Speed			
1	SMAW	1/8" E6010	DCEP	115	21-25	4-8 ipm	
2+	SMAW	1/8" E7018	DCEP	115	21-25	4-8 ipm	

Form N-2

Form N-2—Sample Welding Procedure Specification

**WELDING PROCEDURE SPECIFICATION (WPS)**  
**PREQUALIFIED  QUALIFIED BY TESTING**   
**or PROCEDURE QUALIFICATION RECORDS (PQR) Yes**   
**AASHTO/AWS D1.5 Qualification Type 5.12.1  - 5.12.2  - 5.12.4**

Contractor/ Organization Boretech, LLC  
 Welding Process(es) SMAW  
 Type: Manual  Semiautomatic   
           Mechanized  Automatic   
           Tandem  Parallel

Identification WPS - 3 Fillet Field Welding of IGPS Housing  
 Revision NA Date NA By NA  
 Authorized by Boretech, LLC Date 4/26/17  
 Supporting PQR No.(s) NA

Butt Joint  
**JOINT DESIGN USED**  
 Single  Double Weld   
 Backing: Yes  No  Material NA  
 Root Opening NA Root Face Dimension NA  
 Groove Angle NA Radius (J-U) NA  
 Backgouging: Yes  No  Method NA  
 Root Treatment Remove grease and oil with solvent.

**POSITION**  
 Position of Groove NA Fillet Vertical 5G  
 Vertical Progression: Up  Down

**ELECTRICAL CHARACTERISTICS**  
 Transfer Mode (GMAW): Globular  Spray   
 Current: AC  DCEP  DCEN  Pulsed   
 Electrical Stick Out NA  
 Other NA

**BASE METALS**  
 Material Spec. Pipe - ASTM A252 / IGPS Housing - A36  
 Type or Grade Pipe - Grade 3 Spiral Weld Steel Pipe / IGPS Housing - NA  
 Thickness: Groove NA Fillet NA  
 Diameter (Pipe) 72"

**TECHNIQUE**  
 Stringer or Weave Bead Either  
 Multi-pass or Single Pass (per side) Either  
 Number of Electrodes 1  
 Electrode Spacing: Longitudinal NA  
 Lateral NA Angle NA  
 Interpass Cleaning Clean slag with chipping hammer and wire brush

**FILLER METALS**  
 AWS Specification AWS A5/A5.1M  
 AWS Classification E7018  
 Manufacturer Trade Name NA

**PREHEAT**  
 Preheat Temp., Min. 50 degrees F  
 Interpass Temp., Min. 50 degrees F  
 Interpass Temp., Max. 500 degrees F

**SHIELDING**  
 Flux NA Mfg. Trade Name NA  
 Electrode-Flux (Class) NA  
 Gas Composition NA  
 Flow Rate NA Gas Cup Size NA

**POSTWELD HEAT TREATMENT**  
 Temp. None Hold Time NA  
 Heating/Cooling Rate 15 minutes minimum

**HEAT INPUT**  
 Calculated Heat Input Value: kJ/in  kJ/mm   
 Max. Heat Input NA Min. Heat Input NA

**WELDING PROCEDURE**

Pass or Weld Layer(s)	Process	Filler Metals	Current		Volts	Travel Speed	Diagram
		Diam.	Type & Polarity	Amps or Wire Feed Speed			
<u>ALL</u>	<u>SMAW</u>	<u>1/8"</u>	<u>DCEP</u>	<u>115</u>	<u>21-25</u>	<u>4-8 ipm</u>	
		<u>ALL PASSES WILL HAVE MAX 3/16\"</u>					

Form N-2

Form N-2—Sample Welding Procedure Specification

**WELDING PROCEDURE SPECIFICATION (WPS)**  
**PREQUALIFIED  QUALIFIED BY TESTING**   
**or PROCEDURE QUALIFICATION RECORDS (PQR) Yes**   
**AASHTO/AWS D1.5 Qualification Type 5.12.1  - 5.12.2  - 5.12.4**

Contractor/ Organization Boretech, LLC  
 Welding Process(es) SMAW  
 Type: Manual  Semiautomatic   
 Mechanized  Automatic   
 Tandem  Parallel

Butt Joint  
**JOINT DESIGN USED**  
 Single  Double Weld   
 Backing: Yes  No  Material NA  
 Root Opening NA Root Face Dimension NA  
 Groove Angle NA Radius (J-U) NA  
 Backgouging: Yes  No  Method NA  
 Root Treatment Remove grease and oil with solvent.  
 Surface will be cleaned with wire brush and grinder. Joint shall be dry prior to welding.

**BASE METALS**  
 Material Spec. Pipe - ASTM A252 / IGPS Strap - A36  
 Type or Grade Pipe - Grade 3 Spiral Weld Steel Pipe / IGPS Strap - NA  
 Thickness: Groove NA Fillet NA  
 Diameter (Pipe) 72"

**FILLER METALS**  
 AWS Specification AWS A5/A5.1M  
 AWS Classification E6010  
 Manufacturer Trade Name NA

**SHIELDING**  
 Flux NA Mfg. Trade Name NA  
 Electrode-Flux (Class) NA  
 Gas Composition NA  
 Flow Rate NA Gas Cup Size NA

Identification WPS - 4 Fillet Field Welding of IGPS Sleeve Strap  
 Revision NA Date NA By NA  
 Authorized by Boretech, LCC Date 4/26/17  
 Supporting PQR No.(s) NA

**POSITION**  
 Position of Groove NA Fillet Vertical 5G  
 Vertical Progression: Up  Down

**ELECTRICAL CHARACTERISTICS**  
 Transfer Mode (GMAW): Globular  Spray   
 Current: AC  DCEP  DCEN  Pulsed   
 Electrical Stick Out NA  
 Other NA

**TECHNIQUE**  
 Stringer or Weave Bead Either  
 Multi-pass or Single Pass (per side) Single  
 Number of Electrodes 1  
 Electrode Spacing: Longitudinal NA  
 Lateral NA Angle NA  
 Interpass Cleaning Clean slag with chipping hammer and wire brush

**PREHEAT**  
 Preheat Temp., Min. 50  
 Interpass Temp., Min. 50  
 Interpass Temp., Max. 500

**POSTWELD HEAT TREATMENT**  
 Temp. None Hold Time NA  
 Heating/Cooling Rate 15 minutes minimum


**HEAT INPUT**  
 Calculated Heat Input Value: kJ/in  kJ/mm   
 Max. Heat Input NA Min. Heat Input NA

**WELDING PROCEDURE**

Pass or Weld Layer(s)	Process	Filler Metals Diam.	Current		Volts	Travel Speed	Joint Details
			Type & Polarity	Amps or Wire Feed Speed			
ALL	SMAW	3/16"	DCEP	115	21-25	4-8 ipm	

Form N-2

Form N-2—Sample Welding Procedure Specification

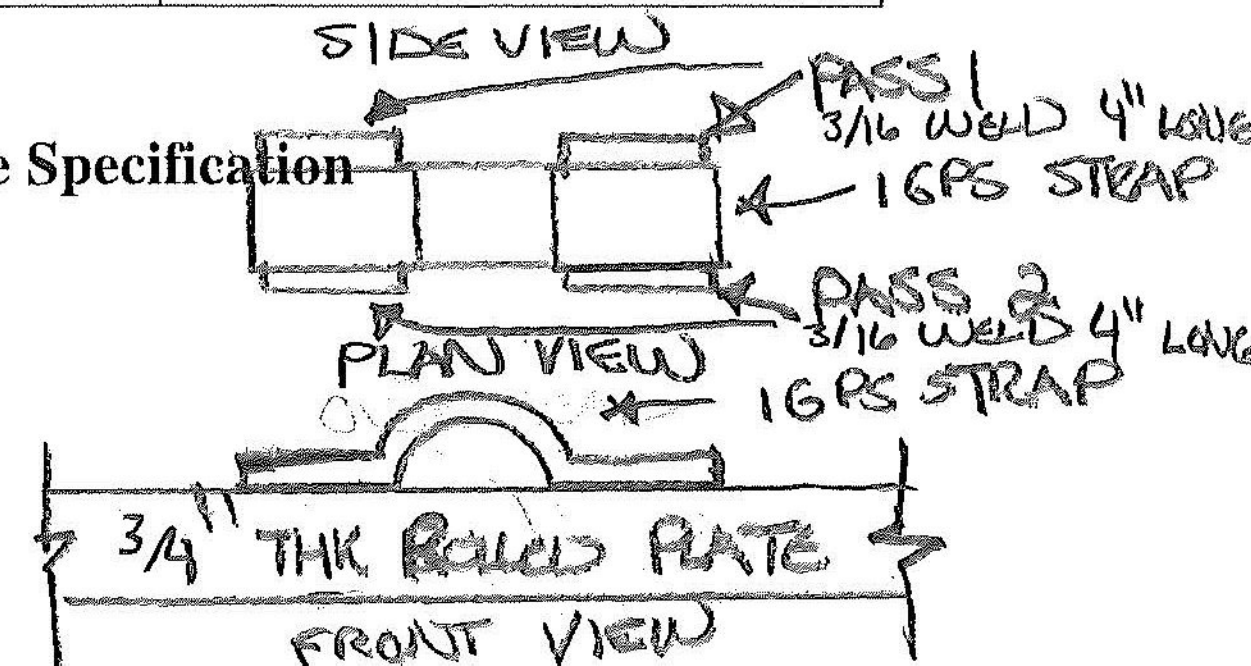

**WELDER, WELDING OPERATOR OR TRACK WELDER QUALIFICATION TEST RECORD**

Code: AASHTO/AWS D1.5M/D1.5:2010

Name: Seth Henley

Identification No. 031617SH

Welding Procedure Specification No. B2.1-1-016:1994

Date: 03/16/2017

Variables		Record Actual Values Used in Qualification	Qualification Range
Process/Type	<b>PLEASE NOTE THIS WAS ALSO SENT TO RYAN FOSTER on 4/11/17, ADDED 4/10/17, JTC CCI</b>	SMAW	SMAW
Electrode (single or multiple)		Single	Single
Current/Polarity		DCEP	DCEP
Position		3G	Flat/Horizontal/Vertical
Weld Progression		Uphill	Uphill Only
Backing (YES or NO)		Yes	With Steel Backing Only
Material/Spec.		M 270M/ M270 (A 709/A 709M) Gr. 250 [Gr. 36]	M 270M/ M270 (A 709/A 709M) Gr. 250 [Gr. 36]
Base Material			
	Thickness (Plate)		
	Groove	1"	1/8" to Unlimited
	Fillet	N/A	Flat, Horizontal, Vertical Fillets
	Thickness: (Pipe/Tube)		
	Groove	N/A	1/8" to Unlimited
	Fillet	N/A	Unlimited Thickness
	Diameter: (Pipe)		
	Groove	N/A	N/A
	Fillet	N/A	N/A
Filler Metal			
	Spec. No.	AWS A5.1	AWS A5.1/A5.1M or AWS A5.5/A5.5M
	Class	E7018	All Listed in Table 4.1 under pre-qualified
F-No.		F4	F4 Only
Gas/Flux Type		N/A	N/A
Other		N/A	N/A

**Visual Inspection: Acceptable YES or NO**

**Guided Bend Test Results**

Type	Results	Type	Results
Side	Accept		N/A
Side	Accept		N/A

**Fillet Test Results**

Appearance: N/A	Fillet Size: N/A
Fracture Test Root Penetration: N/A	Macro etch: N/A
(Describe the location, nature and size of any crack or tearing of specimen.)	
N/A	


Inspected by: Chris Govoni	Test No: N/A
Organization: Advanced Welding Institute	Date: 3/16/2017

**Radiographic Results**

Film Identification			Film Identification		
Number	Results	Remarks	Number	Results	Remarks

Interpreted by: N/A	Test Number: N/A
Organization: N/A	Date: N/A

We, the undersigned, certify that the statements in this record are correct and that the test welds were prepared, welded and tested in accordance with the requirements of Section 5 of AASHTO/AWS D1.5M/D1.5:2010 Bridge Welding Code

Inspected by:  Chris Govoni, AWS/CWI	Witnessed by: Chris Govoni
Contractor: CS Welding & Repair	Date: 3/16/2017

**WELDER, WELDING OPERATOR OR TRACK WELDER QUALIFICATION TEST RECORD**

Code: AASHTO/AWS D1.5M/D1.5:2010

Name: Seth Henley

Identification No. 031617SH

Welding Procedure Specification No. B2.1-1-016:1994

Date: 3/16/2017

Variables		Record Actual Values Used in Qualification	Qualification Range
Process/Type		SMAW	SMAW
Electrode (single or multiple)	<b>PLEASE NOTE THIS WAS ALSO SENT TO RYAN FOSTER on 4/11/17, ADDED 4/10/17, JTC CCI</b>	Single	Single
Current/Polarity		DCEP	DCEP
Position		4G	Flat/Overhead
Weld Progression		N/A	N/A
Backing (YES or NO)		Yes	With Steel Backing Only
Material/Spec.		M 270M/ M270 (A 709/A 709M) Gr. 250 [Gr. 36]	M 270M/ M270 (A 709/A 709M) Gr. 250 [Gr. 36]
Base Material	Thickness (Plate)		
	Groove	1"	1/8" to Unlimited
	Fillet	N/A	Flat, Horizontal, Overhead Fillets
	Thickness: (Pipe/Tube)		
	Groove	N/A	1/8" to Unlimited
	Fillet	N/A	Unlimited Thickness
	Diameter: (Pipe)		
	Groove	N/A	N/A
Filler Metal	Fillet	N/A	N/A
	Spec. No.	AWS A5.1	AWS A5.1/A5.1M or AWS A5.5/A5.5M
	Class	E7018	All Listed in Table 4.1 under pre-qualified
	F-No.	F4	F4 Only
Gas/Flux Type		N/A	N/A
Other		N/A	N/A

**Visual Inspection: Acceptable YES or NO**

**Guided Bend Test Results**

Type	Results	Type	Results
Side	Accept		N/A
Side	Accept		N/A

**Fillet Test Results**

Appearance: N/A	Fillet Size: N/A
Fracture Test Root Penetration: N/A	Macro etch: N/A
(Describe the location, nature and size of any crack or tearing of specimen.)	
N/A	


Inspected by: Chris Govoni	Test No: N/A
Organization: Advanced Welding Institute	Date: 3/16/2017

**Radiographic Results**

Film Identification			Film Identification		
Number	Results	Remarks	Number	Results	Remarks

Interpreted by: N/A	Test Number: N/A
Organization: N/A	Date: N/A

We, the undersigned, certify that the statements in this record are correct and that the test welds were prepared, welded and tested in accordance with the requirements of Section 5 of AASHTO/AWS D1.5M/D1.5:2010 Bridge Welding Code

Inspected by:	 Chris Govoni AWS/CWI	Witnessed by: Chris Govoni
Contractor:	CS Welding & Repair	Date: 3/16/2016