



RECLAIM TO COLD PLANE TRANSITION DETAIL


ROCHESTER
VT. ROUTE 73: MM 4.889 = STA R 258+13.92

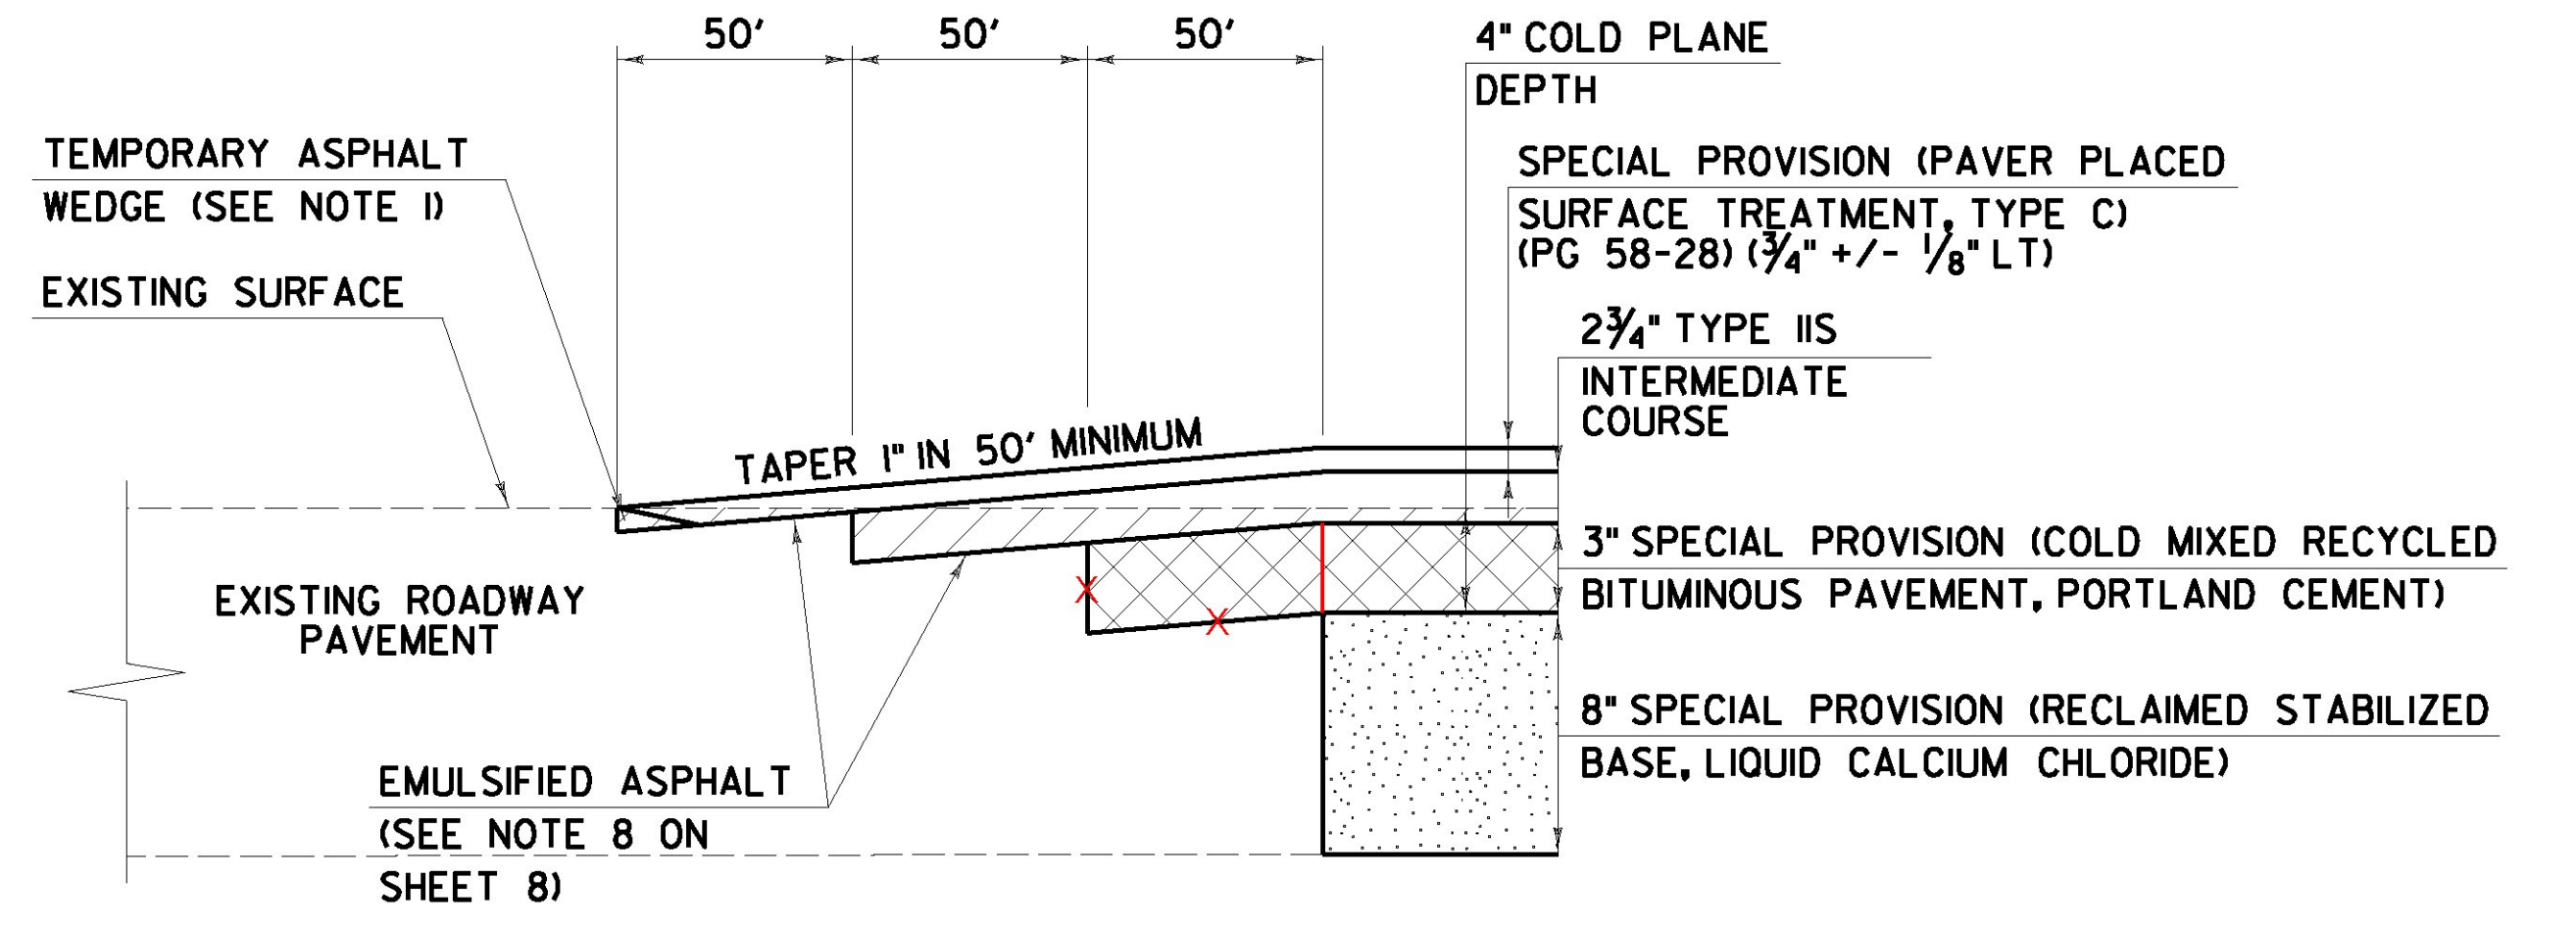

RECLAIM APPROACH AREA DETAIL
VT. ROUTE 73 ROCHESTER STA R 0+00.00 - BEGIN PROJECT

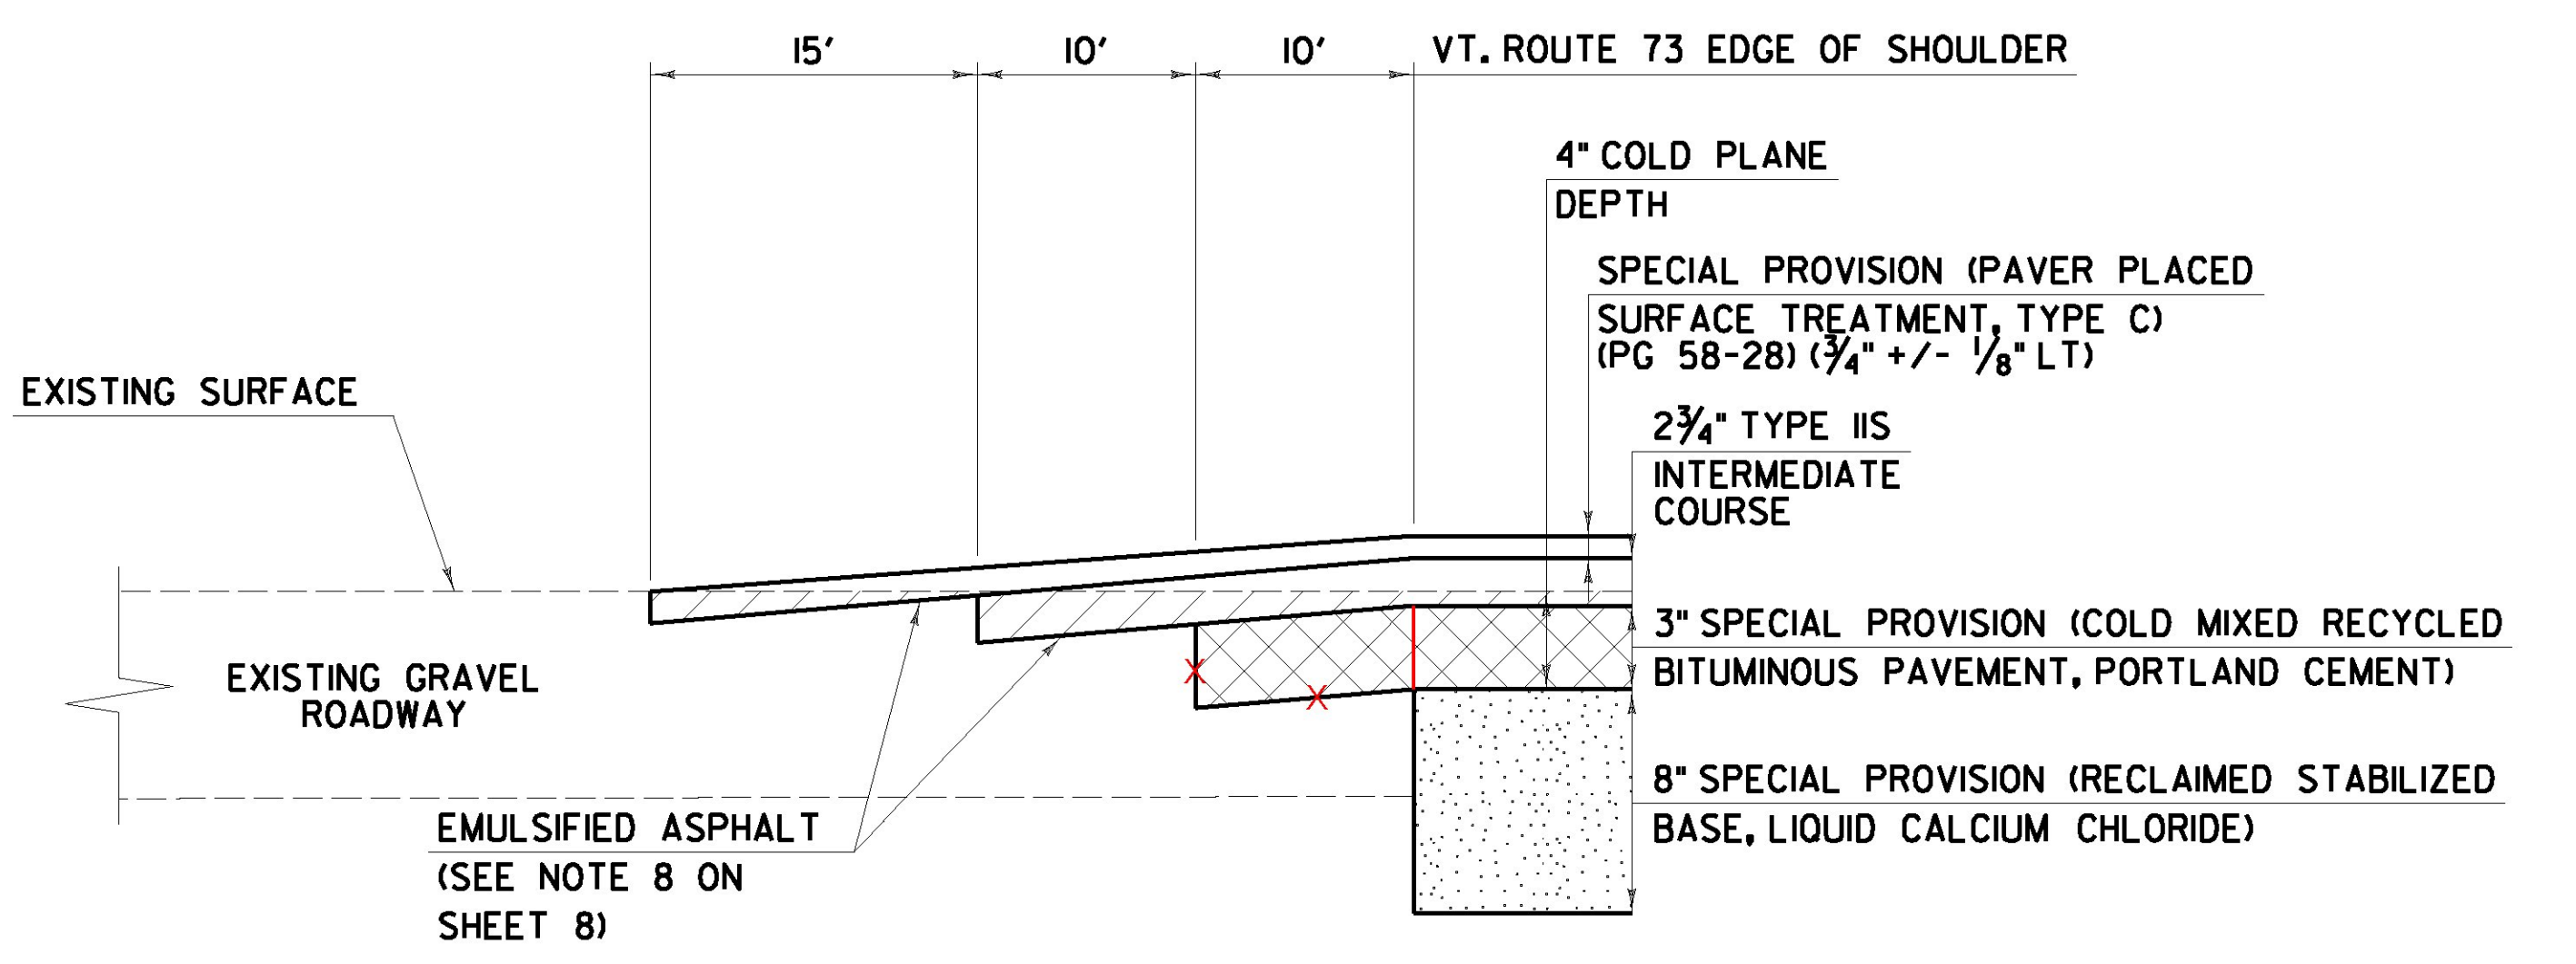

RECLAIM SIDE ROAD APPROACH AREA DETAIL
ROCHESTER: TH-37 STA R 190+71.36 LT

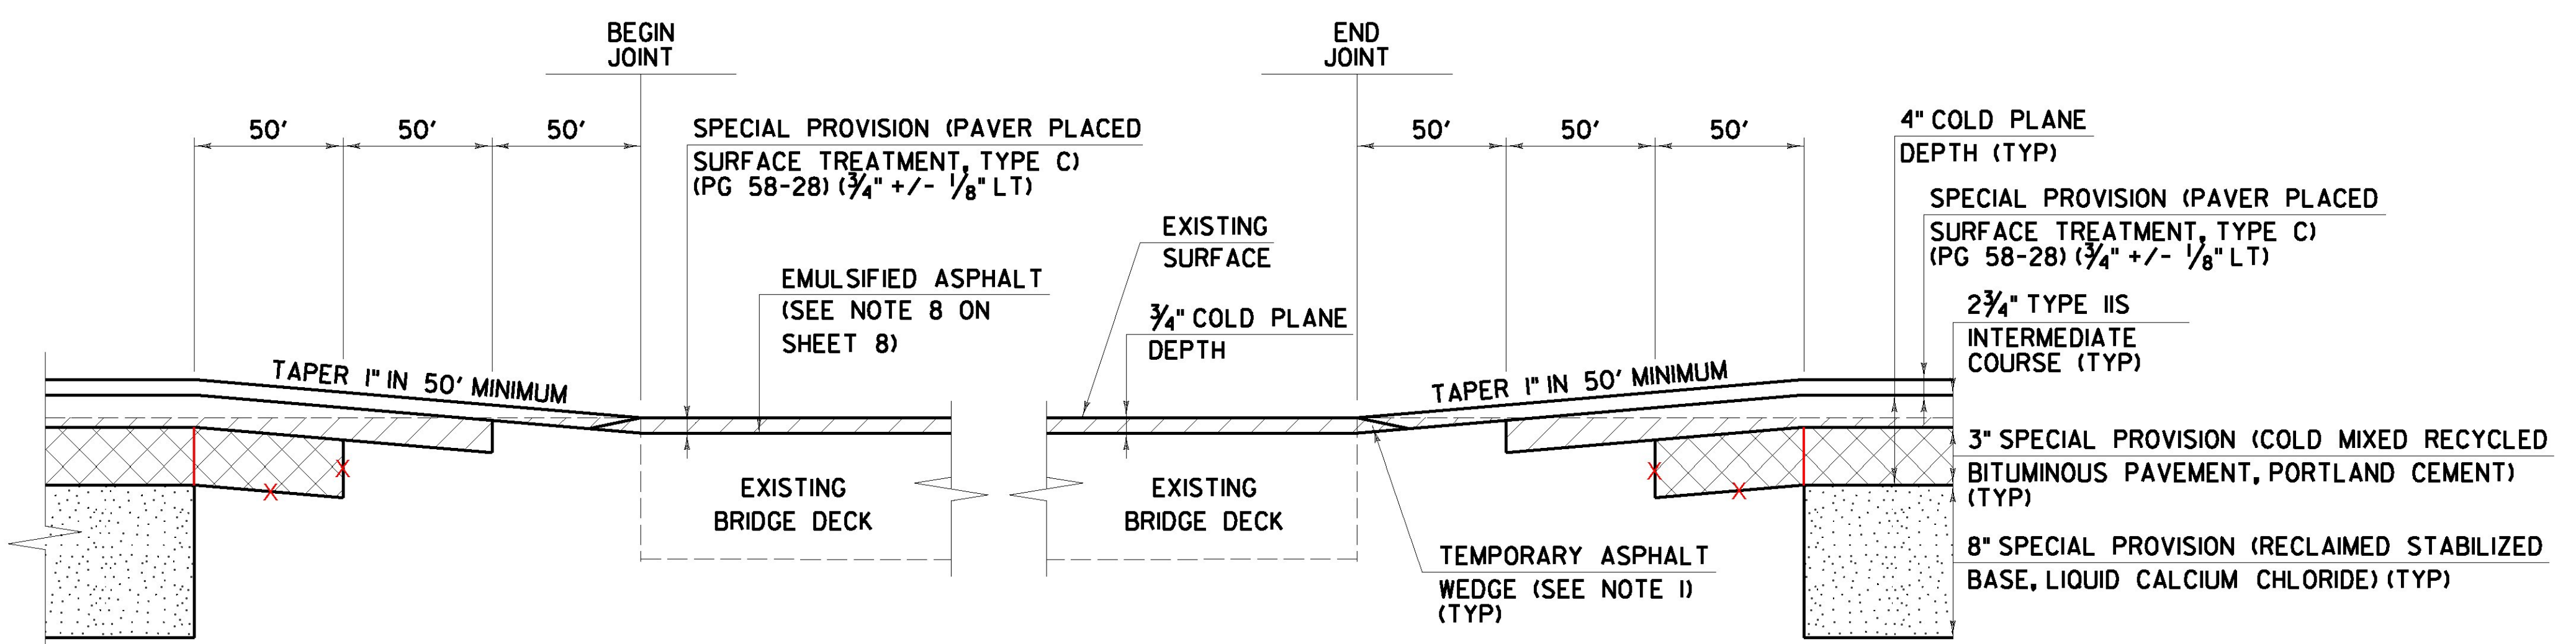

RECLAIM BRIDGE TRANSITION AREA DETAIL

BR 13 VT. ROUTE 73 ROCHESTER STA R 120+31.21 TO STA R 122+13.98
BR 14 VT. ROUTE 73 ROCHESTER STA R 194+08.70 TO STA R 194+47.50

- ITEM 210.10 COLD PLANING, BITUMINOUS PAVEMENT

NOTE:
1. TEMPORARY ASPHALT WEDGE SHALL BE REMOVED PRIOR TO PAVING. COST TO BE CONSIDERED INCIDENTAL TO PAVING.

PROJECT NAME: ROCHESTER	
PROJECT NUMBER: ER STP 0162(21)	
FILE NAME: z13cl76pd01.dgn	PLOT DATE: 1/26/2017
PROJECT LEADER: D. GOZALKOWSKI	DRAWN BY: J. HEALD
DESIGNED BY: J. OLSEN	CHECKED BY: J. SHIELDS
PAVING DETAILS SHEET #1	SHEET 19 OF 360

NOT TO SCALE
CHA