
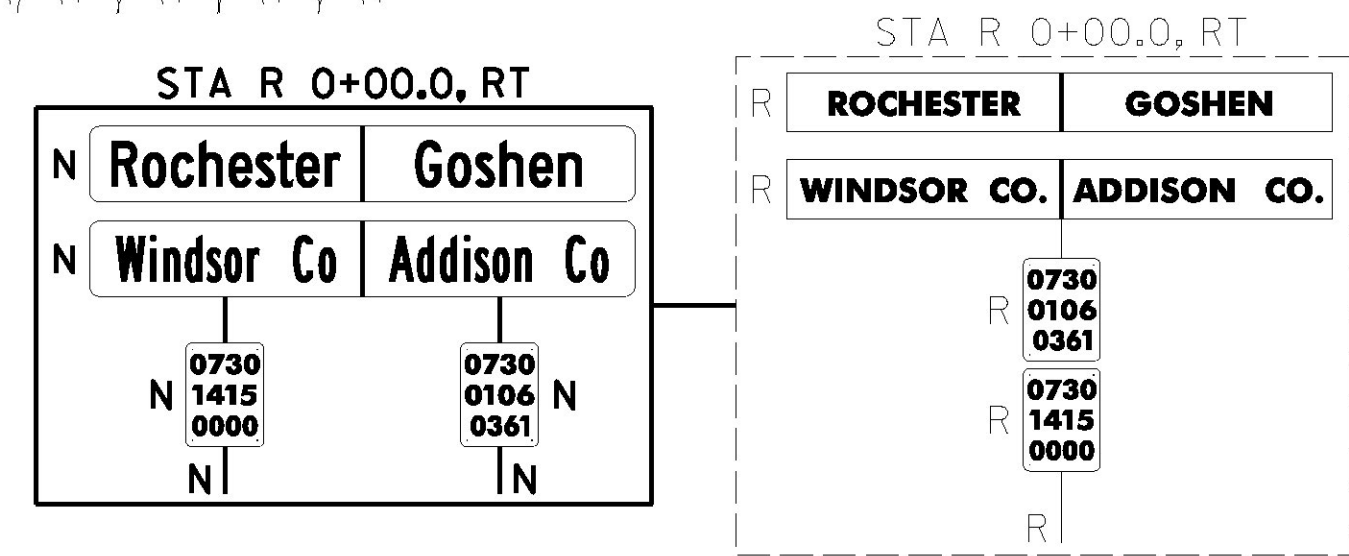
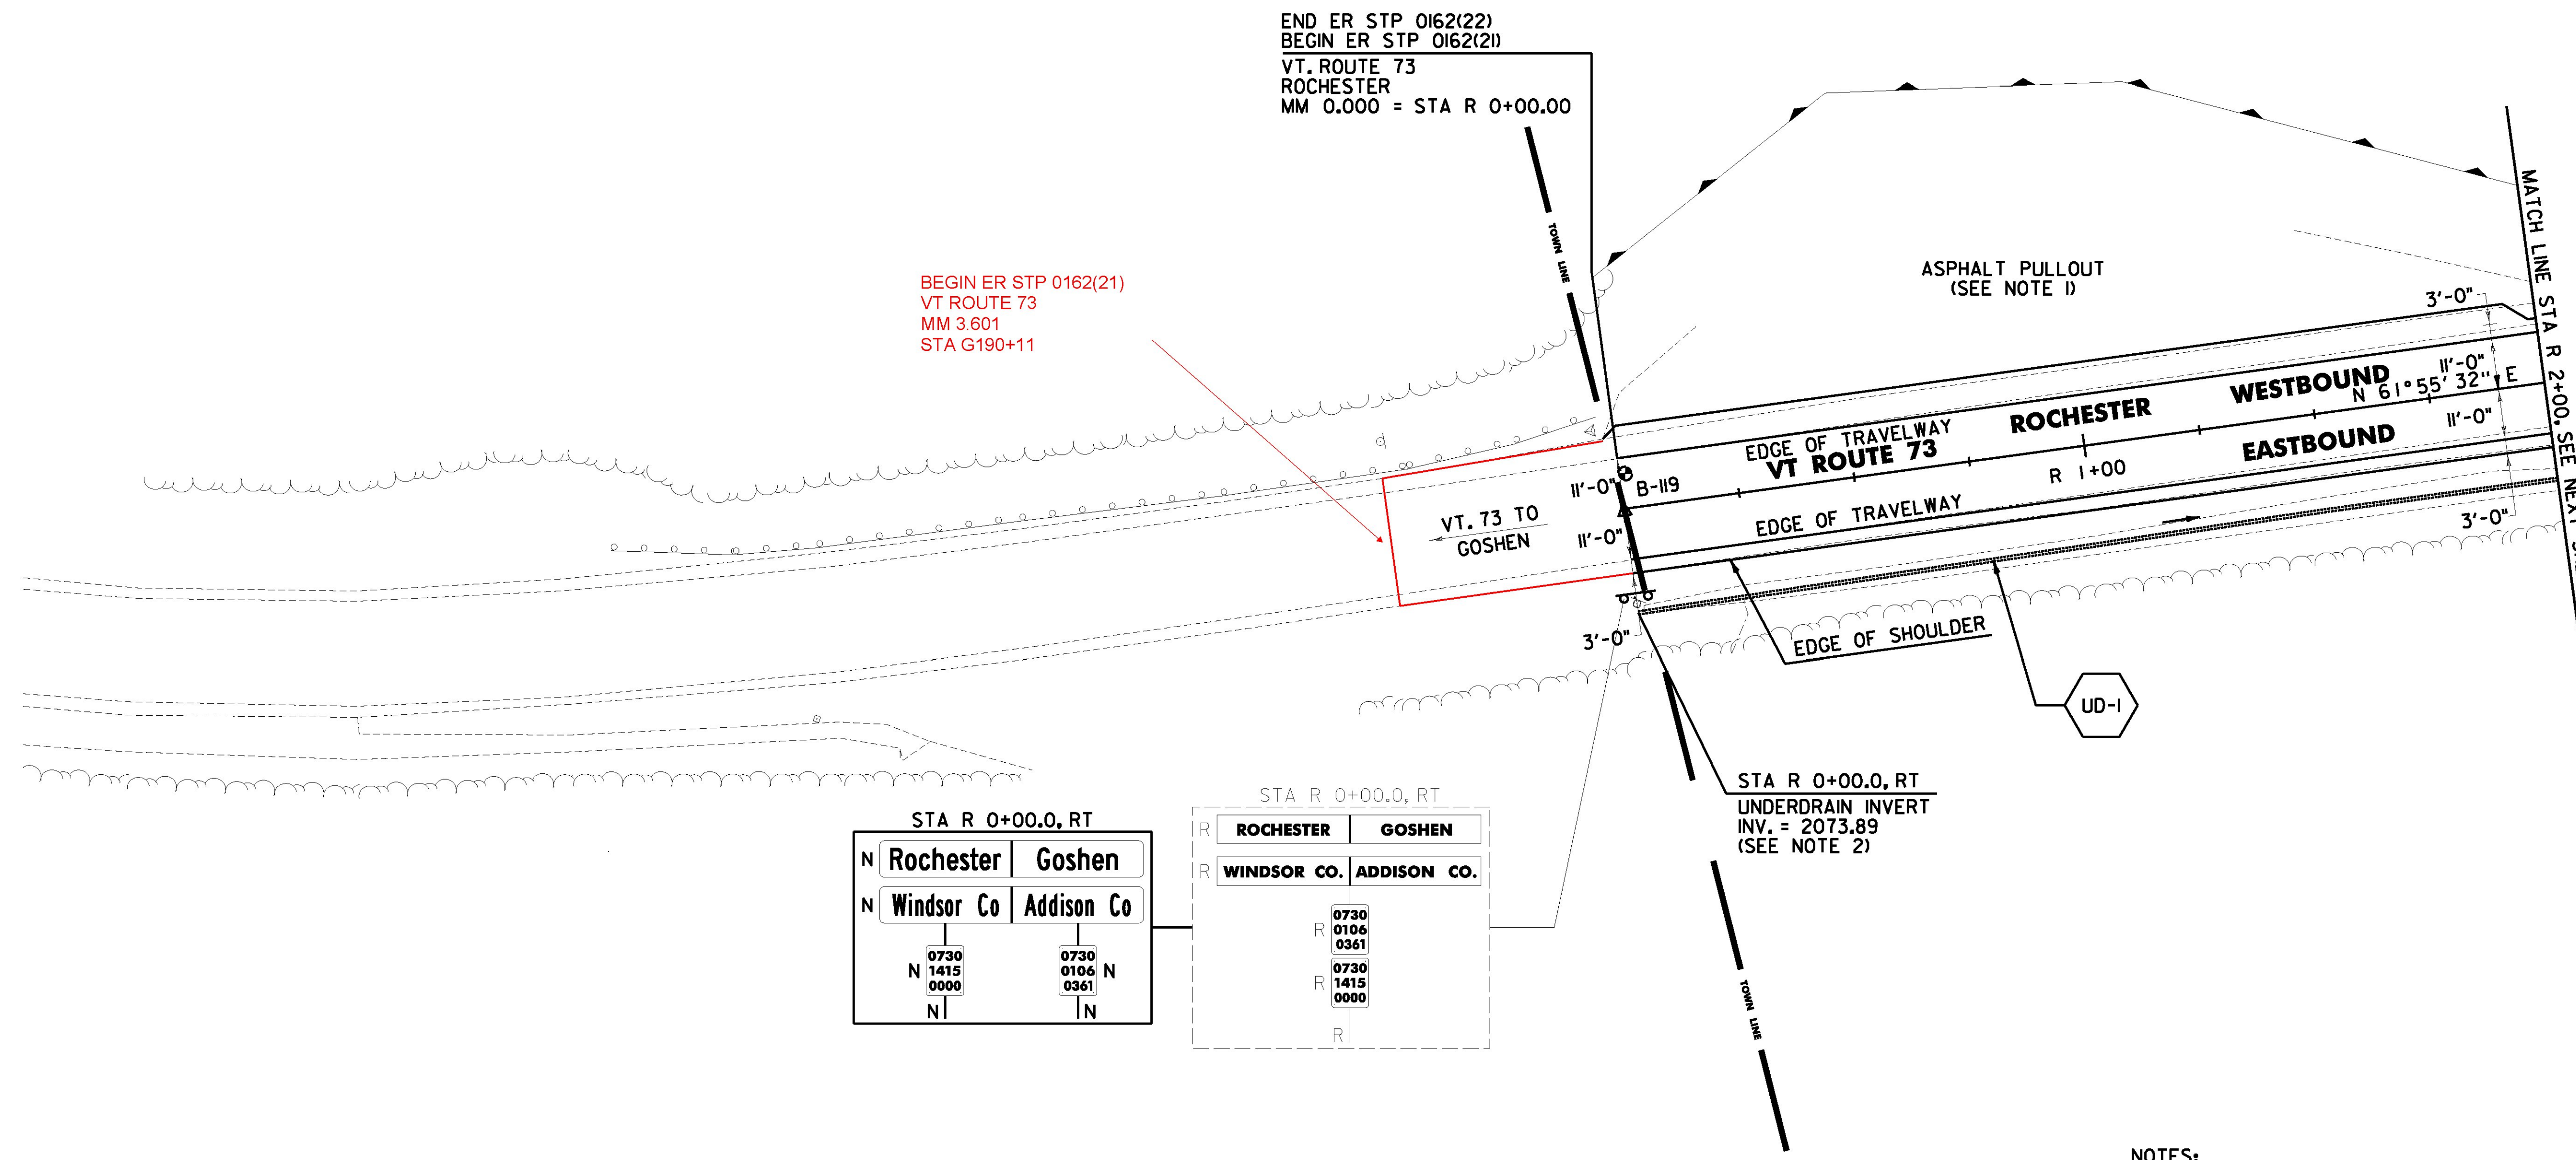


DURABLE 4 INCH WHITE LINE (OPTION ITEM)
AND TEMPORARY 4 INCH WHITE LINE, PAINT
(ALL LINES WILL INCLUDE EDGE LINE BREAKS AND
RADIUS FOR TOWN HIGHWAYS)
ROCHESTER:
STA R 0+00.00 - STA R 2+00.00 LT & RT

DURABLE 4 INCH YELLOW LINE (OPTION ITEM) AND
TEMPORARY 4 INCH YELLOW LINE, PAINT
(ALL LINES WILL INCLUDE C/L BREAKS FOR TOWN
HIGHWAYS) S = SOLID, D = DASHED
ROCHESTER:
STA R 0+00.00 - STA R 2+00.00 LT ☉ RT
S - S

REMOVING SIGNS
AS SHOWN - 4

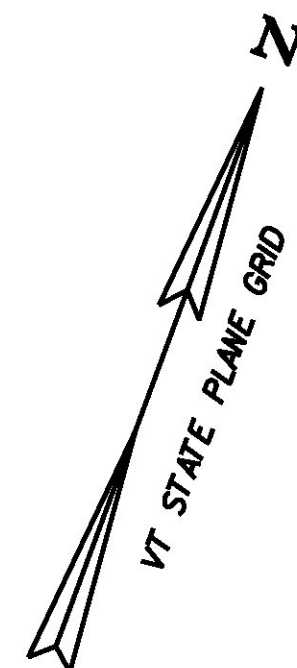


SOIL BORING DATA			
BORING #	DEPTH (FT.)	PCC	COMMENTS
B-119	5.0	NO	

6 INCH UNDERDRAIN PIPE
ROCHESTER:
STA R 0+00.00 - STA R 2+00.0 RT

PROJECT DEMARCATION FENCE
ROCHESTER:
~~STA R 0+00.00 - STA R 2+00.0 RT~~
~~STA R 1+93.0 - STA R 2+00.0 LT~~

BARRIER FENCE
ROCHESTER:
STA R 1+93.0 - STA R 2+00.0 LT

SIGN LEGEND
R = REMOVE
S = SALVAGE
N = NEW
RET = RETAIN
B-B = BACK TO BACK
EXISTING = _____
NEW = _____
R = RETURN TO TOWN
OF ROCHESTER

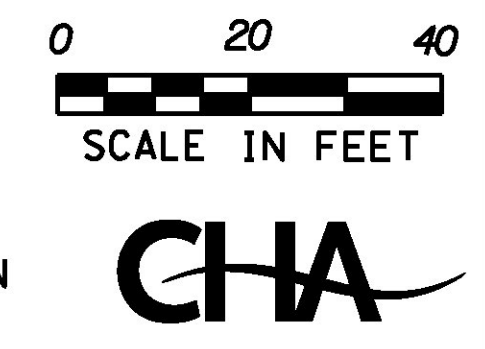

NOTES:

- PROVIDE A FOUR FT WIDE, 1/2" TYPE IVS APRON FOR THE EXISTING ASPHALT PULLOUT. ANY REQUIRED EXCAVATION SHALL BE PERFORMED AS DIRECTED BY THE ENGINEER AND PAID FOR UNDER ITEM 608.25 ALL PURPOSE EXCAVATOR RENTAL, TYPE I.
- SEE SHEETS 26 & 27 FOR UNDERDRAIN DETAILS.

PROJECT NAME: ROCHESTER
PROJECT NUMBER: ER STP 0162(21)

FILE NAME: z13cl76bdr.dgn
PROJECT LEADER: D. GOZALKOWSKI
DESIGNED BY: J. OLSEN
PROJECT LAYOUT SHEET #1

PLOT DATE: 1/11/2017
DRAWN BY: J. HEALD
CHECKED BY: J. SHIELDS
SHEET 33 OF 360