
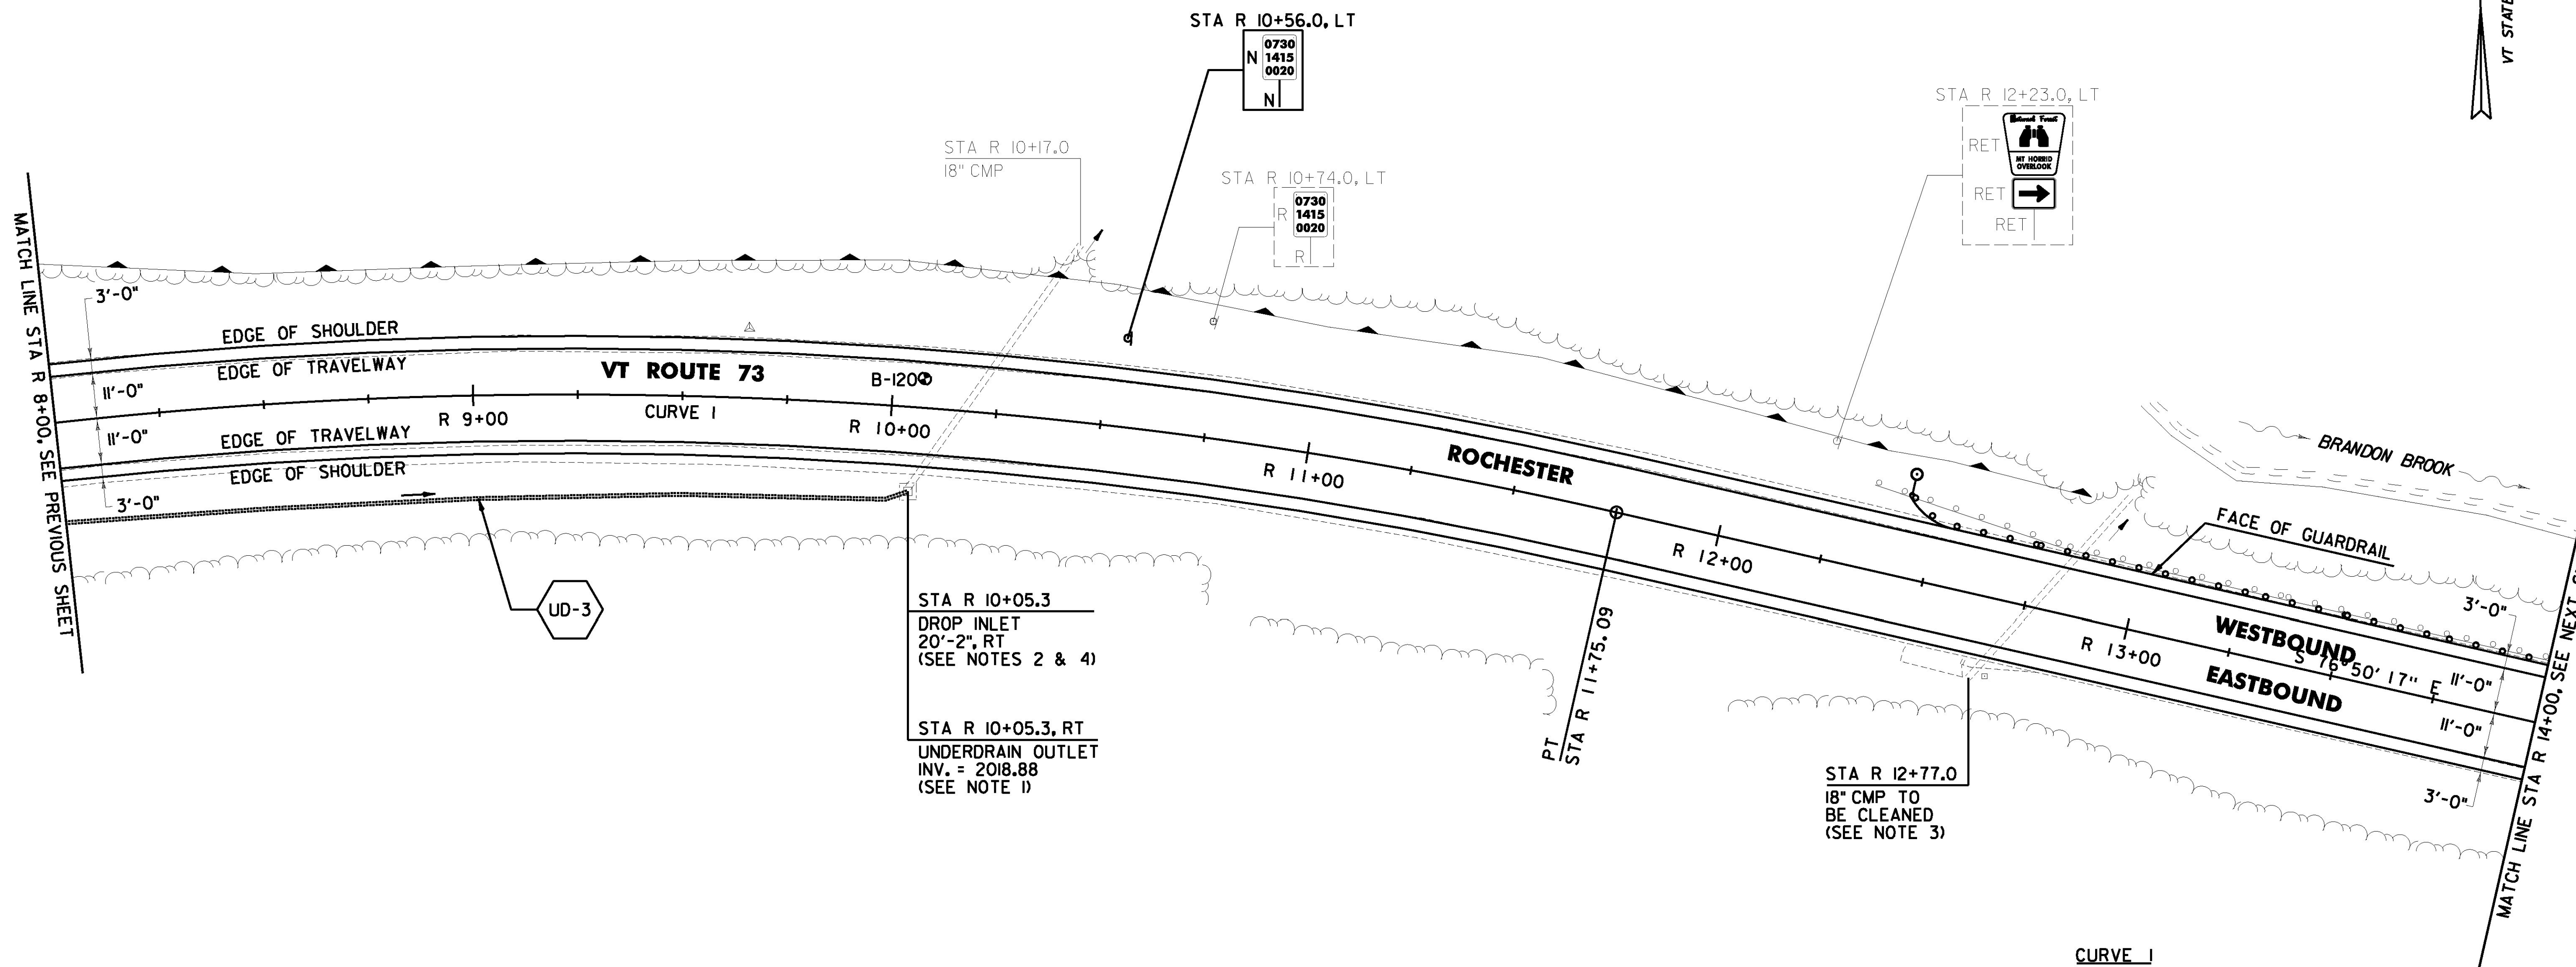


DURABLE 4 INCH WHITE LINE (OPTION ITEM)
AND TEMPORARY 4 INCH WHITE LINE, PAINT
(ALL LINES WILL INCLUDE EDGE LINE BREAKS AND
RADIUS FOR TOWN HIGHWAYS)
ROCHESTER:
STA R 8+00.00 - STA R 14+00.00 LT & RT

DURABLE 4 INCH YELLOW LINE (OPTION ITEM) AND
TEMPORARY 4 INCH YELLOW LINE, PAINT
(ALL LINES WILL INCLUDE C/L BREAKS FOR TOWN
HIGHWAYS) S = SOLID, D = DASHED
ROCHESTER:
STA R 8+00.00 - STA R 14+00.00 LT RT
S S

SPECIAL PROVISION (CORING CONCRETE)
ROCHESTER:
STA R 10+05.3 RT
CLEANING CULV. PIPE IN-PLACE (0 TO 24 IN., INCL.)
ROCHESTER:
STA R 12+77.0 LT/RT

REMOVING SIGNS
AS SHOWN - 1

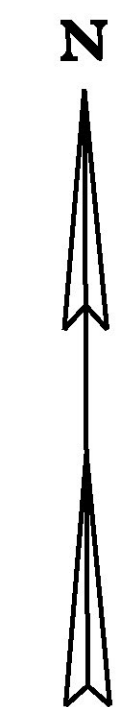

PROJECT DEMARCATION FENCE
ROCHESTER:
~~STA R 8+00.0 - STA R 14+00.0 LT & RT~~

BARRIER FENCE
ROCHESTER:
STA R 8+00.0 - STA R 13+85.0 LT R 9+43.0 LT

REHAB DROP INLETS, CATCH BASINS OR MANHOLES
CLASS I, II, OR III (SEE NOTE 4)
ROCHESTER:
STA R 10+05.3, RT

STEEL BEAM GUARDRAIL, GALVANIZED
W/ 8 FEET POSTS
ROCHESTER:
STA R 12+42.5 - STA R 14+00.0 LT

ANCHOR FOR STEEL BEAM RAIL
ROCHESTER:
STA R 12+51.0 LT

6 INCH UNDERDRAIN PIPE
ROCHESTER:
STA R 8+00.0 - STA R 10+05.3 RT

REMOVAL AND DISPOSAL OF GUARDRAIL
ROCHESTER:
STA R 12+34.0 - STA R 14+00.0 LT

DELINEATOR WITH STEEL POST
ROCHESTER:
STA R 12+42.5 LT


NOTES:

- SEE SHEETS 26 & 27 FOR UNDERDRAIN DETAILS.
- THE CONTRACTOR SHALL ADJUST THE PROPOSED SIDE SLOPE TO AVOID FILLING IN THE EXISTING DROP INLET AS DIRECTED BY THE ENGINEER.
- THE CONTRACTOR SHALL ADJUST THE PROPOSED SIDE SLOPE TO AVOID FILLING IN THE EXISTING PIPE AS DIRECTED BY THE ENGINEER.
- THE CONTRACTOR SHALL REHABILITATE THE EXISTING DROP INLETS, CATCH BASINS OR MANHOLES TO A DEPTH AS DIRECTED BY THE ENGINEER. ALL REHABILITATION WORK WILL BE PAID FOR UNDER THE APPLICABLE REHABILITATION ITEM AS DIRECTED BY THE ENGINEER. ALL EXISTING UTILITIES MARKED "TO REMAIN" SHALL NOT BE ALTERED OR REHABILITATED UNLESS DIRECTED OTHERWISE BY THE ENGINEER.

CURVE 1
Δ = 41° 14' 11" RT
D = 5° 05' 35"
R = 1125.00'
T = 423.27'
L = 809.67'
E = 76.99'
e = 0.072 FT/FT

SOIL BORING DATA			
BORING #	DEPTH (FT.)	PCC	COMMENTS
B-120	5.0	NO	

SIGN LEGEND
R = REMOVE
S = SALVAGE
N = NEW
RET = RETAIN
B-B = BACK TO BACK
EXISTING = _____
NEW = _____
R = RETURN TO TOWN
⊙ OF ROCHESTER

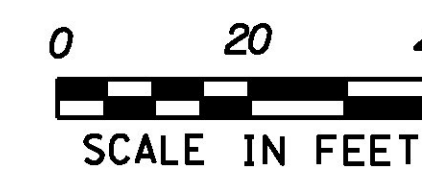

PROJECT NAME: ROCHESTER
PROJECT NUMBER: ER STP 0162(21)

FILE NAME: z13cl76bdr.dgn
PROJECT LEADER: D. GOZALKOWSKI
DESIGNED BY: J. OLSEN
PROJECT LAYOUT SHEET #3

PLOT DATE: 1/11/2017
DRAWN BY: J. HEALD
CHECKED BY: J. SHIELDS
SHEET 35 OF 360