
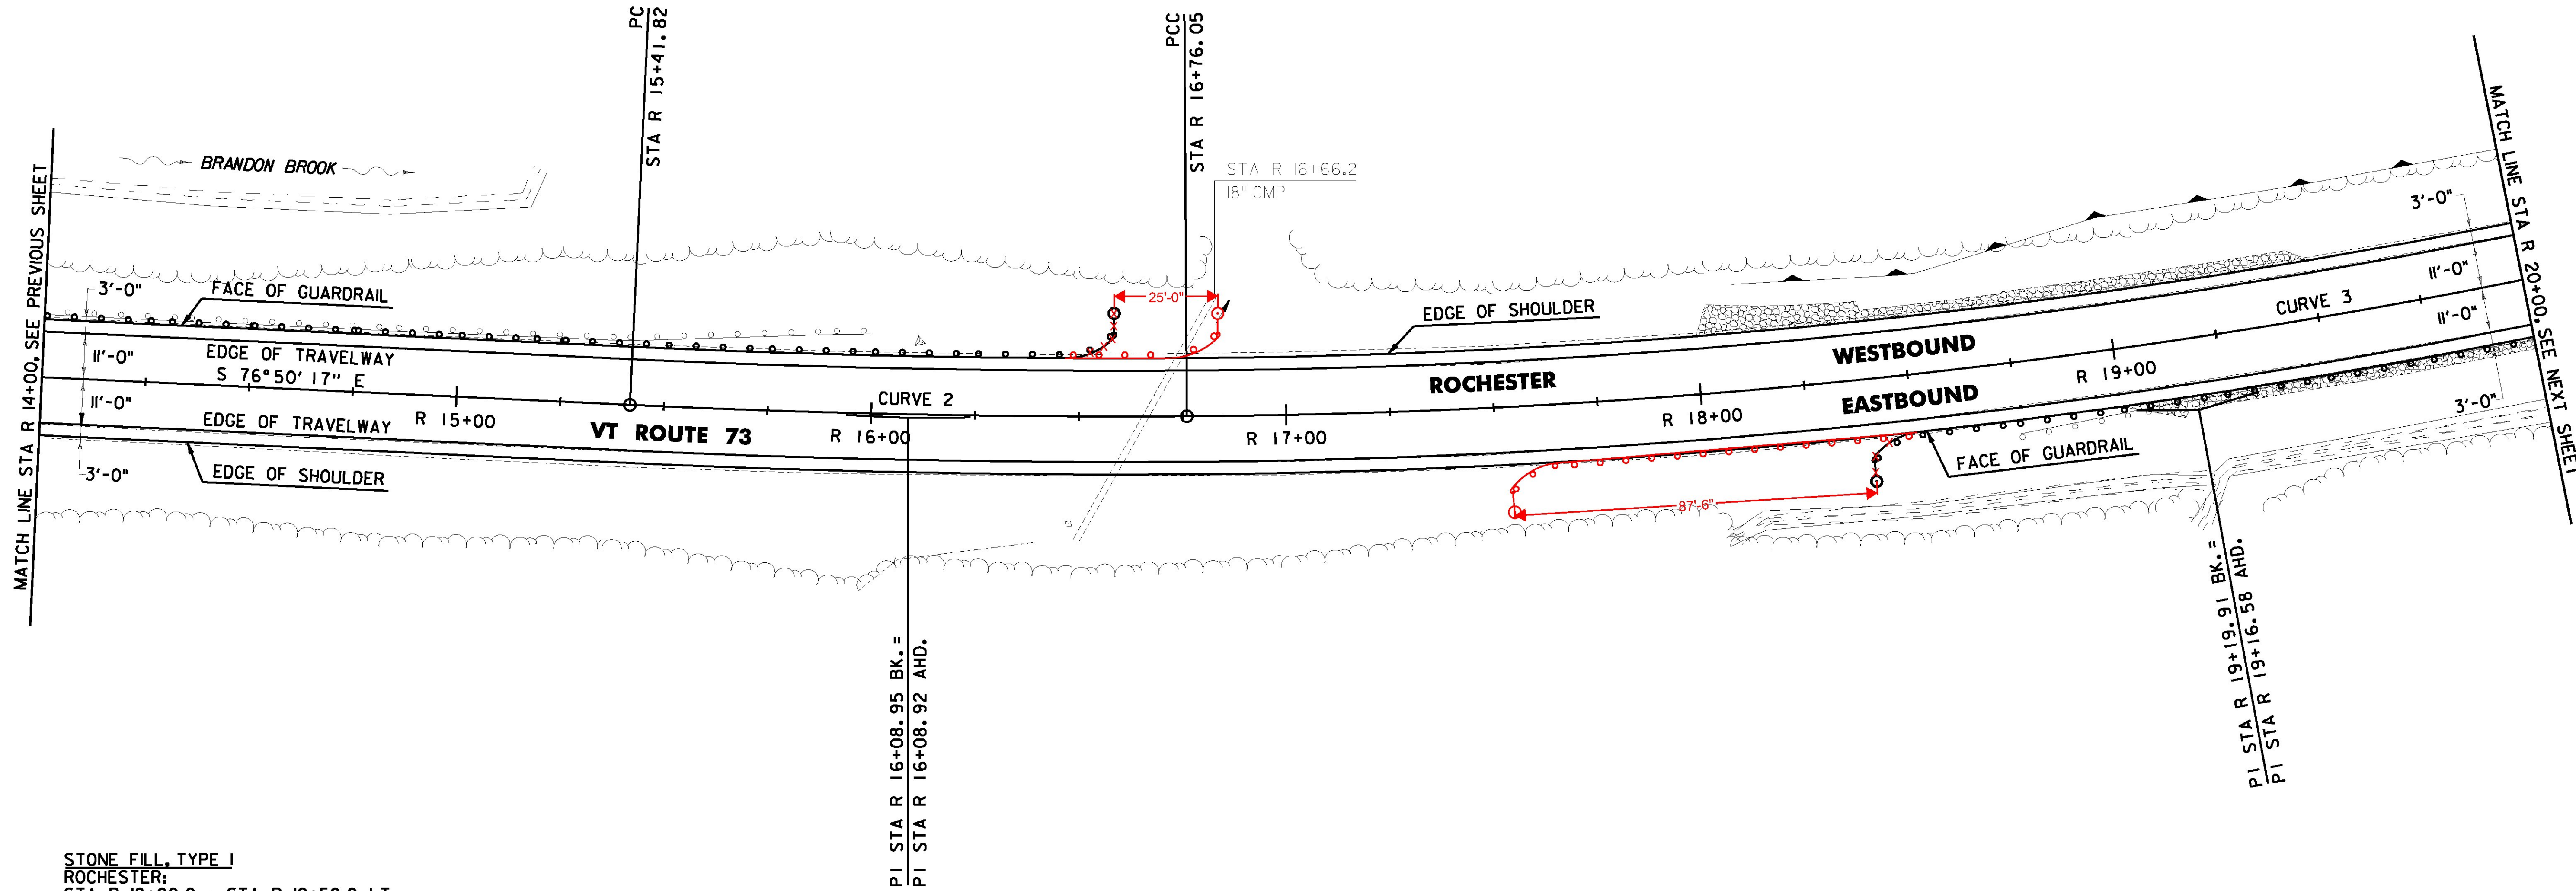


DURABLE 4 INCH WHITE LINE (OPTION ITEM)  
AND TEMPORARY 4 INCH WHITE LINE, PAINT  
(ALL LINES WILL INCLUDE EDGE LINE BREAKS AND  
RADIUS FOR TOWN HIGHWAYS)  
ROCHESTER:  
STA R 14+00.00 - STA R 20+00.00 LT & RT

DURABLE 4 INCH YELLOW LINE (OPTION ITEM) AND  
TEMPORARY 4 INCH YELLOW LINE, PAINT  
(ALL LINES WILL INCLUDE C/L BREAKS FOR TOWN  
HIGHWAYS) S = SOLID, D = DASHED  
ROCHESTER:  
STA R 14+00.00 - STA R 20+00.00 LT & RT  
LT & RT  
S S

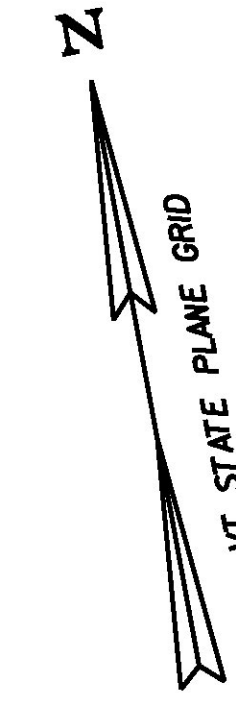

**STONE FILL, TYPE I**  
ROCHESTER:  
STA R 18+00.0 - STA R 19+50.0 LT  
STA R 19+00.0 - STA R 20+00.0 RT

**GRUBBING MATERIAL (6")**  
ROCHESTER:  
STA R 18+00.0 - STA R 19+50.0 LT  
STA R 19+00.0 - STA R 20+00.0 RT

**STEEL BEAM GUARDRAIL, GALVANIZED  
W/ 8 FEET POSTS**  
ROCHESTER:  
STA R 14+00.0 - STA R 16+84.0 LT  
STA R 18+39.5 - STA R 20+00.0 RT

**REMOVAL AND DISPOSAL OF GUARDRAIL**  
ROCHESTER:  
STA R 14+00.0 - STA R 15+99.5 LT  
STA R 18+75.0 - STA R 20+00.0 RT

**ANCHOR FOR STEEL BEAM RAIL**  
ROCHESTER:  
STA R 16+50.5 LT  
STA R 18+48.0 RT

**PROJECT DEMARCATION FENCE**  
ROCHESTER:  
~~STA R 14+00.0 - STA R 20+00.0 LT & RT~~

**BARRIER FENCE**  
ROCHESTER:  
~~STA R 17+00.0 - STA R 20+00.0 LT~~

**GEOTEXTILE FOR SILT FENCE**  
ROCHESTER:  
~~STA R 19+00.0 - STA R 20+00.0 RT~~

**EROSION LOG**  
ROCHESTER:  
STA R 18+00.0 - STA R 19+50.0 LT

**DELINEATOR WITH STEEL POST**  
ROCHESTER:  
STA R 16+59.0 LT  
STA R 18+39.5 RT

PI STA R 16+08.95 BK. =  
PI STA R 16+08.92 AHD.

**CURVE 2**  
Δ = 3° 03' 06" LT  
D = 2° 16' 25"  
R = 2520.00'  
T = 67.13'  
L = 134.22'  
E = 0.89'  
e = 0.044 FT/FT

**CURVE 3**  
Δ = 16° 22' 26" LT  
D = 3° 22' 49"  
R = 1695.00'  
T = 243.86'  
L = 484.39'  
E = 17.45'  
e = 0.058 FT/FT

**LEGEND**  
ITEM 613.10  
STONE FILL, TYPE I

**SIGN LEGEND**  
R = REMOVE  
S = SALVAGE  
N = NEW  
RET = RETAIN  
B-B = BACK TO BACK  
EXISTING = \_\_\_\_\_  
NEW = \_\_\_\_\_  
R = RETURN TO TOWN  
OF ROCHESTER

0 20 40  
SCALE IN FEET



PROJECT NAME: ROCHESTER  
PROJECT NUMBER: ER STP 0162(21)

FILE NAME: z13cl76bdr.dgn  
PROJECT LEADER: D. GOZALKOWSKI  
DESIGNED BY: J. OLSEN  
PROJECT LAYOUT SHEET #4

PLOT DATE: 1/11/2017  
DRAWN BY: J. HEALD  
CHECKED BY: J. SHIELDS  
SHEET 36 OF 360